


G.P.S. / GEODETIC SURVEY MONUMENT RECORD

SECTION 31, T 16 N, R 4 W, CITY/TOWN/VILLAGE LEON

MONROE COUNTY

Lat: 43°49'30.727280 N (.00000m)
Lon: 90°54'38.766870 W (.00000m)
Ell. Hgt in m: (382.1880m), (.00000m)

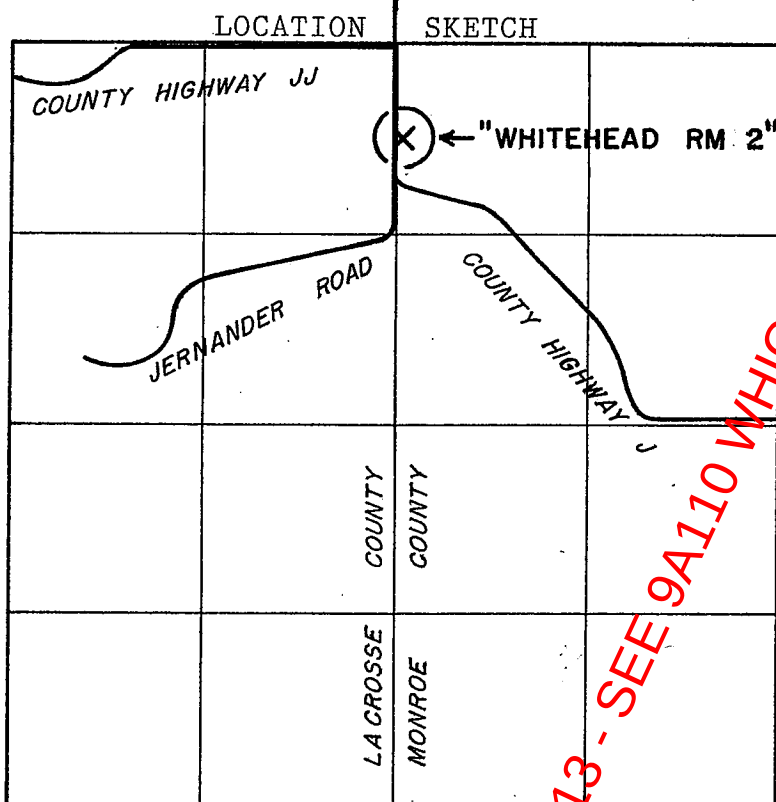

E. 1/2 - SEC. 36-16-5.

W. 1/2 - SEC. 31-16-4.

HORIZONTAL DATUM

NAD 83(91):

(Y) 666,553.109786

(X) 1,728,149.408003

NAD 27:

(Y)

(X)

OTHER:

(Y)

(X)

VERTICAL DATUM

ELEV. _____,

ELEV. _____, 1929

ELEV. _____, 1988

GPS / GEODETIC STATION DESCRIPTION

D.O.T. PROJECT I.D.: LaCrosse Co. computer I.D.: WHIT

STATION NAME: "Whitehead RM 2" STATION NO. 164W31S

LATITUDE: N 43°49'30.72728" LONGITUDE: W 90°54'38.76687"

LOCAL NAME: Whitehead Reference #2 (1930)

MONUMENT BY AGENCY: LaX Co. Surveyor DATE: 8/11/1993 TYPE: Brass Cap in Conc.

FD. BY: William C. Jung-(LaCrosse County Surveyor), Peter F. Follansbee

MAINTENANCE RECORD: 7/30/99 OK wseg

MAINTENANCE RECORD: 6/6/00 and 7/18/00 OK wseg

MAINTENANCE RECORD: 10/30/07 OK wseg

MAINTENANCE RECORD: 9/16/08 Fd. the monument knocked off plumb. wseg

MAINTENANCE RECORD:


Beginning at the intersection of State Hwy 33 & State Hwy 162 in the unincorporated area known as Middle Ridge in the Town of Washington, LaCrosse Co., then 3.0 miles east along St. Hwy 33 to the intersection of County Hwy Y, then 1.1 mi. + N. along Co. Hwy Y to the 1st intersection of Co. Hwy Y & Co. Hwy J; thence 1.4 mi. + N.W.-ly along Co. Hwy J to the monument which is an 11" sq. concrete marker with 4" brass cap 23.5 Ft. east of centerline. Both the D.O.T. & NGS advisors approved the use of the monument. ("Whitehead" & "Whitehead RM1" were also recovered.) (3.0mi. = 4.83km, 1.1mi. = 1.77km, 1.4mi. = 2.25km)

RECORD OF DURABLE WITNESS MONUMENTS

DETAIL SKETCH



GRID
NORTH

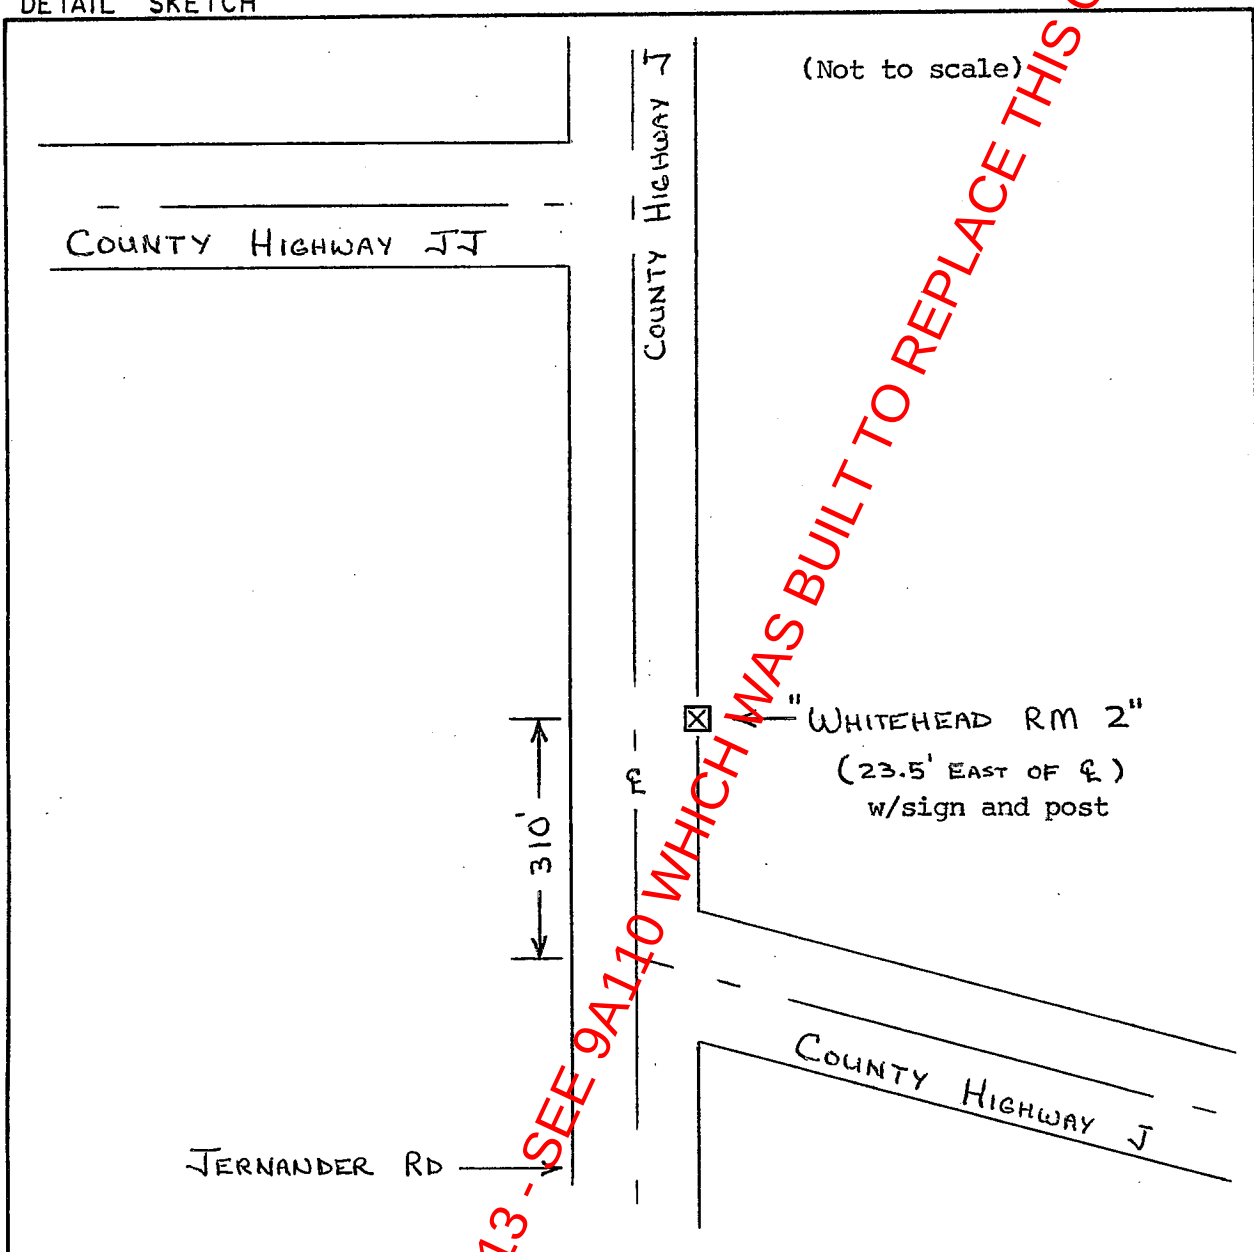

NO.	DESCRIPTION	BEARING	DISTANCE

REMARKS: _____

I, William C. Jung, LaCrosse County Surveyor
 HEREBY CERTIFY THAT THE MONUMENT LOCATION SHOWN
 ON THIS RECORD WAS DETERMINED UNDER MY DIRECTION
 AND CONTROL AND THAT THIS GPS/GEODETIC RECORD IS
 CORRECT AND COMPLETE TO THE BEST OF MY KNOWLEDGE
 AND BELIEF

William C. Jung
 SIGNATURE

2/8/00
 DATE

