


## U. S. PUBLIC LAND SURVEY MONUMENT RECORD

SECTION 27 T 15 N, R 5 W, TOWN OF WASHINGTON

LA CROSSE COUNTY

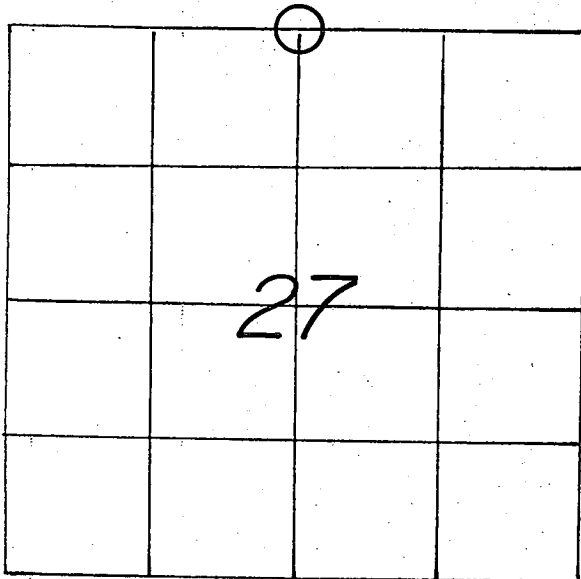

LOCATION OF LANDMARK

CREW: **WILLIAM C. JUNG**  
**PETER F. FOLLANSBEE**  
 DATE: **12/29/2005**

## WISCONSIN COORDINATE SYSTEM

North

East

Theta Angle

Horiz. Order

Vert. Order

## TYPE OF LANDMARK

2" (O.D.) IRON PIPE, UP 1.7'

BEARINGS ARE REFERENCED TO

Describe any record evidence, monument evidence, testimonial evidence or any other material evidence you considered and whether the monument was found or restored through acceptance of an obliterated evidence location.

Bob Chalsma set an iron pipe at this corner in 1989. He apparently set the pipe at what he assumed to be the occupied corner. The pipe was used as the corner in later survey work. I accepted this pipe as the corner by "common report".

Describe or show any material discrepancy between the location of the restored corner and that of the corner previously restored or reestablished.

**NONE KNOWN.**

