


21505260000

U. S. PUBLIC LAND SURVEY MONUMENT RECORD

SECTION 36 T 15 N, R 5 W, TOWN OF WASHINGTON
 LA CROSSE COUNTY

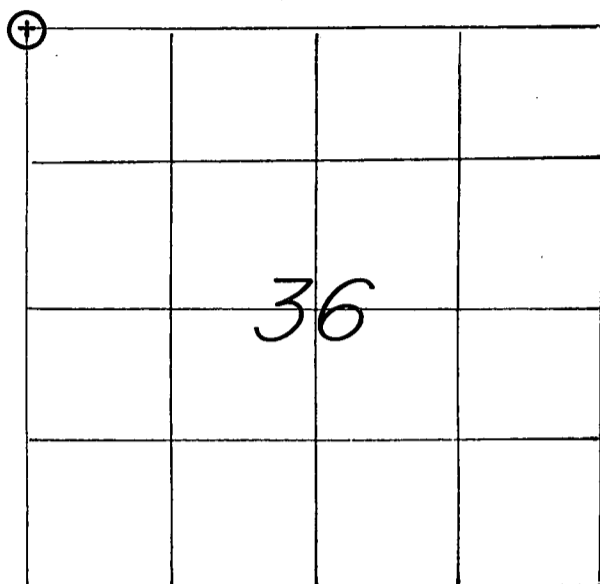

WISCONSIN COORDINATE SYSTEM
North
East
Theta Angle
Horiz. Order
Vert. Order
TYPE OF LANDMARK
<i>3/4" x 30" IRON BAR WITH ALUMINUM CAP.</i>
BEARINGS ARE REFERENCED TO
<i>ASSUMED NORTH.</i>

LOCATION OF LANDMARK
 CREW: WILLIAM C. JUNG
 PETER F. FOLLANSBEE
 DATE: 11/19/1997

Describe any record evidence, monument evidence, testimonial evidence or any other material evidence you considered and whether the monument was found or restored through acceptance of an obliterated evidence location.


In 1984 Phil Scholze found a stone at this corner and tied it off. The local landowners had apparently known of this section corner stone for quite some time. I dug at the location but found only stone remnants. Was it plowed out? Scholze's iron pipe offsets were still in. I set an iron bar with a cap at the corner using the pipes. The iron bar is down 18". I set a hub with a tack over the iron bar. In digging for the stone I went down 40".

Describe or show any material discrepancy between the location of the restored corner and that of the corner previously restored or reestablished.

None known.

U. S. PUBLIC LAND SURVEY MONUMENT RECORD

SECTION 26 T 15 N, R 5 W, TOWN OF WASHINGTON
 LA CROSSE COUNTY

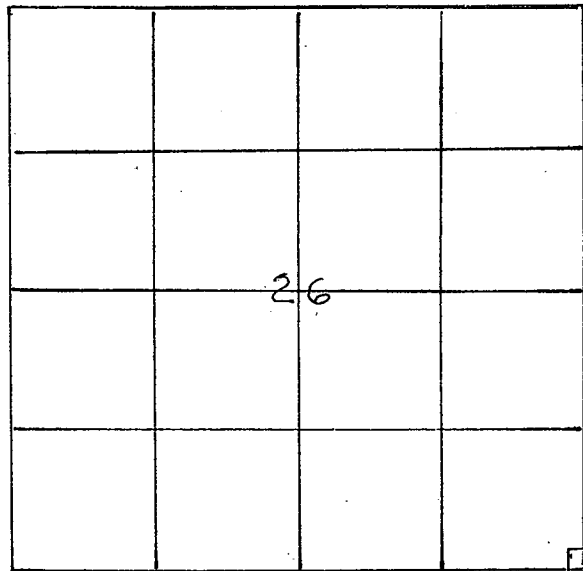

LOCATION OF LANDMARK SE CORNER

WISCONSIN COORDINATE SYSTEM
North
East
Theta Angle
Horiz. Order
Vert. Order

TYPE OF LANDMARK
4" X 4" X 2' STONE FOUND

BEARINGS ARE REFERENCED TO
 LACROSSE COUNTY CSM
 RECORDED IN VOL. 2 PG 164

Describe any record evidence, monument evidence, testimonial evidence or any other material evidence you considered and whether the monument was found or restored through acceptance of an obliterated evidence location.

Present owner, Ray Korn knew of the location of the corner and stated that the farm had been in the family since it was originally homesteaded in the 1800's and that the location of the corner had been passed down from owner to owner since that time.

Describe or show any material discrepancy between the location of the restored corner and that of the corner previously restored or reestablished.

