


SIDE ROAD CONNECTION LEFT
845+48.5 ± = 0V'+23.5

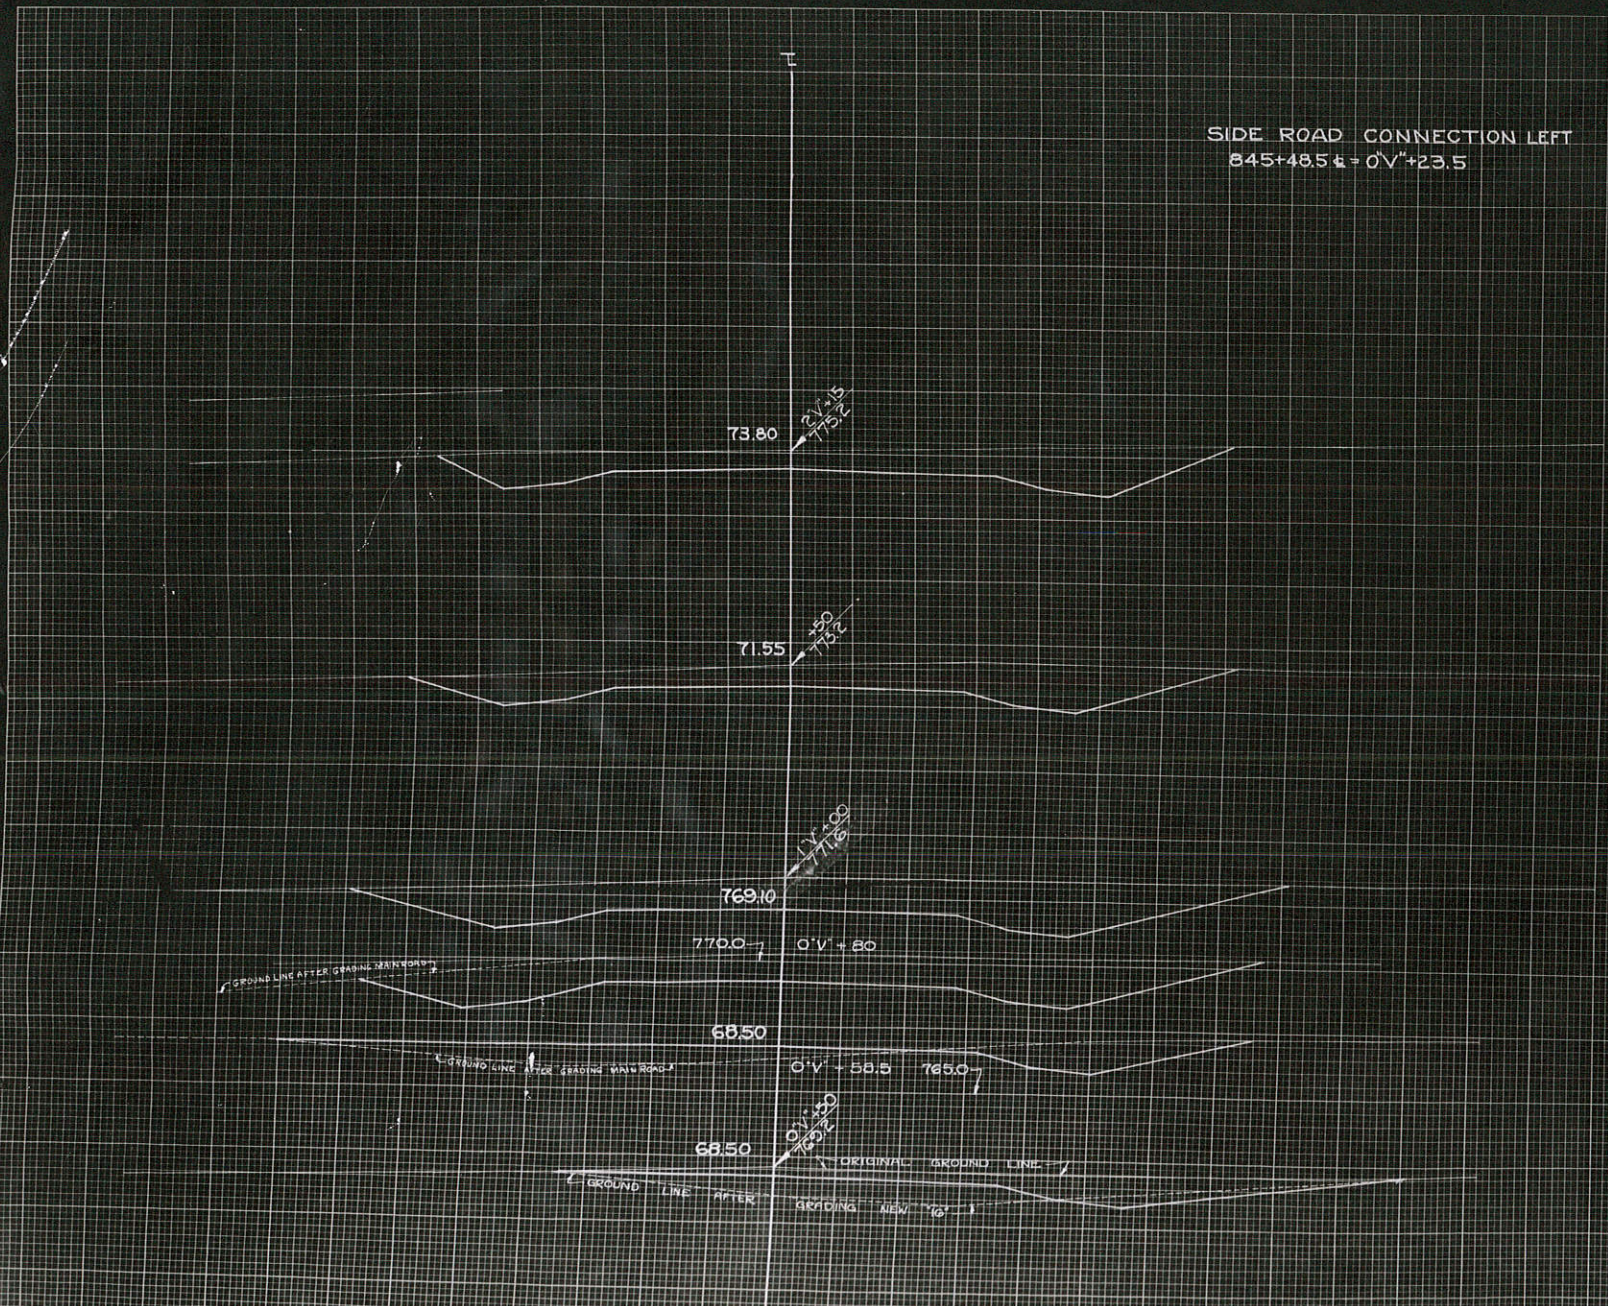


C.Y.	STEP SLOPES	STATION	END AREA			DISTANCE	YARDAGE				
			EXCAVATION		FILL		EXCAVATION				
			COMMON	ROCK			COMMON	ROCK	TOTAL	TOTAL FILL	
		0V'+30	0		0						
		+50	12		45	C10 F20	2		2	17	
		+58.5	33		52	85	7		7	15	
		+80	163		0	C25 F35	78		78	13	
		1V'	188		0	20	130		130	0	
		+50	130		0	50	294		294	0	
		2V'+15	123		0	65	306		306	0	
		+20	0		0	5	11		11	0	
		SUB TOTAL - MILE									
		SHEET TOTAL					828			828	45

FINAL SURVEY REPORT
DATE: 3-17-40
BY: W. E. BOON
CHECKED: [Signature]


ORIGINAL SURVEY REPORT
DATE: 3-17-40
BY: W. E. BOON
CHECKED: [Signature]

FINAL SURVEY
 SECTION
 NORTH BOUNDARY
 MAP SHEET
 NO. 5131

FINAL SURVEY
 SECTION
 NORTH BOUNDARY
 MAP SHEET
 NO. 5131

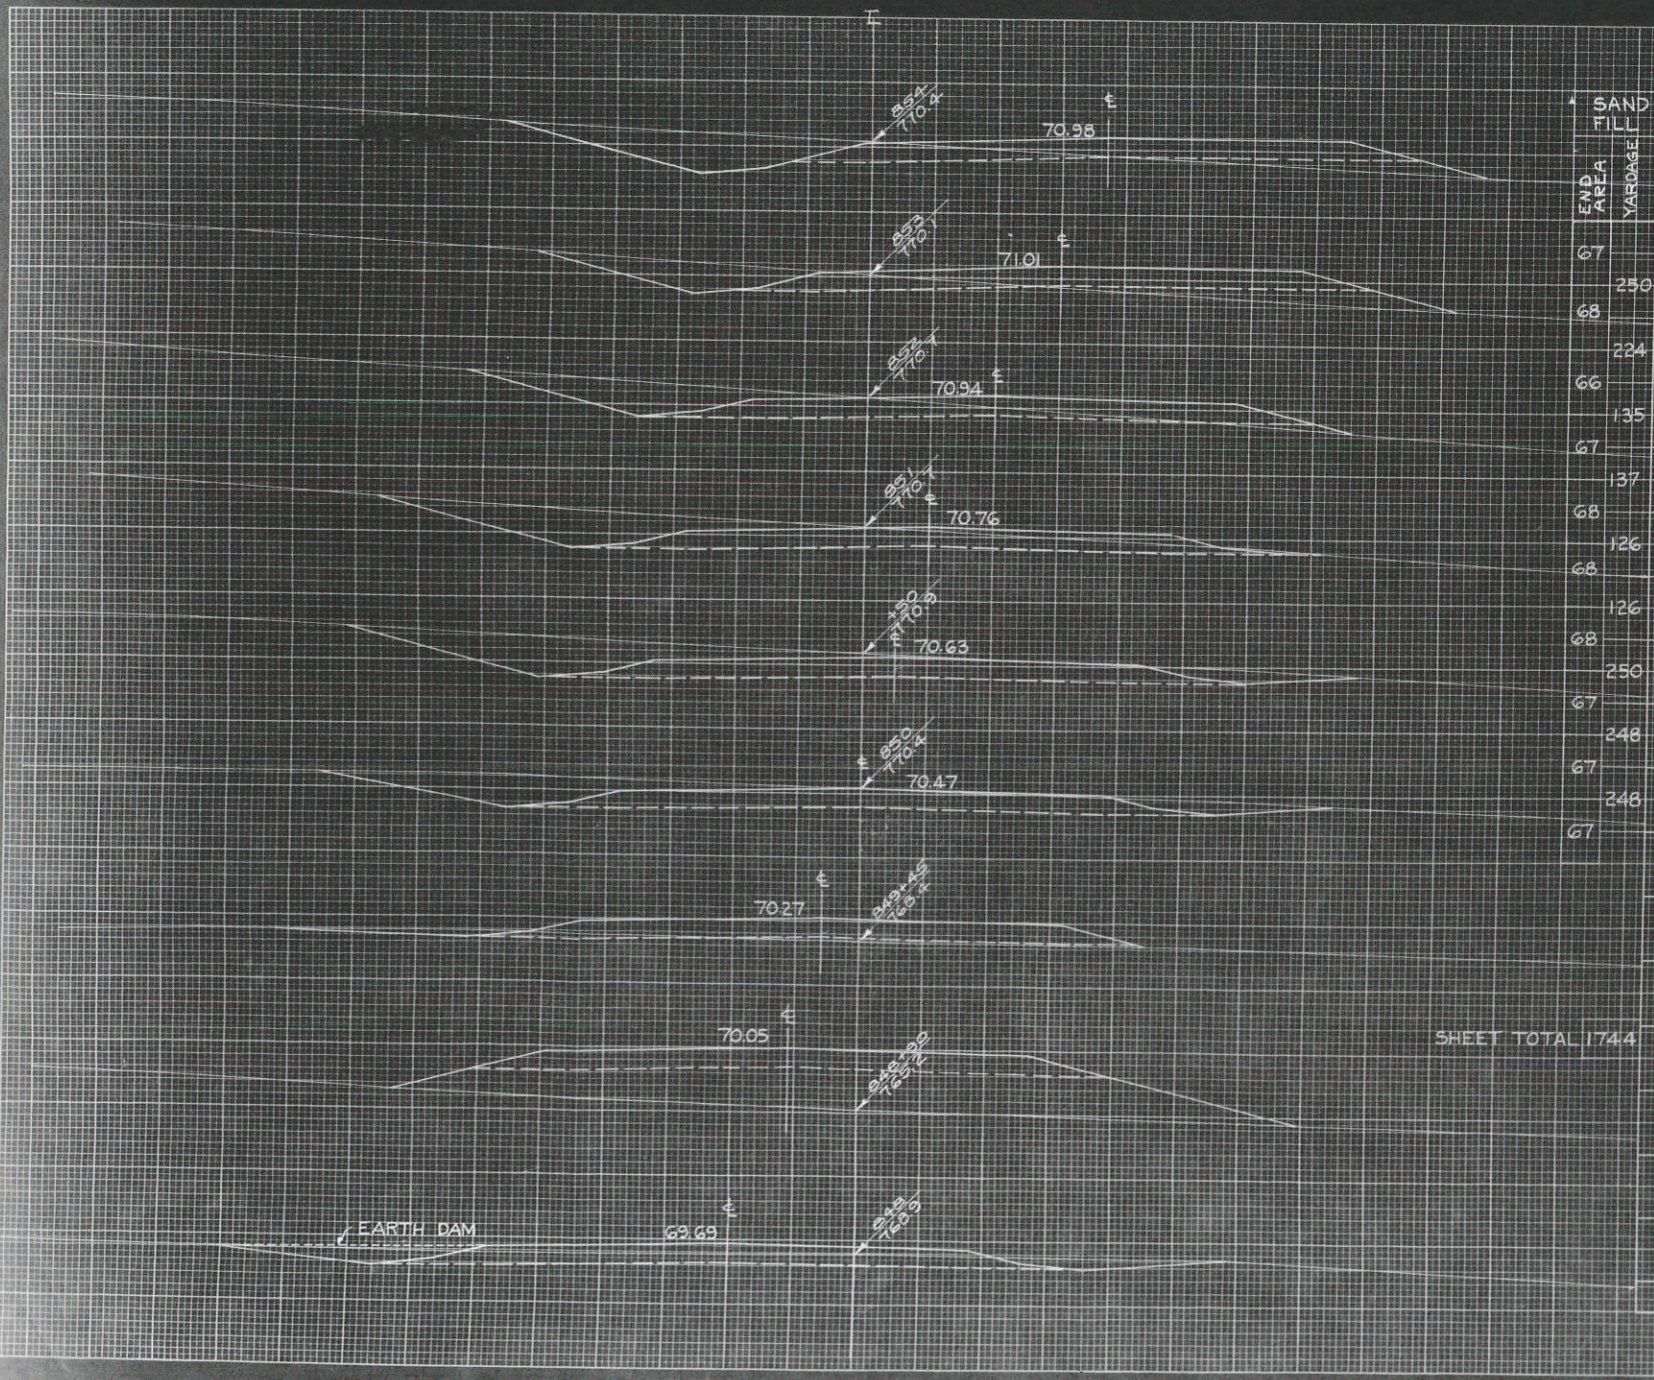


STATION	CY	STEP SLOPES	END AREA			DISTANCE	YARDAGE					
			EXCAVATION		FILL		EXCAVATION		TOTAL	FOOTING FILL		
			COMMON	ROCK			COMMON	ROCK				
67	250	847	6		3							
68	224	848	62		0	100'		144		144	6	
66	135	+90	0		175	90'		104		104	228	
67	137	+45	0		8	70'		2		2	187	
68	126	850	117		0	55'		130		130	4	
68	126	+50	144		0	25'		243		243	0	
68	250	851	111		0	50'		237		237	0	
67	248	852	75		5	100'		359		359	6	
67	248	853	48		22	60'		228		228	55	
67	248	854	72		13	100'		220		220	65	
SHEET TOTAL						174.4						
EARTH DAM LT. STA 848+00											15	
EARTH DAM LT. STA 852+00											10	
SUB TOTAL - MILE												
SHEET TOTAL						1667					1667	578

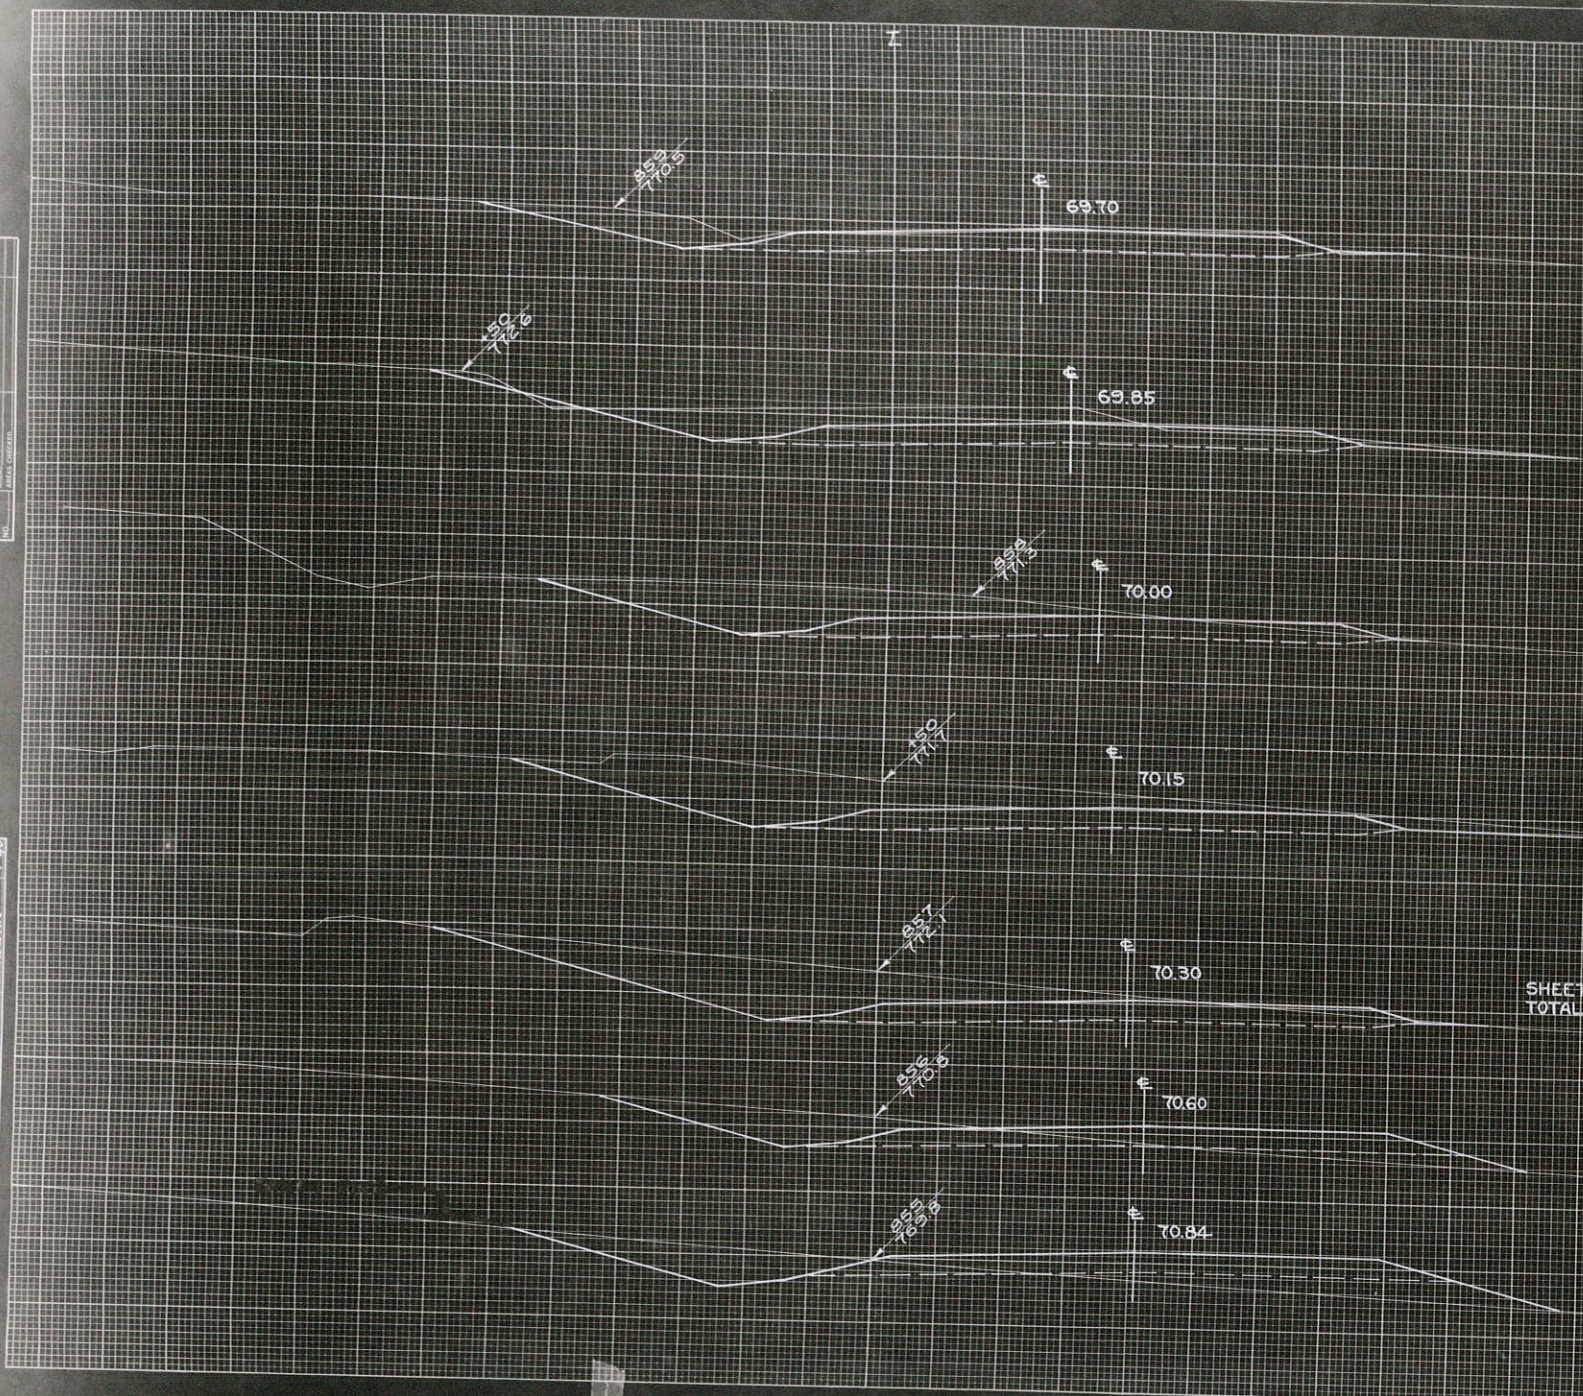

STATION	SAND FILL AREA	YARDAGE	C.Y.	STEP SLOPES	END AREA			YARDAGE					
					COMMON	ROCK	FILL	COMMON	ROCK	TOTAL	FORM FILL		
67	246				854	72	13						
66	246				855	57	41	100	239		239	100	
67	248				856	66	12	100	228		228	98	
67	124				857	188	0	100	470		470	15	
67	124				+50	218	0	50	376		376	0	
67	124				858	157	0	50	348		348	0	
67	124				+50	136	2	50	272		272	2	
67					859	99	1	50	219		219	4	
SHEET TOTAL					1236								
					856+30 P.E. LT.				90		90	35	
					STA. 859+00 P.E. LT.				30		30	40	
SUB TOTAL - MILE													
SHEET TOTAL									2272		2272	294	

ORIGINAL DRAWING
 DATE: 1-1-50
 BY: L. C. A. D. L. R.
 CHECKED: R. L. R.
 NO. 8227

ORIGINAL DRAWING
 DATE: 1-1-50
 BY: L. C. A. D. L. R.
 CHECKED: R. L. R.
 NO. 8227

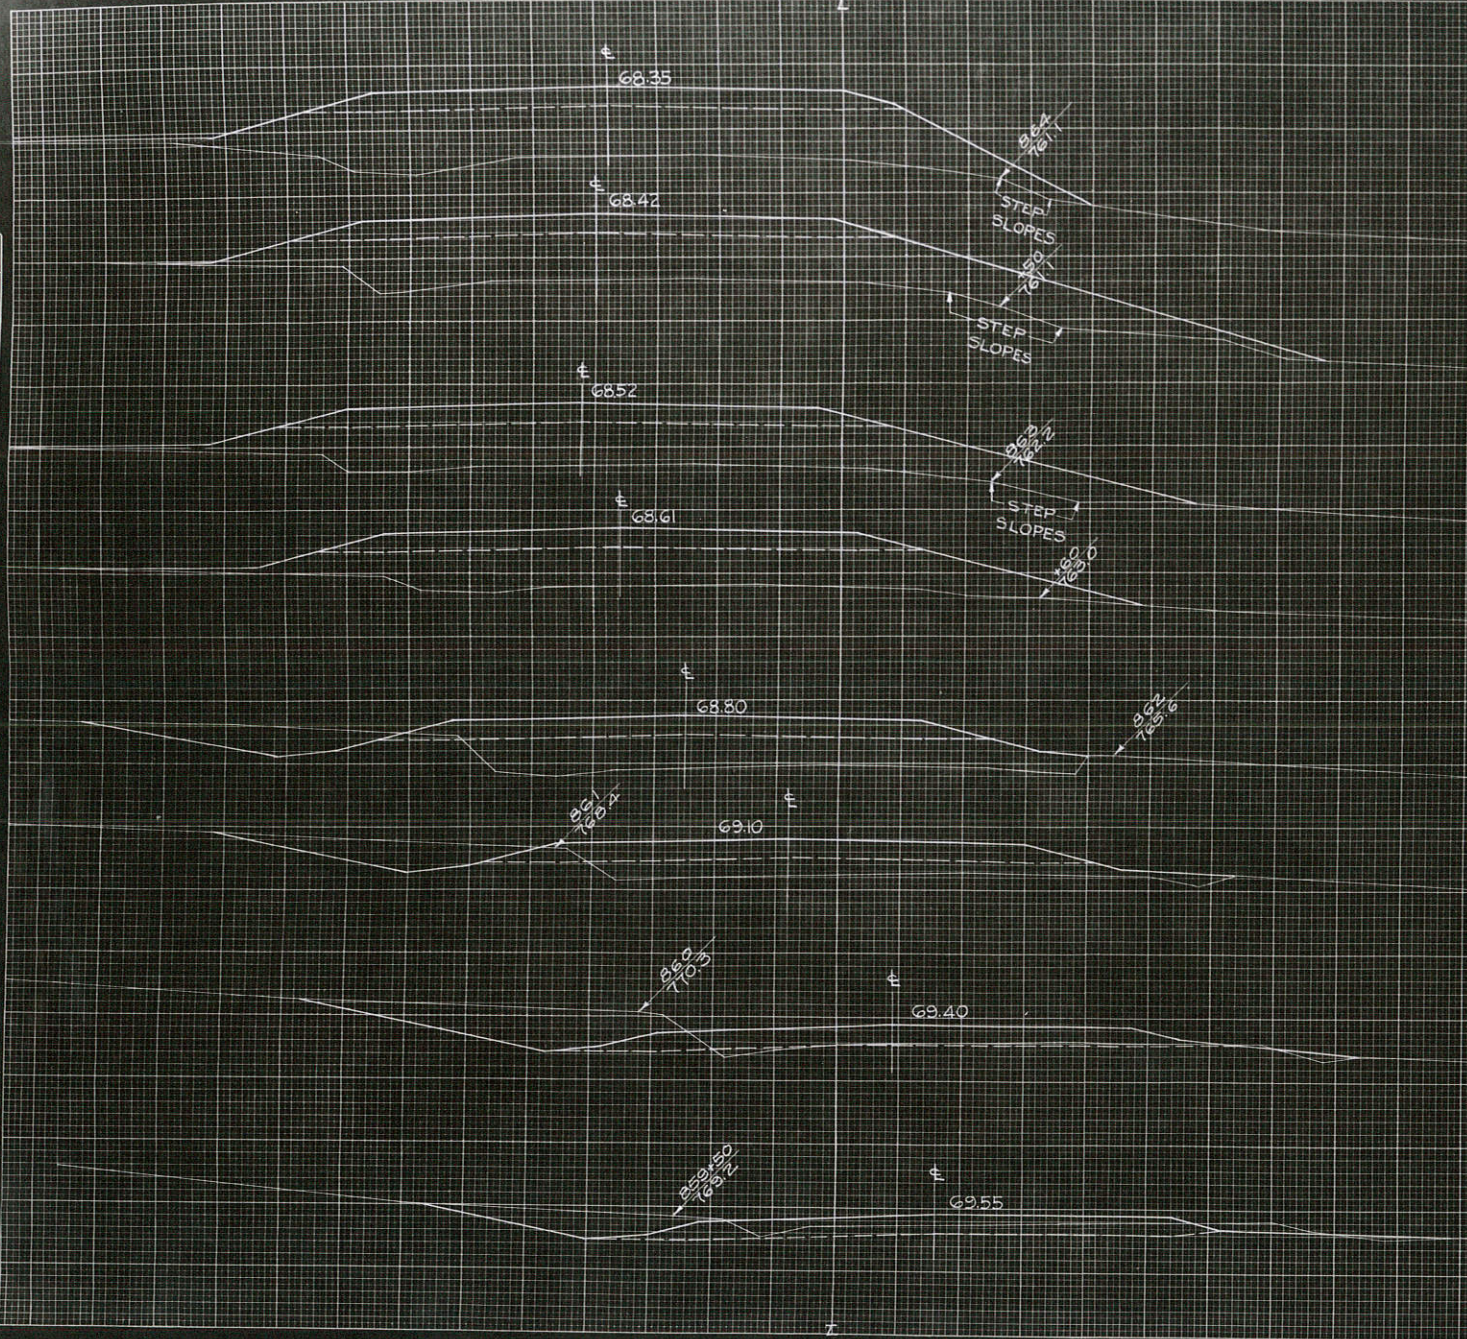

C.Y. COMP. EMB.	SAND IN END AREA YARDAGE	C.Y. STEP SLOPES	STATION	END AREA			DISTANCE	YARDAGE					
				EXCAVATION		FILL		EXCAVATION			TOTAL FILL		
				COMMON	ROCK			COMMON	ROCK	TOTAL			
67	124		859 99		1								
67	126		+50 76		2 50 ⁸				163		163	2	
68	250		860 83		9 50 ¹				148		148	11	
66	246		861 44		57 100 ⁴				237		237	122	
391	330		862 38		121 100 ⁶				152		152	331	
66	146		+60 0		175 60 ³				19		19	330	
285	96	2	863 0		220 39 ¹				0		0	285	
66	430	6	+50 0		254 49				0		0	430	
66	459	7	864 0		243 50				0		0	459	
66													
			SHEET TOTAL	1230									
			15										

1835

SUB TOTAL - MILE _____
SHEET TOTAL 719 1970

DATE: _____ BY: _____
DRAWN BY: _____ CHECKED BY: _____
NOTED BY: _____
NO. 8137


DATE: 1-29-34 BY: L. J. M.
DRAWN BY: L. J. M. CHECKED BY: L. J. M.
NOTED BY: L. J. M.
NO. 8137

END OF MILE NO. 6, STA. 864+00
 C=6646 CY (6575 CY
 71 CY STEP SLOPES (NOT INCL. IN YARD. BAL.)

F=13020 CY (4352 CY @ NO. 5HG, 4200 CY @ 20% SHG, 4368 CY @ 25% SHG)

SANDFILL = 7211 CY @ 5% SHG
 OBTAIN FROM MILE NO. 7 (4045 CY COMMON) FOR RE-USE
 (4352 CY ROCK)
 OBTAIN FROM MILE NO. 7 - 7571 CY ROCK FOR SANDFILL

SPEC. COMP. EMB. - 6411 CY

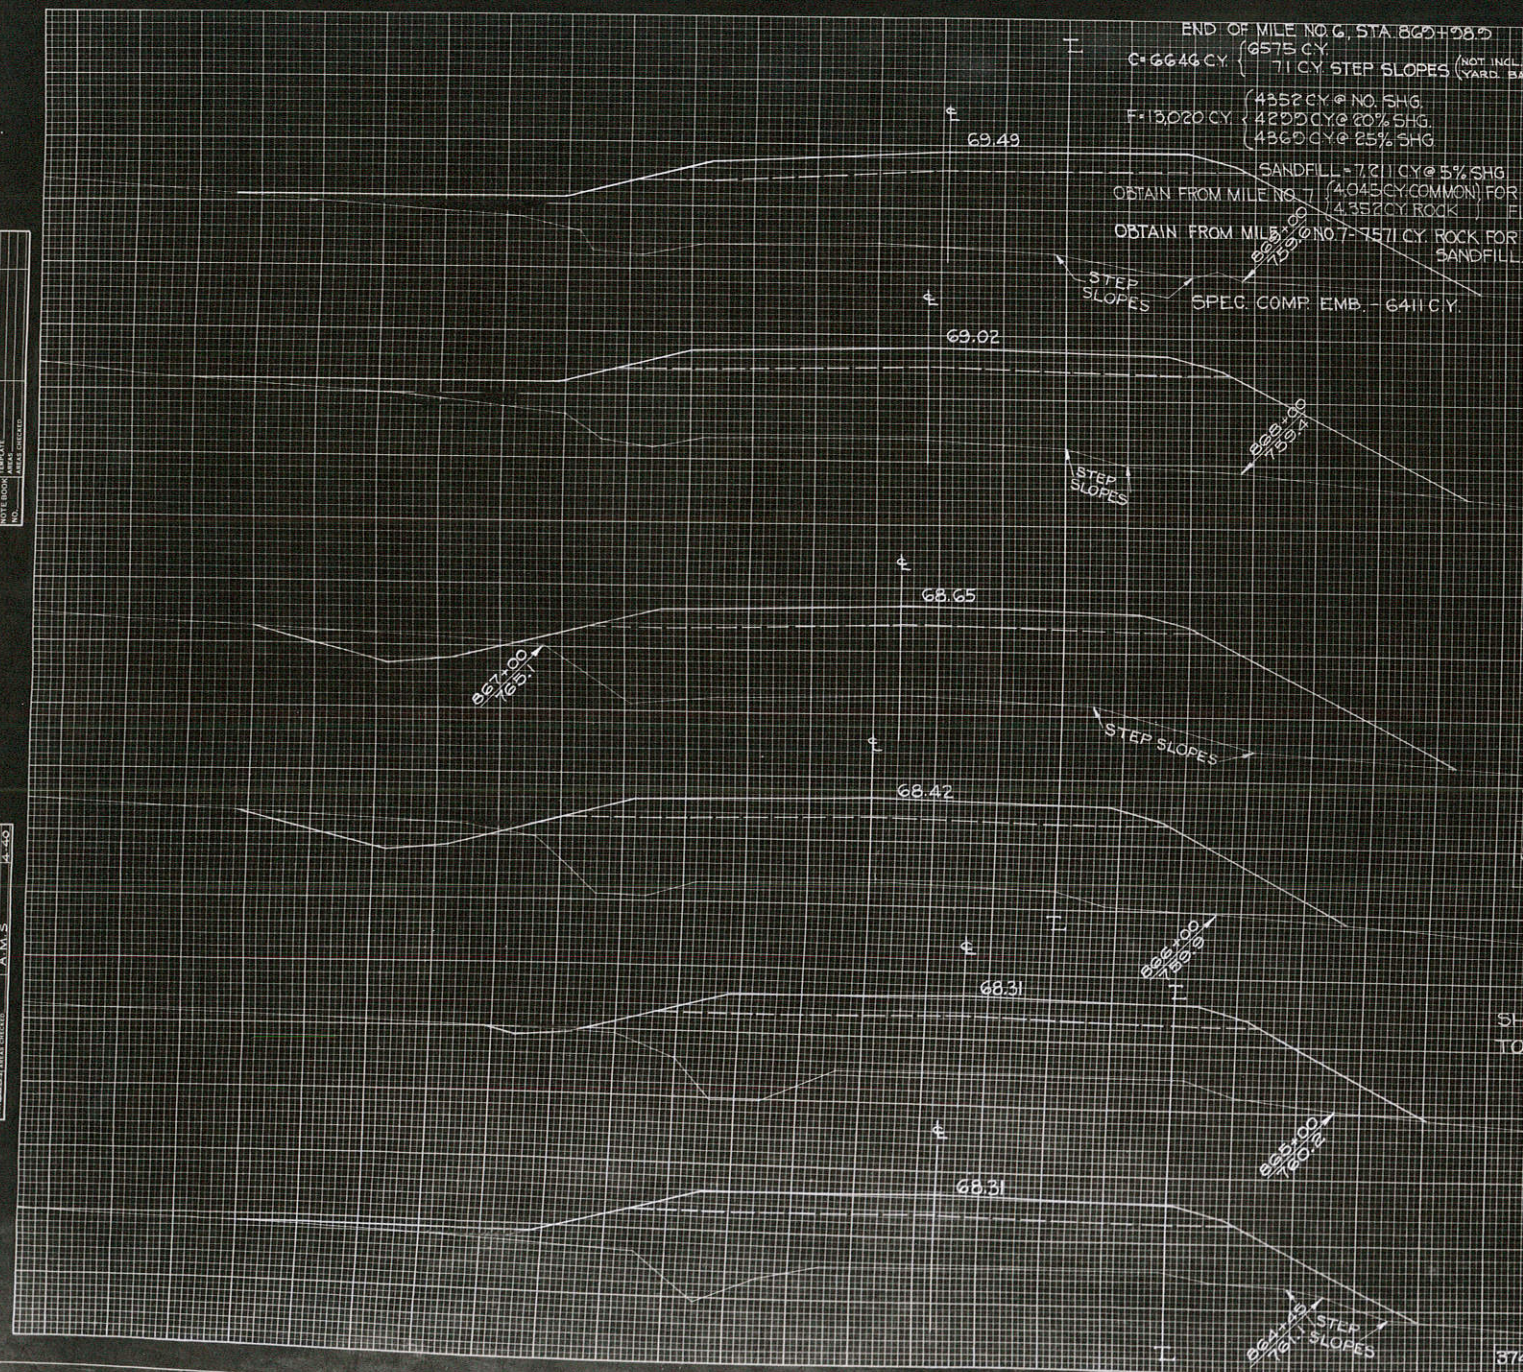


C.Y. COMP. EMB.	SAND FILL	STATION	END AREA		DISTANCE	YARDAGE		
			EXCAVATION	FILL		COMMON	ROCK	TOTAL
		864 0		243				
417	109	6						
		+45 0	258	45	0	0	417	
543	135	4			4	4	543	
		865 3	275	55				
744	244	0			61	61	1096	
		866 30	317	100				
339	244	9			107	107	1339	
		867 28	406	100				
526	244	15			28	28	1526	
		868 0	418	100				
598	244	11			0	0	598	
		869 0	445	100				
574	244	11			0	0	574	
		869 0	405	98				
		867+00 EARTH DAM RT	0			0	225	
		867+00 CATTLE RAMPLT	70			70	0	
		SHEET TOTAL	1464				750	
		869+00 PE RT.						
		56						
		374.1						
		SUB TOTAL - MILE						
		SHEET TOTAL			270		270	9068

FINAL SURVEY NOTE BOOK NO. DATE

ORIGINAL SURVEY NOTE BOOK NO. DATE

SCALE : 1" = 10'

SAND FILL	END AREA YARD-AGE	C.Y. STEP SLOPES	STATION	END AREA			DISTANCE	YARDAGE						
				EXCAVATION		FILL		EXCAVATION			TOTAL	SOFTEN FILL		
				COMMON	ROCK			COMMON	ROCK					
	68		873 +50	245	0	20								
	126									743	0		743	11
	68		874 +50	555	0	4	50'							
	126									1320	356		1676	22
	68		+50	872	353	20	50							
	102									1323	2007		3330	35
	42		875 +50	556	175	18	50							
	78									1156	4759		5915	24
	42		+50	691	3355	8	50							
	78									1380	7009		8389	7
	42		876 +50	800	4215	0	50							
				SHEET TOTAL		510								

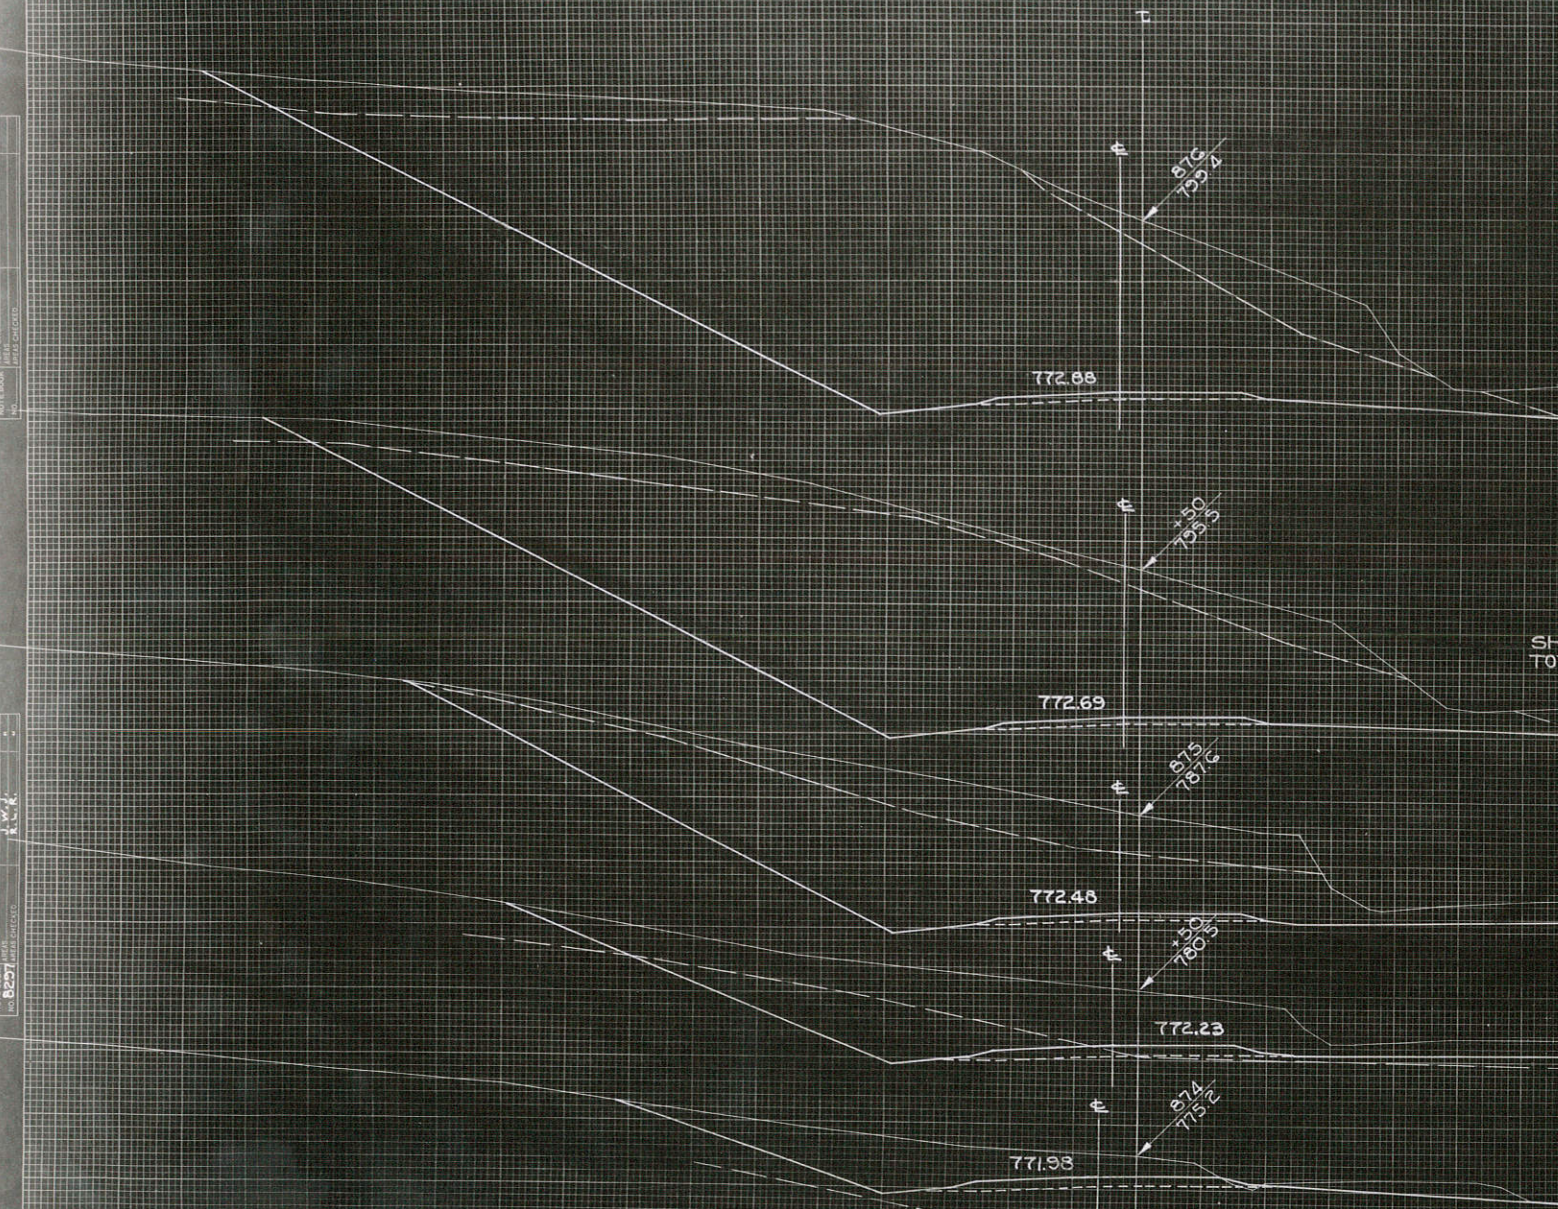

FINAL SURVEY PLOTTED
 NOTE BOOK NO. 8257
 DATE CHECKED


ORIGINATOR SURVEY NO. 8257
 SURVEYOR J.W. R.G.
 CHECKED J.W. R.G.
 DATE 1-31-38

SCALE : 1" = 10'

SUB TOTAL - MILE _____
 SHEET TOTAL 5922/4131 20053 99

DIVISION JOB NO. 5113

SCALE 1"=10'

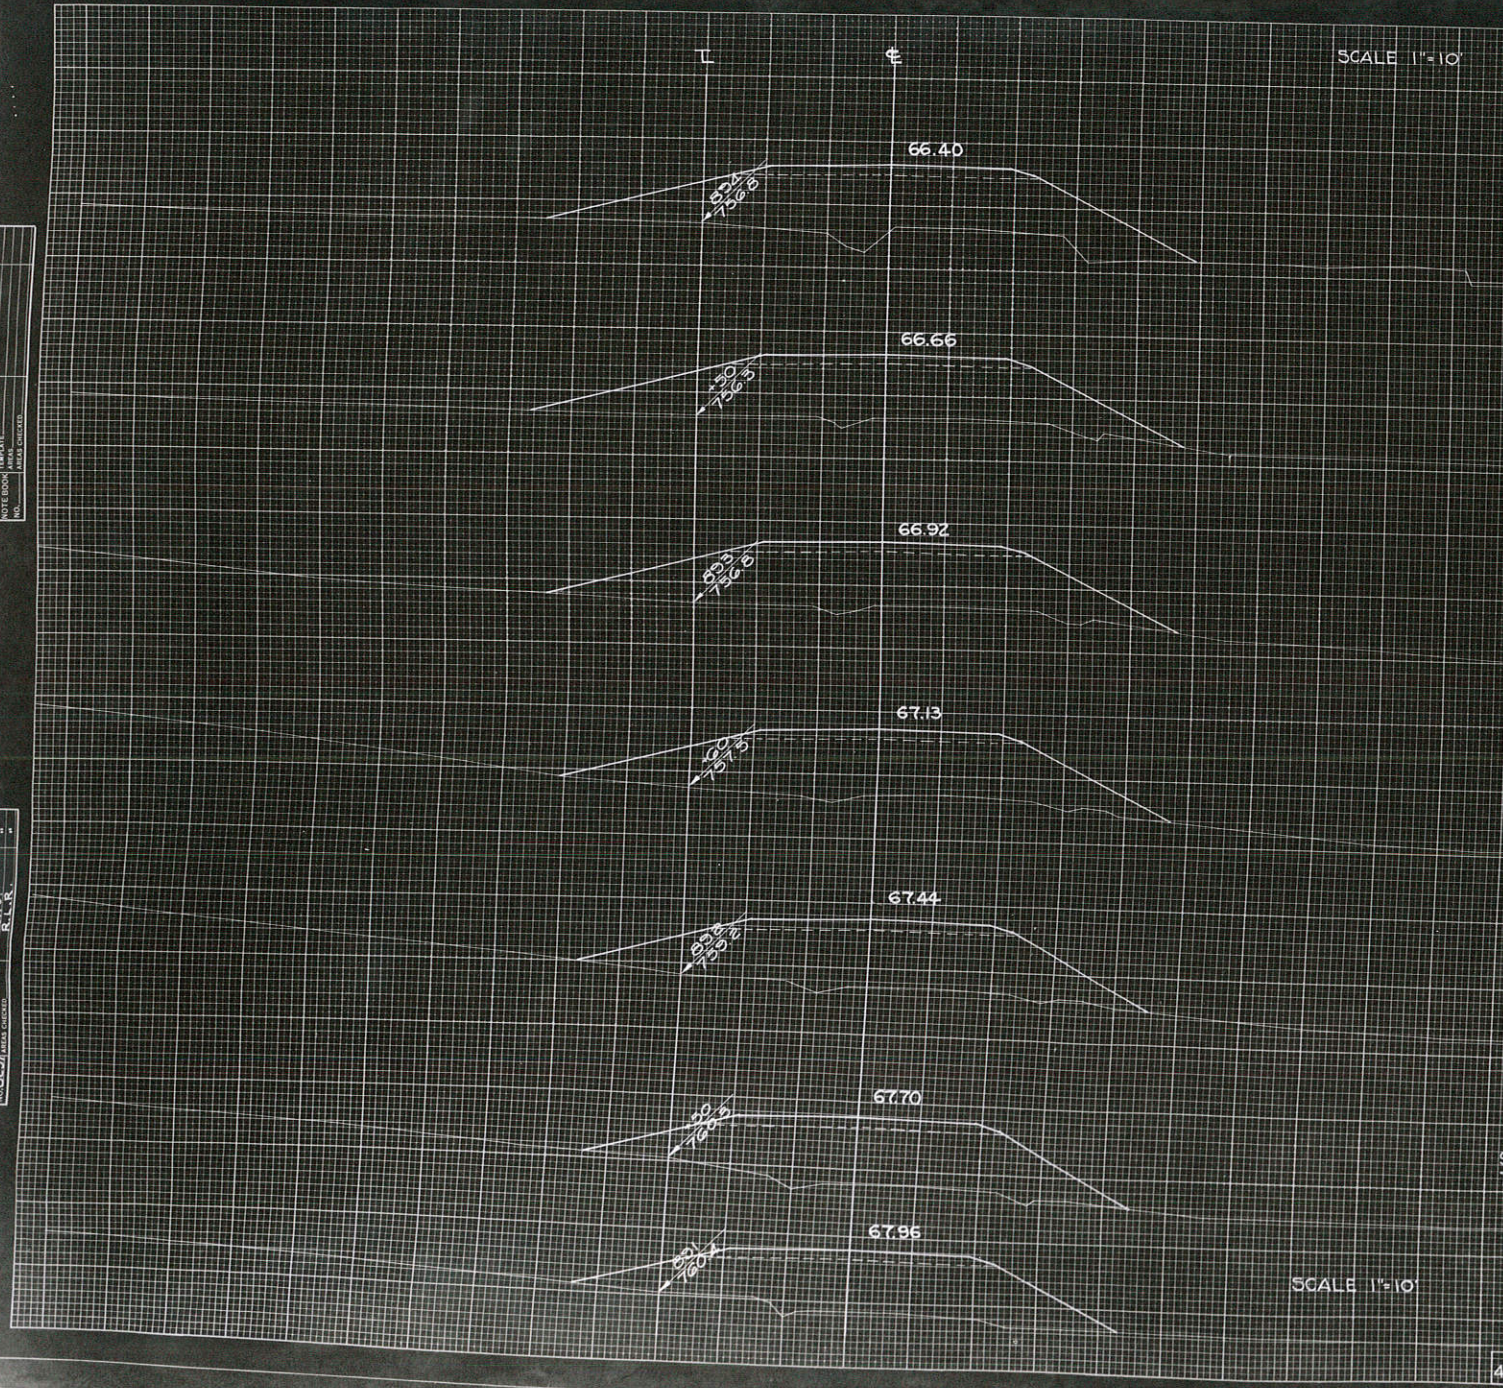


C.Y.	COMP. EMB.	SAND FILL	C.Y.	STEP SLOPES	STATION	END AREA			YARDAGE			
						COMMON	ROCK	FILL	EXCAVATION		TOTAL	#OFF-#FILL
END AREA	YARDAGE	COMMON	ROCK	FILL	COMMON	ROCK	FILL	COMMON	ROCK	TOTAL	#OFF-#FILL	
68					890 0		456					
733	250							0		0	1789	
67					891 0		510 100					
467	124							0		0	967	
67					+50 0		534 50					
548	124							0		0	1048	
67					892 0		597 50					
374	148							0		0	1374	
67					+60 0		639 60					
463	100							0		0	963	
67					893 0		662 40					
722	124							0		0	1222	
67					+50 0		657 50					
761	124							0		0	1261	
67					894 0		705 50					
SHEET TOTAL	994				894+00	SP. DITCH RT		85		85	0	
SUB TOTAL - MILE												
SHEET TOTAL								85		85	8624	

SCALE 1"=10'

4124

FINAL SURVEY REPORT
NOTE BOOK NO. 101
DATE

ORIGINAL SURVEY REPORT
NO. 101
DATE 1-20-50
BY L.C.A. & J.S.
CHECKED J.S. & R.L.R.

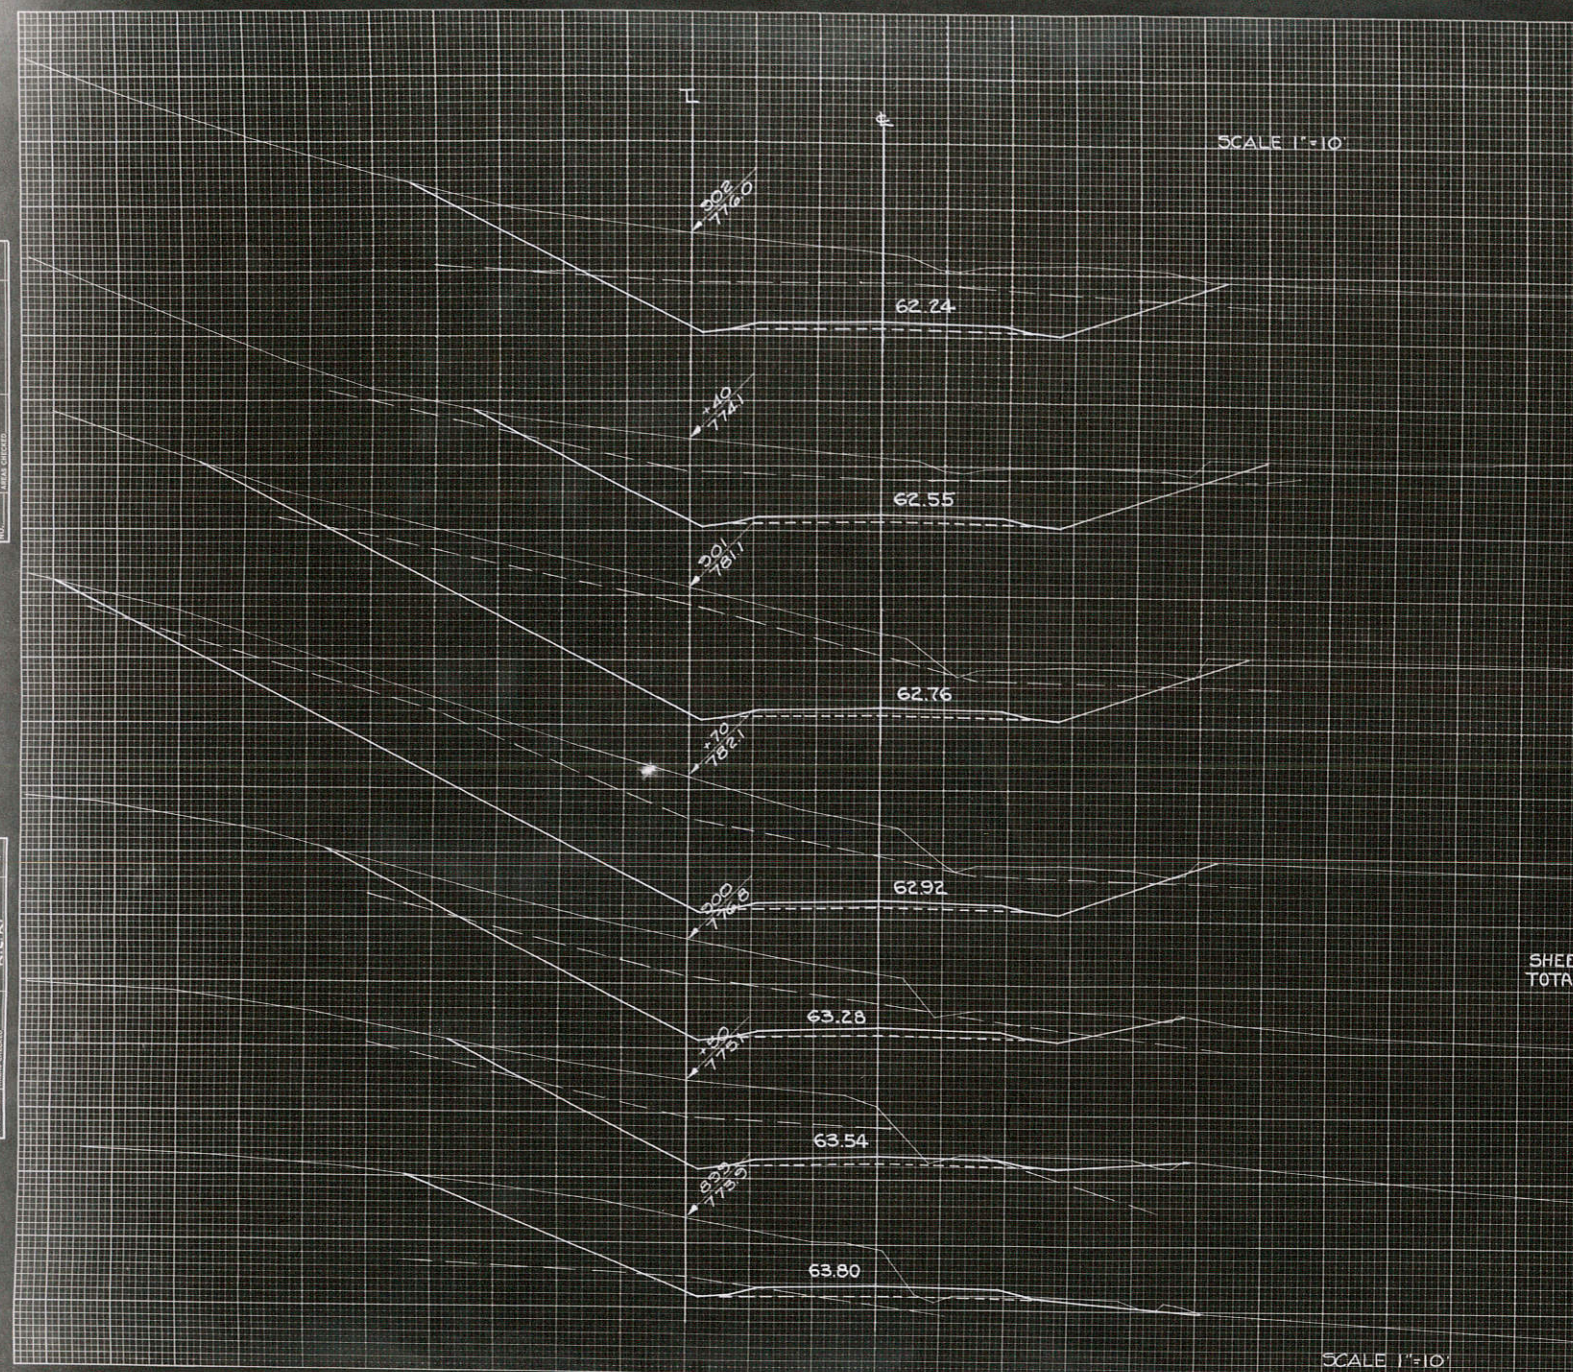

STATION	SAND FILL	CITY	SLOPES	END AREA			DISTANCE	YARDAGE						
				EXCAVATION	EXCAVATION	EXCAVATION		EXCAVATION	EXCAVATION	EXCAVATION	EXCAVATION	EXCAVATION		
68	36			898	856	144								
68	102			899	561	39	1	40		239	11	250	7	
42	78			+50	323	337	0	C.50 F.30		819	348	1167	0	
42	109			900	482	482	0	50		745	759	1504	0	
42	46			+70	572	1258	0	70		1366	2256	3622	0	
42	63			901	419	1121	0	30		550	1322	1872	0	
42	93			+40	350	594	0	40		571	1270	1841	0	
42				902	618	521	0	60		1076	1239	2315	0	


SHEET TOTAL 527

SUB TOTAL - MILE _____
SHEET TOTAL 53667205 12571 7

FINAL SURVEY
DATE _____
BY _____
REVISIONS
NO. _____

ORIGINAL SURVEY
DATE _____
BY _____
REVISIONS
NO. _____

SCALE 1"=10'

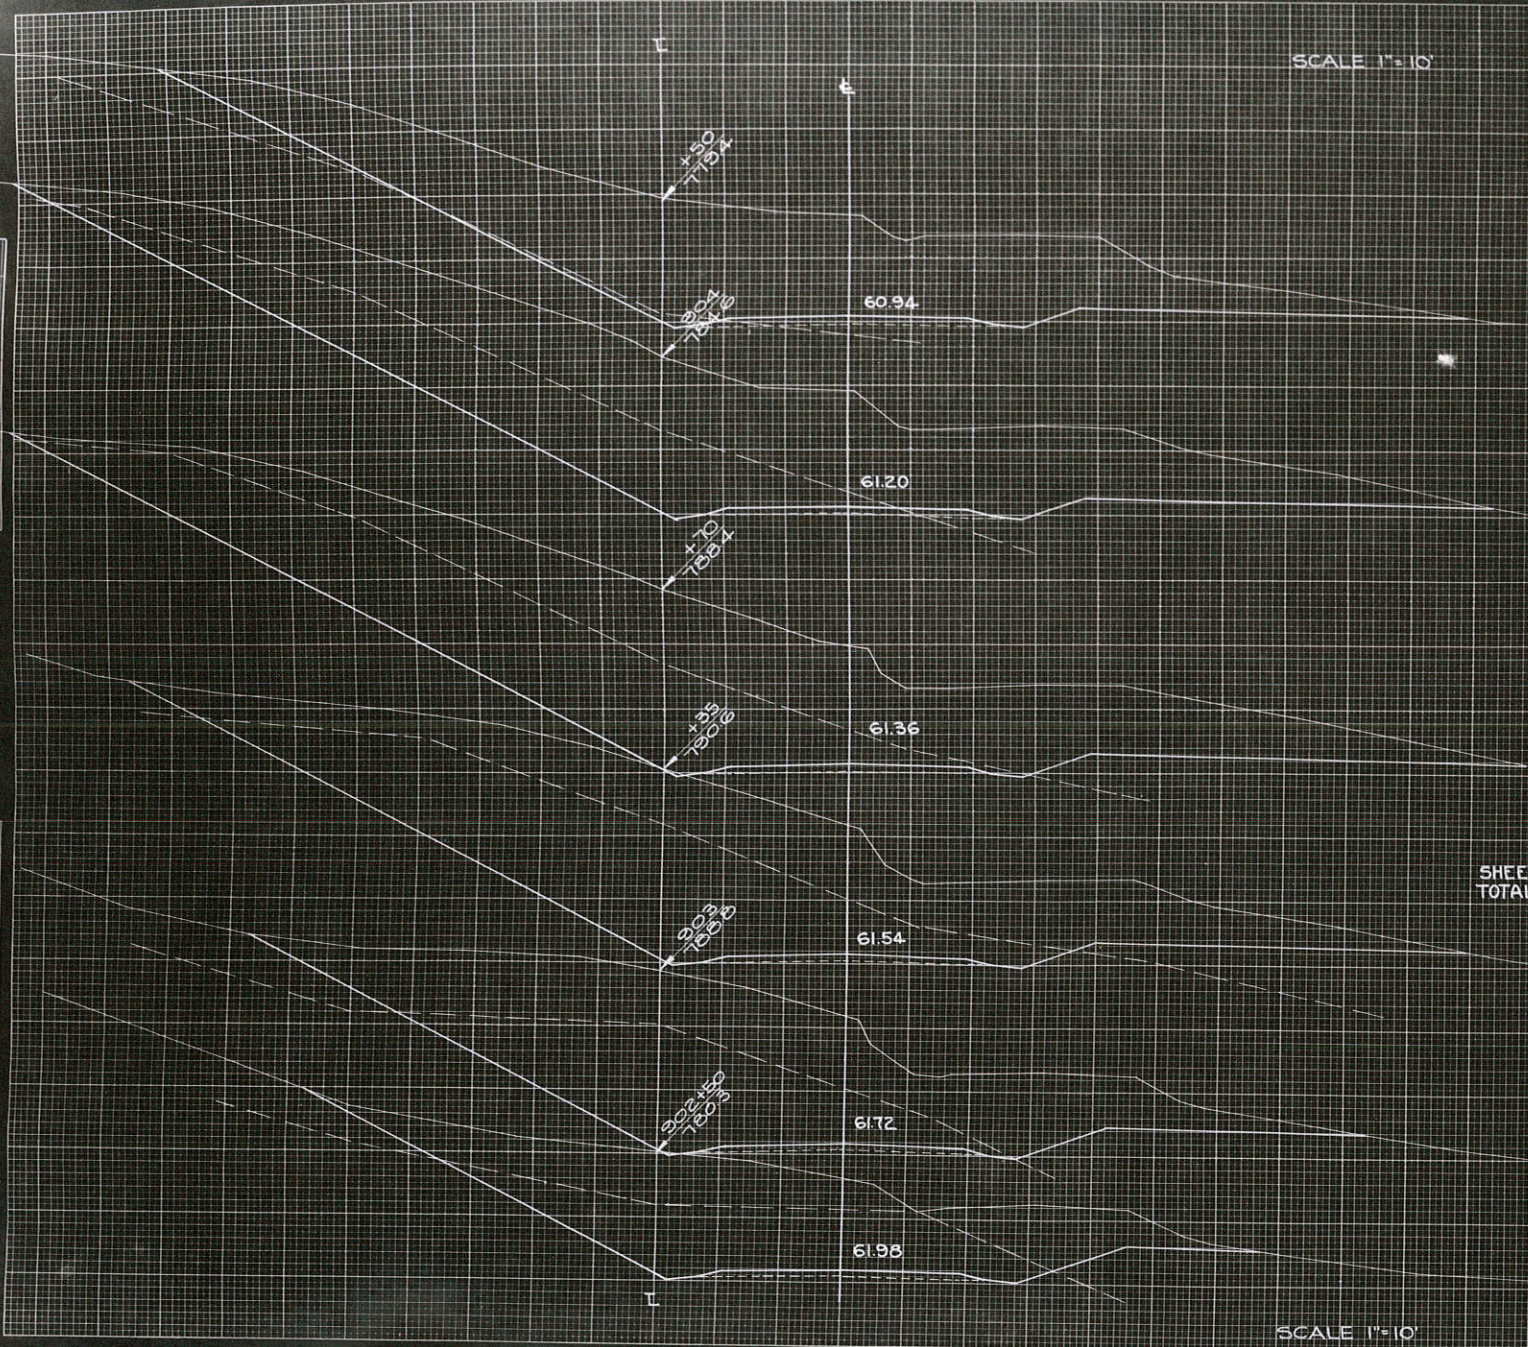

END AREA SAND YARDAGE	CY STEP SLOPES	STATION	END AREA			YARDAGE		
			COMMON	ROCK	FILL	COMMON	ROCK	TOTAL
		902	618	521	0			
42		78				1317	1209	2526
		42	+50	805	785	0	50	
42		78				2048	1663	3711
		42	903	1408	1010	0	50	
		54				1815	1731	3546
		42	+35	1391	1662	0	35	
		54				2653	2180	4233
		42	+70	1776	1702	0	35	
		52				2115	1563	3678
		50	904	2028	1113	0	30	
		109				3889	1978	4867
		68	+50	2172	50	0	50	
SHEET TOTAL		425						

SHEET TOTAL 425

SCALE 1"=10'


SUB TOTAL MILE _____

SHEET TOTAL 13237 9424 22661 0

FINAL SURVEY
 DRAWING NO. 2021146
 DATE 11/13/13

ORIGINAL SURVEY
 DRAWING NO. 2021146
 DATE 11/13/13

SCALE 1" = 10'

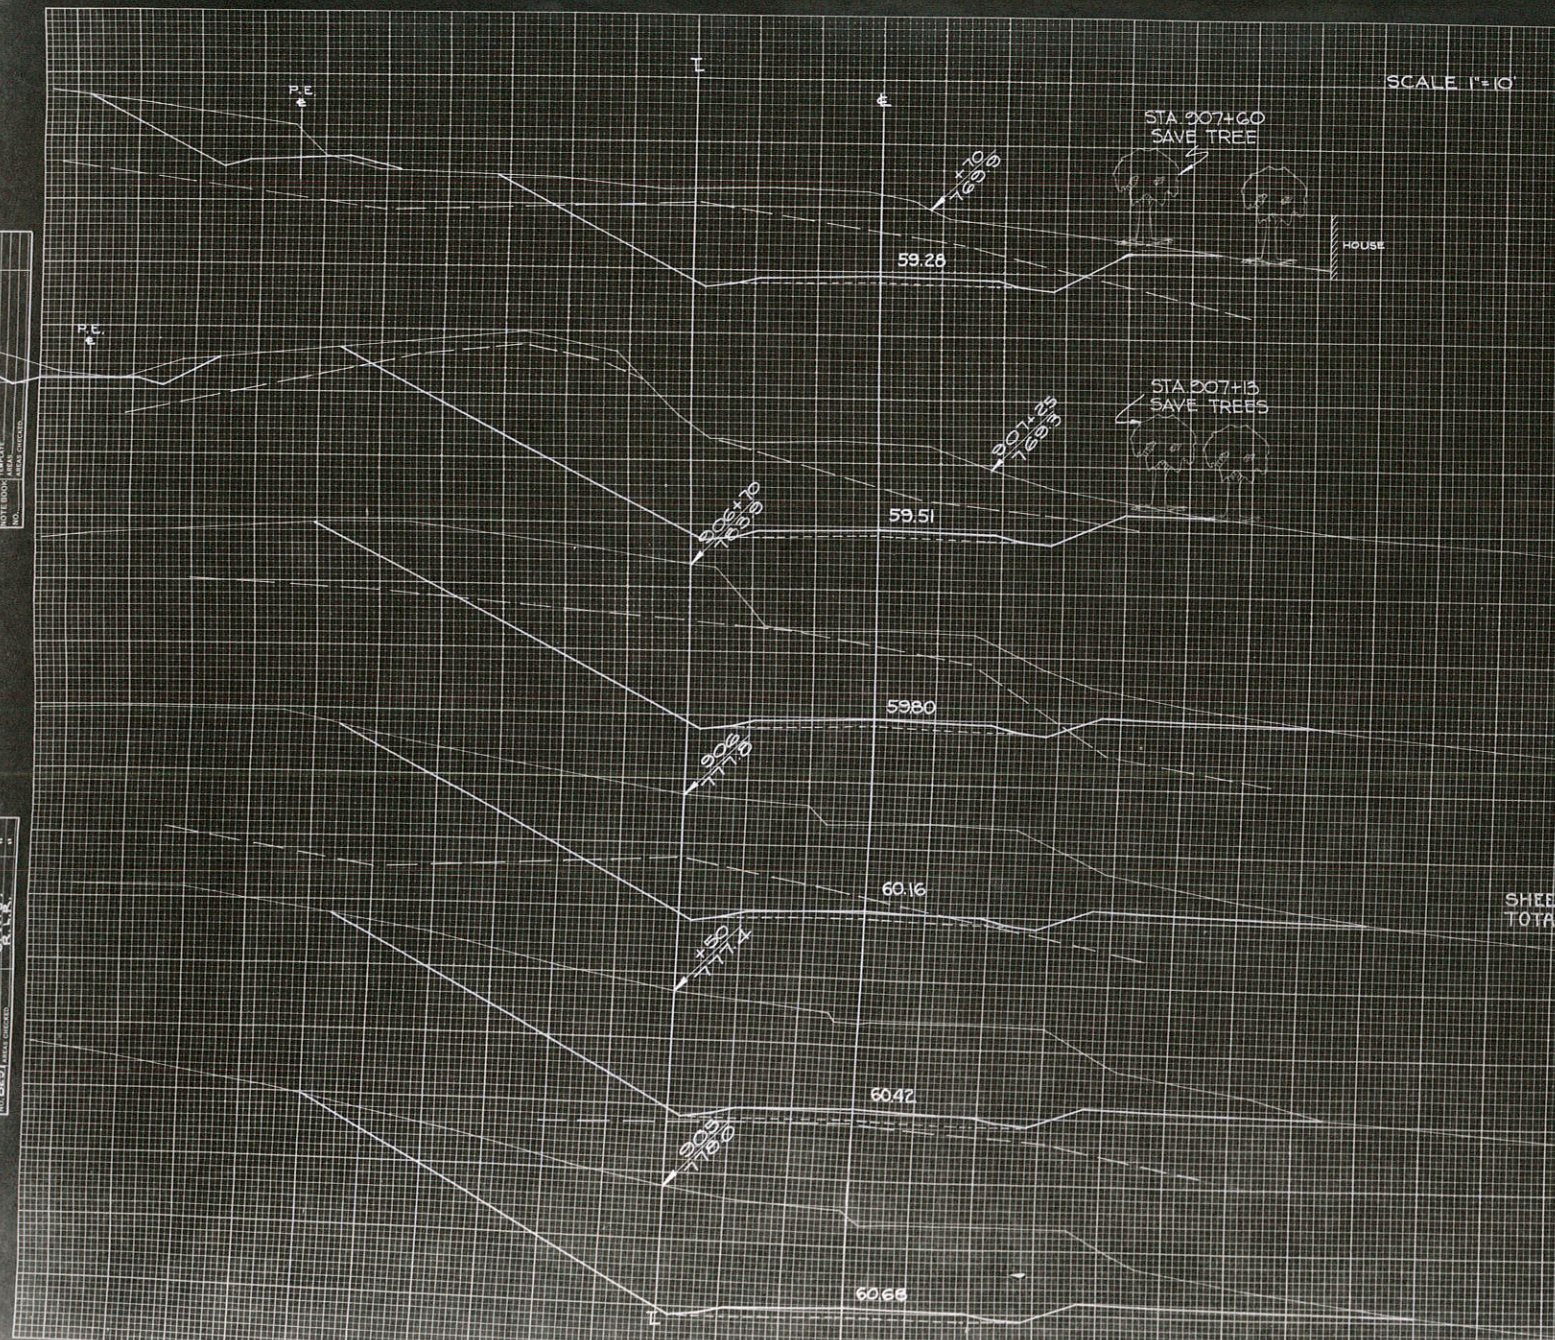

END AREA	SAND FILL YARDAGE	C.Y.	STEP SLOPES	STATION	END AREA			DISTANCE	YARDAGE				
					COMMON	ROCK	FILL		COMMON	ROCK	TOTAL	TOTAL FILL	
68				904	2172	50	0						
	126			+50				3660	46	3706	0		
68				905	1780	0	0	50					
	126			+50	1687	0	0	50	3211	0	3211	0	
68				102					2816	265	3081	0	
42				906	1356	286	0	50					
	109			+70	850	1023	0	70	2860	1696	4556	0	
42				85					1463	2230	3693	0	
	70			907	587	1166	0	55	580	1498	2478	6	
42				+70	589	632	7	45					

SHEET TOTAL 618

SCALE 1" = 10'


SUB TOTAL - MILE _____
 SHEET TOTAL 14,390,5735 20,725 6

FINAL SURVEY PHOTO NO. _____
 NOTE BOOK NUMBER NO. _____
 AREA CHECKED _____

ORIGINAL SURVEY PHOTO NO. _____
 NO. 5113 AREA CHECKED _____

SCALE: 1" = 10'

FED. ROAD DIST. NO.	STATE	FED. AID NO.	SHEET NO.	TOTAL SHEETS
4	WISC.	2012	149	193
DIVISION JOB NO. 5713				

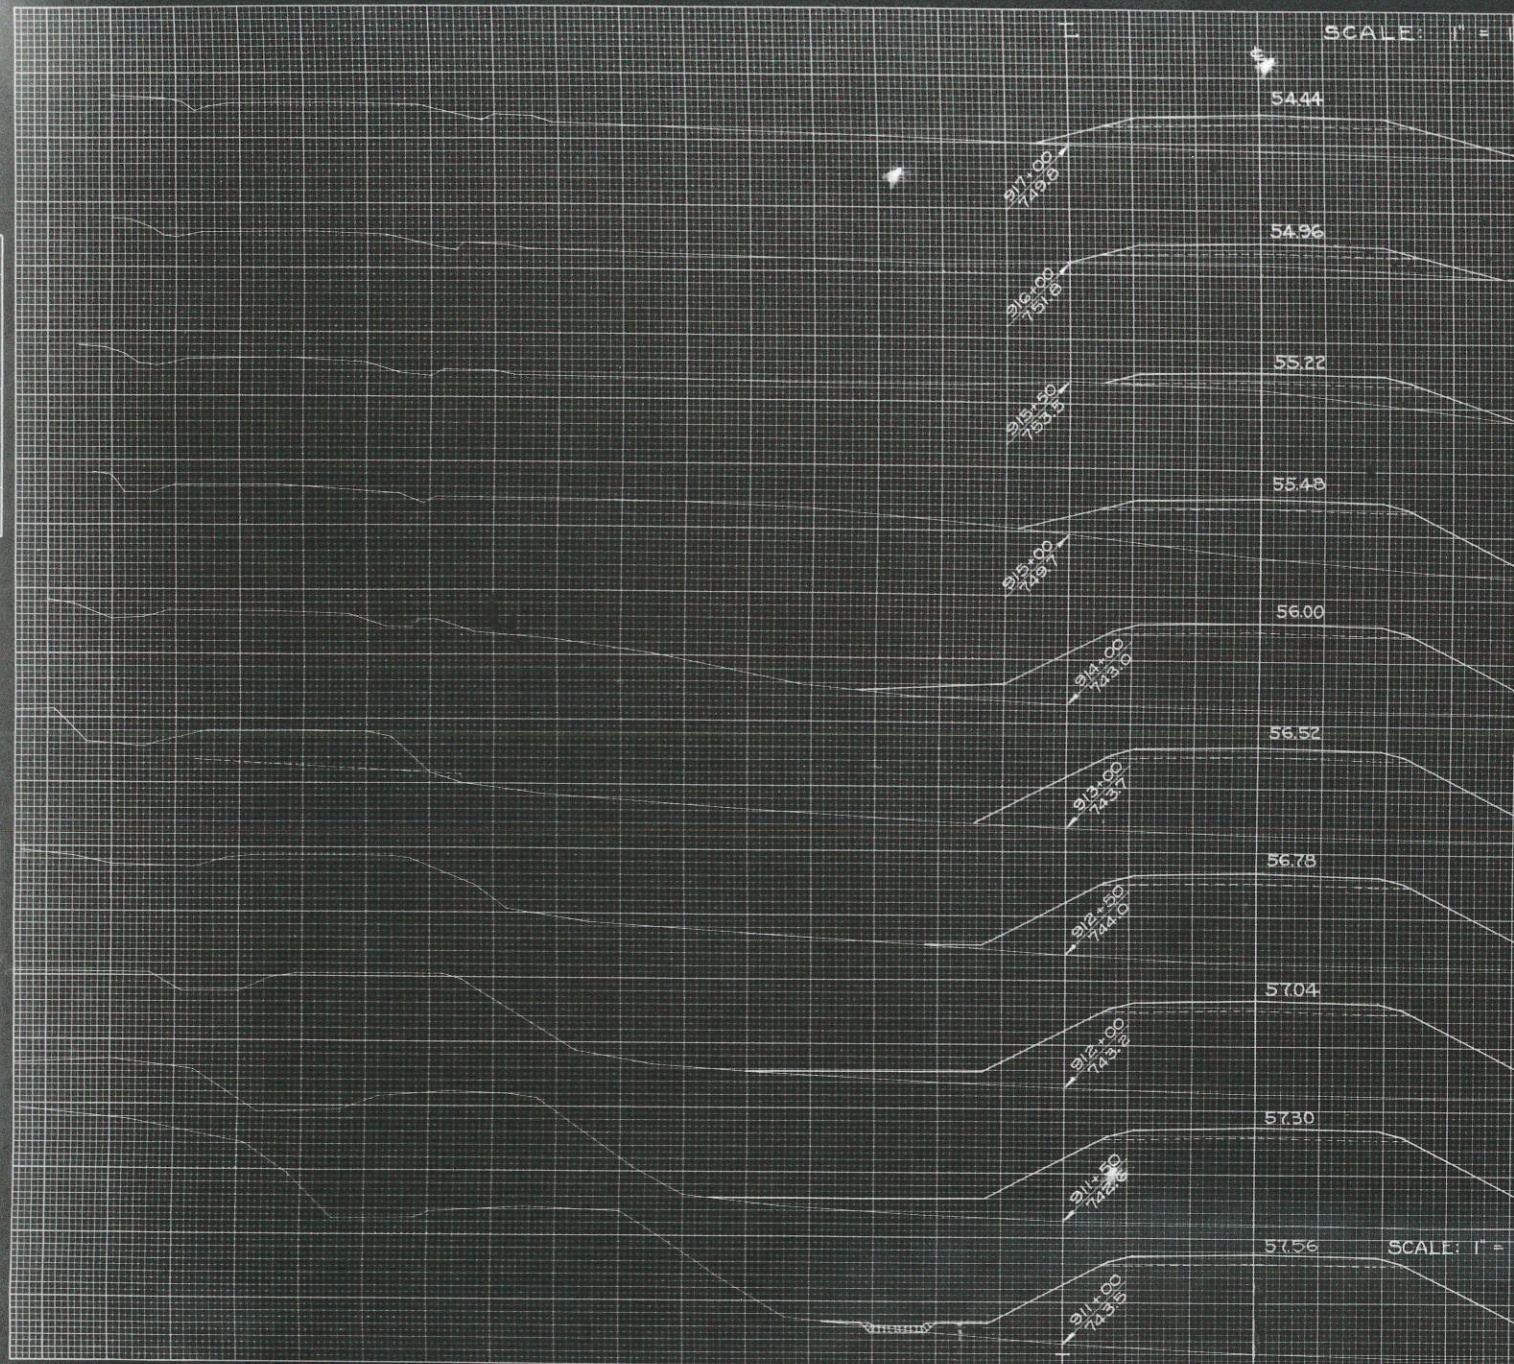

CY COMP. EMB.	SAND TILT	CY SLOPES	STATION	END AREA			YARDAGE		
				COMMON	ROCK	FILL	COMMON	ROCK	TOTAL
			910						
863	122		+50	0		994			
918	122		911	0		1018 50		0	1063
867	122		+50	0		1054 50		0	1919
693	122		912	0		962 50		0	1867
589	122		+50	0		866 50		0	1693
1144	244		913	0		849 50		0	1589
1463	244		914	0		849 100		0	3144
537	122		915	0		481 100		0	2463
193	122		+50	0		99 50		0	537
654	244		916	0		110 50		0	193
66			917	0		243 100		0	654
SHEET TOTAL						1586			
				SUB TOTAL - MILE					
				SHEET TOTAL		0		0	1532

DATE
BY
SURVEY
STATE
NOTE BOOK
NO.

DATE
BY
SURVEY
STATE
NOTE BOOK
NO.