


FED. ROAD DIST. NO.	STATE	STATE AID PROJ. NO.	SHEET NO.	TOTAL SHEETS
4	WIS.	5291	3	96

DIVISION JOB NO. 5291

RECEIVED
LAND TITLE/MAPPING
LA CROSSE COUNTY


JUN 1 1984

Dist 5
Copy

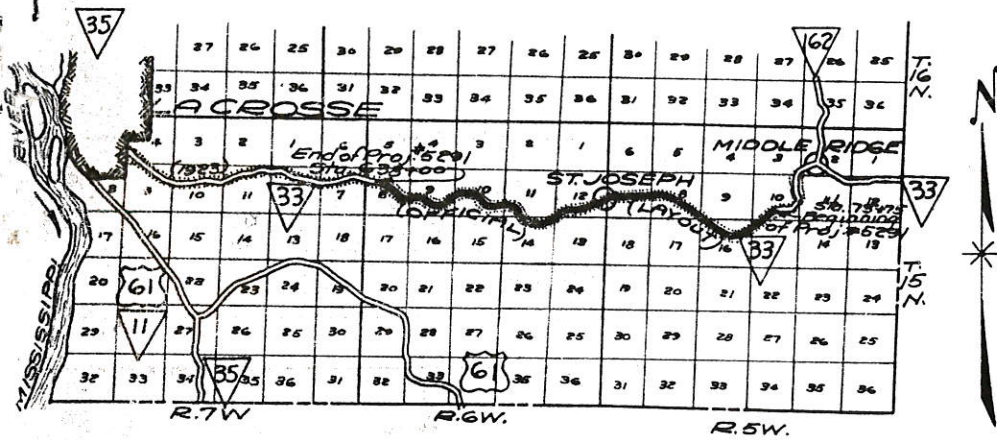

PLAN NO. 341



LOCATION SKETCH
SCALE: 3 MI.

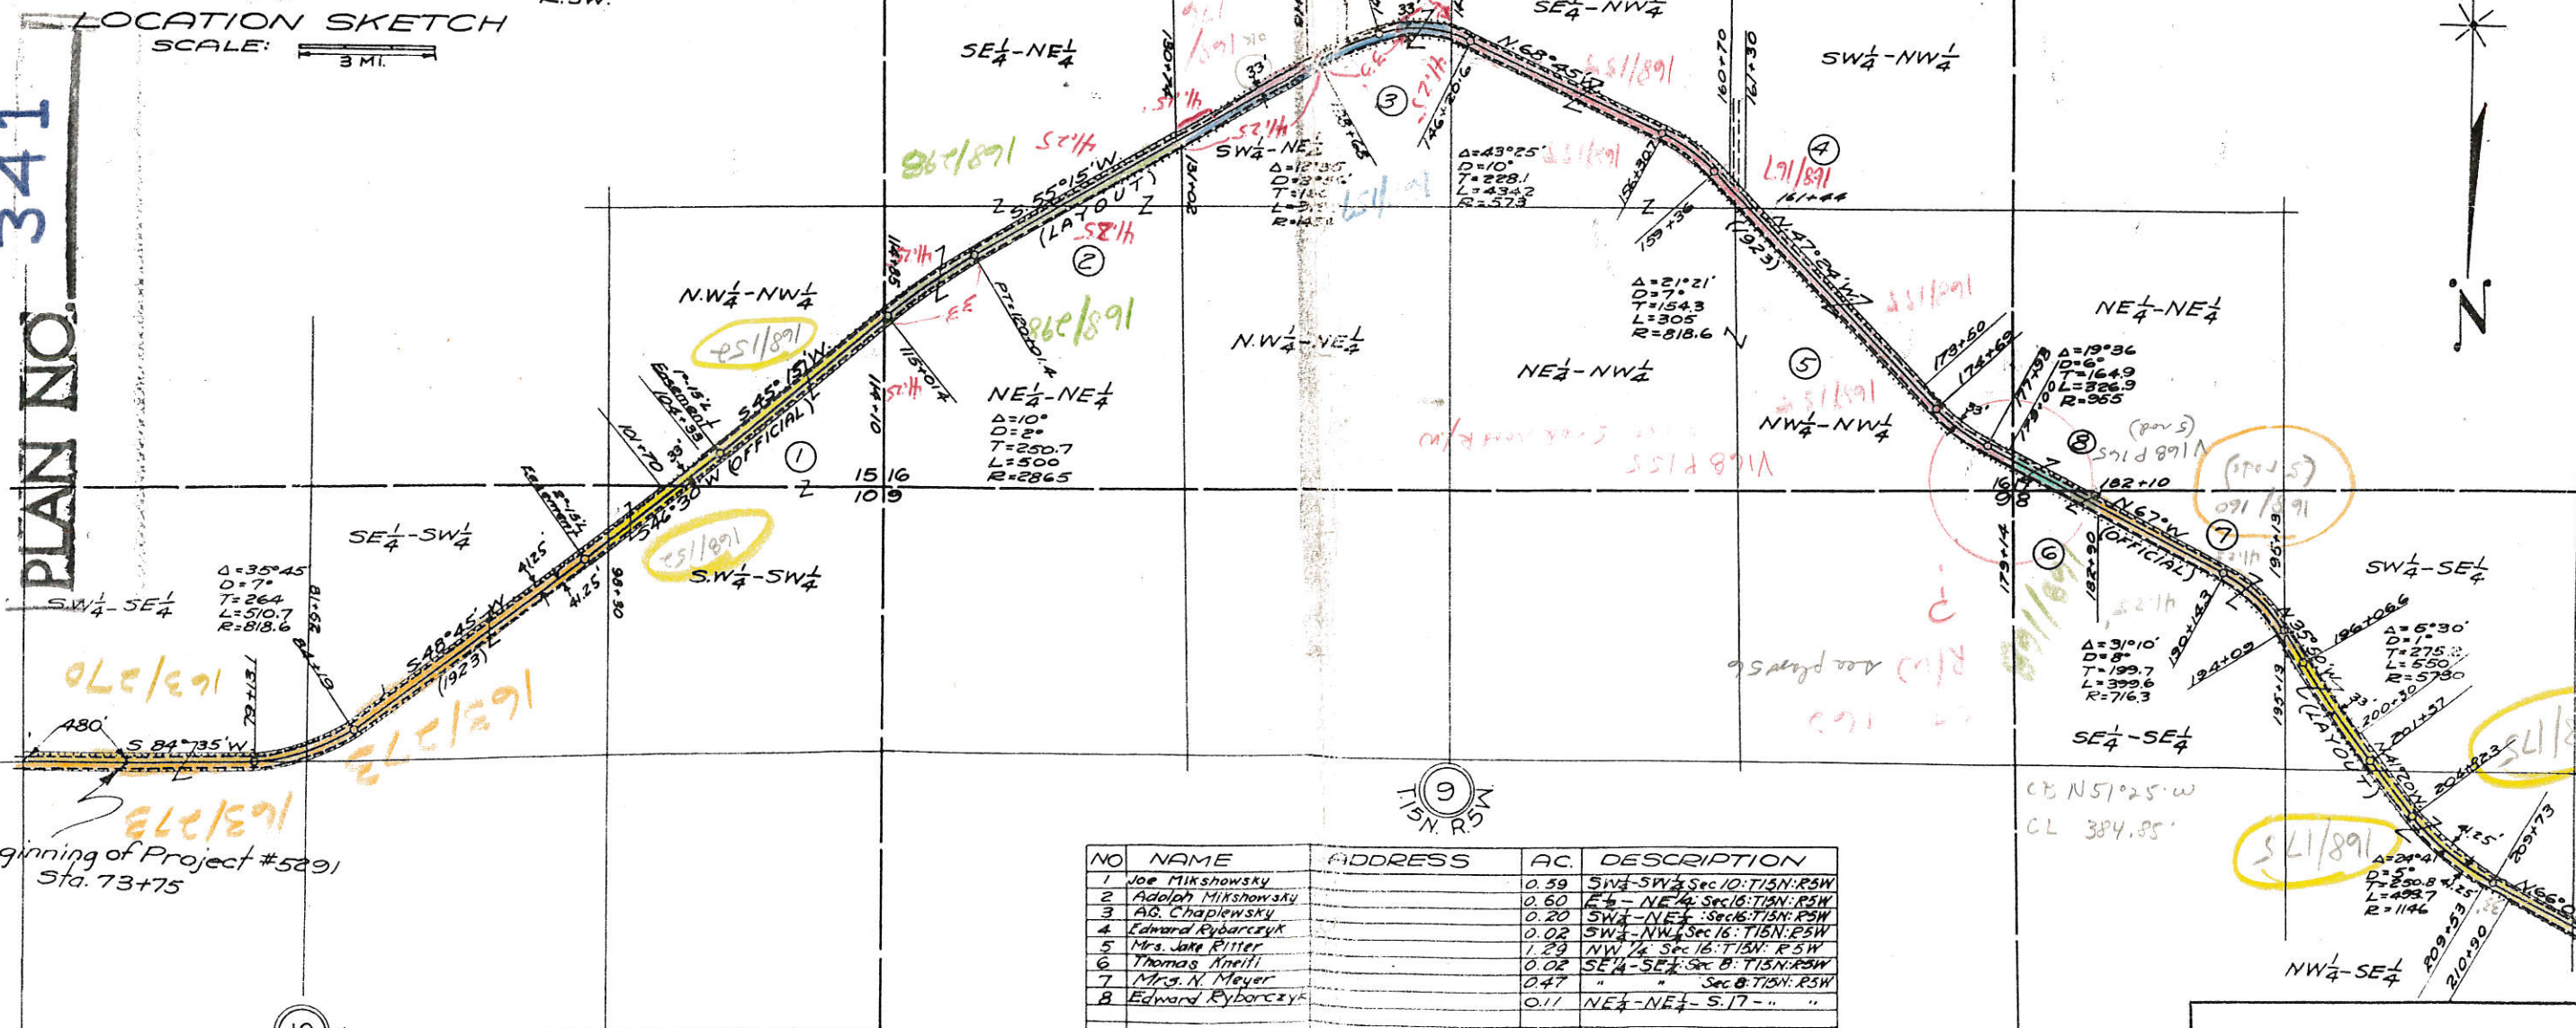

Beginning of Project #5291
Sta. 73+75

NO	NAME	ADDRESS	AC.	DESCRIPTION
1	Joe Mikshowsky		0.59	SW 1/4 SW 1/4 Sec 10: T15N: R5W
2	Adolph Mikshowsky		0.60	E 1/4 - NE 1/4 Sec 10: T15N: R5W
3	AG Chaplewsky		0.20	SW 1/4 - NE 1/4 Sec 16: T15N: R5W
4	Edward Ryborczyk		0.02	SW 1/4 - NW 1/4 Sec 16: T15N: R5W
5	Mrs. Jake Ritter		1.29	NW 1/4 Sec 16: T15N: R5W
6	Thomas Anelli		0.02	SE 1/4 - SE 1/4 Sec 8: T15N: R5W
7	Mrs. N. Meyer		0.47	" " Sec 8: T15N: R5W
8	Edward Ryborczyk		0.11	NE 1/4 - NE 1/4 - S. 17 - " "

PLAT OF RIGHT OF WAY REQUIRED
STATE AID PROJECT NO. 5291
MIDDLE RIDGE - LA CROSSE ROAD
S.T.H. #33 LA CROSSE COUNTY
SCALE 1000'

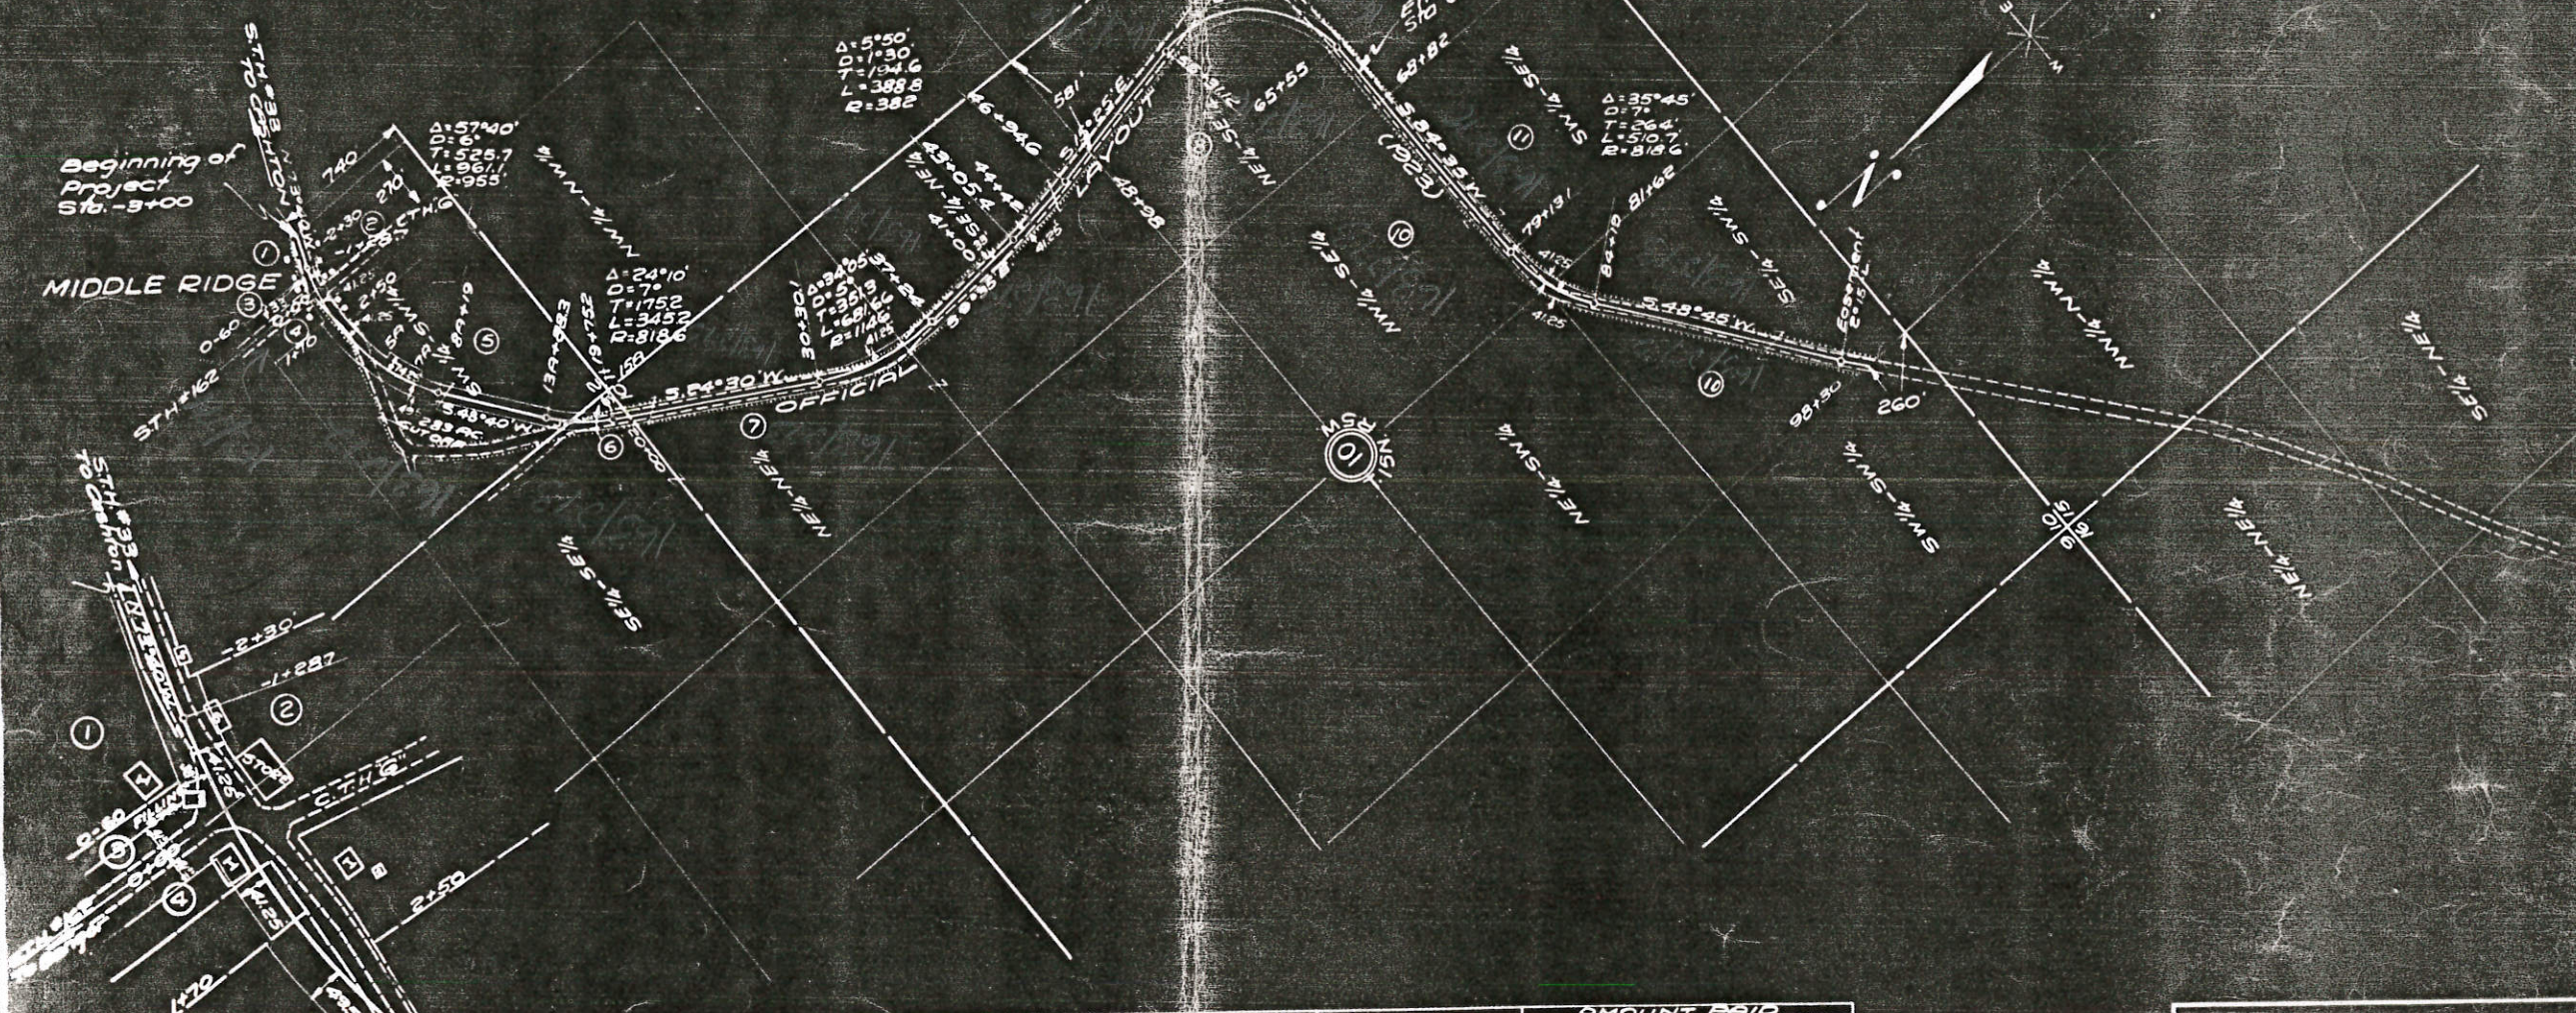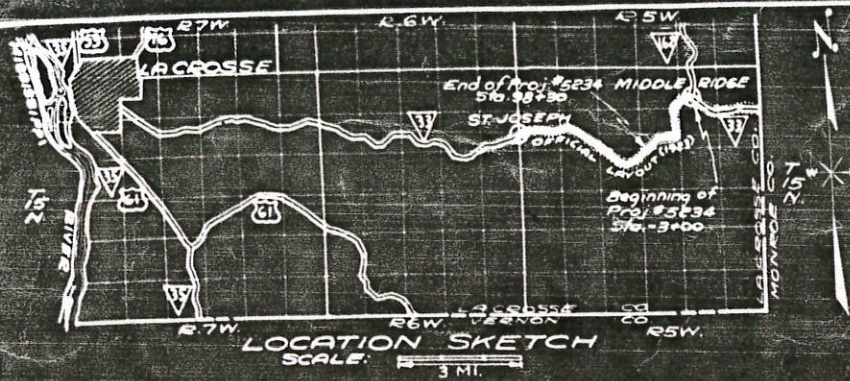

ENLARGED SKETCH OF MIDDLE RIDGE
Scale: 1" = 100'


NO	NAME	ADDRESS	AC	DESCRIPTION	MORTGAGEE	ADDRESS	AMOUNT PAID		REMARKS
							5/11/19	TOTAL PAID	
1	WM ARNEZ		0.03	SE 1/4 SW 1/4 S 2 T 15 N R 5 W					
2	PETE CAVADINI		0.03	" " " " " "					
3	BERT AICE		0.07	" " " " " "					
4	HENRY KLAS		0.33	SW 1/4 SW 1/4 - " " " "					
5	WM ELSER		0.0	SE 1/4 SE 1/4 S 3 T - " " " "					
6	PETER HUNDT		1.07	" " " " " "					
7	"		"	NE 1/4 - NE 1/4 S 3 T - " " " "					
8	"		"	SE 1/4 - NE 1/4 - " " " "					
9	JOHN BURBACH		1.61	NE 1/4 - SE 1/4 - " " " "					
10	JOHN KOEN		0.04	SE 1/4 - SE 1/4 - " " " "					
11	ARTHUR HUNDT		0.82	NW 1/4 - SE 1/4 - " " " "					
12	AUGUST HUNDT		0.32	SW 1/4 - SW 1/4 - " " " "					
13	ARTHUR HUNDT		"	SE 1/4 - SW 1/4 - " " " "					

PLAT OF RIGHT OF WAY REQUIRED
STATE AID PROJECT NO. 5234
MIDDLE RIDGE - LACROSSE ROAD
S.T.H. 33 LACROSSE COUNTY
SCALE 1" = 1000'

PLAN NO. 341

0492 W 10721 W

FED. ROAD DIST. NO.	STATE	SEC. NO.	SHEET NO.	TOTAL SHEETS
	WIS	5234	3	
DIVISION JOB NO. 5234				

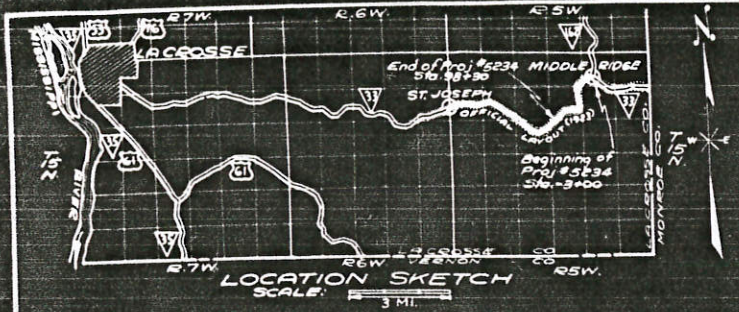



ENLARGED SKETCH OF MIDDLE RIDGE Scale: 1"=100'

NO	NAME	ADDRESS	AC.	DESCRIPTION	MORTGAGEE	ADDRESS	AMOUNT PAID	REMARKS
1	WM. ARNEZ		0.03	SE 1/4 SW 1/4 S 23 E N 25 W				
2	DEE CAVADINI		0.02	"				
3	DEE ALICE		0.01	"				
4	HEINZ KLOS		0.17	SW 1/4 SW 1/4				
5	WM. ELSEN		2.35	"				
6			0.0	1/4 SW 1/4 S 3				
7	PETER MUNDT		1.17	"				
8			-	NE 1/4 NE 1/4 S 10				
9	JOHN BURBACH		1.61	NE 1/4 SE 1/4				
10	JOHN KOEN		0.04	SE 1/4 SE 1/4				
11	REINHOLD MUNDT		0.81	NW 1/4 SE 1/4				
12	ALBERT MUNDT		0.32	SW 1/4 SW 1/4				
13	LORENZ MUNDT			"				

PLAT OF RIGHT OF WAY REQUIRED
 STATE AID PROJECT NO. 5234
 MIDDLE RIDGE-LACROSSE ROAD
 S.T.H. 33 LACROSSE COUNTY
 SCALE: 1"=1000'

NO	OWNER	ADDRESS	ACRES	DESCRIPTION	MORTGAGEE	ADDRESS	AMOUNT PAID				
							R/W	FENCE	BLDG	TOTAL	PND
1	WM. ARENTZ		0.45	SE 1/4 OF SW 1/4 SEC. 2 15-5							
2	MATT ELSEN		0.04	S.W. 1/4 OF S.E. 1/4							
3	WM. ARENTZ		0.20	N.W. 1/4 OF N.E. 1/4							
4	"		0.38	N.E. 1/4 OF "							
5	R. CAVIDINI		0.35	N.E. 1/4 OF N.E. 1/4							
6	MRS. G. ARENTZ EST.		2.55	N.W. 1/4 OF "							
7	JACOB HURTZ		0.91	N.E. 1/4 OF "							
8	Emma E. Bedessen		0.04	S.W. 1/4 OF S.E. 1/4							
9	WM. GRONEMUS		0.34	SE 1/4 "							

NO. ROAD DIST. NO.	STATE	STATION	SHEET NO.	TOTAL SHEETS
4	WIS.	5985	3	18

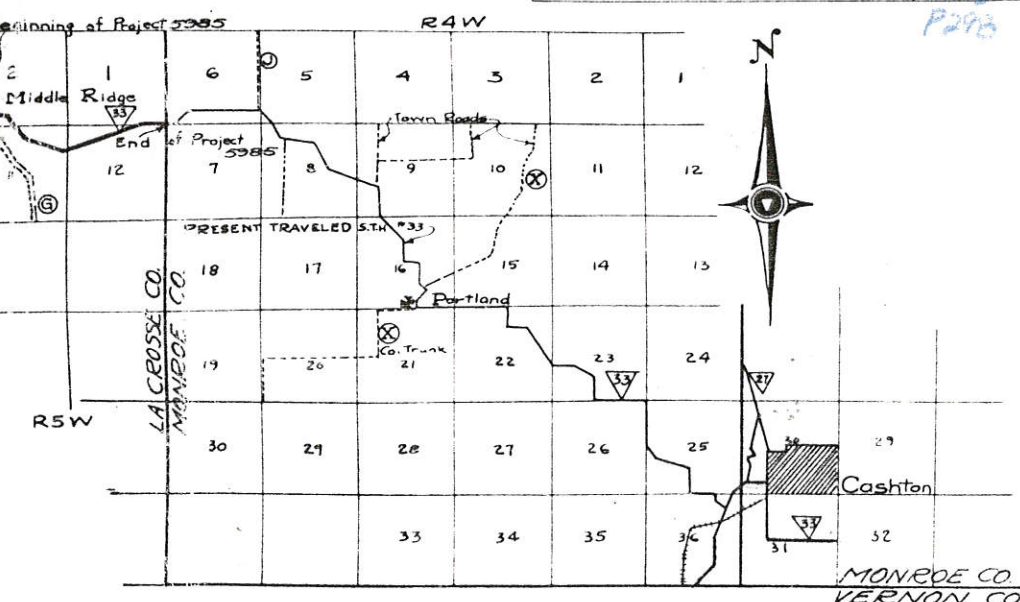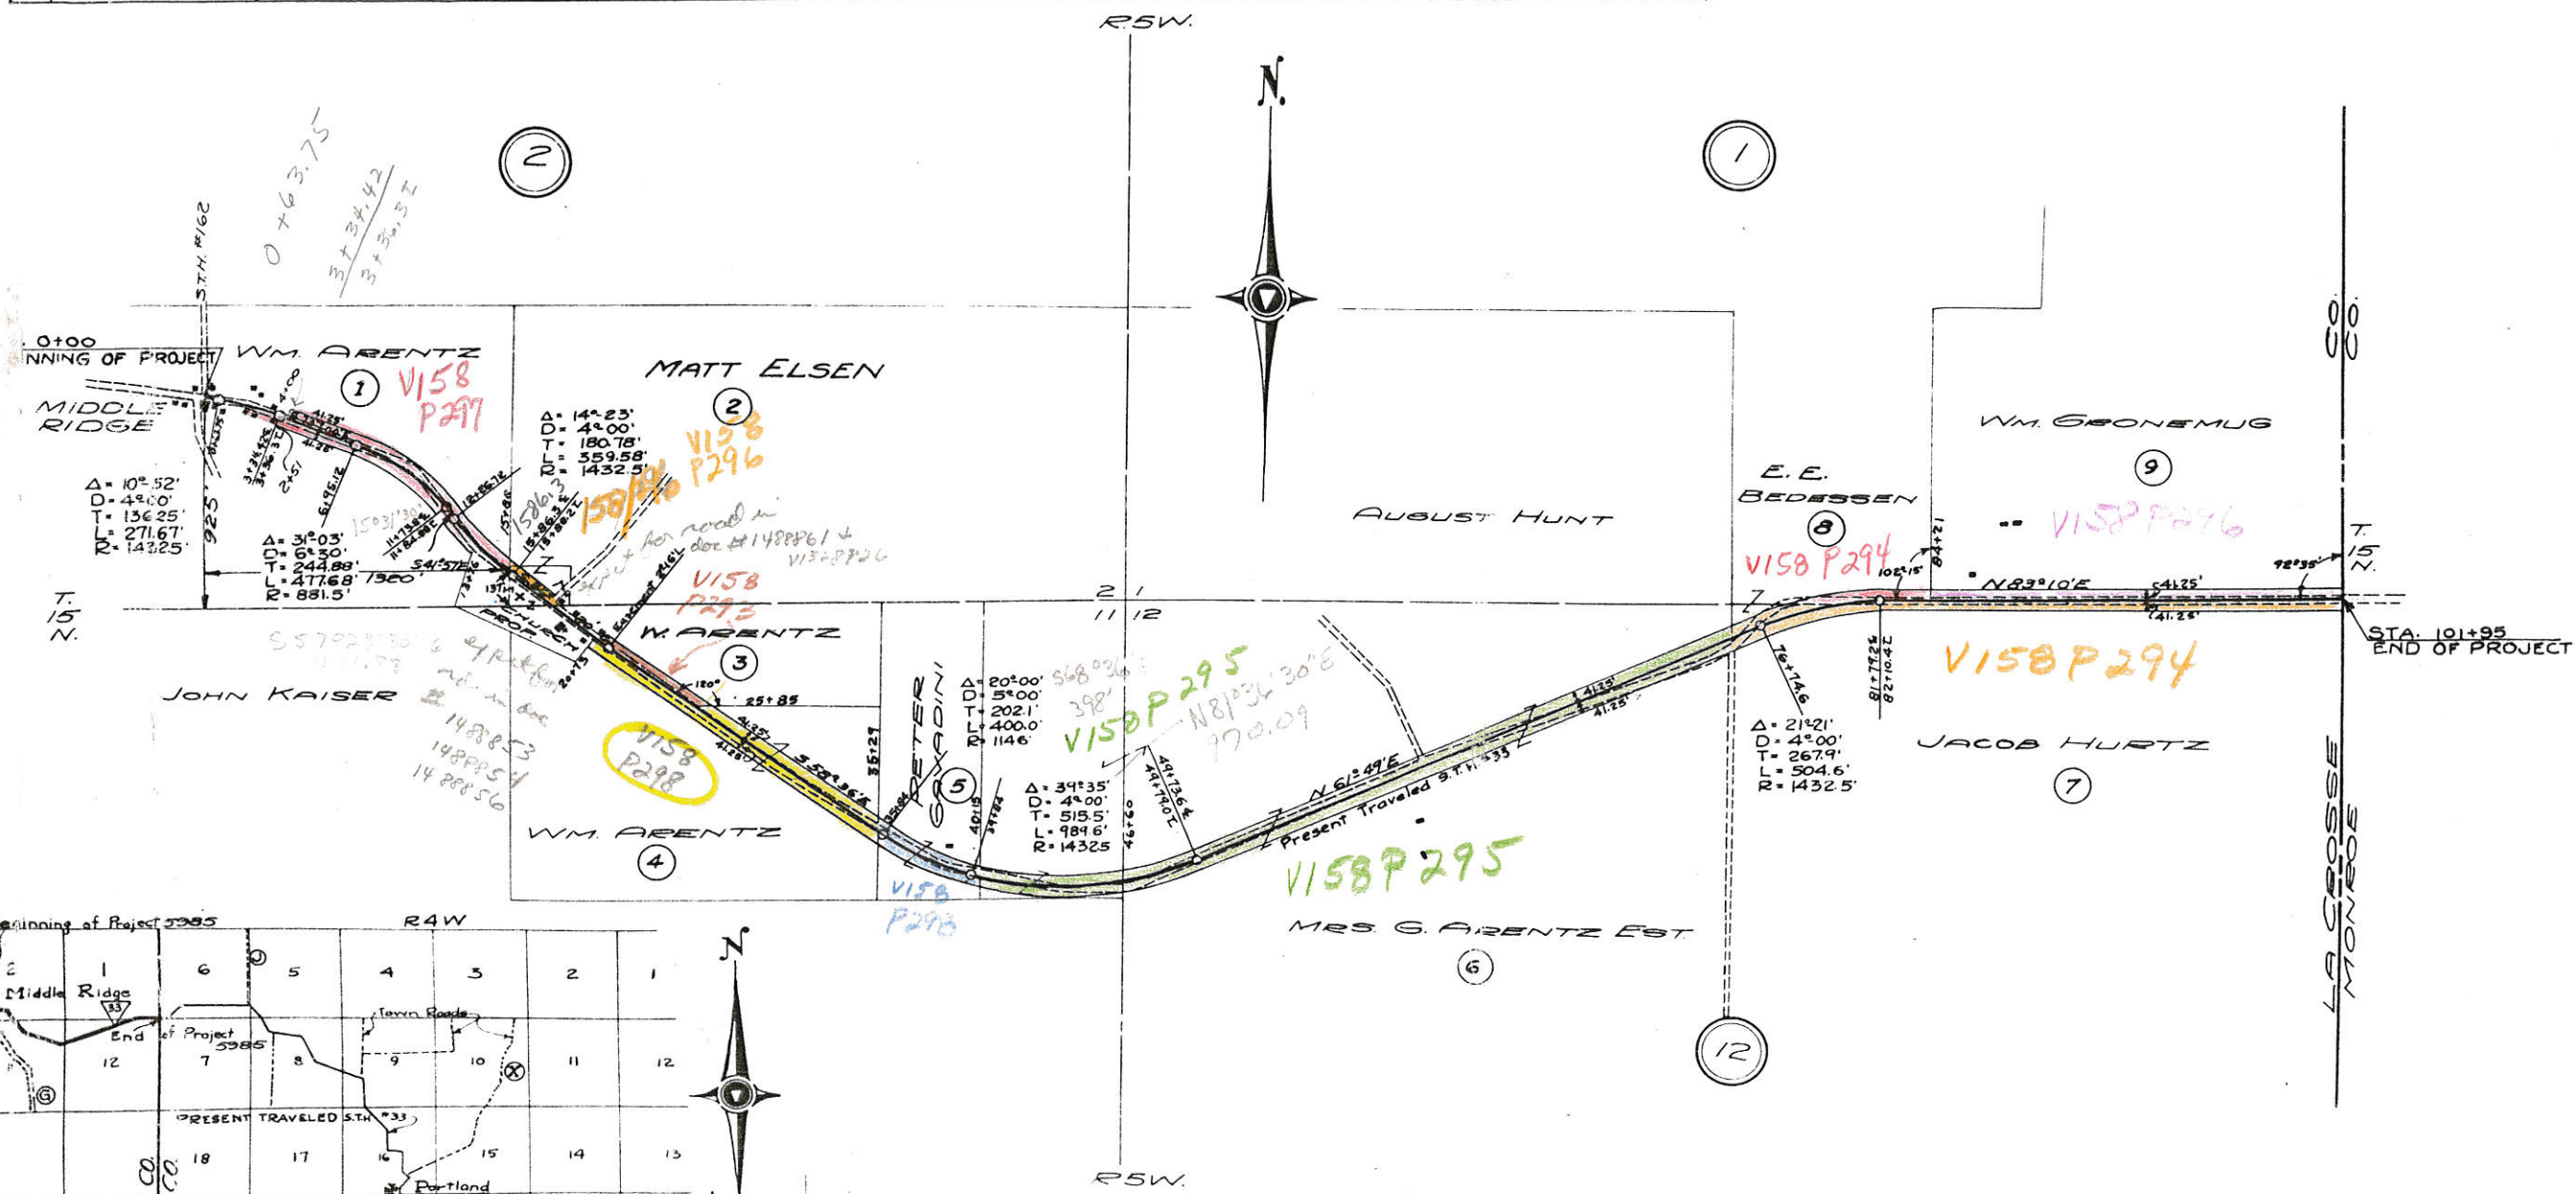

1432.50
- 47.25
1385.25

PLAT OF RIGHT OF WAY REQUIRED
STATE AID PROJECT NO. 5985
MIDDLE RIDGE-CASHTON ROAD
LA CROSSE COUNTY
SCALE: 400' = 1" S.T.H. #33