

R/W PROJECT NUMBER I.D. 5120-03-21	SHEET NUMBER 4.0	TOTAL SHEETS 6
FEDERAL PROJECT NUMBER		
PLAT OF RIGHT OF WAY REQUIRED FOR STATE ROAD, CITY OF LA CROSSE 29TH ST. - EAST CORPORATE LIMITS S.T.H. 33 LA CROSSE COUNTY		

CONVENTIONAL SIGNS AND ABBREVIATIONS

- | | |
|---|---|
| ----- STATE LINE | -----FO----- FIBER OPTIC |
| ----- COUNTY LINE | -----W----- WATER |
| ----- TOWN OR RANGE LINE | -----G----- GAS |
| ----- SECTION LINE | -----T----- TELEPHONE OR TELEGRAPH |
| ----- QUARTER LINE | -----E----- ELECTRIC |
| ----- SIXTEENTH LINE | -----TV----- CABLE TELEVISION |
| ----- PROPOSED OR NEW R/W LINE | -----SS----- STORM SEWER |
| ----- EXISTING R/W LINE | -----SAN----- SANITARY SEWER |
| ----- LOT LINE | ⊙ TELEPHONE POLE |
| ----- PROPERTY LINE | □ POWER POLE |
| ////// CORPORATE LIMITS | ⊗ SERVICE PEDESTAL |
| ◆◆◆◆ NO ACCESS (By Previous Acquisition) | ⊗⊗ TRANSMISSION TOWER AND LINE |
| NO ACCESS (By Acquisition) | ⊙ LIGHT POLE |
| ●●●● NO ACCESS (By Statutory Authority) | ⊙ (Label) VALVE |
| ----- LIMITED EASEMENT (Temporary or Permanent) | ☀ CAUTION NOTATION FOR COMBUSTIBLE FLUIDS |
| ● RIGHT OF WAY MONUMENT | ⊙ OR TANK STORAGE TANK |
| ⌒ NEW ALIGNMENT | ⊙ (Label) SILO, MANHOLE OR WELL, ETC. |
| ---/--- SLOPE INTERCEPT | (Label) BUILDING |
| -X-X- FENCE | |
| RAILROAD | |



- | | | |
|-----------------------------|----------------------------|-----------------------------------|
| AC. ACRES | H. HOUSE | P.L. PROPERTY LINE |
| A.P. ACCESS POINT | I.P. IRON PIN | P.L.E. PERMANENT LIMITED EASEMENT |
| AH. AHEAD | I.H. INTERSTATE HIGHWAY | R. RADIUS |
| BK. BACK | L. LENGTH OF CURVE | R REFERENCE LINE |
| B. BARN | LC LONG CHORD | R/W RIGHT OF WAY |
| CL CENTERLINE | LCB LONG CHORD BEARING | SEC. SECTION |
| C.T.H. COUNTY TRUNK HIGHWAY | MON. MONUMENT | S. SHED |
| D. DEGREES | P.C. POINT OF CURVATURE | S.T.H. STATE TRUNK HIGHWAY |
| G. GARAGE | P.I. POINT OF INTERSECTION | STA. STATION |
| G.N. GRID NORTH | P.T. POINT OF TANGENCY | T.L.E. TEMPORARY LIMITED EASEMENT |
| | | U.S.H. UNITED STATES HIGHWAY |

NOTES

COORDINATES AND BEARINGS ON THIS PLAT ARE ORIENTED TO THE WISCONSIN COORDINATE SYSTEM SOUTH ZONE. ALL PLAT DISTANCES ARE GROUND LENGTH AND MAY BE CONVERTED TO GRID LENGTH BY MULTIPLYING THE DISTANCE BY THE GRID FACTOR PROVIDED ON THE DETAIL SHEETS.

RIGHT OF WAY MONUMENTS ARE TYPE II AND ARE PLACED PRIOR TO OR AT THE TIME OF LAND TITLE TRANSFER.

RIGHT OF WAY BOUNDARIES ARE DEFINED WITH COURSES OF THE PERIMETER OF THE HIGHWAY LANDS REFERENCED TO THE U.S. PUBLIC LAND SURVEY OR OTHER SURVEYS OF PUBLIC RECORD.

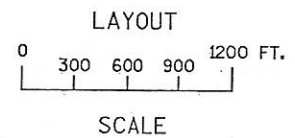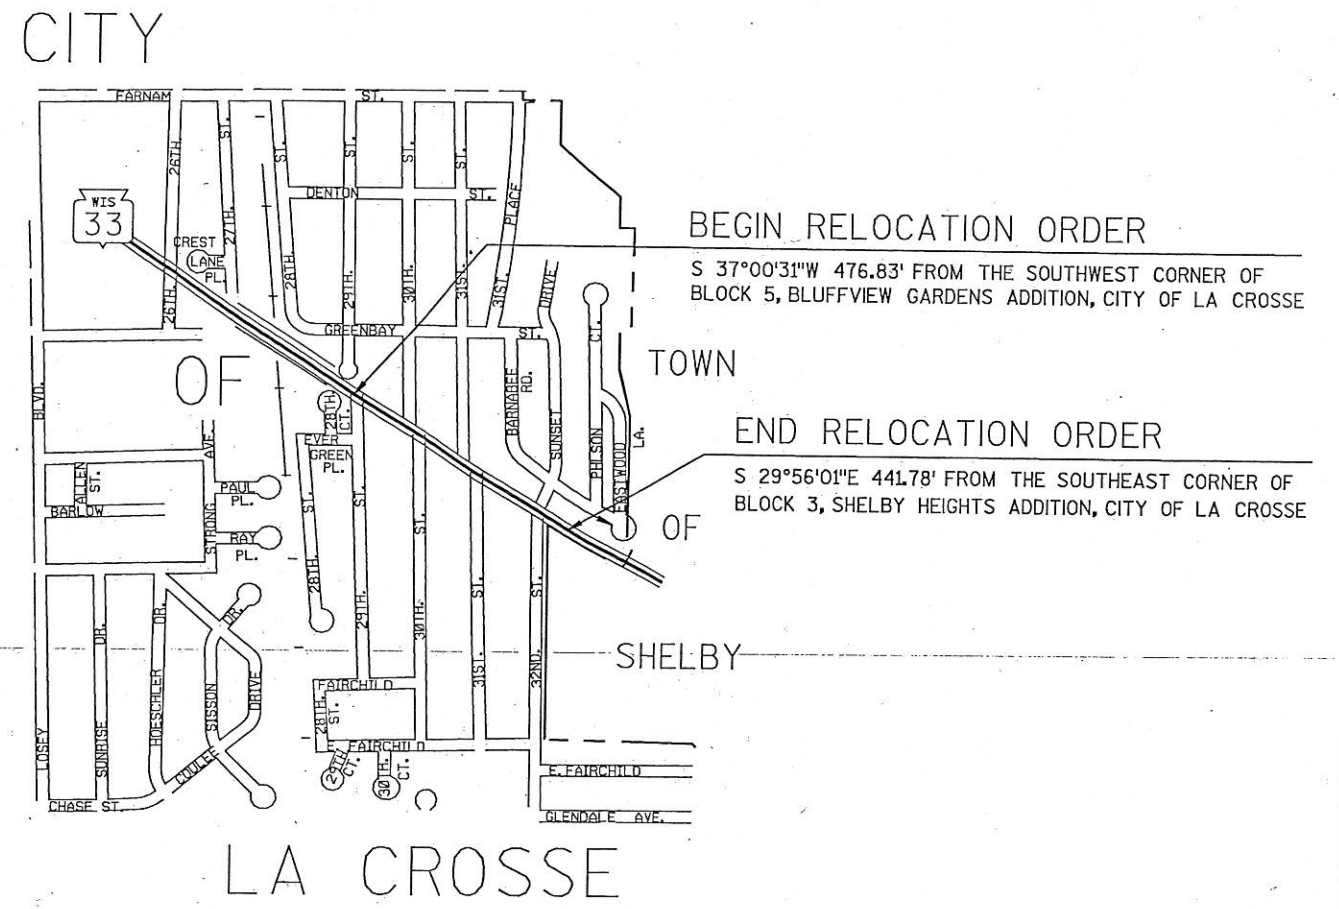

TOTAL NET LENGTH OF CENTERLINE = 0.227 MI.

REVISION DATE 4-16-97 N.C. 1-10-2007 N.C.	STATE OF WISCONSIN DEPARTMENT OF TRANSPORTATION
APPROVED: DATE: 2-13-96	<i>[Signature]</i> DISTRICT REAL ESTATE MANAGER

PLOT SCALE:

PLOT NAME:

REV. DATE: 2-4-97

ORIGINATOR:

SCHEDULE OF LANDS & INTERESTS REQUIRED

AREAS SHOWN IN THE TOTAL ACRES COLUMN MAY BE APPROXIMATE AND ARE DERIVED FROM TAX ROLLS OR OTHER AVAILABLE SOURCES AND MAY NOT INCLUDE LANDS OF THE OWNER WHICH ARE NOT CONTIGUOUS TO THE AREA TO BE ACQUIRED.

REVISION DATE
4-16-97
1-10-2007 N.C.

ROUTE COUNTY DATE
S.T.H. 33 LA CROSSE 2-13-96
NOT TO SCALE

R/W PROJECT NUMBER
I.D. 5120-03-21
SHEET NUMBER
4.1

PARCEL NUMBER	SHEET NUMBER	OWNER	INTEREST REQUIRED	TOTAL BEFORE AC./S.F.	AC./S.F. REQUIRED			TOTAL REM. AC./S.F.	L.E. AC./S.F.	
					NEW	EXIST.	TOTAL		PERM.	TEMP.
1	4.2	PAULETTE A. MARDAK	PLE & TLE	27500 S.F.	-	-	-	27500 S.F.	90 S.F.	2890 S.F.
2	4.2	MICHAEL A. & TAMMY J. JOHNSON	PLE & TLE	8850 S.F.	-	-	-	8850 S.F.	25 S.F.	1017 S.F.
4	4.2 & 4.3	JEANNE M. NOTH	PLE & TLE	10840 S.F.	-	-	-	10840 S.F.	50 S.F.	984 S.F.
5	4.2 & 4.3	THOMAS J. & THERESA M. JUAN	TLE	8200 S.F.	-	-	-	8200 S.F.	-	1567 S.F.
6	4.3	ALAN W. ISAKSON	PLE & TLE	6440 S.F.	-	-	-	6440 S.F.	25 S.F.	650 S.F.
7	4.3	S.L. TYSON	TLE	8960 S.F.	-	-	-	8960 S.F.	-	730 S.F.
8	4.3	ROY A. & LILLIAN V. WILSON	FEE	7000 S.F.	7000 S.F.	-	7000 S.F.	0 S.F.	-	-
9	4.3	GILBERT T. & KARLENE K. CHICK	FEE	5320 S.F.	5320 S.F.	-	5320 S.F.	0 S.F.	-	-
10	4.3	NORBERT J. & ARLENE L. SCHMIDT L.C. TO ROBERT J. SCHMIDT	PLE & TLE	21374 S.F.	-	-	-	21374 S.F.	50 S.F.	748 S.F.
11	4.3	NORBERT J. & ARLENE L. SCHMIDT	FEE & TLE	29694 S.F.	2600 S.F.	-	2600 S.F.	27094 S.F.	-	2225 S.F.
12	4.3 & 4.4	SOUTHEAST DENTAL ARTS	TLE	25230 S.F.	-	-	-	25230 S.F.	-	1020 S.F.
13	4.3 & 4.4	HRZ, A WISCONSIN PARTNERSHIP	FEE & TLE	16505 S.F.	3778 S.F.	-	3778 S.F.	12727 S.F.	-	3056 S.F.
14	4.4 & 4.5	JESS ONDELL	FEE & TLE	43996 S.F.	4631 S.F.	-	4631 S.F.	39365 S.F.	-	1726 S.F.
15	4.4	WILLIAM M. & MARY R. STERBA	TLE	10500 S.F.	-	-	-	10500 S.F.	-	463 S.F.
16	4.5	HRZ, A WISCONSIN PARTNERSHIP	FEE & TLE	28214 S.F.	752 S.F.	-	752 S.F.	27462 S.F.	-	2953 S.F.
18	4.3	NORBERT J. & ARLENE L. SCHMIDT	TLE	12103 S.F.	-	-	-	12103 S.F.	-	887 S.F.

PLOT SCALE:

PLOT NAME:

REV. DATE: 4-16-97

ORIGINATOR: DOT/JSC

LEVELS ON


REVISION DATE 4-16-97 1-10-2007 N.C.	ROUTE S.T.H. 33	COUNTY LA CROSSE	DATE 2-13-96	R/W PROJECT NUMBER I.D. 5120-03-21	SHEET NUMBER 4.2
	SCALE, FT. 0 40		GRID FACTOR 0.9999147	FEDERAL PROJECT NUMBER	

PLOT SCALE:


PLOT NAME:

REV. DATE: 4-16-97

ORIGINATOR:

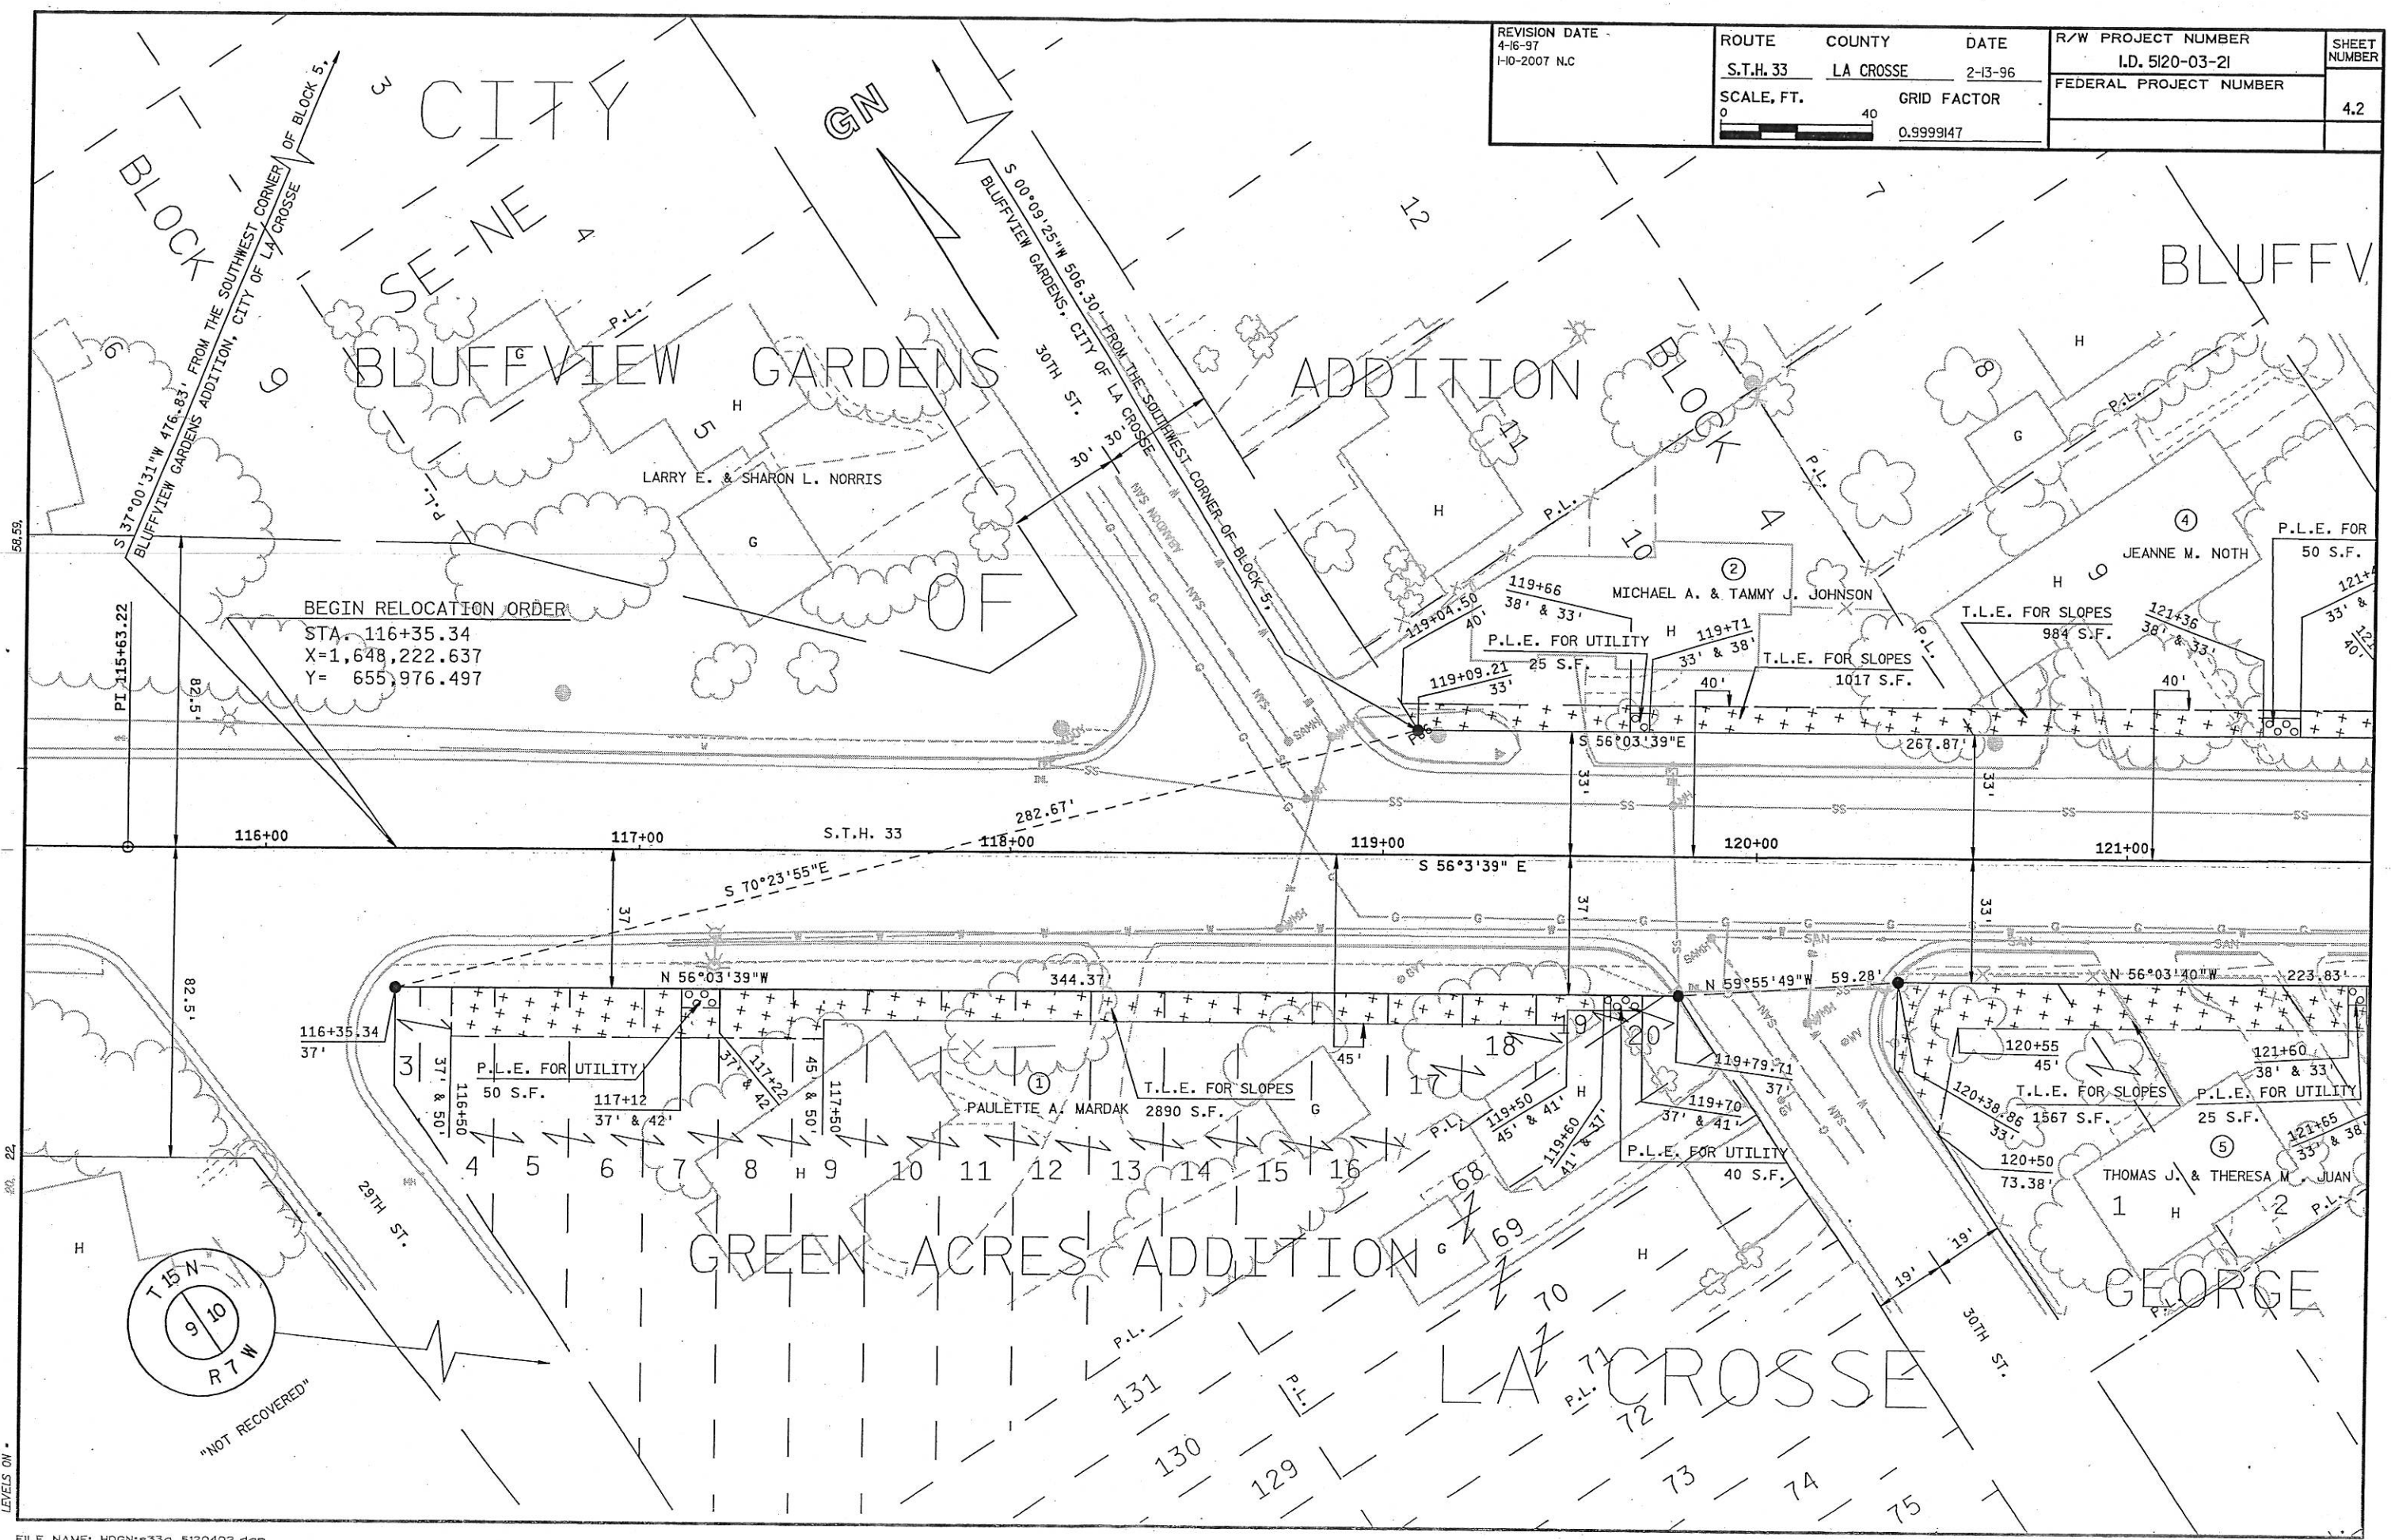


REVISION DATE 4-16-97 1-10-2007	ROUTE S.T.H. 33	COUNTY LA CROSSE	DATE 2-13-96	R/W PROJECT NUMBER I.D. 5120-03-21	SHEET NUMBER 4.3
	SCALE, FT. 0 40		GRID FACTOR 0.9999147	FEDERAL PROJECT NUMBER	

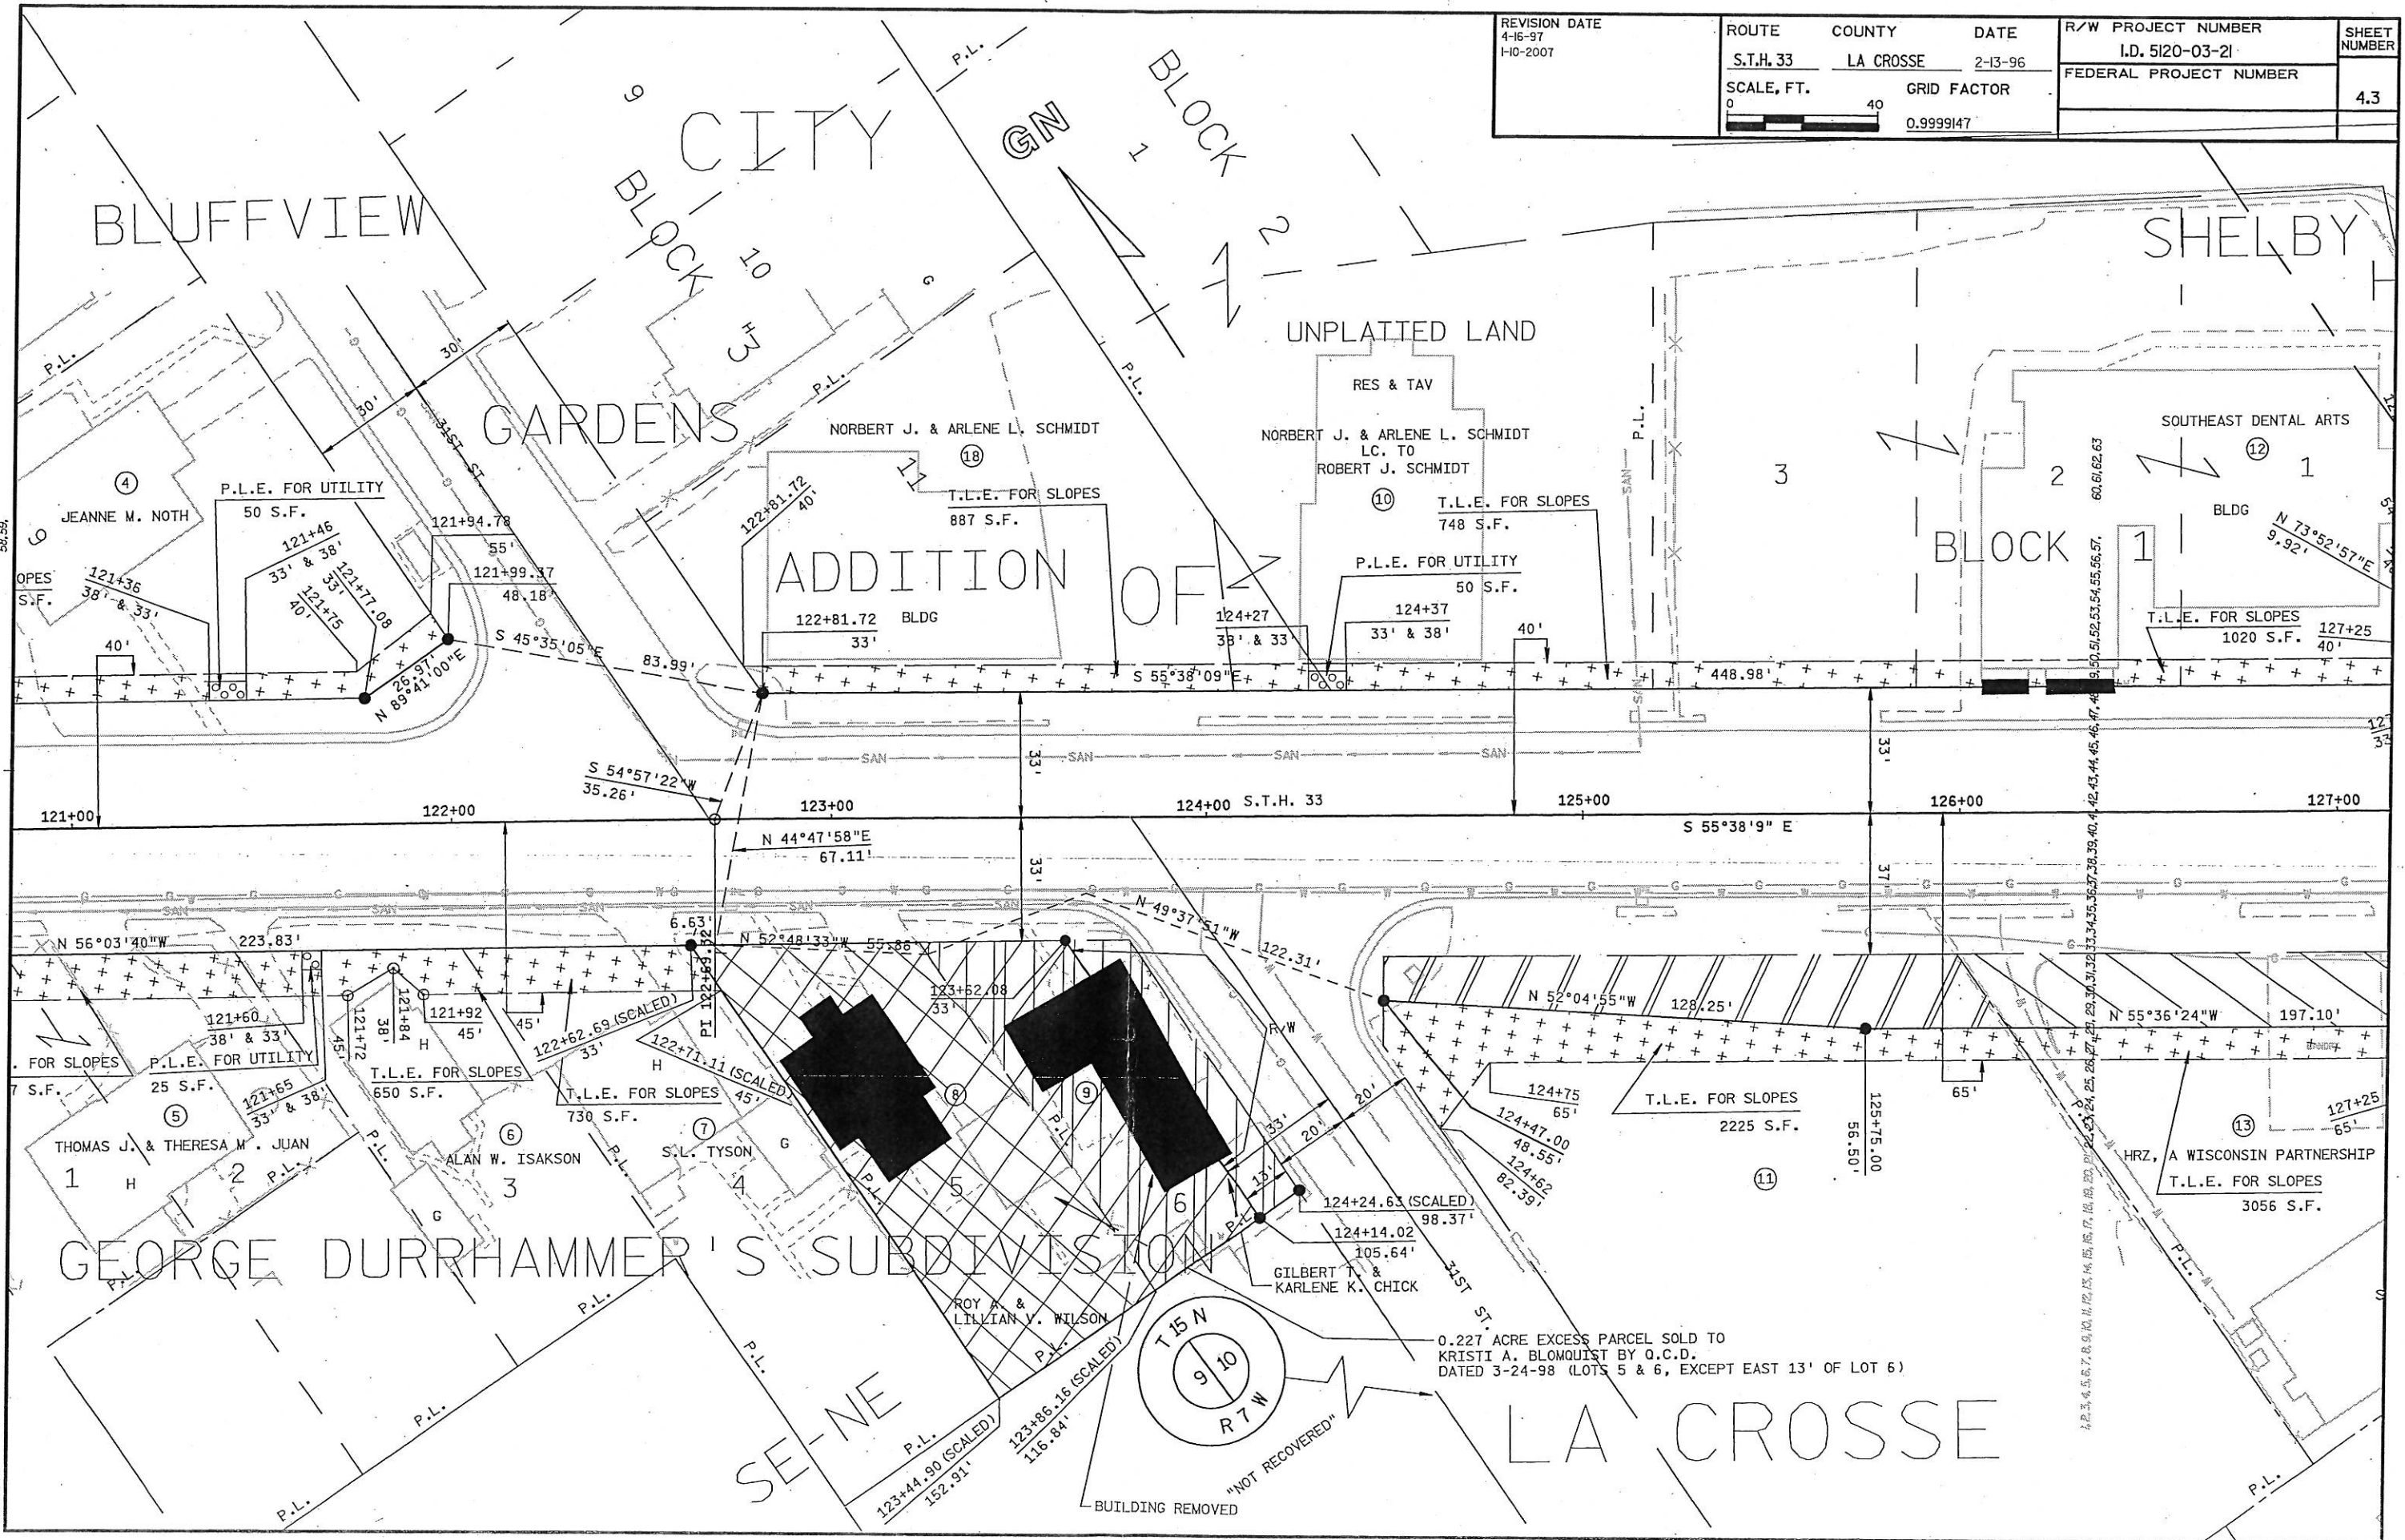

PLOT SCALE:
 PLOT NAME:
 REV. DATE: 4-16-97
 ORIGINATOR: RLLP

REVISION DATE 4-16-97 1-10-2007 N.C.	ROUTE S.T.H. 33	COUNTY LA CROSSE	DATE 2-13-96	R/W PROJECT NUMBER I.D. 5120-03-21	SHEET NUMBER 4.4
	SCALE, FT. 0 40		GRID FACTOR 0.9999147	FEDERAL PROJECT NUMBER	

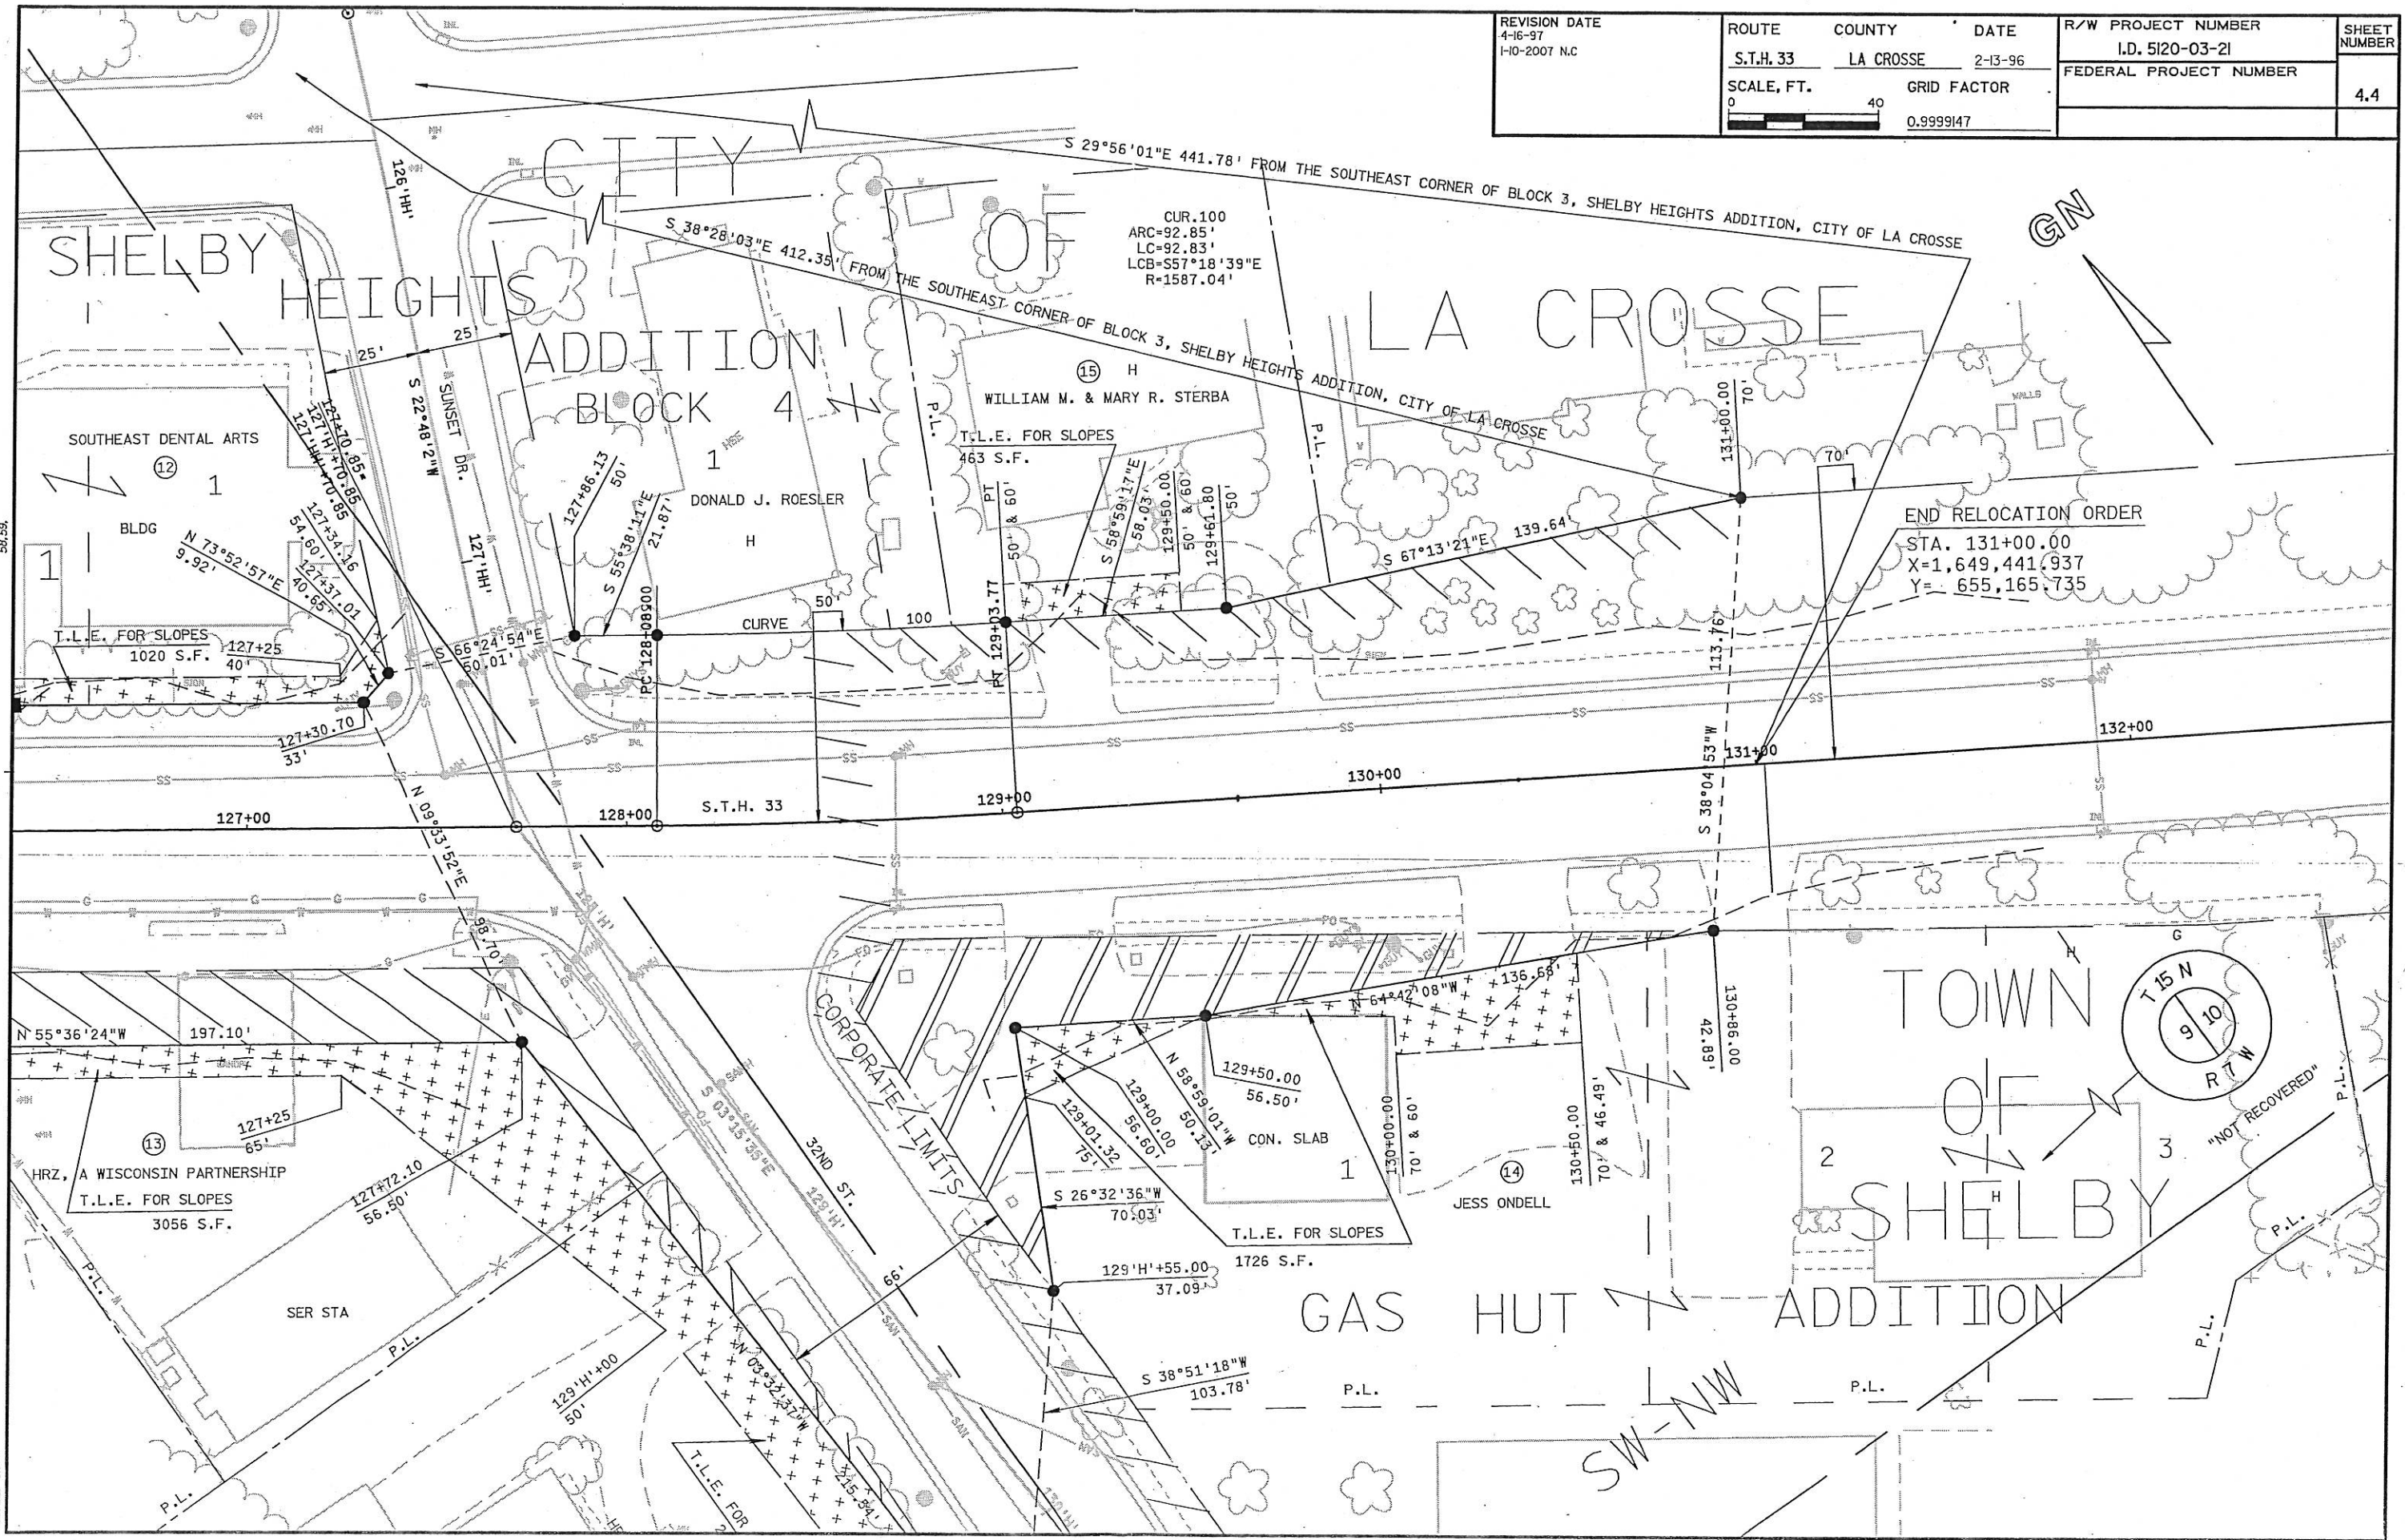

PLOT SCALE:

PLOT NAME:

REV. DATES 4-16-97

ORIGINATOR: RLP

REV. DATE: 4-16-97

PLOT NAME:

PLOT SCALE:

ORIGINATOR: RLP

LEVELS ON - 1, 2, 3, 4, 5, 6, 7, 8, 9, 10, 11, 12, 13, 14, 15, 16, 17, 18, 19, 20, 21, 22, 23, 24, 25, 26, 27, 28, 29, 30, 31, 32, 33, 34, 35, 36, 37, 38, 39, 40, 41, 42, 43, 44, 45, 46, 47, 48, 49, 50, 51, 52, 53, 54, 55, 56, 57, 58, 59, 60, 61, 62, 63

REVISION DATE 4-16-97 1-10-2007 N.C.	ROUTE S.T.H. 33	COUNTY LA CROSSE	DATE 2-13-96	R/W PROJECT NUMBER I.D. 5120-03-21	SHEET NUMBER 4.5
	SCALE, FT. 0 40		GRID FACTOR 0.9999147	FEDERAL PROJECT NUMBER	

