
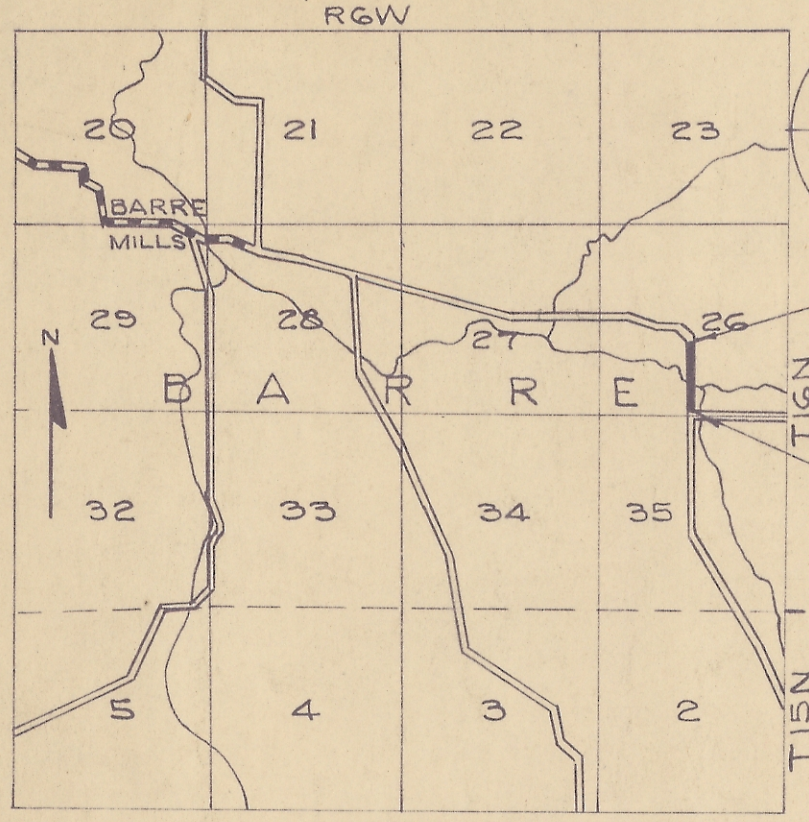


COR. APPROX. 2640'
WEST OF CENTERLINE

STA. 77+00
END OF RELOC. ORDER
PROJECT S0123(2)


STA. 60+50
BEGIN RELOC. ORDER
PROJECT S0123(2)

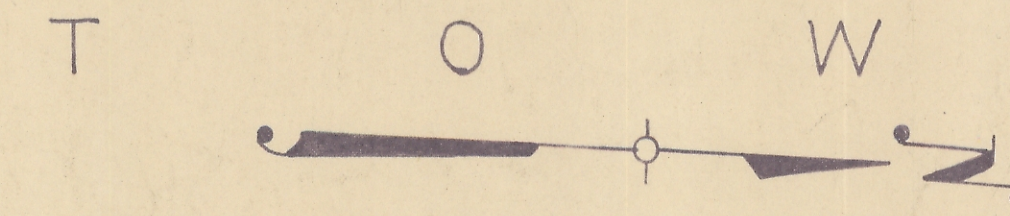

1 DORA RHODES ET AL
0.21 AC. RQD.

2 LOUIS SCHWIER

S.T.H. 33-BARRE MILLS ROAD (BOSTWICK BR.)
C.T.H. "M"
LA CROSSE COUNTY
DATED FEB. 9, 1951

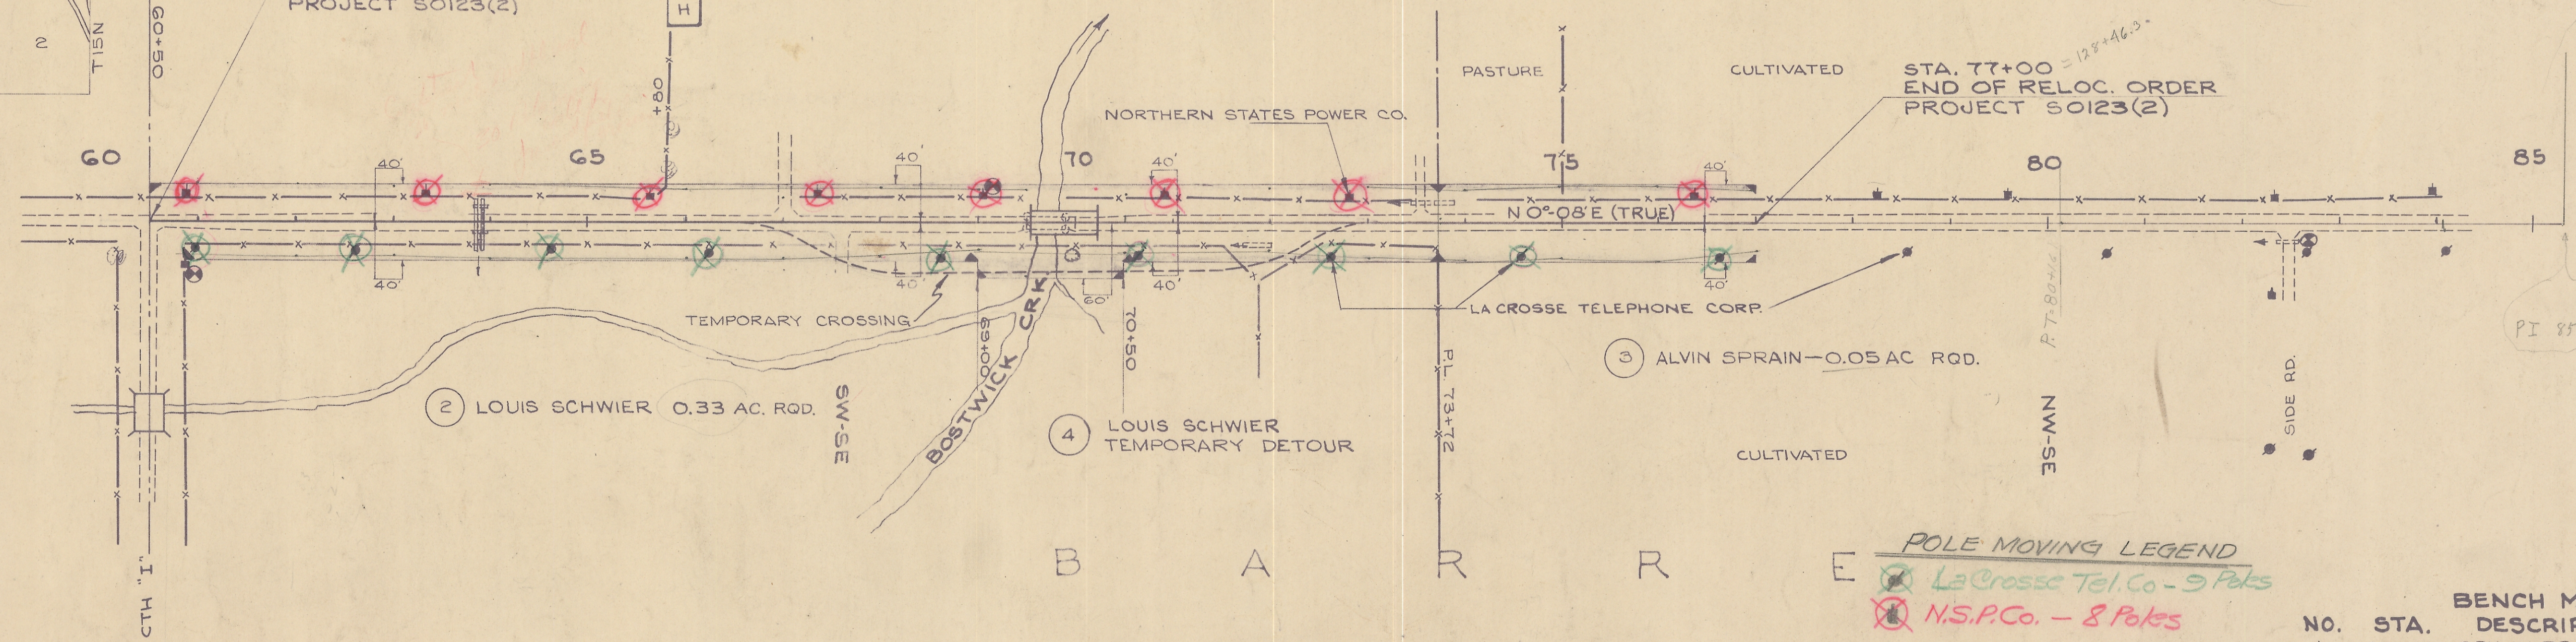


POLE MOVING LEGEND
X La Crosse Tel. Co. - 9 Poles
X N.S.P.Co. - 8 Poles

NO.	STA.	DESCRIPTION	EL.
1	60+85	SPK. IN PP*9411KKI NE "M" 8" I	747.96
2	69+06	SPK. IN PP*9411AAI38 22.5' LT	740.19
3	82+50	KEEL SQ. NE. COR. PE. PIPE HDWALL	747.50

BOSTWICK BRIDGE

NET LENGTH OF CENTERLINE STA. 60+50 - 77+00 = 1650 LIN. FT.

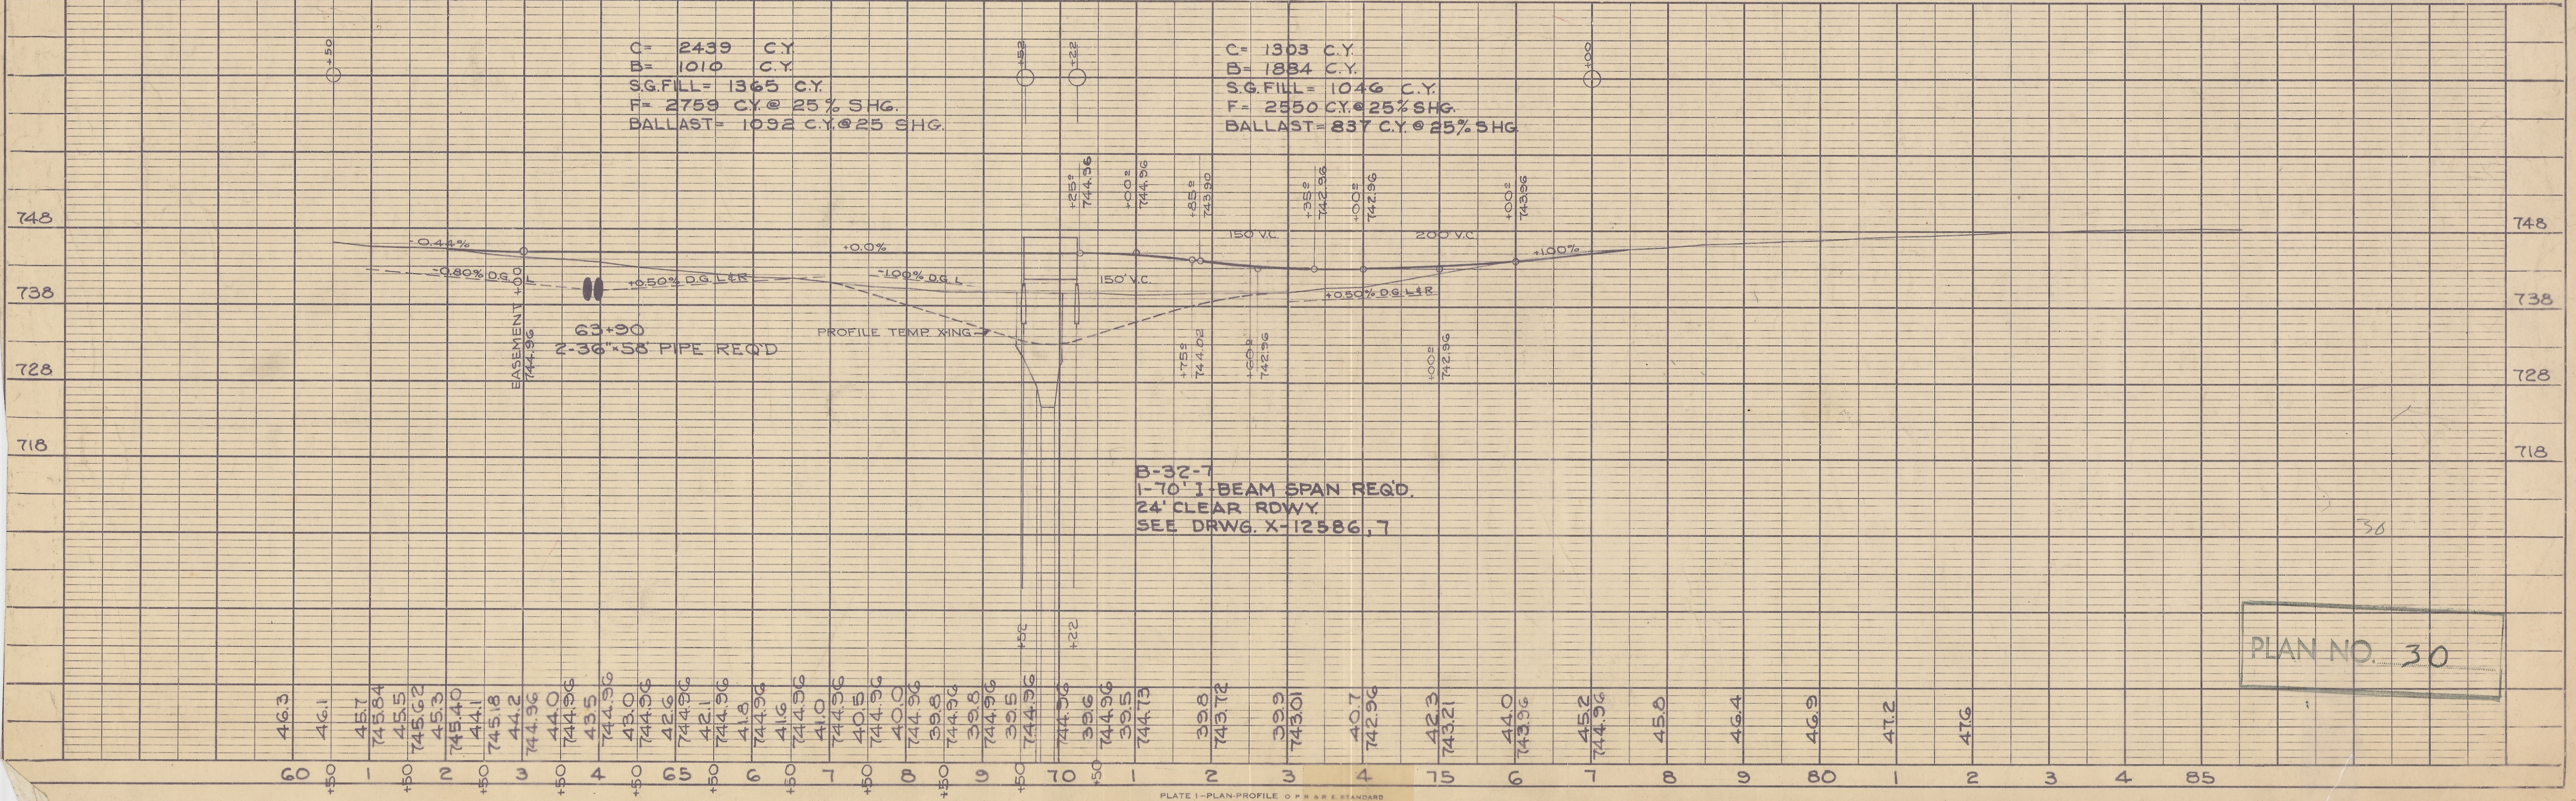

C = 2439 C.Y.
B = 1010 C.Y.
S.G. FILL = 1365 C.Y.
F = 2759 C.Y. @ 25% SHG.
BALLAST = 1092 C.Y. @ 25% SHG.

C = 1303 C.Y.
B = 1884 C.Y.
S.G. FILL = 1046 C.Y.
F = 2550 C.Y. @ 25% SHG.
BALLAST = 837 C.Y. @ 25% SHG.

B-32-7
1-70' 1" BEAM SPAN REQ'D.
24' CLEAR ROWY.
SEE DRWG. X-12586, 7

PLAN NO. 30