



W.M. "I"

Drainage  
3478 0-5

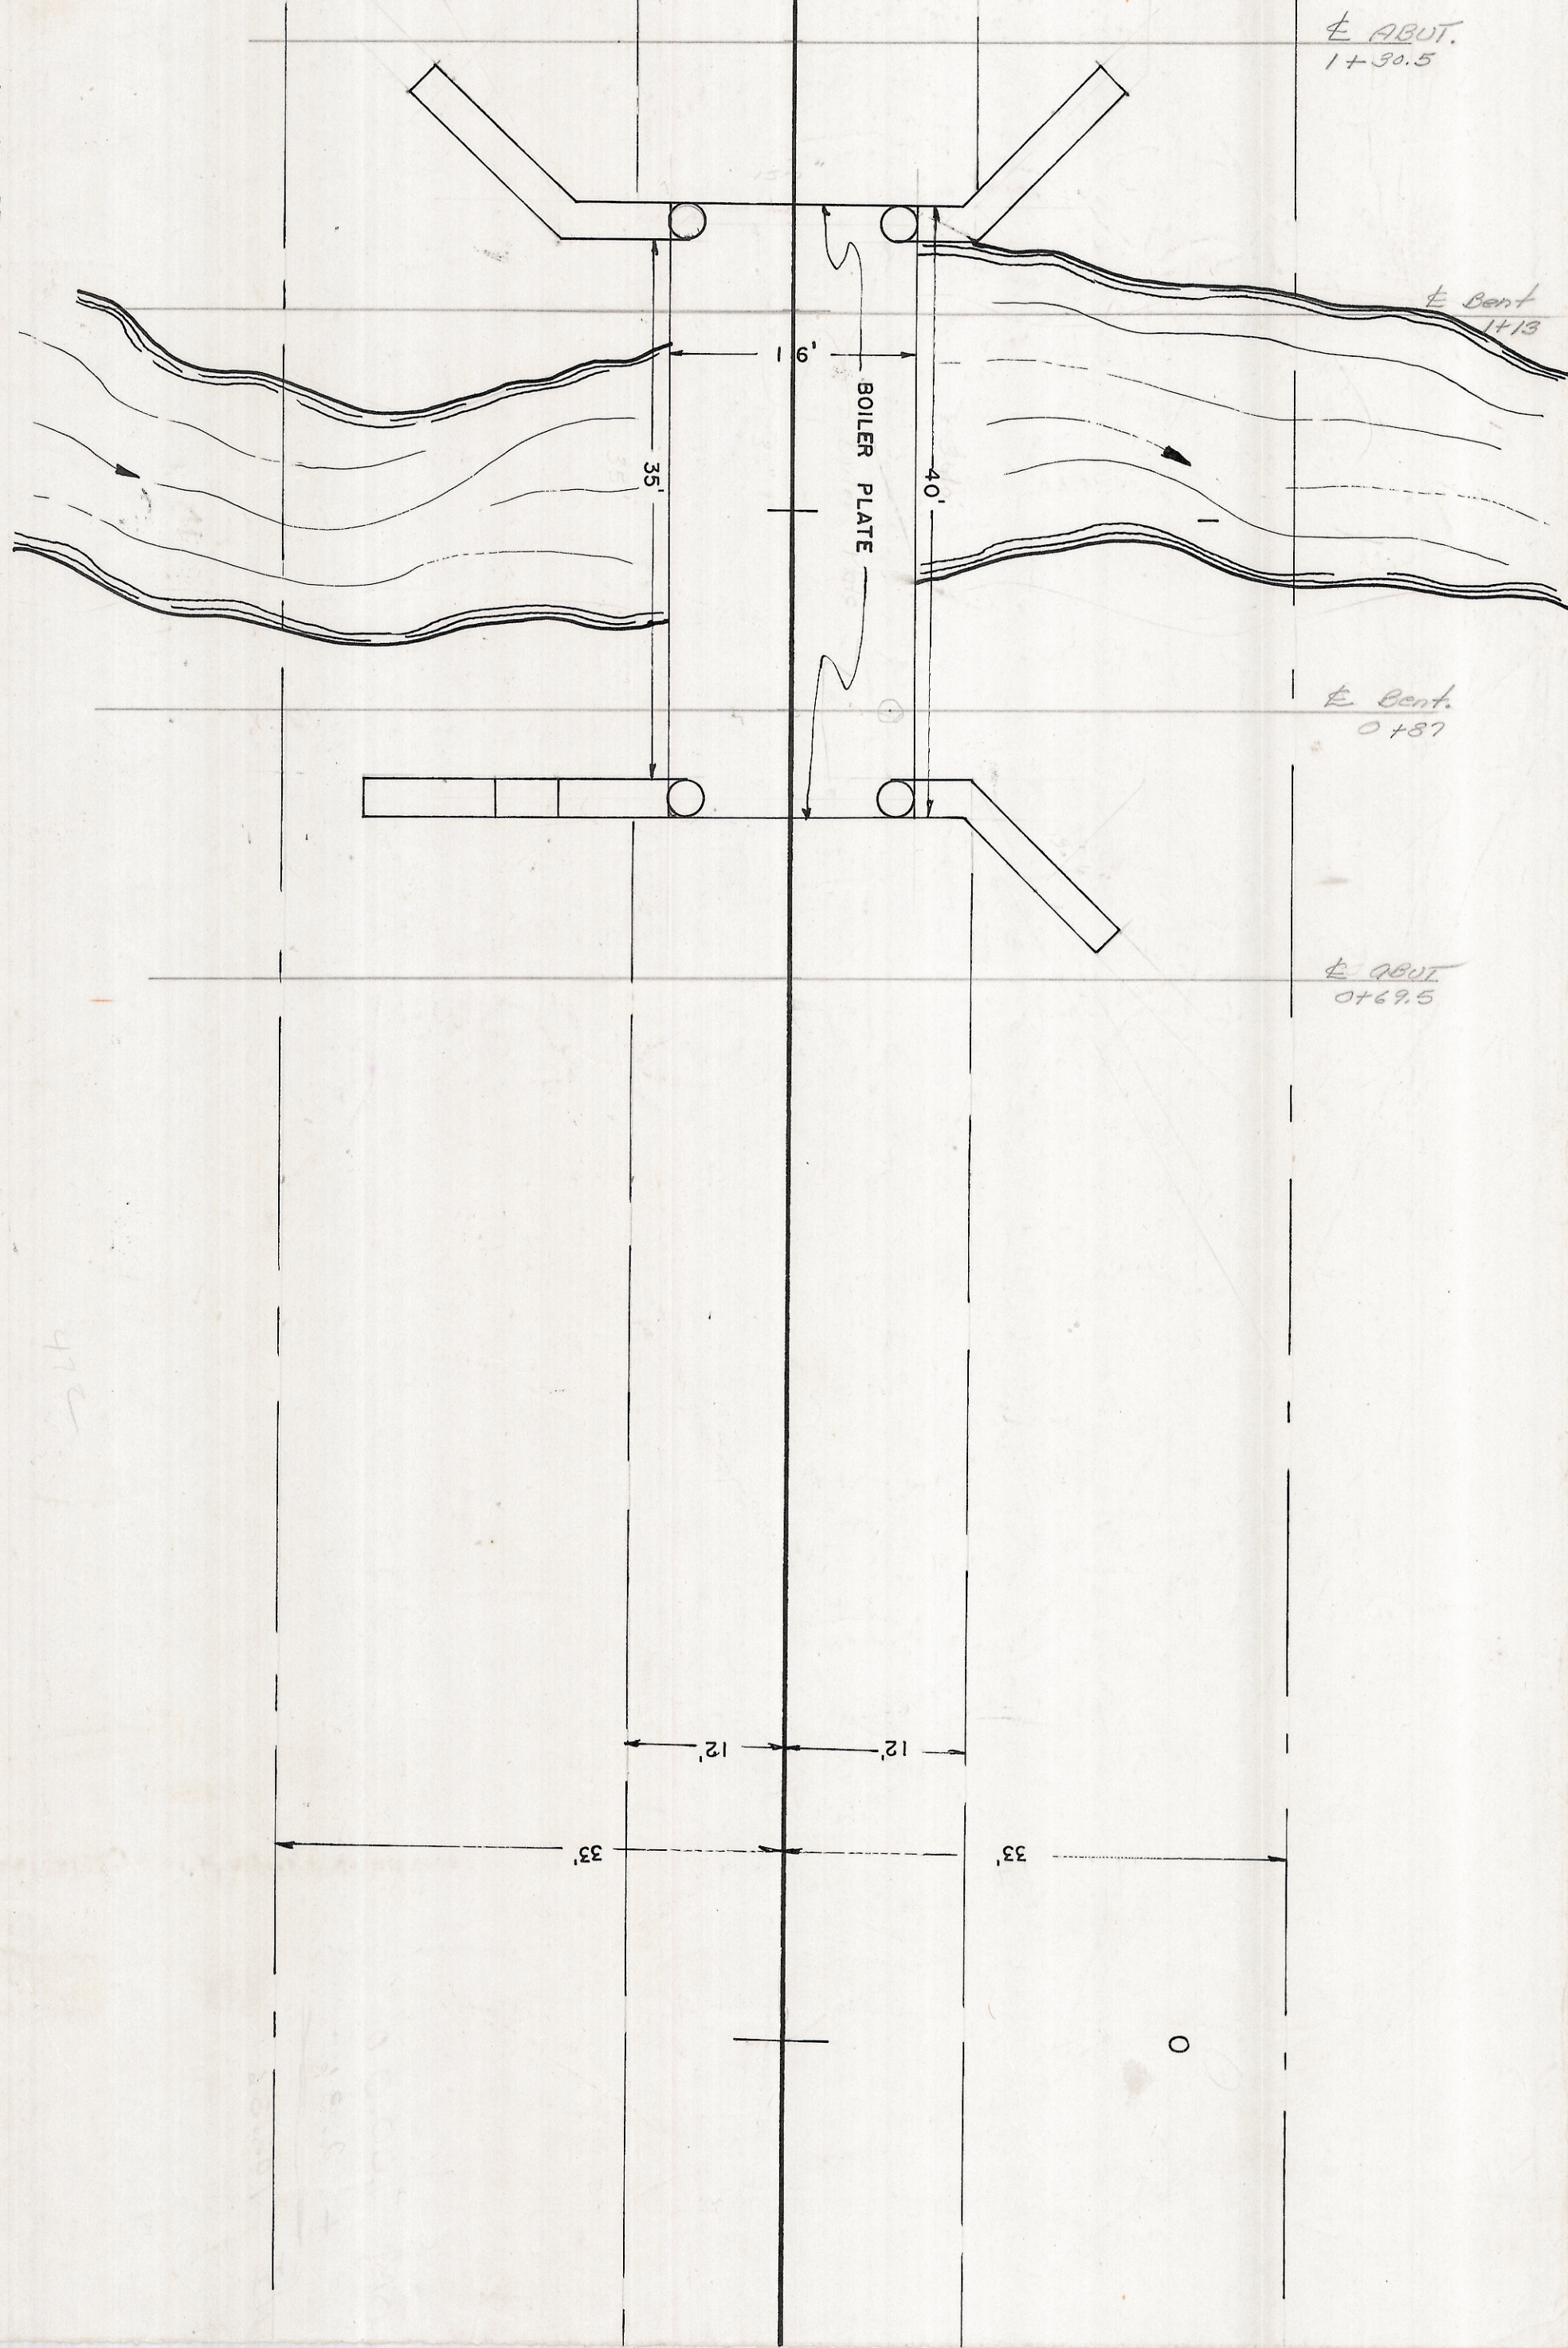

TOWN OF BARRE BR. 54 CTH "I"

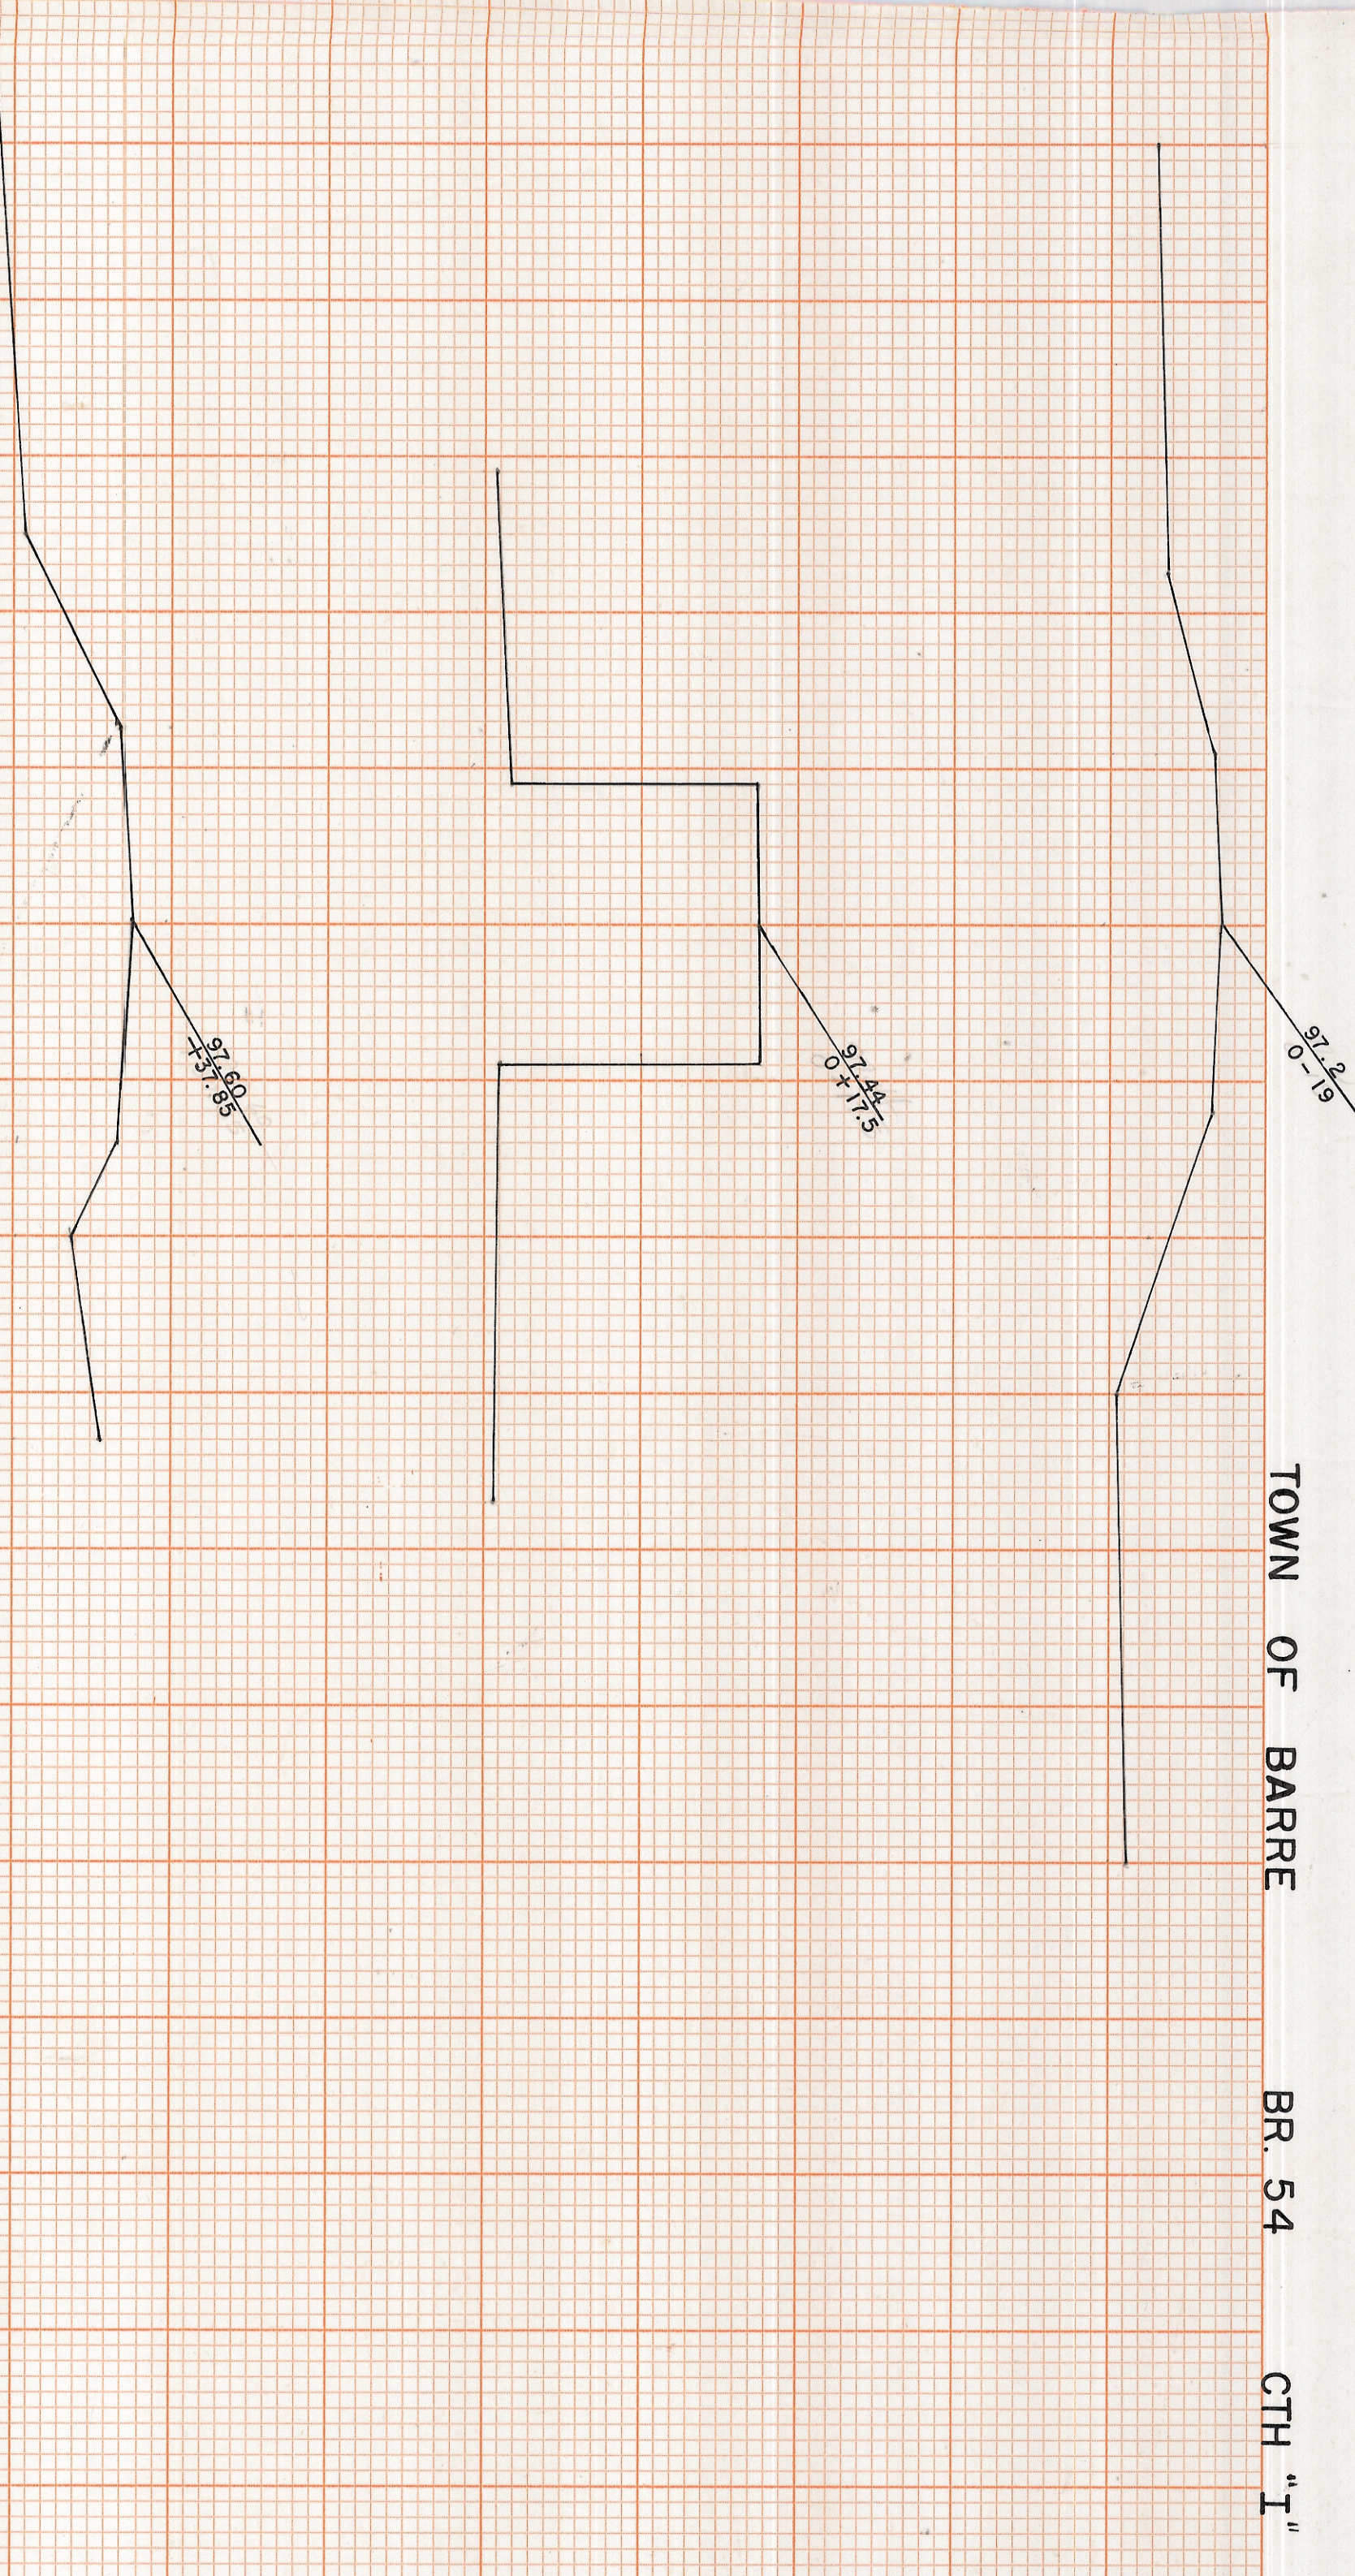

|                     |      |
|---------------------|------|
| 0 - EDGE OF WATER   | 15.1 |
| +05.7               | 15.3 |
| +11.7 & CREEK       | 15.2 |
| +18.2 & BR.         | 14.2 |
| +21.3 EDGE OF WATER | 14.0 |
| +36                 | 12.2 |

|                        |       |
|------------------------|-------|
| 0 - W. END FACE ABUT.  | 12.2  |
| +05.7 EDGE WATER       | 15.05 |
| +11.7 & CREEK          | 15.3  |
| +18.2 & BR.            | 15.3  |
| +21.3 EDGE WATER       | 13.9  |
| +36 E. END. FACE ABUT. | 9.7   |

SOUNDINGS DWN. STR.

SOUNDINGS UP STREAM

KEUFFEL & ESSER CO.  
NEW YORK.

TRADE STANDARD  
CROSS SECTION 10 X 10  
PAPER 10 X 10

KEUFFEL & ESSER CO.  
NEW YORK.

TRADE STANDARD  
CROSS SECTION 10 X 10  
PAPER 10 X 10

# 472