


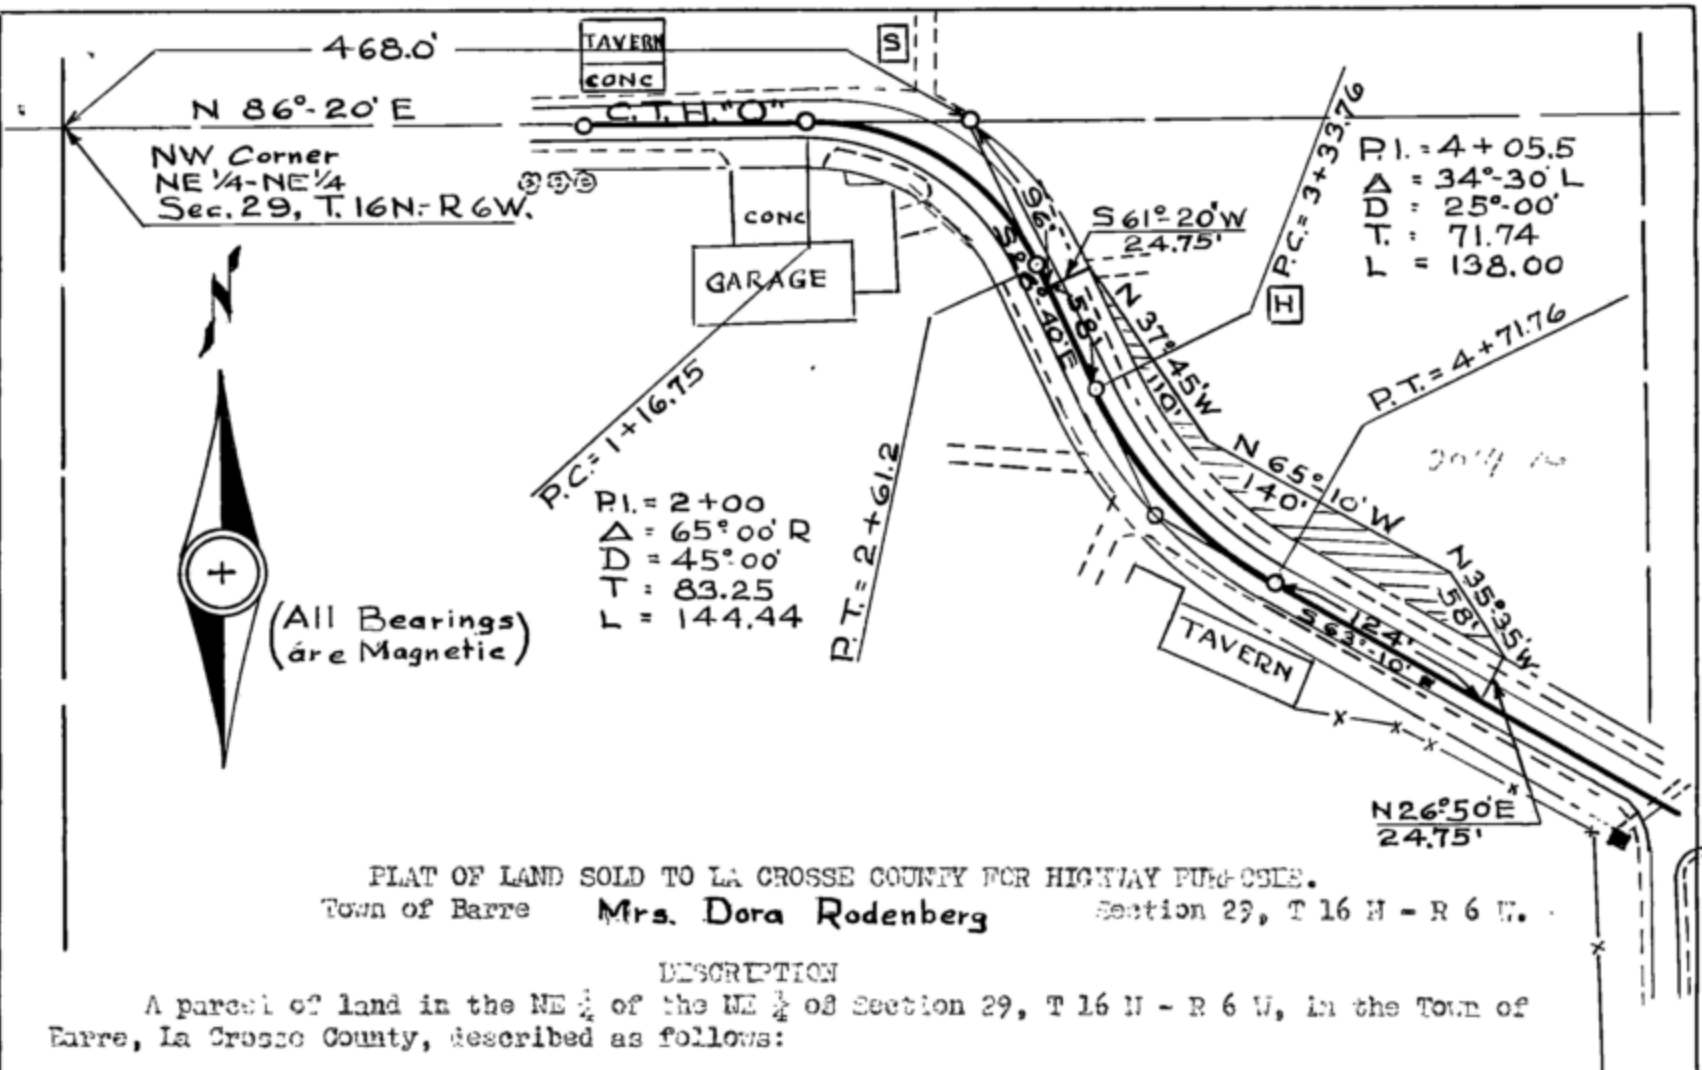

Commencing at the N corner of the NE 1/4 of the NE 1/4 of Section 29, T 16 N - R 6 W; thence N 86°-20' E along the north line of Section 29 a distance of 468 ft; thence S 28°-40' E a distance of 56 ft; to a point of beginning, this point being on the center line of County Trunk Highway "O"; thence S 28°-40' E along said center line a distance of 58 ft. to the beginning of a 25 degree curve, concave to the northeast and having a radius of 231 ft; thence south-easterly along said curve a distance of 158 ft. to a point of tangency; thence S 63°-10' E a distance of 124 ft; thence N 26°-50' E a distance of 24.75 ft. to a point on the northerly right-of-way line of C. T. H. "O"; thence N 35°-35' W a distance of 58 ft; thence N 65°-10' W a distance of 140 ft; thence N 37°-45' W a distance of 110 ft. to a point on the easterly right-of-way line of C. T. H. "O"; thence S 61°-20' W a distance of 24.75 ft. to the point of beginning; excepting therefrom the lands now being used for highway purposes and containing nine one-hundredths (.09) acres, more or less.

(Filed)

Plan # 579

LA CROSSE COUNTY HIGHWAY DEPARTMENT
LA CROSSE, WIS.

Paul A. Hartwig, Highway Commissioner

ROAD - C.T.H. "O"	TOWN Barre	Book # 36
SURVEYED BY - F.N.D.	DATE 2-14-45	
DRAWN BY - D.C.	DATE 5-14-45	
CHECKED BY - P.A.H.	DATE 5-21-45	
APPROVED BY - Town Board	DATE 5-18-45	

9+35.3 from EAST


+50


6. foo

450

5400

4 + 50

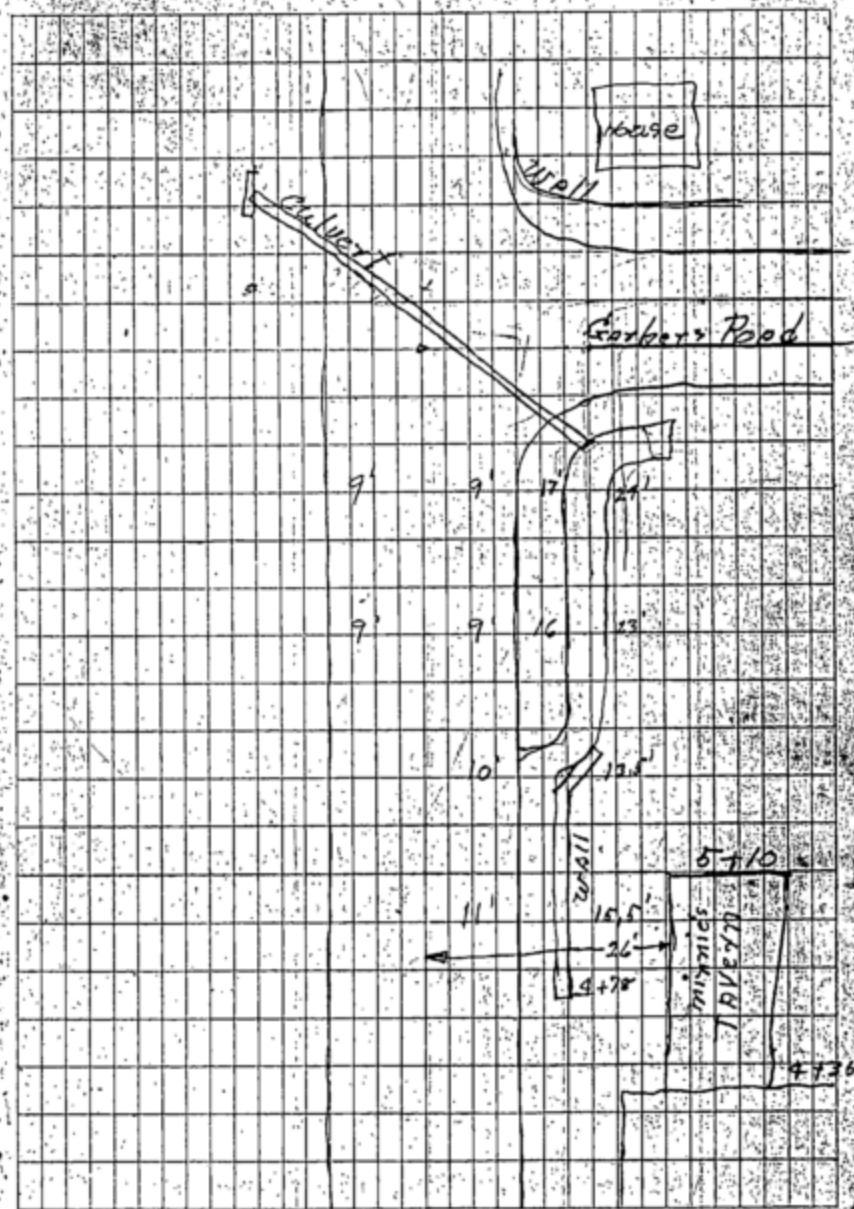

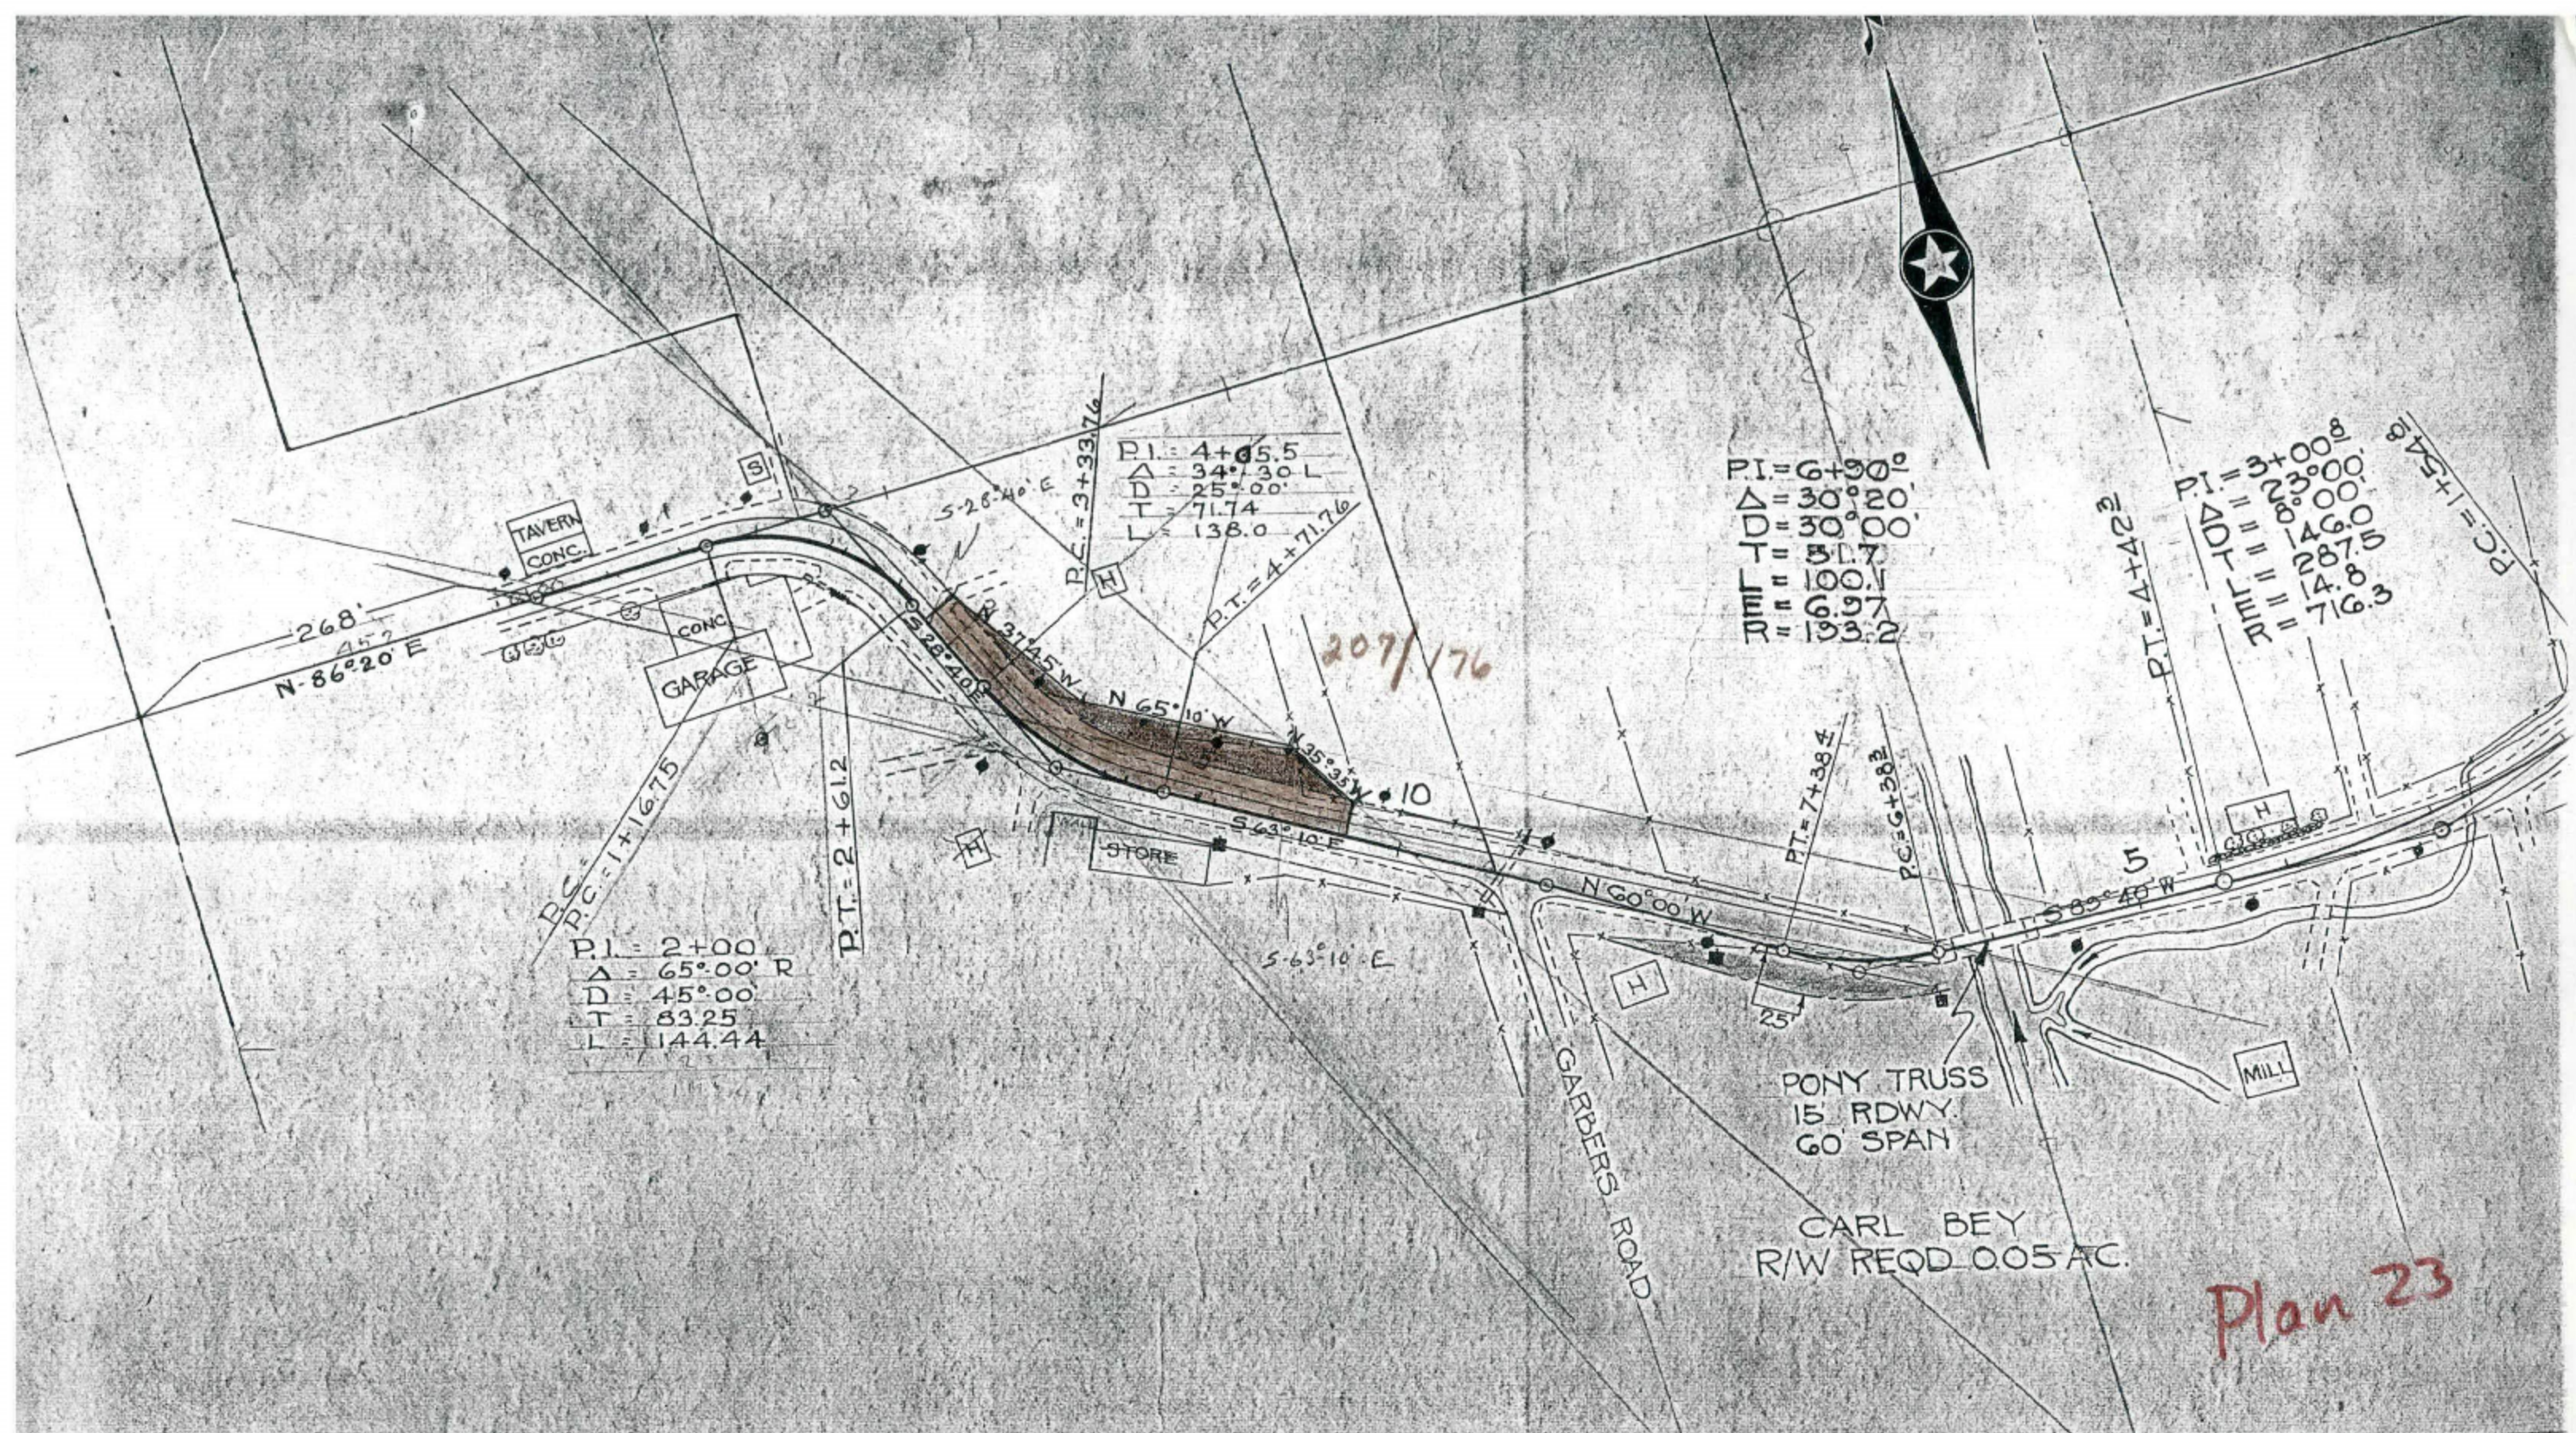

COUNTY HIGHWAY DEPT.
 TWIG - HIGHWAY COMMISSIONER
 TOWN - BARRE
 DATE - AUG 1940