


BENCHMARKS			
NO.	STA.	DESCRIPTION	ELEV.
1	10+09 11' LT.	CHISELED CROSS ON N.W. WING WALL OF BRIDGE	100.00
2	9+26 80' LT.	DBL. 20d. NAIL IN S. FACE OF 18" ELM.	102.29
3	10+36 42' RT.	DBL. 20d. NAIL IN W. FACE OF 24" MAPLE.	99.18

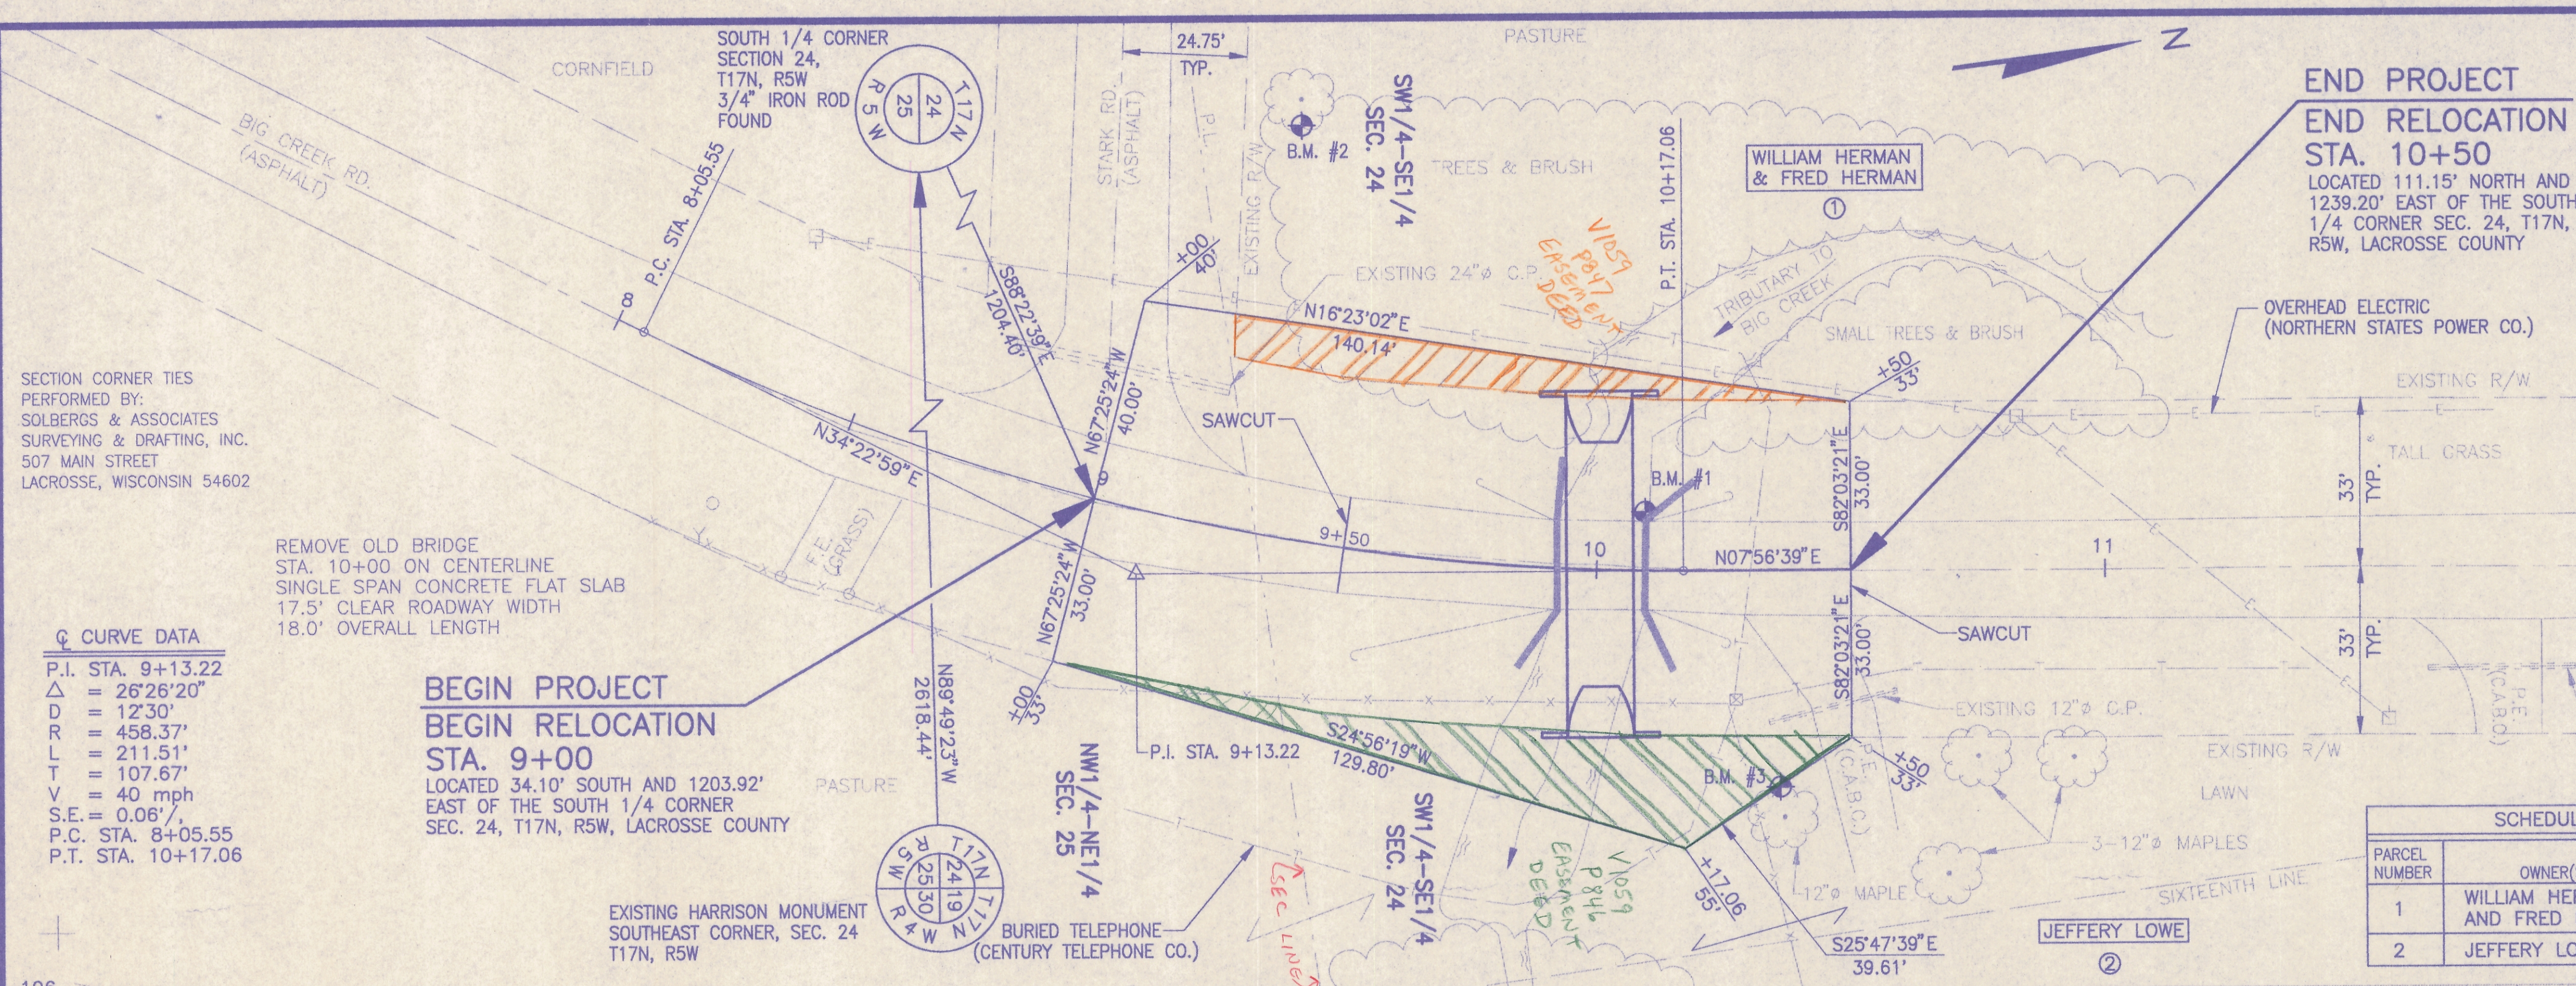



SECTION CORNER TIES
PERFORMED BY:
SOLBERG & ASSOCIATES
SURVEYING & DRAFTING, INC.
507 MAIN STREET
LACROSSE, WISCONSIN 54602

Q CURVE DATA
P.I. STA. 9+13.22
Δ = 26°26'20"
D = 12°30'
R = 458.37'
L = 211.51'
T = 107.67'
V = 40 mph
S.E. = 0.06%
P.C. STA. 8+05.55
P.T. STA. 10+17.06

BEGIN PROJECT
BEGIN RELOCATION
STA. 9+00
LOCATED 34.10' SOUTH AND 1203.92'
EAST OF THE SOUTH 1/4 CORNER
SEC. 24, T17N, R5W, LACROSSE COUNTY

END PROJECT
END RELOCATION
STA. 10+50
LOCATED 111.15' NORTH AND
1239.20' EAST OF THE SOUTH
1/4 CORNER SEC. 24, T17N,
R5W, LACROSSE COUNTY

SCHEDULE OF LANDS & INTERESTS					
PARCEL NUMBER	OWNER(S)	INTEREST REQUIRED	R/W ACRES REQUIRED		
			NEW	EXISTING	TOTAL
1	WILLIAM HERMAN ^{V1057} AND FRED HERMAN ^{200P ENR}	FEE	0.02	0.10	0.12
2	JEFFERY LOWE ^{V1058} ^{800P}	FEE	0.03	0.12	0.15

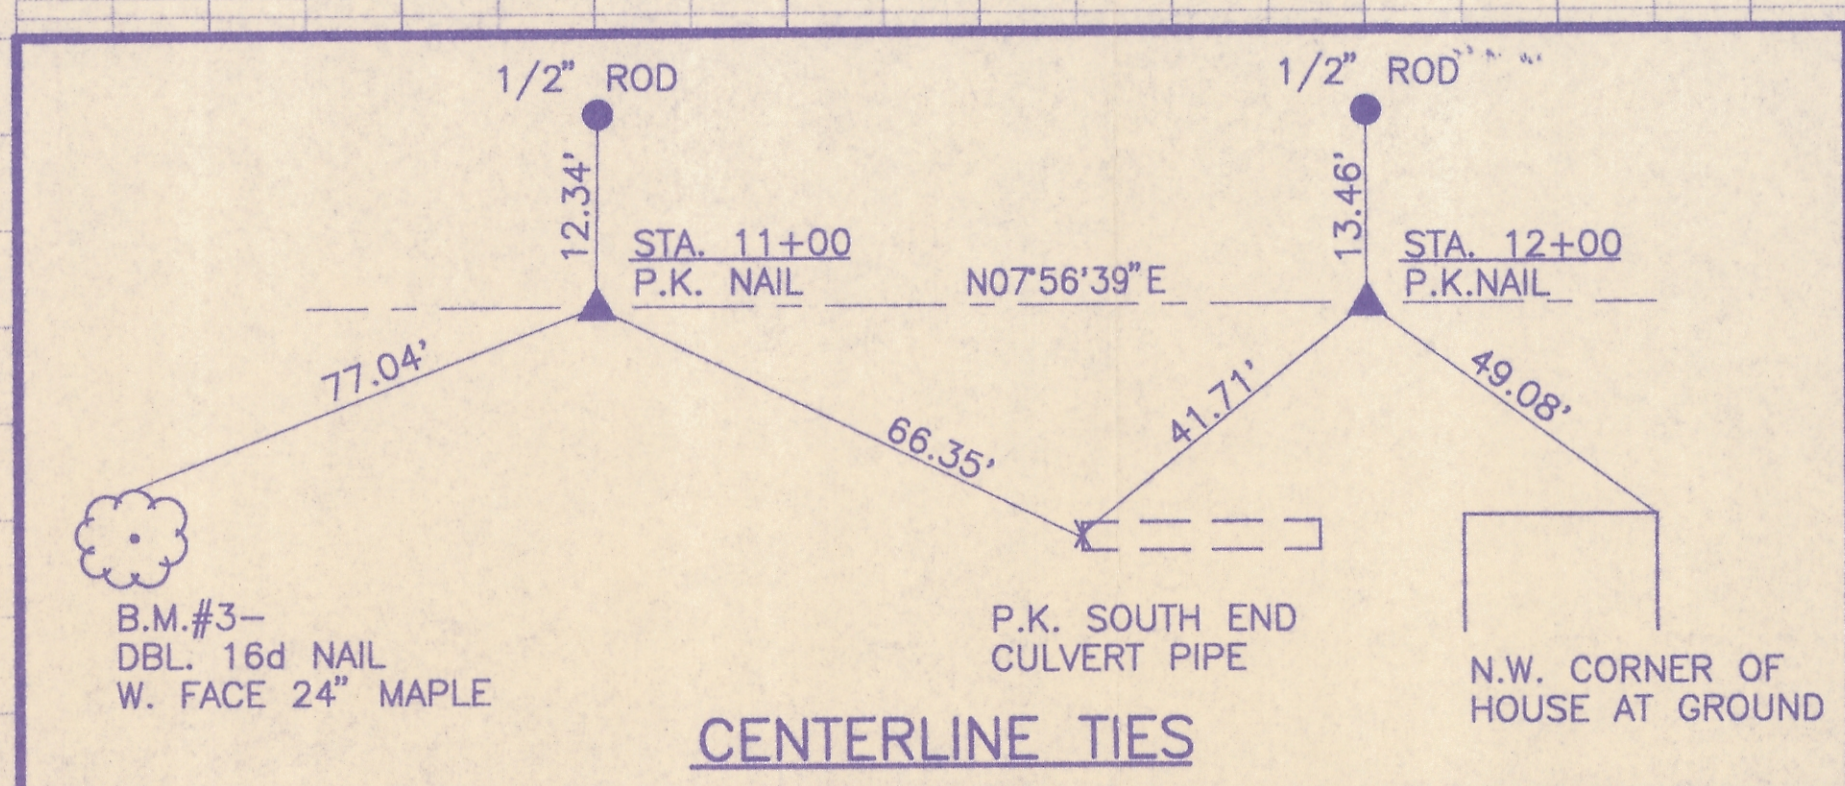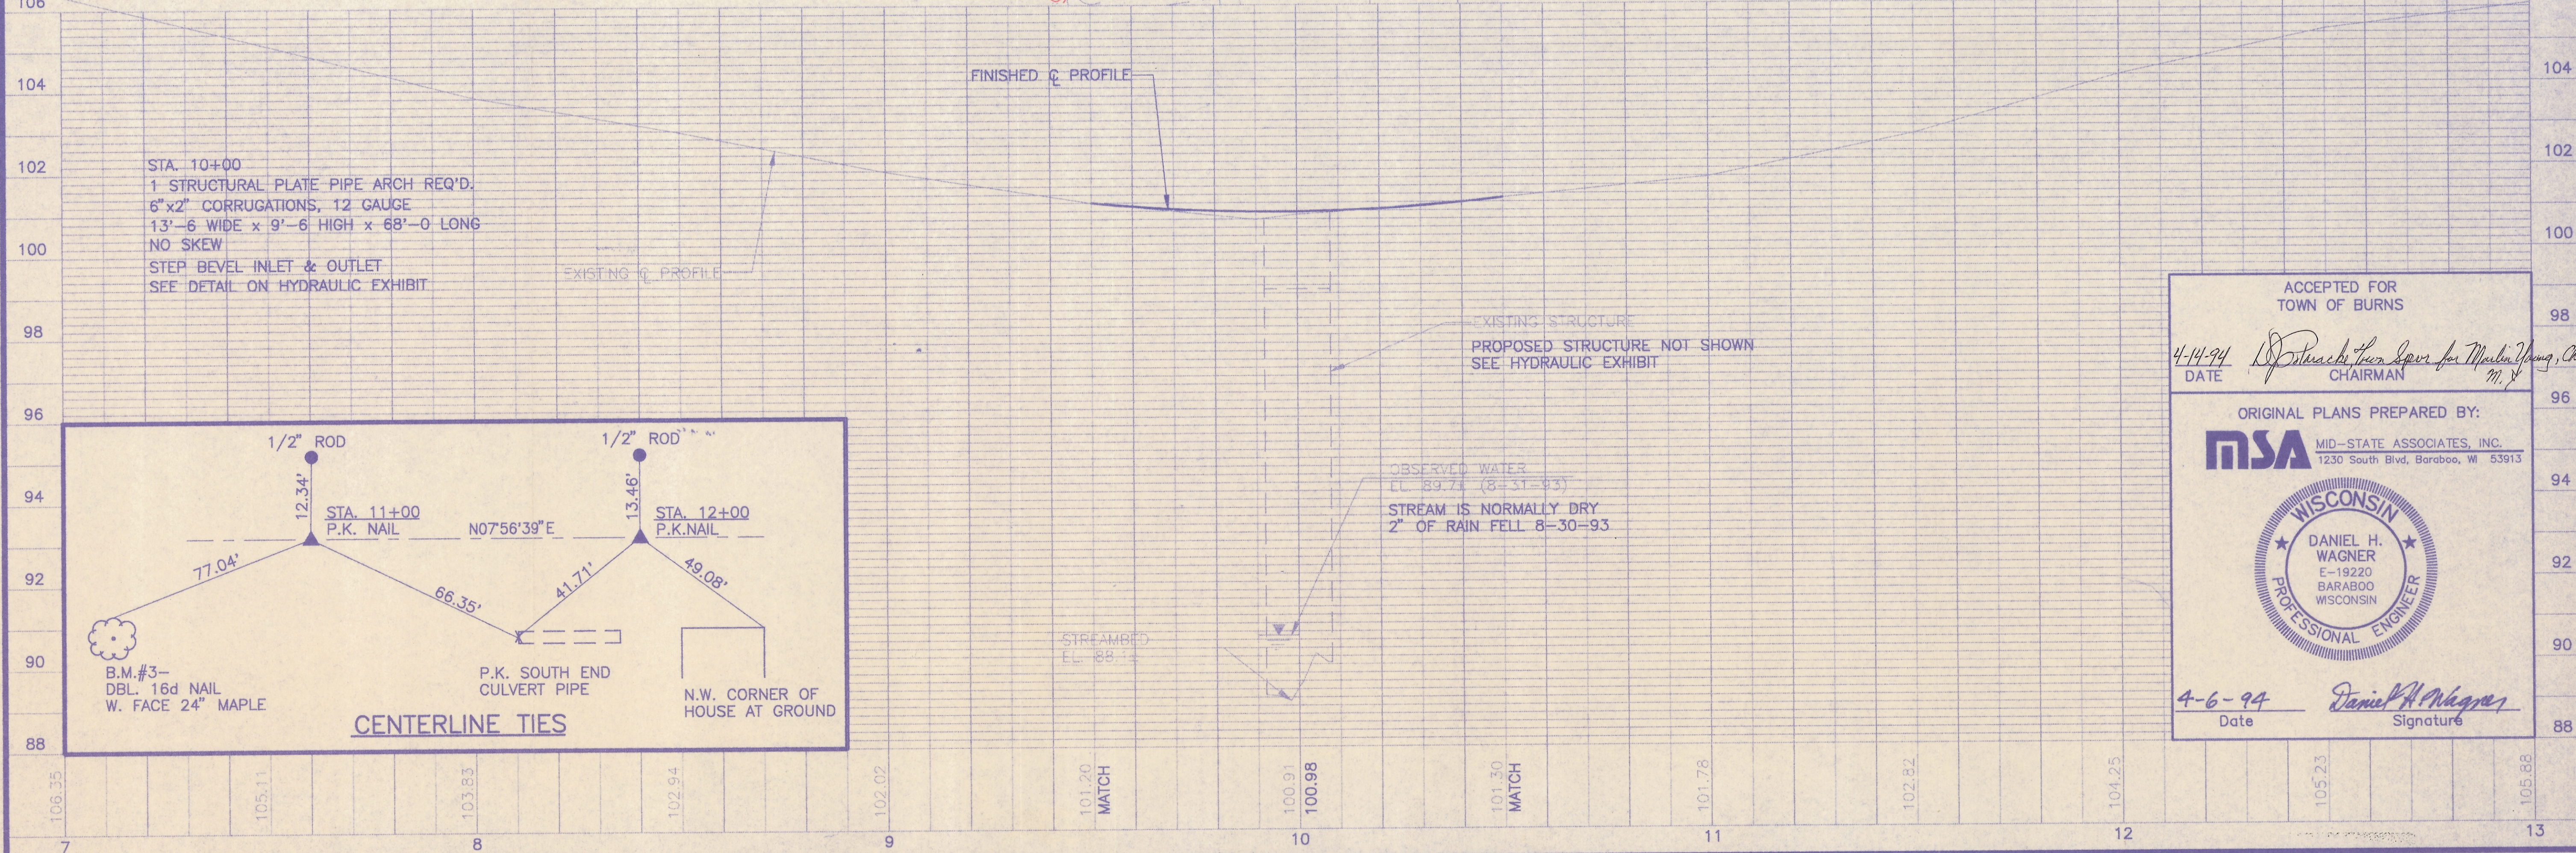

ACCEPTED FOR
TOWN OF BURNS

4-14-94
DATE

CHAIRMAN

ORIGINAL PLANS PREPARED BY:

MSA MID-STATE ASSOCIATES, INC.
1230 South Blvd, Baraboo, WI 53913

WISCONSIN
DANIEL H. WAGNER
E-19220
BARABOO
WISCONSIN
PROFESSIONAL ENGINEER

4-6-94
Date

Daniel H. Wagner
Signature