

SCALE: 1" = 40'

*590-35 Grades*

*Revised 6-6-80*  
 SCALE: 1" = 40' HOZ.  
 1" = 4' VERT.  
*L.S. # 23*  
*R.S. # 10*  
*500' ± G Grades*


MADE IN U.S.A.  
 CLEARPRINT PAPER CO.  
 NO. 1363—PLAN PROFILE PASTE A

MADE IN U.S.A.  
 CLEARPRINT PAPER CO.  
 NO. 1363—PLAN PROFILE PASTE A

TOWN OF CAMPBELL

BREEZY POINT ROAD

PLAN NO. 586

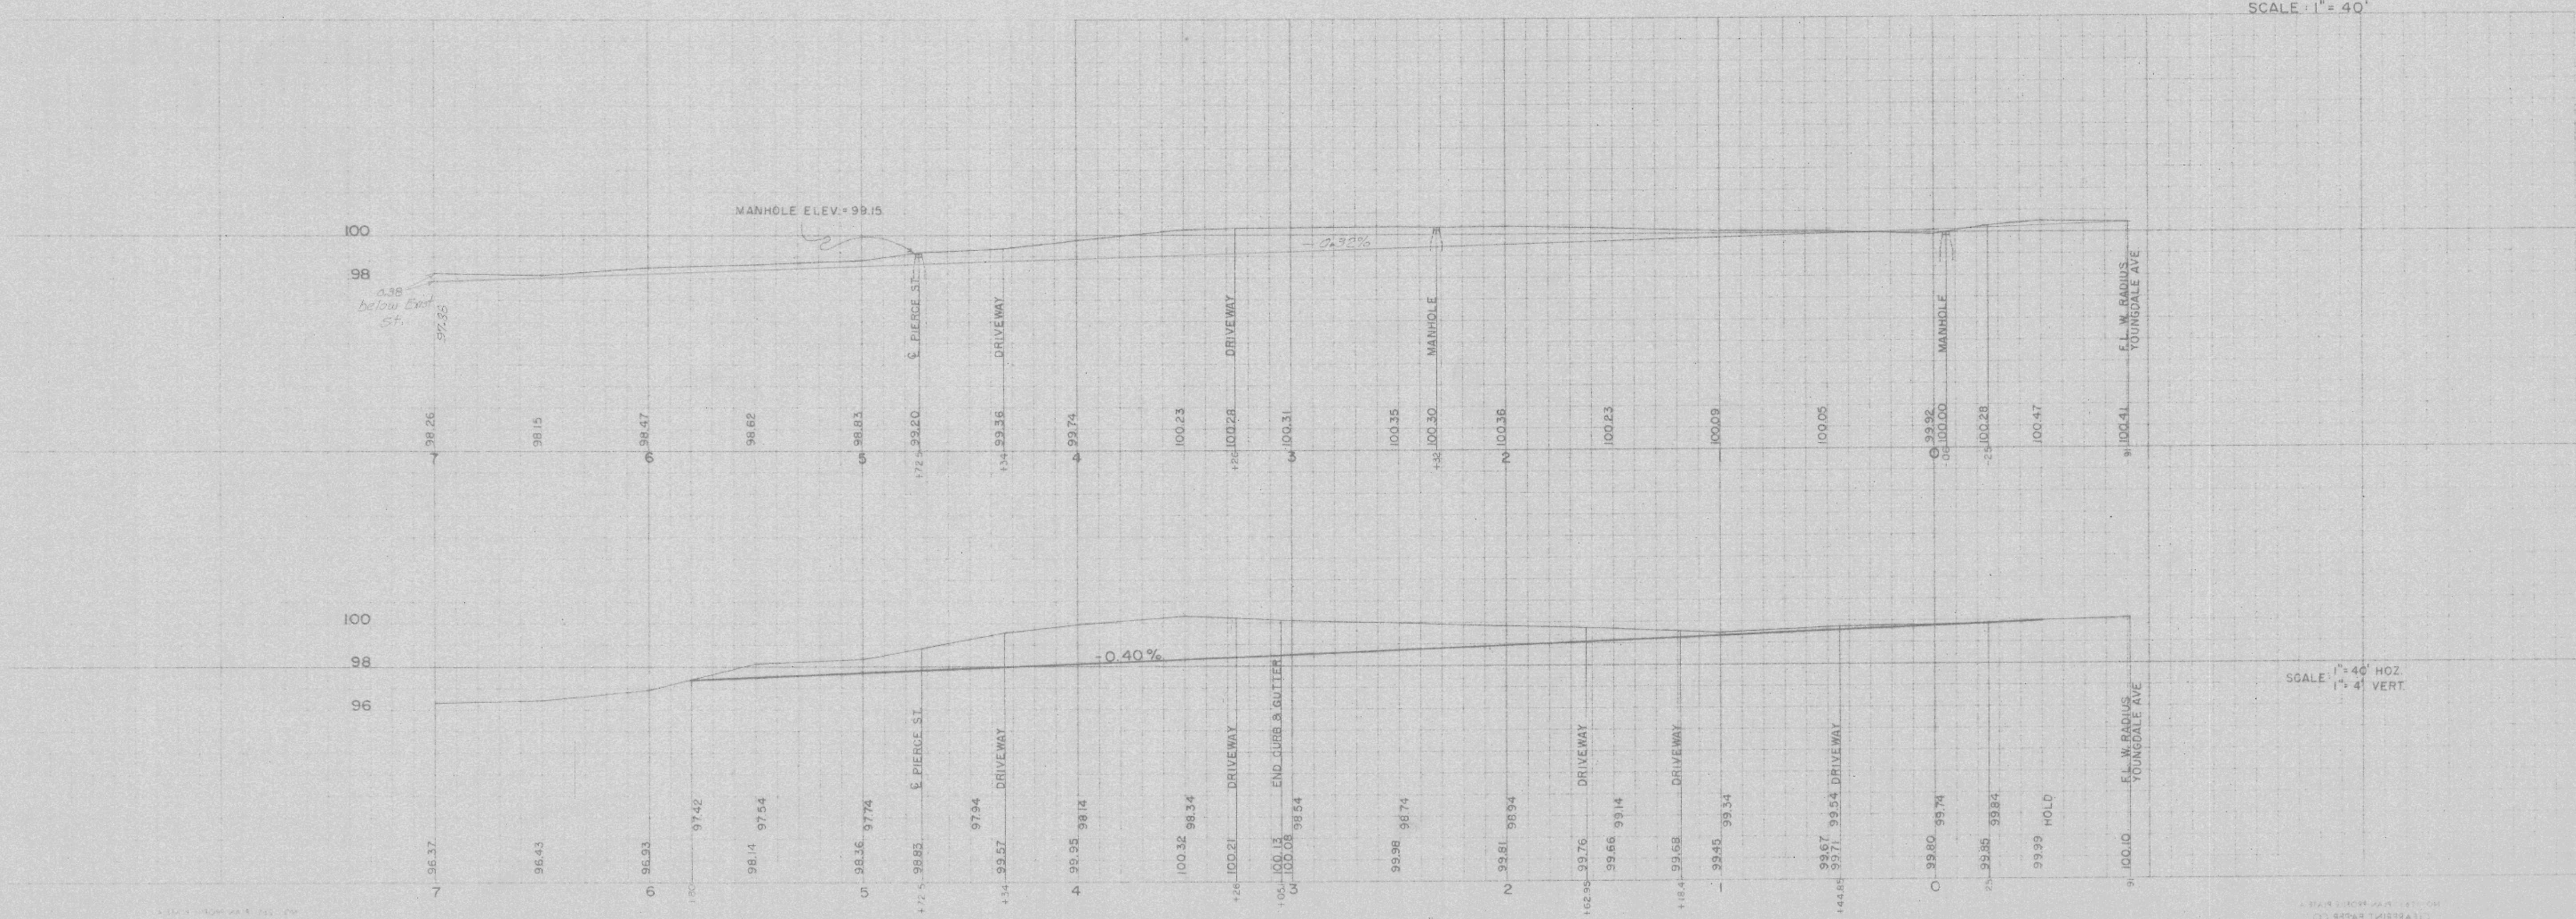

SCALE: 1" = 40'

SCALE: 1" = 40' HORIZ.  
1" = 4' VERT.




















TOWN OF CAMPBELL


BREEZY POINT ROAD




Breezy Pt. Rd.  
 SECTIONS  
 PROCURBUT.  
 6-S-80  
 17.000 17.000

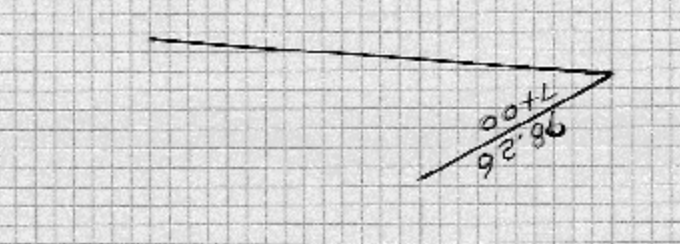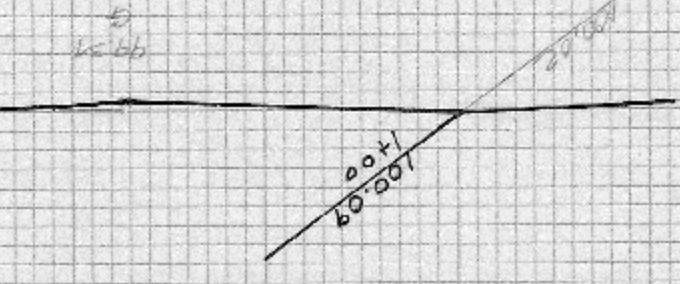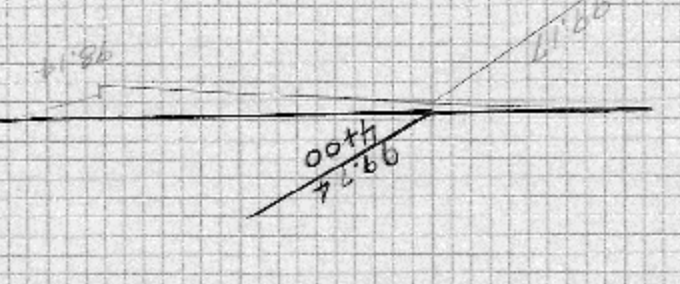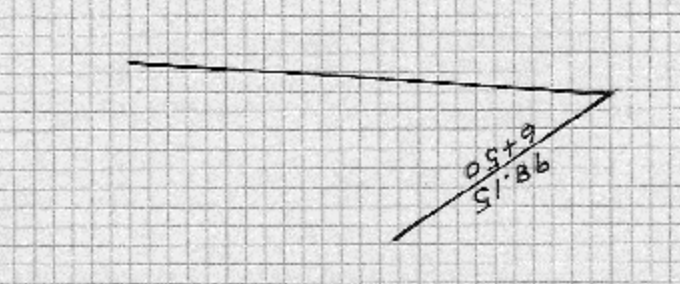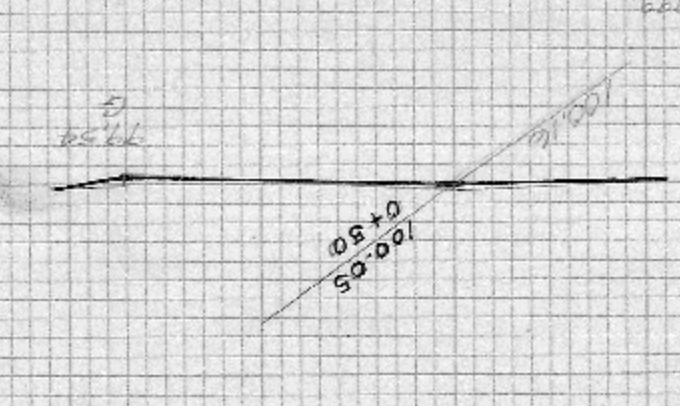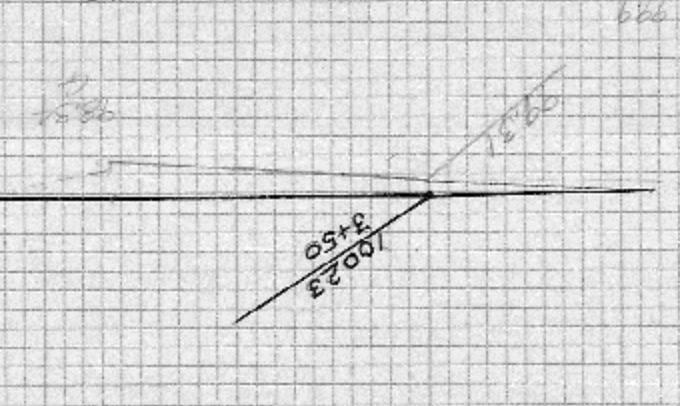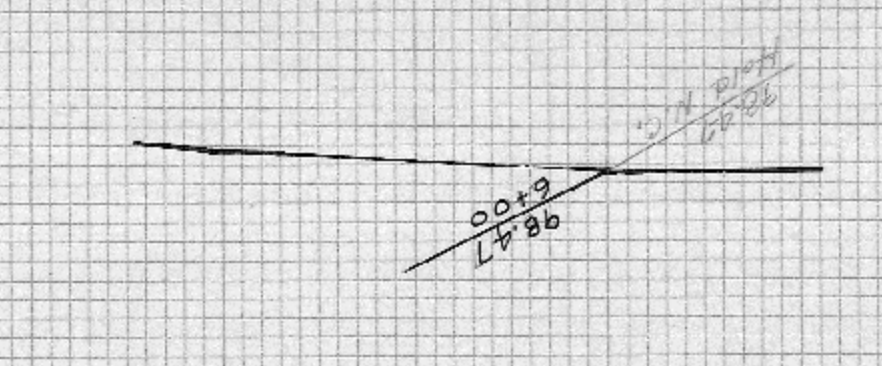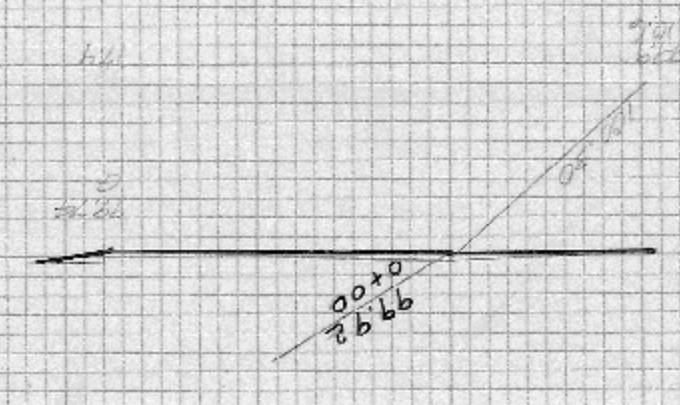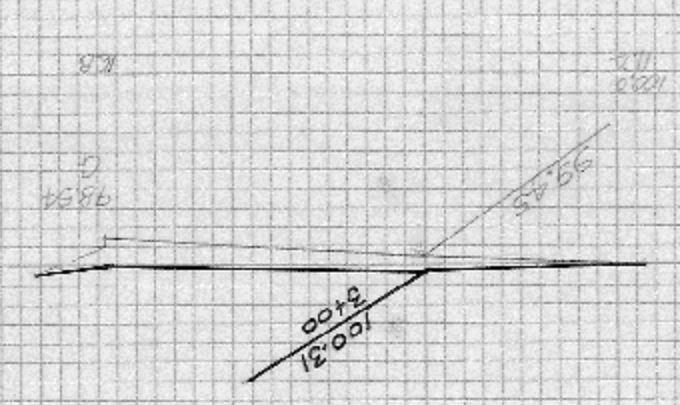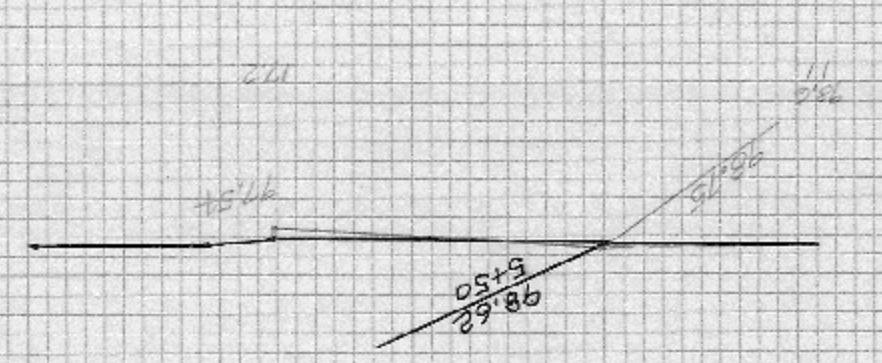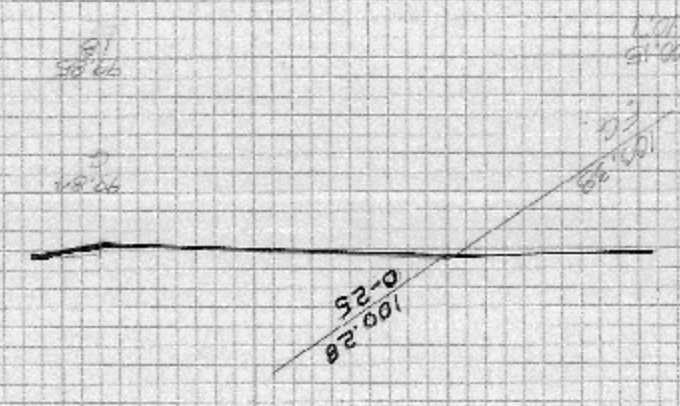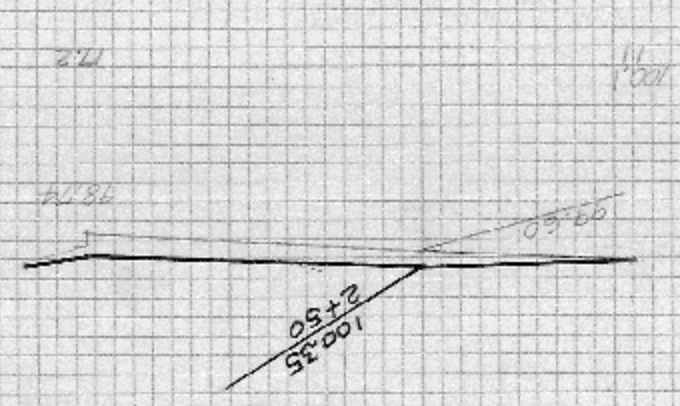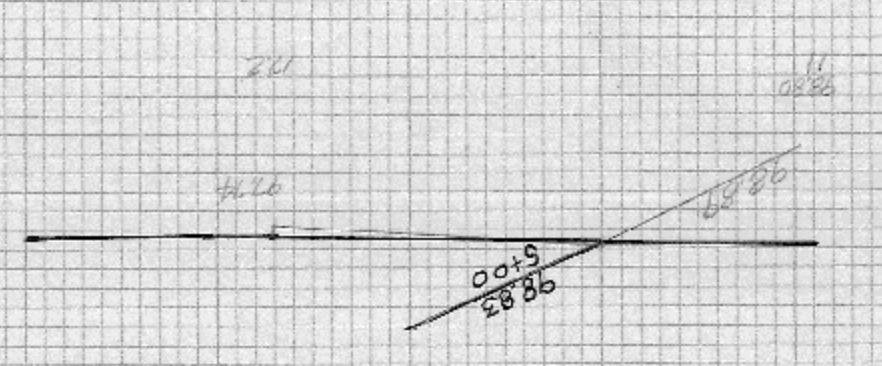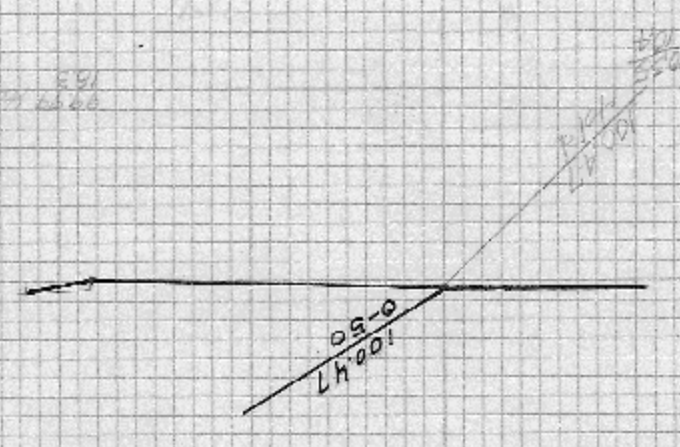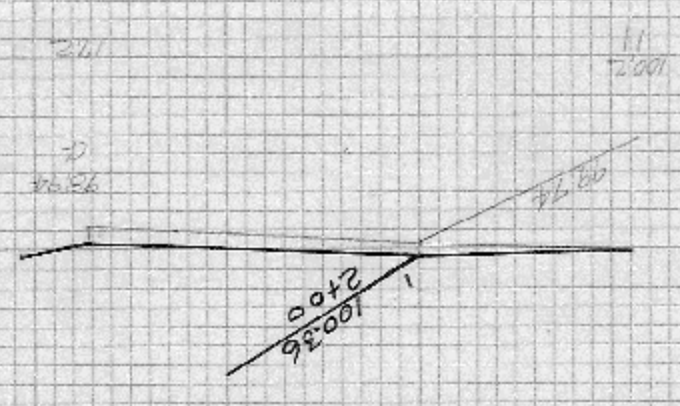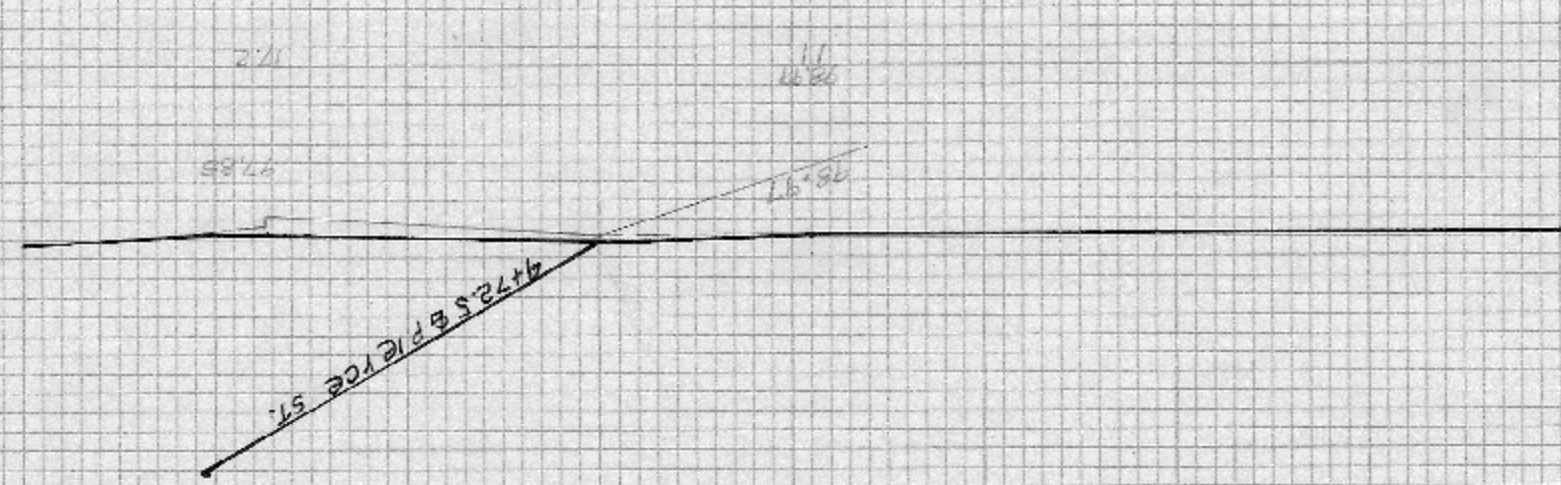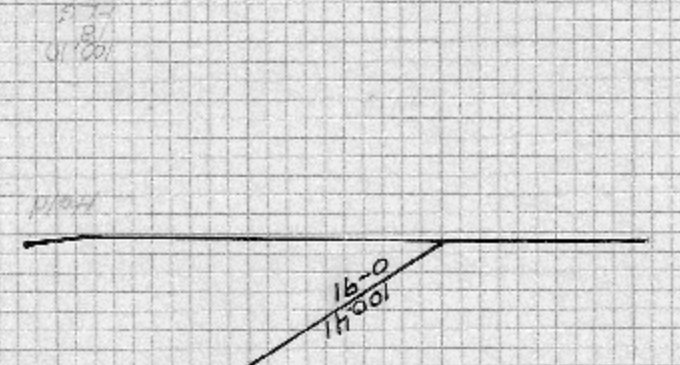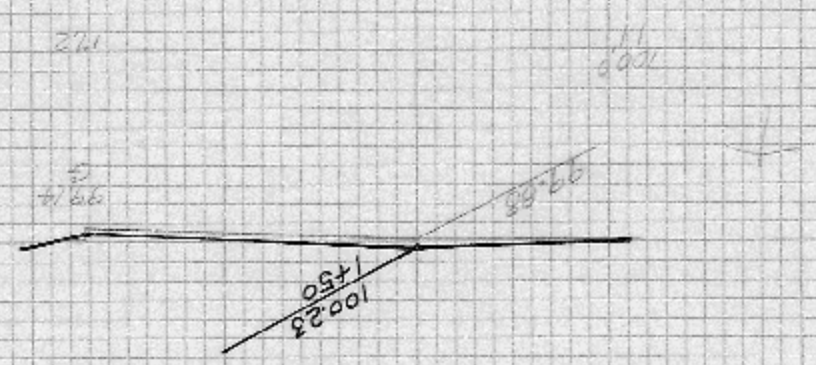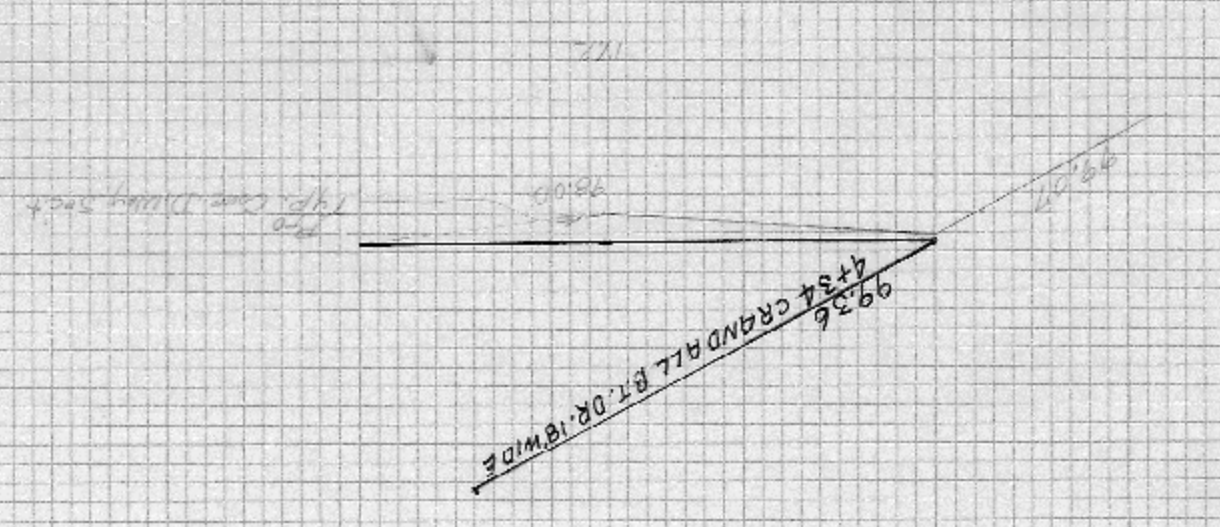

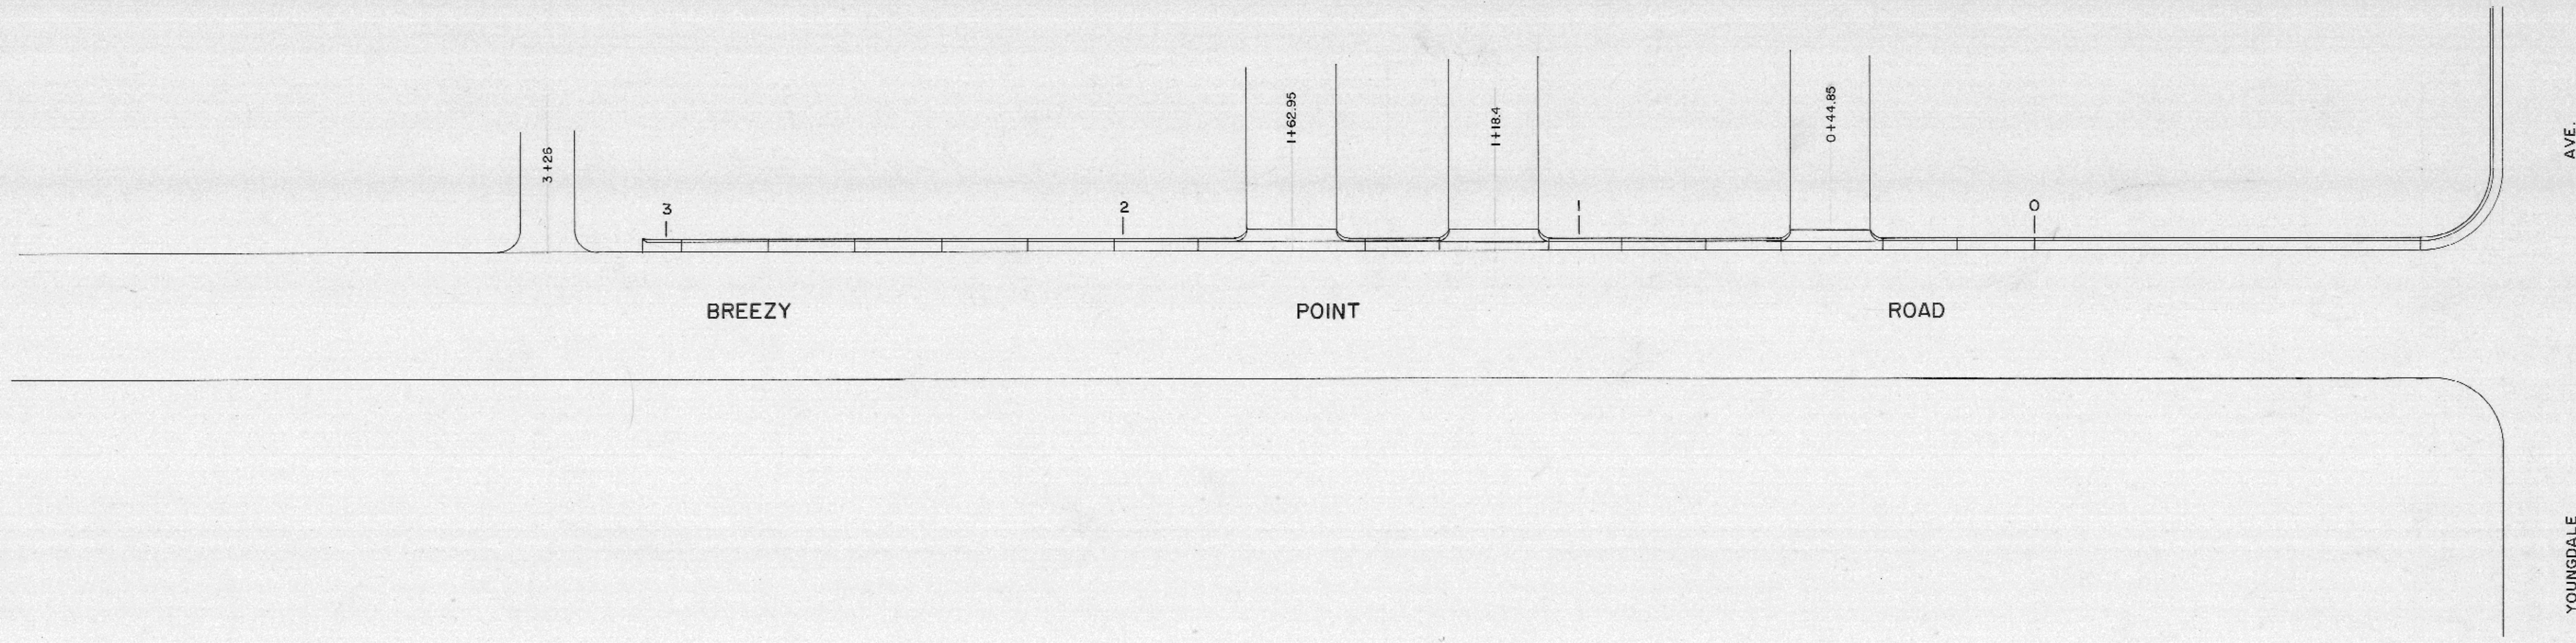

*Void see revised sheet*




SCALE: 1" = 20'

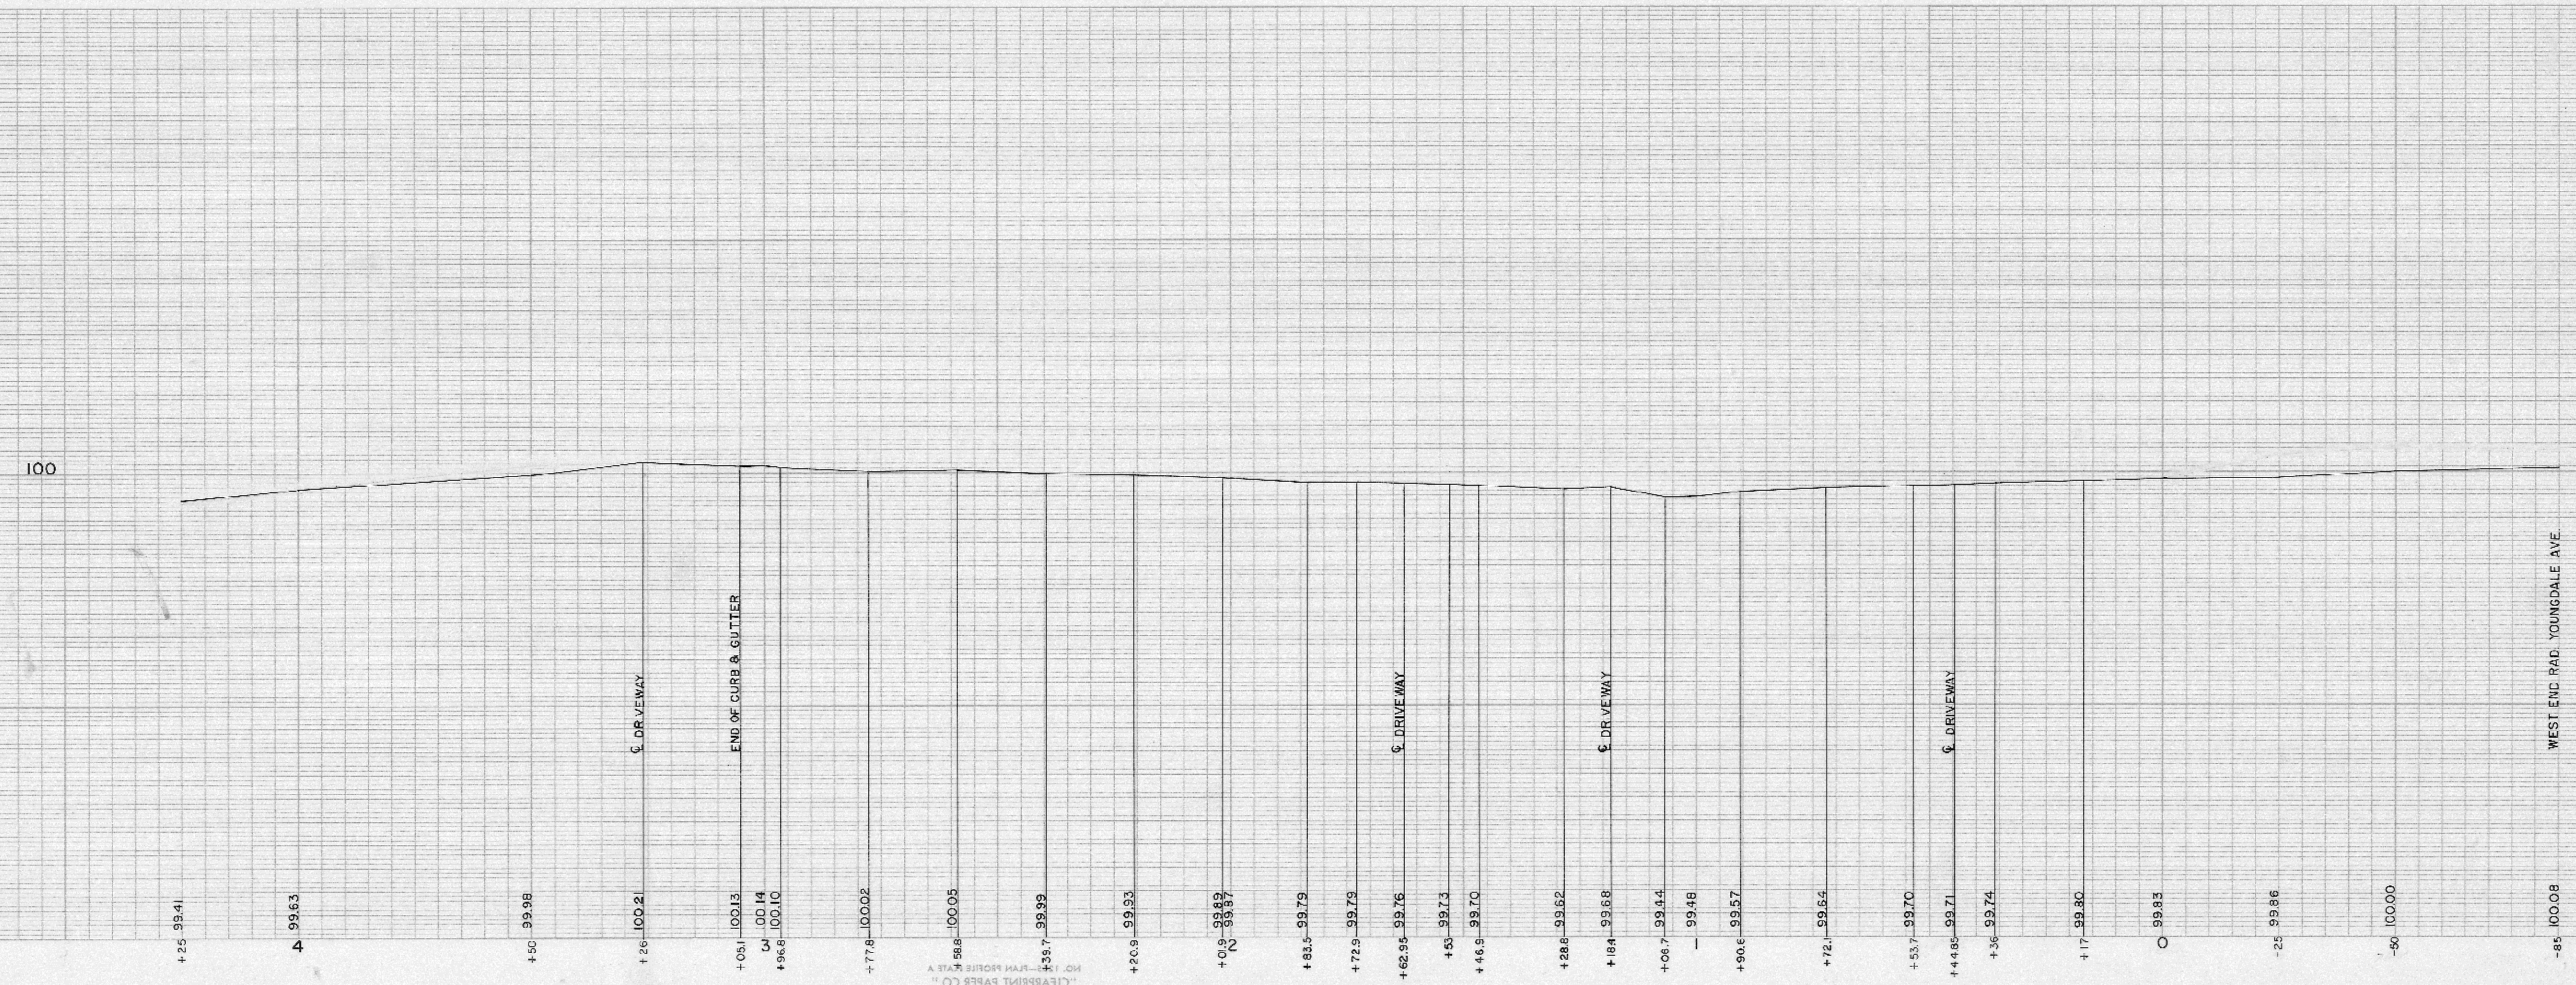

SCALE: 1" = 20' HOZ.  
1" = 2' VERT.  
DATE: 4-16-80  
LEVEL BOOK NO. 73

TOWN OF CAMPBELL

PROFILE OF GUTTER ON NORTH SIDE OF BREEZY POINT RD. FROM YOUNGDALE AVE. WEST

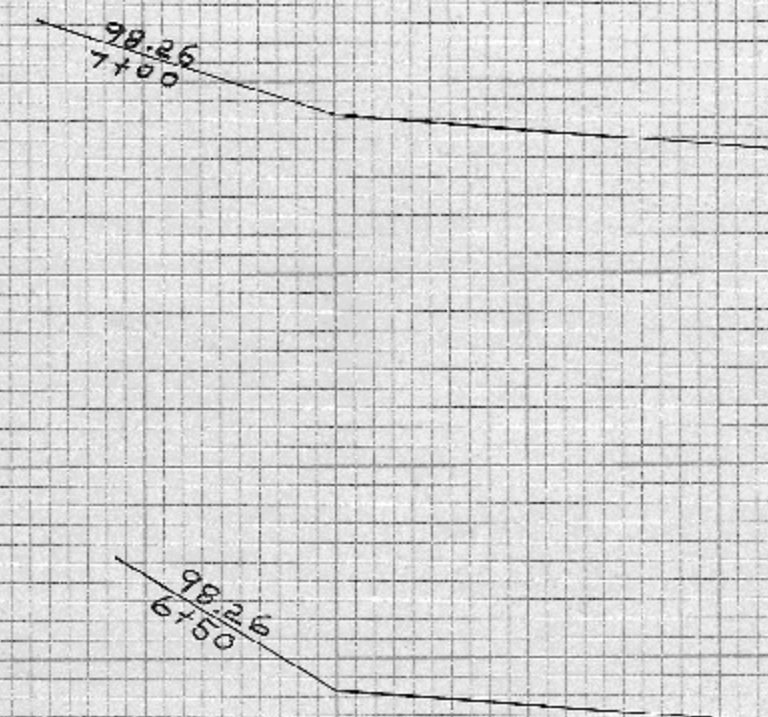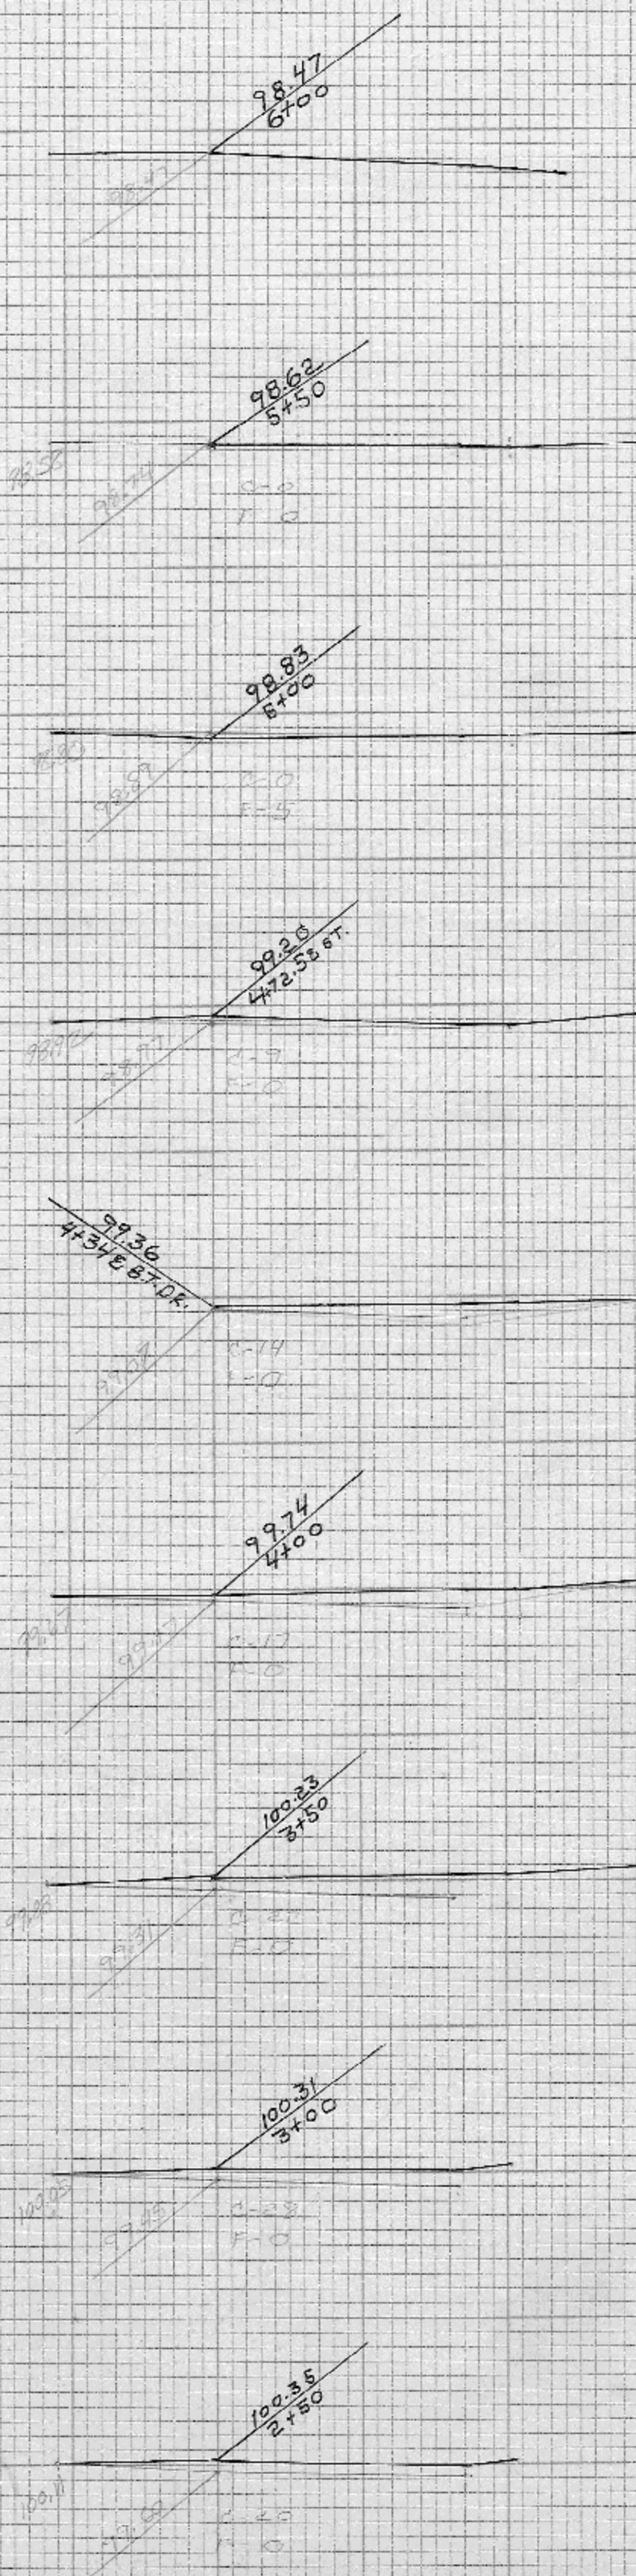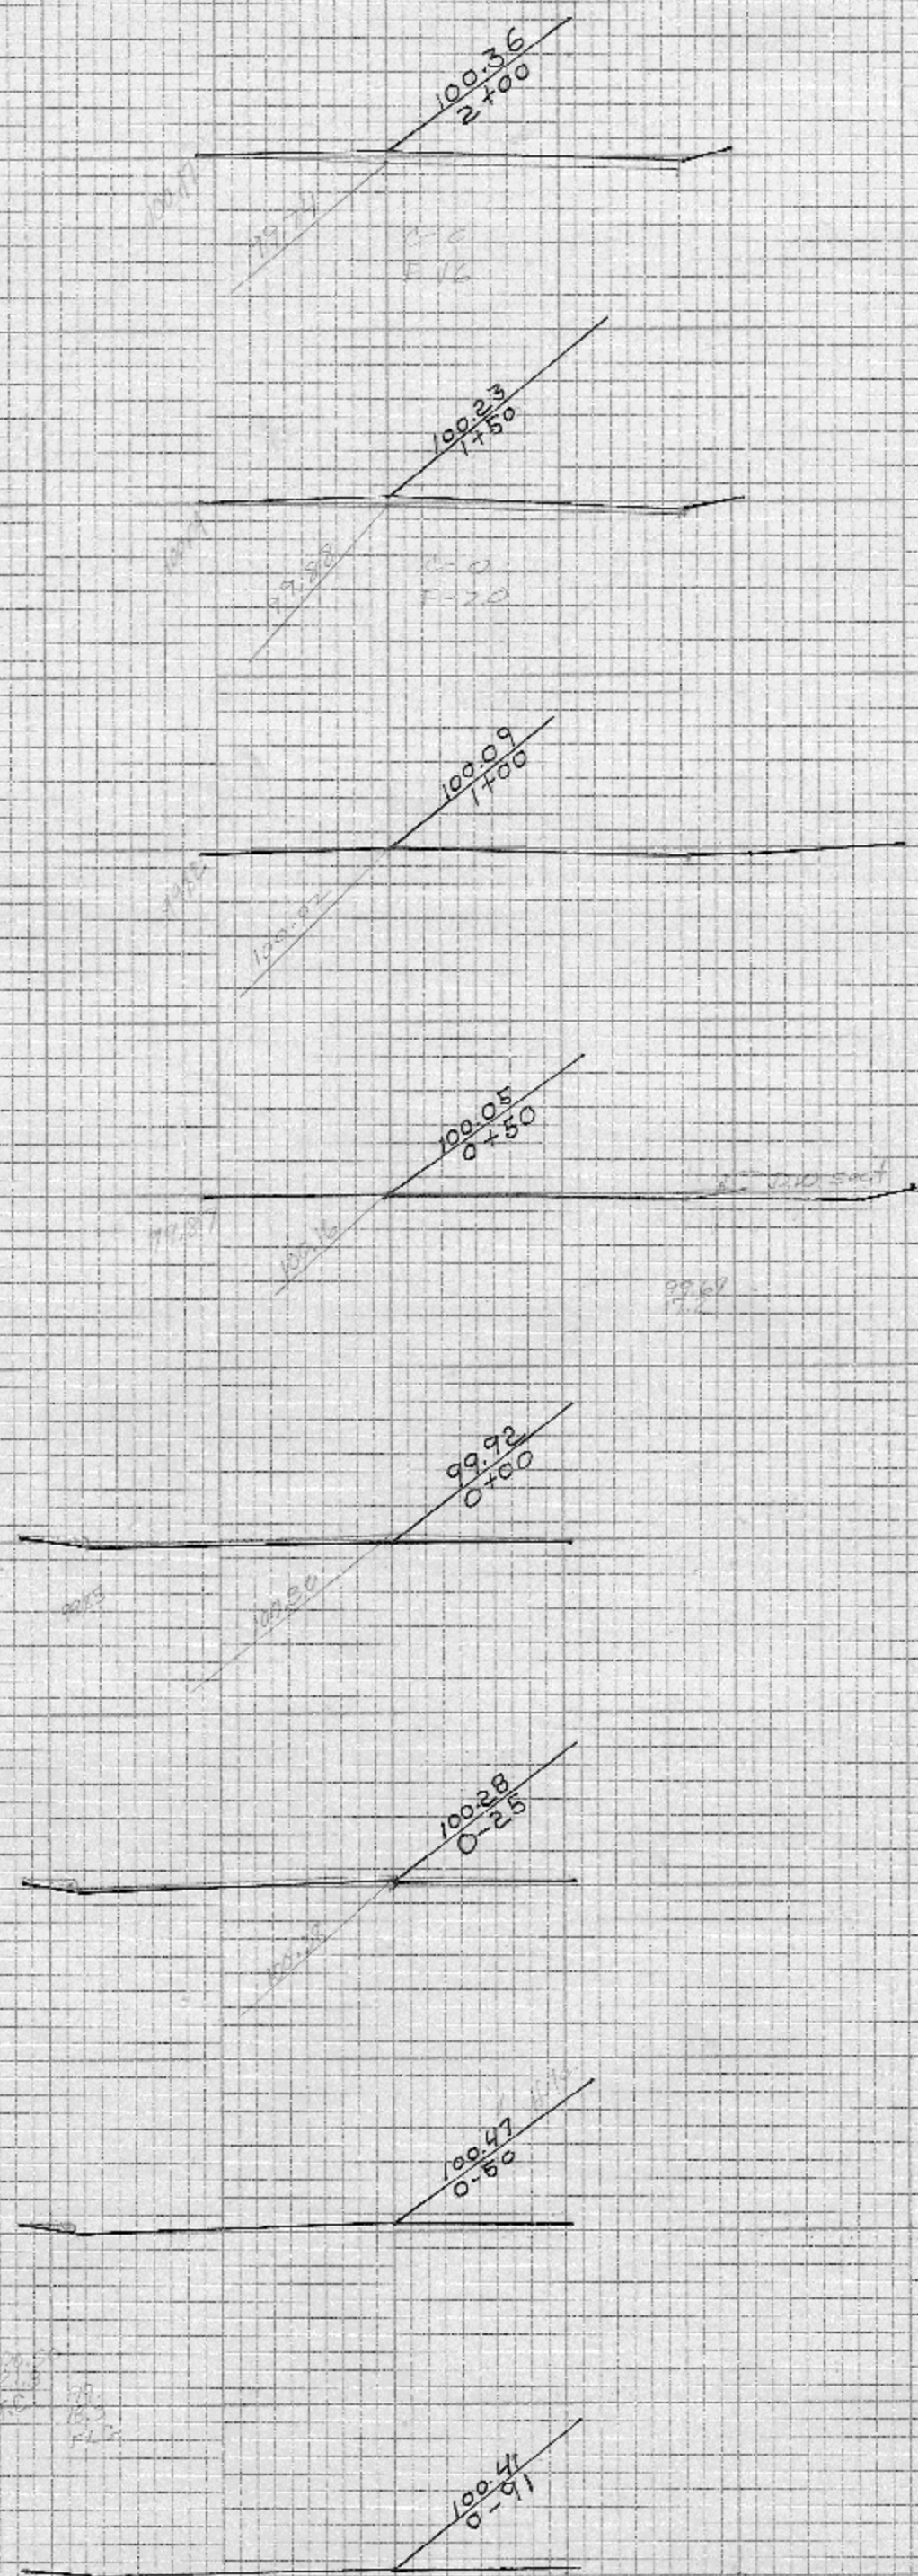

XSECTIONS  
 BREEZY PT. RD.  
 6-5-80