

TOWN OF FARMINGTON



BRIDGE 108

CTH "V"

9-20-73  
SCALE 1"=10' HOR. & VERT.

PLAN 473

TOP DECK 99.94  
LOW STEEL 97.94

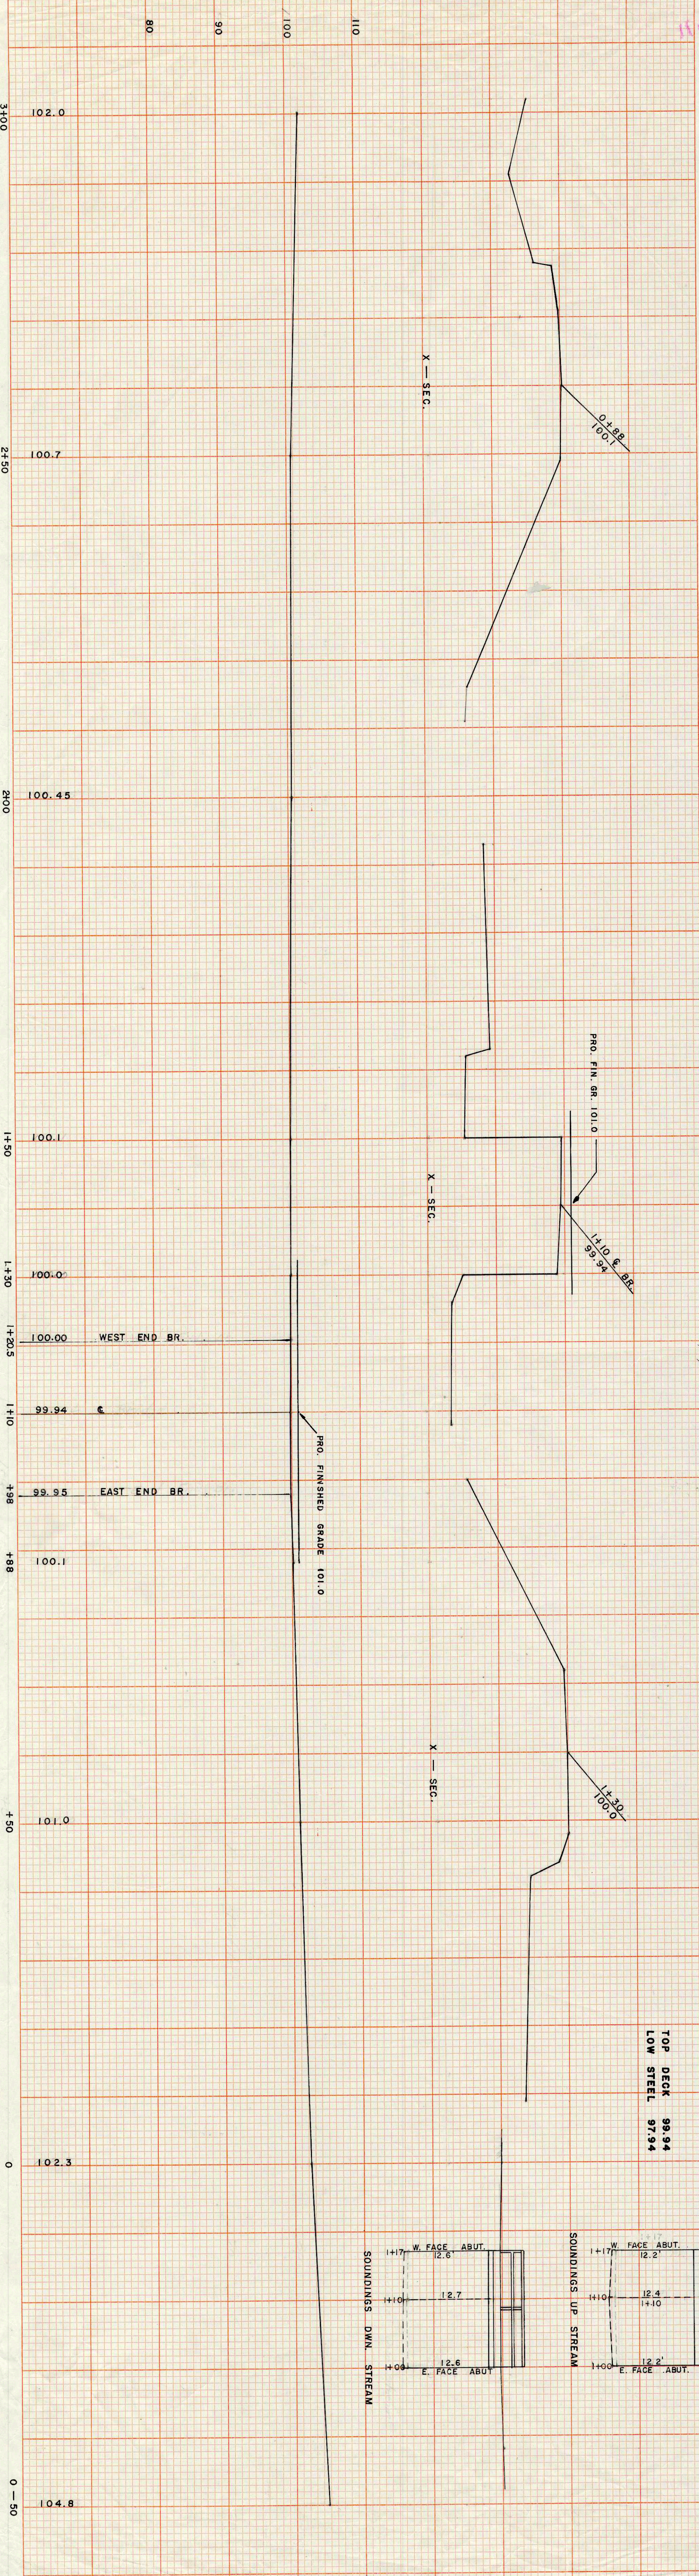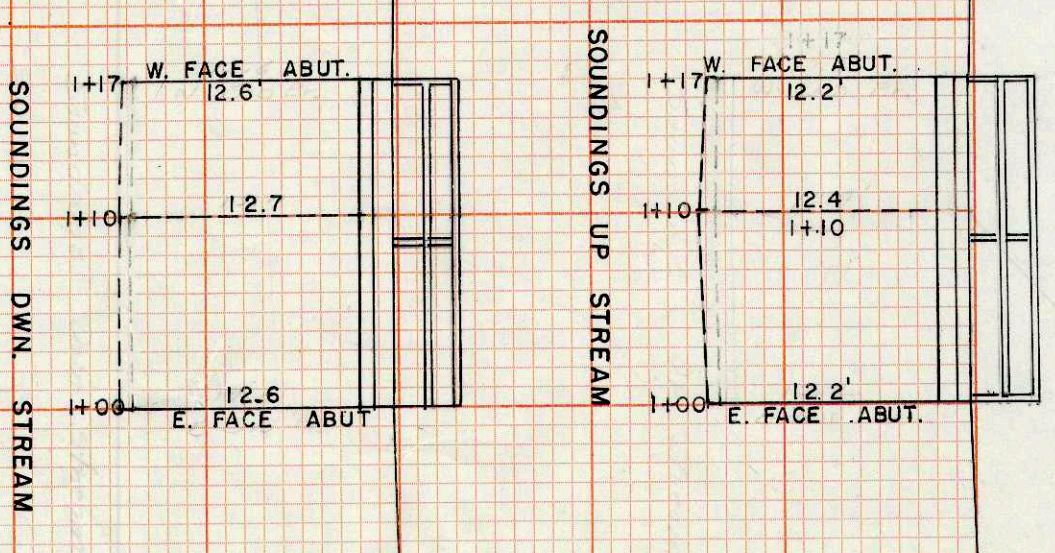

TRAFFIC STANDARD  
CROSS SECTION TO X 10  
NEW YORK

KEUFFEL & ESSER CO.  
NEW YORK





473