



B.P.R. DIVISION	PROJECT	SHEET NUMBER	TOTAL SHEETS
EN	GREENFIELD "YY"	2	2
	61-606-40		

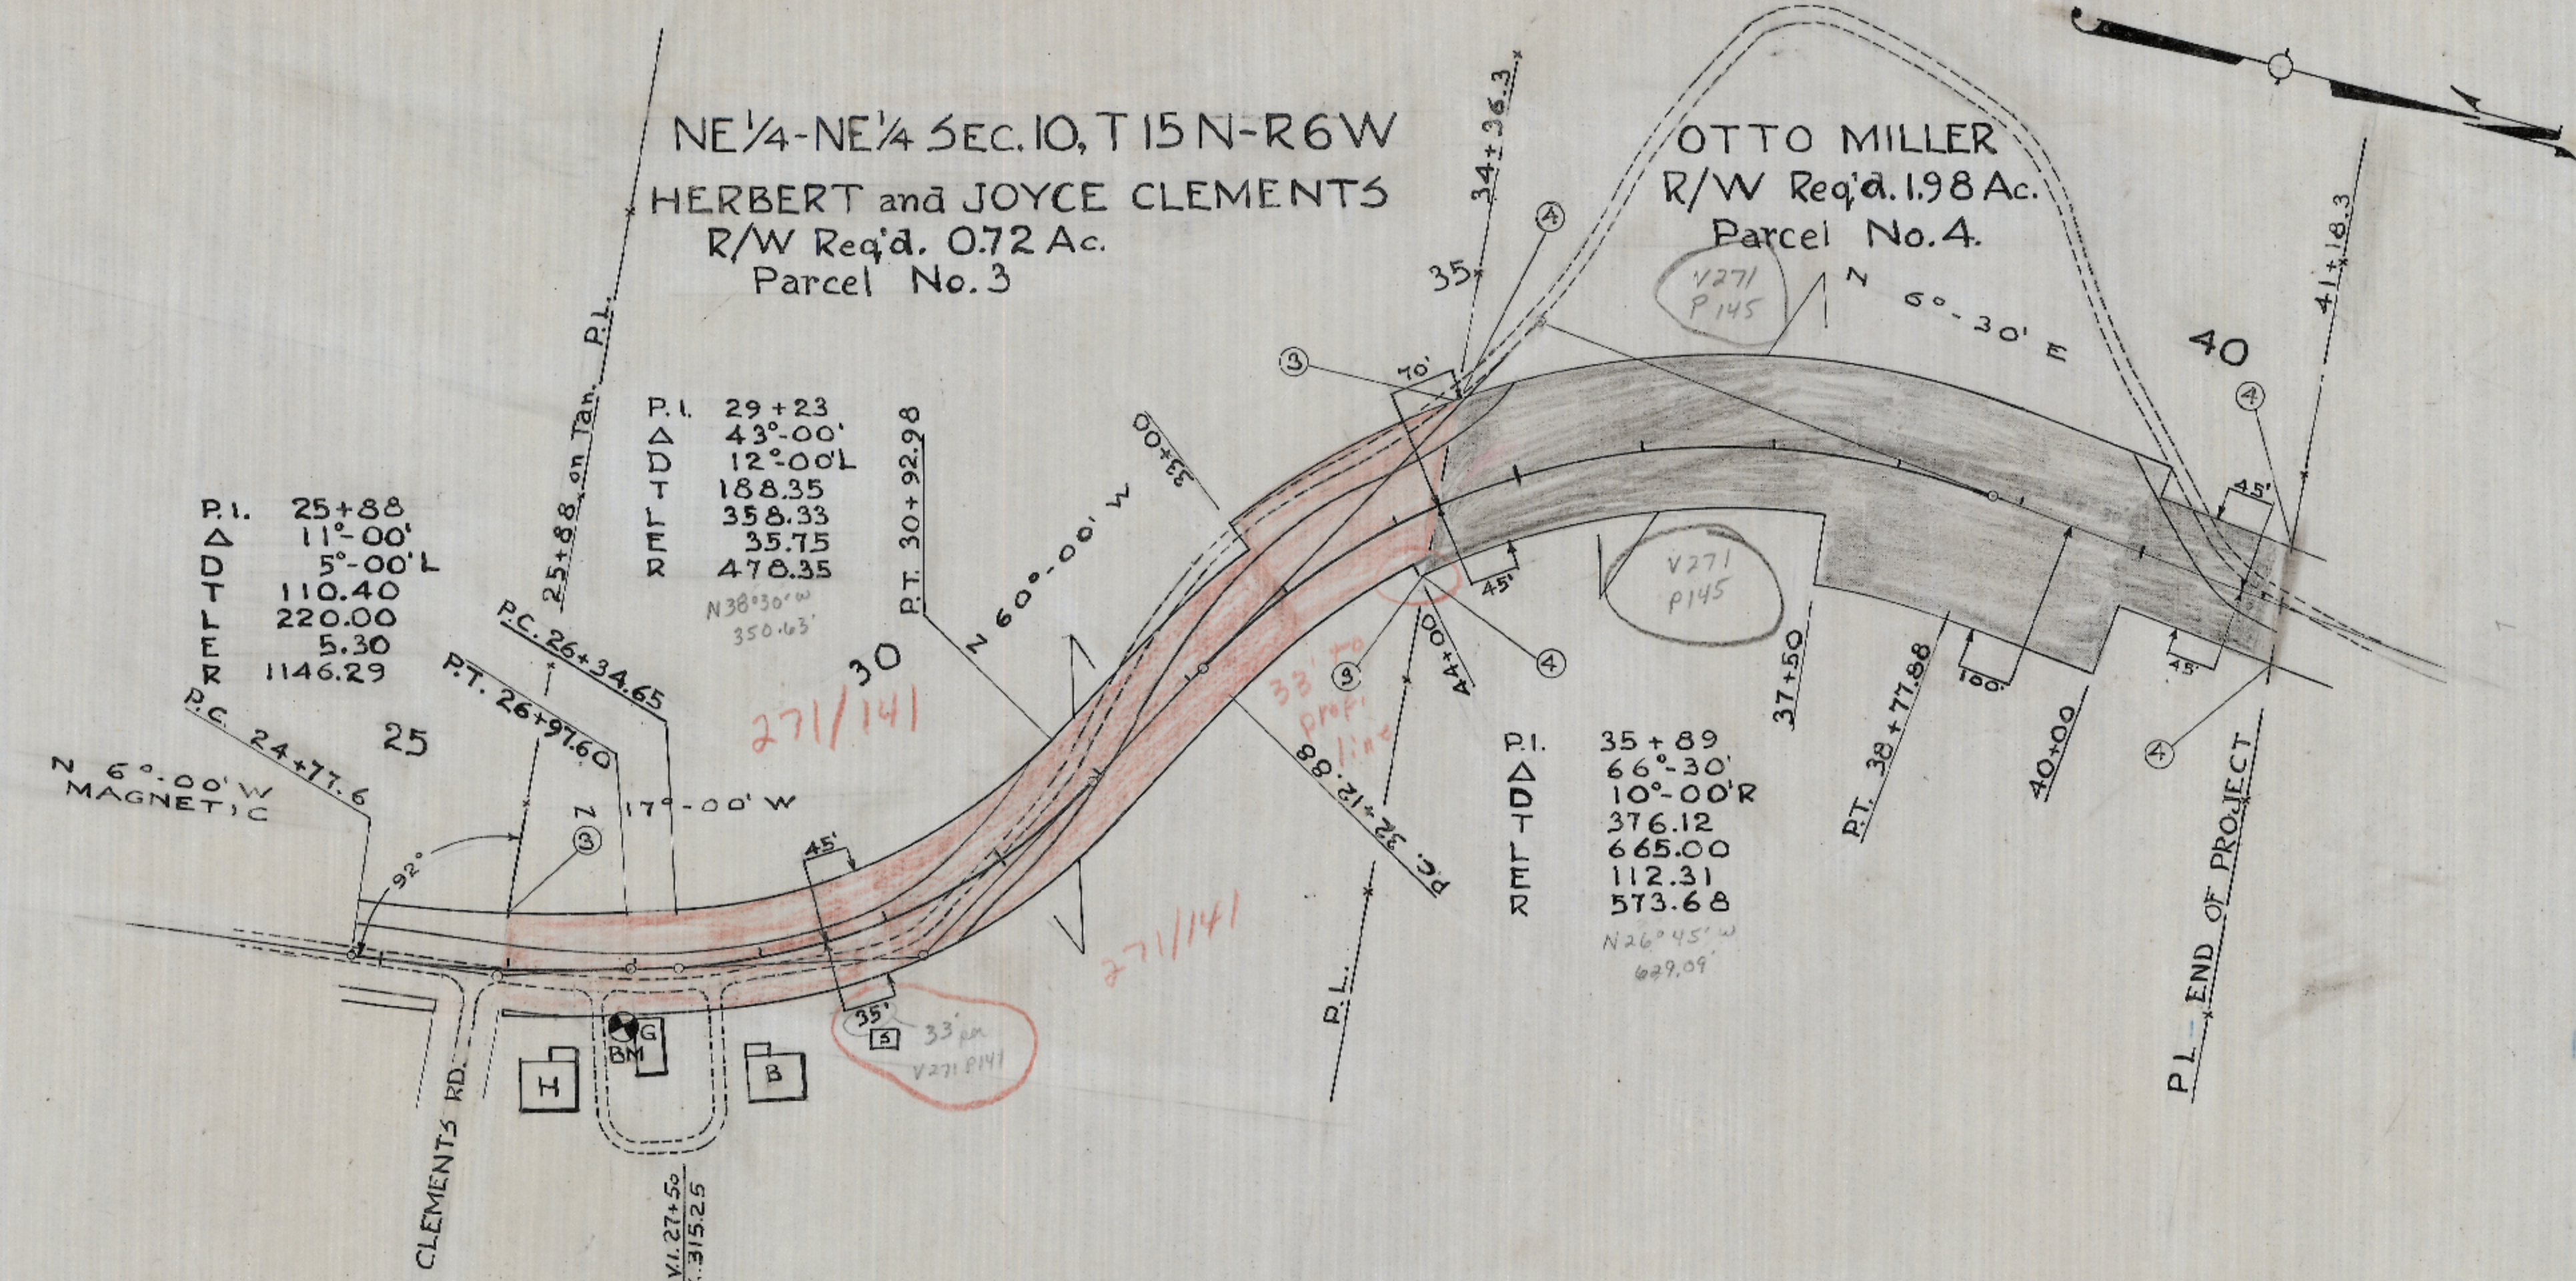

B.M. 40' COTTONWOOD 33' Rf. 26+96 EL. 310.13

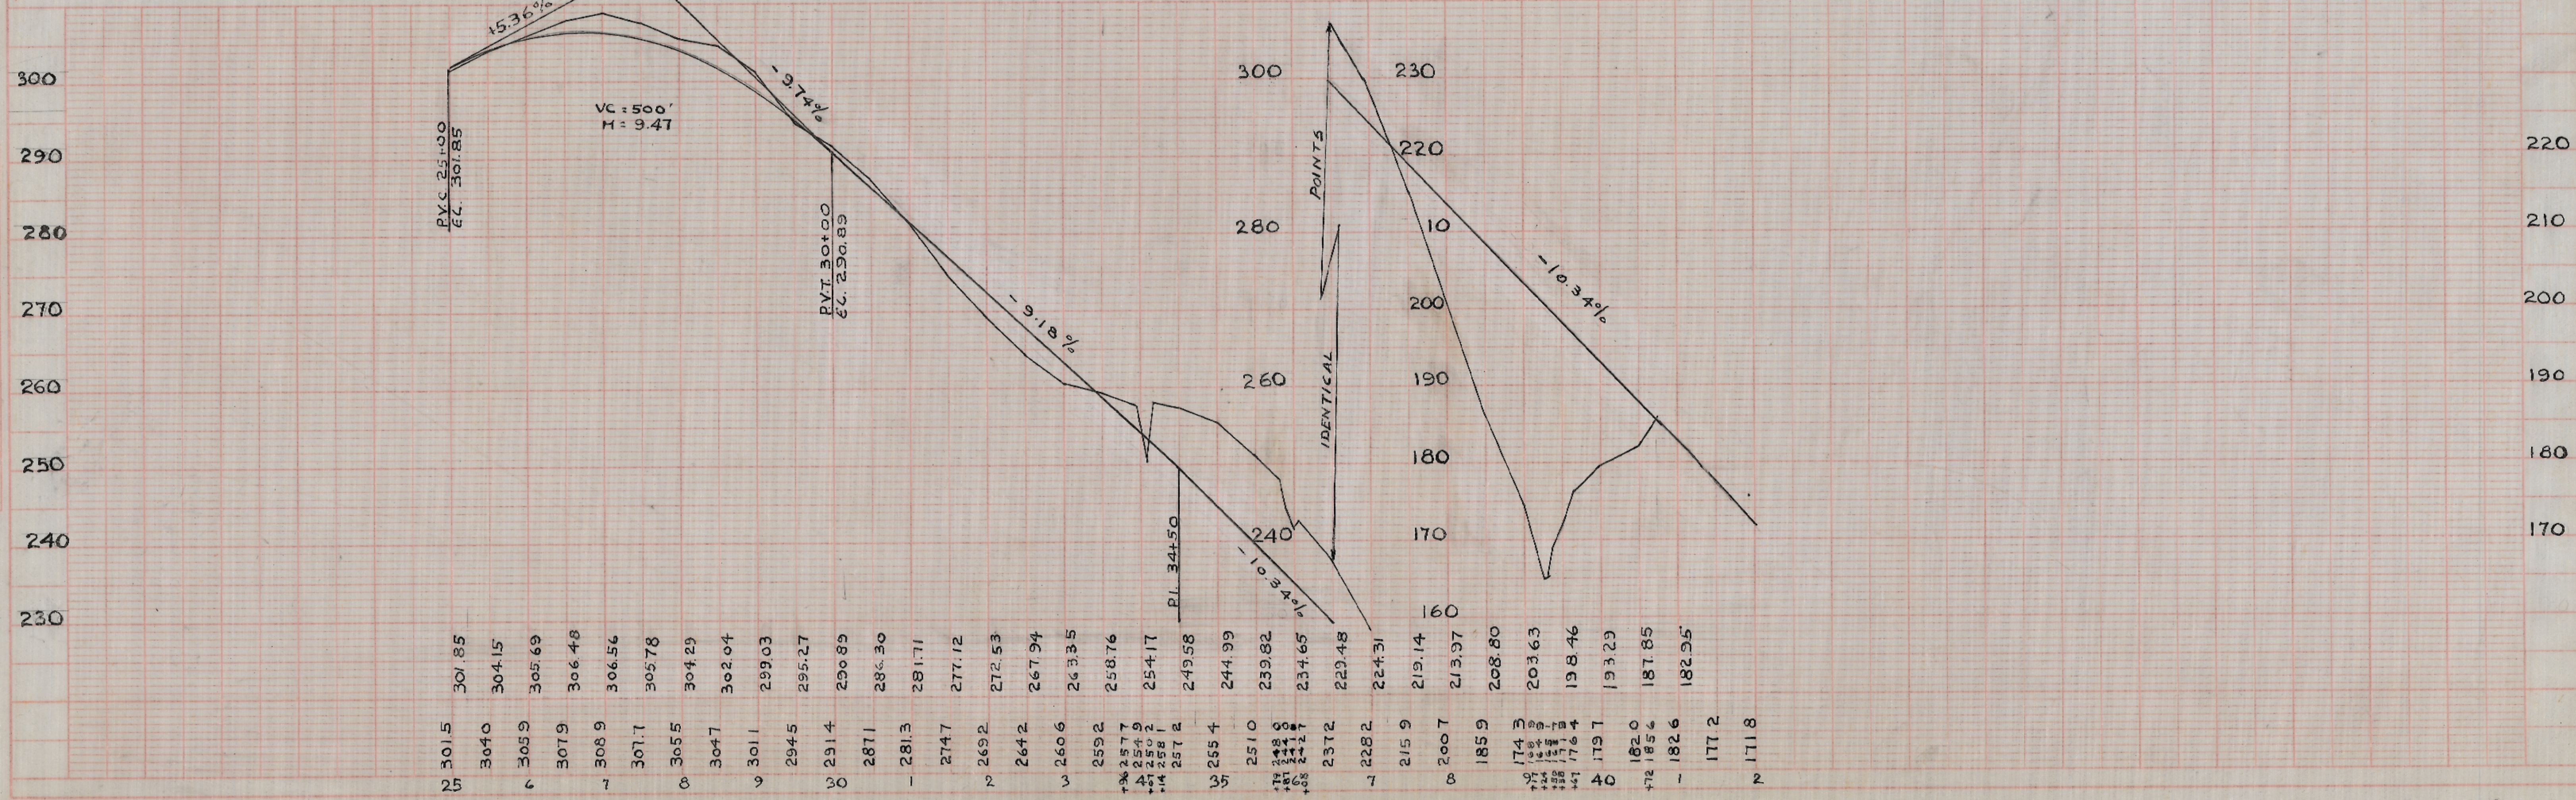

PLAN
5/19/56
J.M.
102

PROFILE
5/19/56
101