





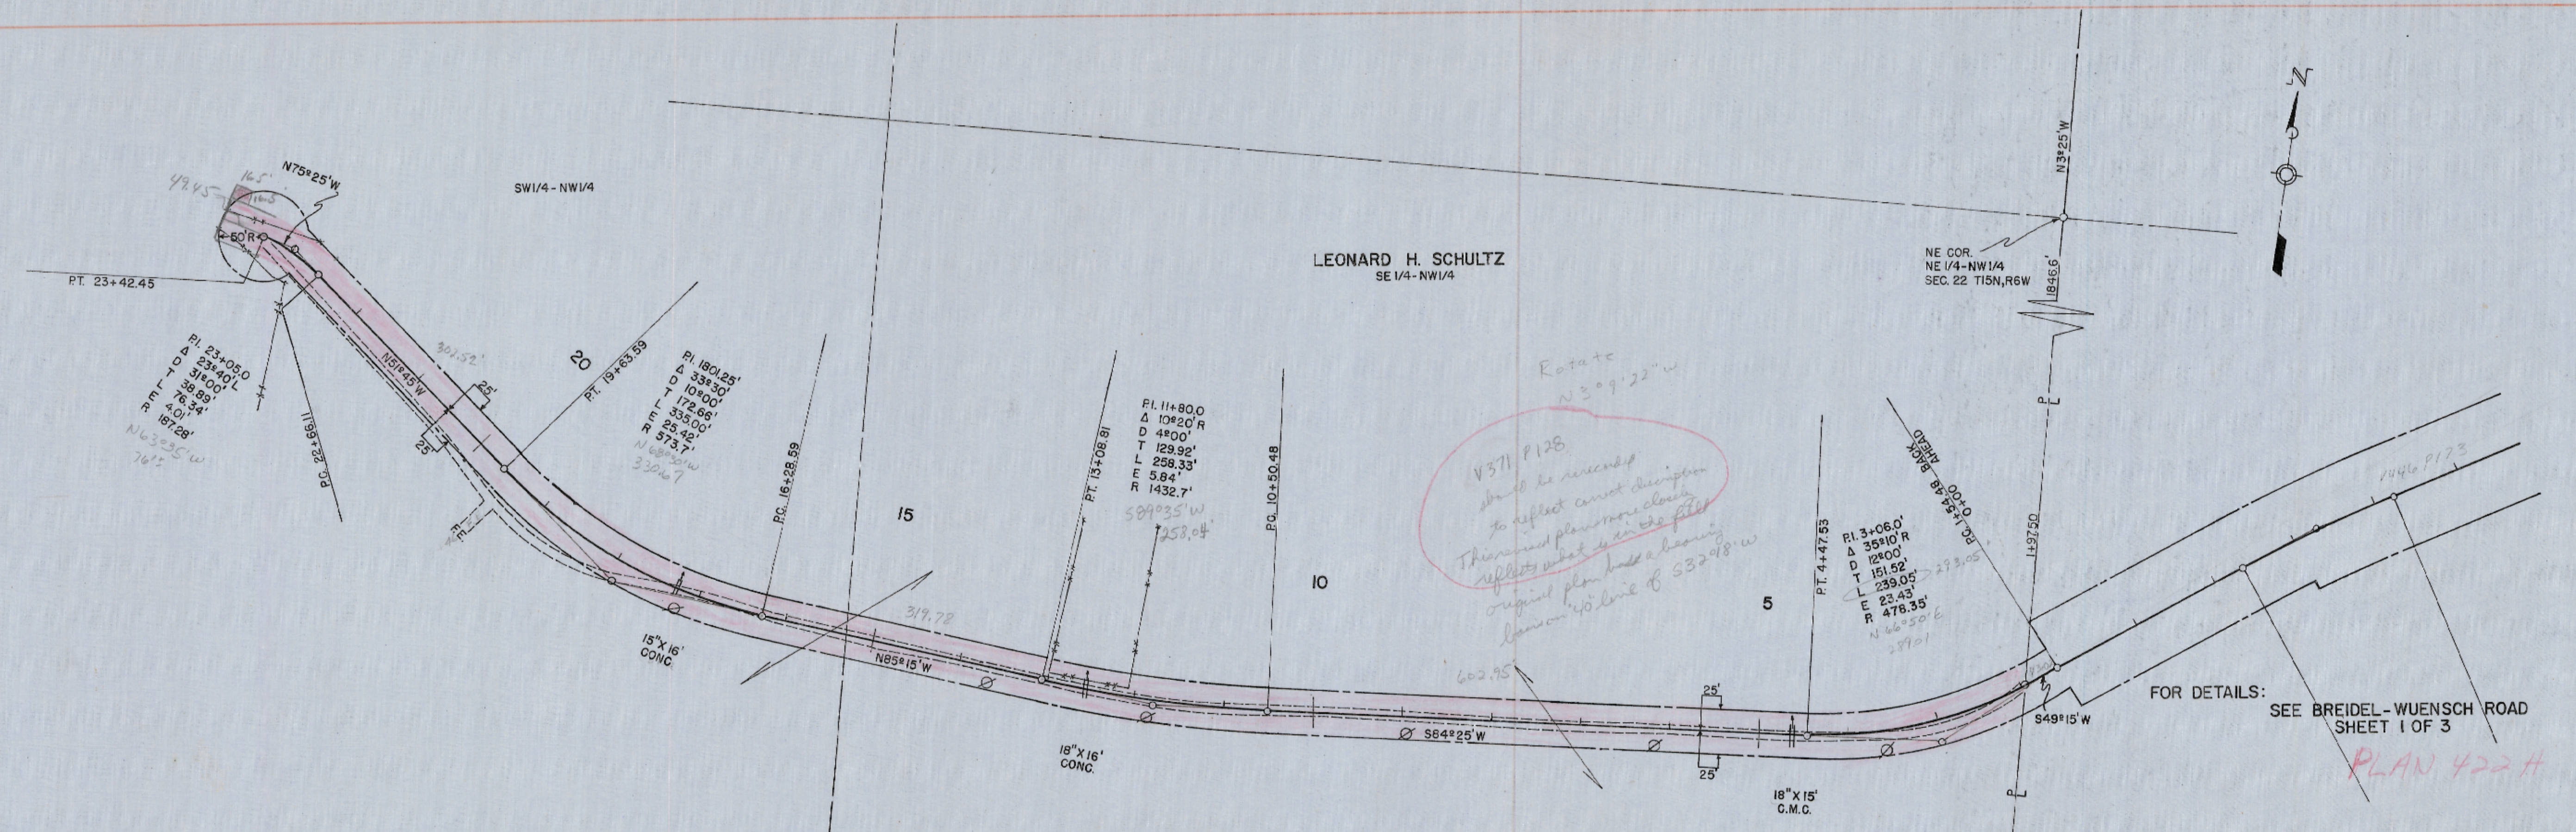




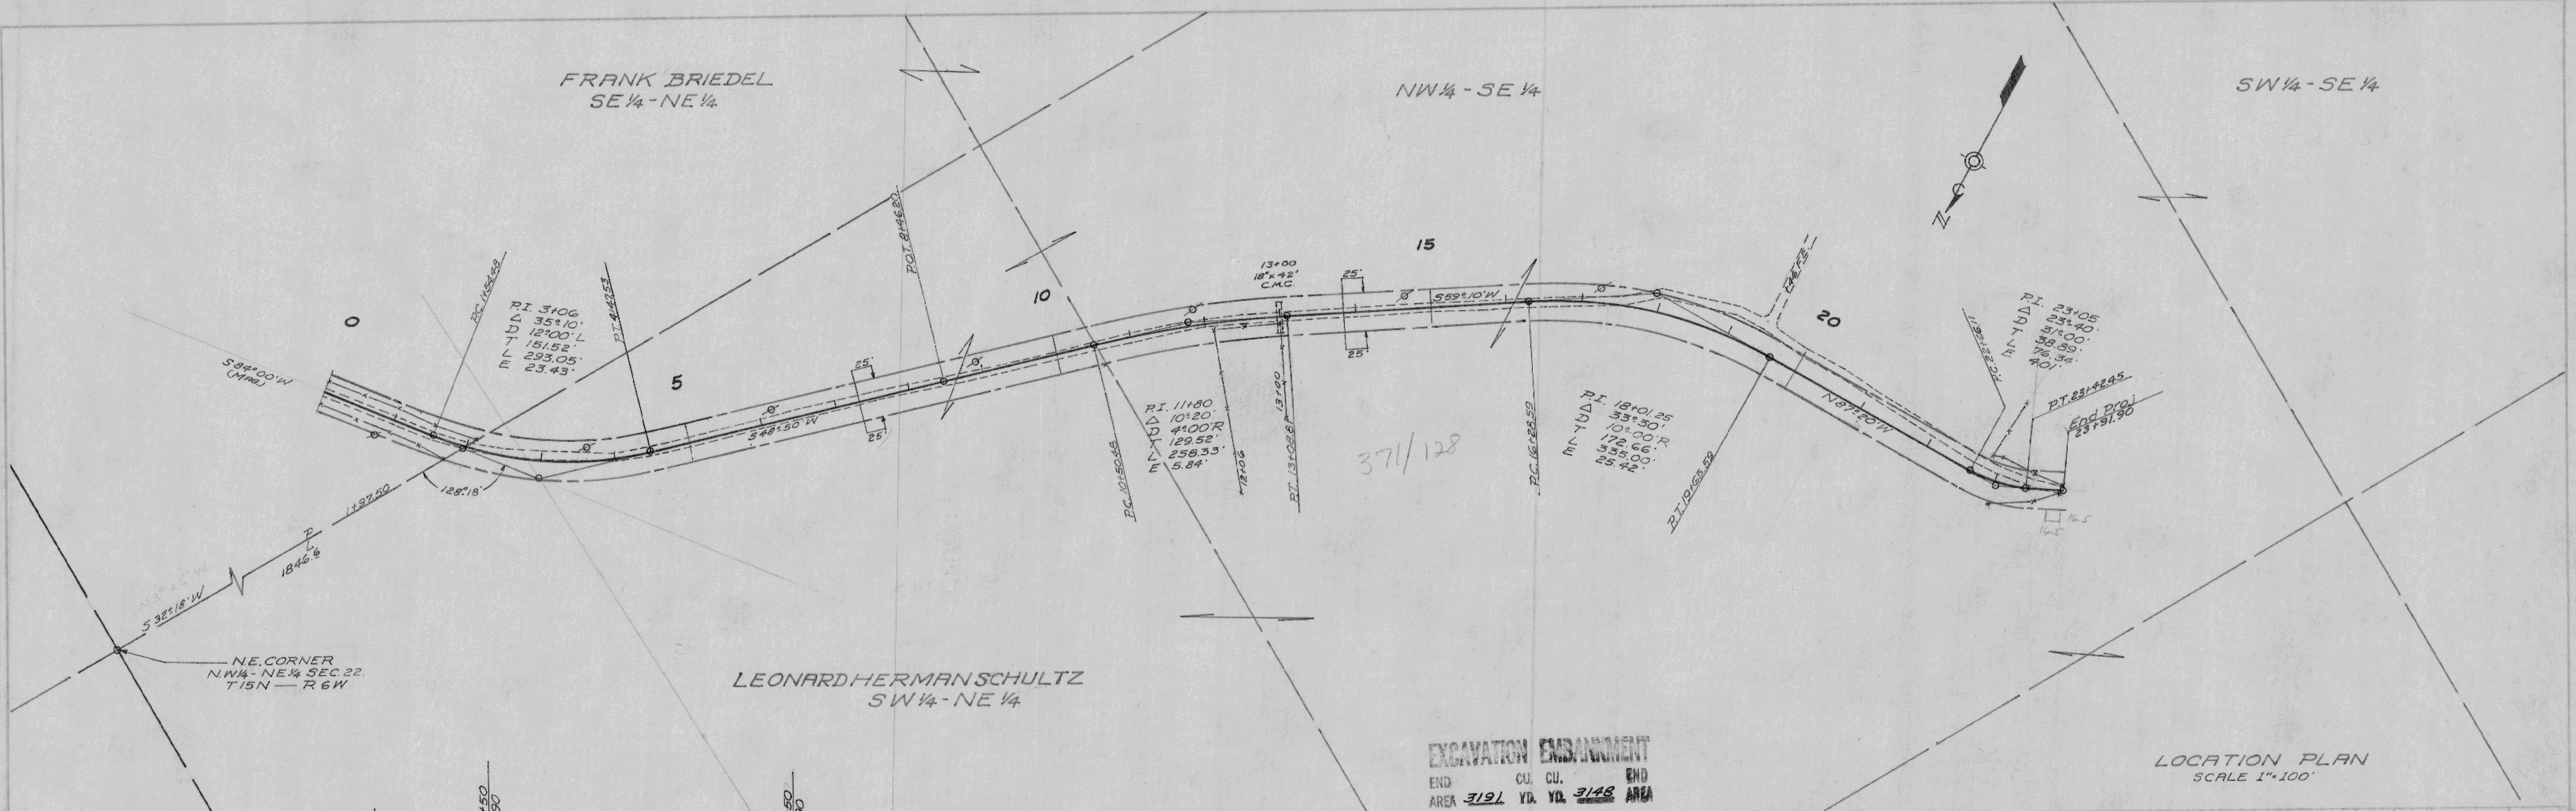

EXCAVATION EMBANKMENT
 END CU. CU. END
 AREA 319 YD. YD. 3148 AREA

LOCATION PLAN
 SCALE 1"=100'

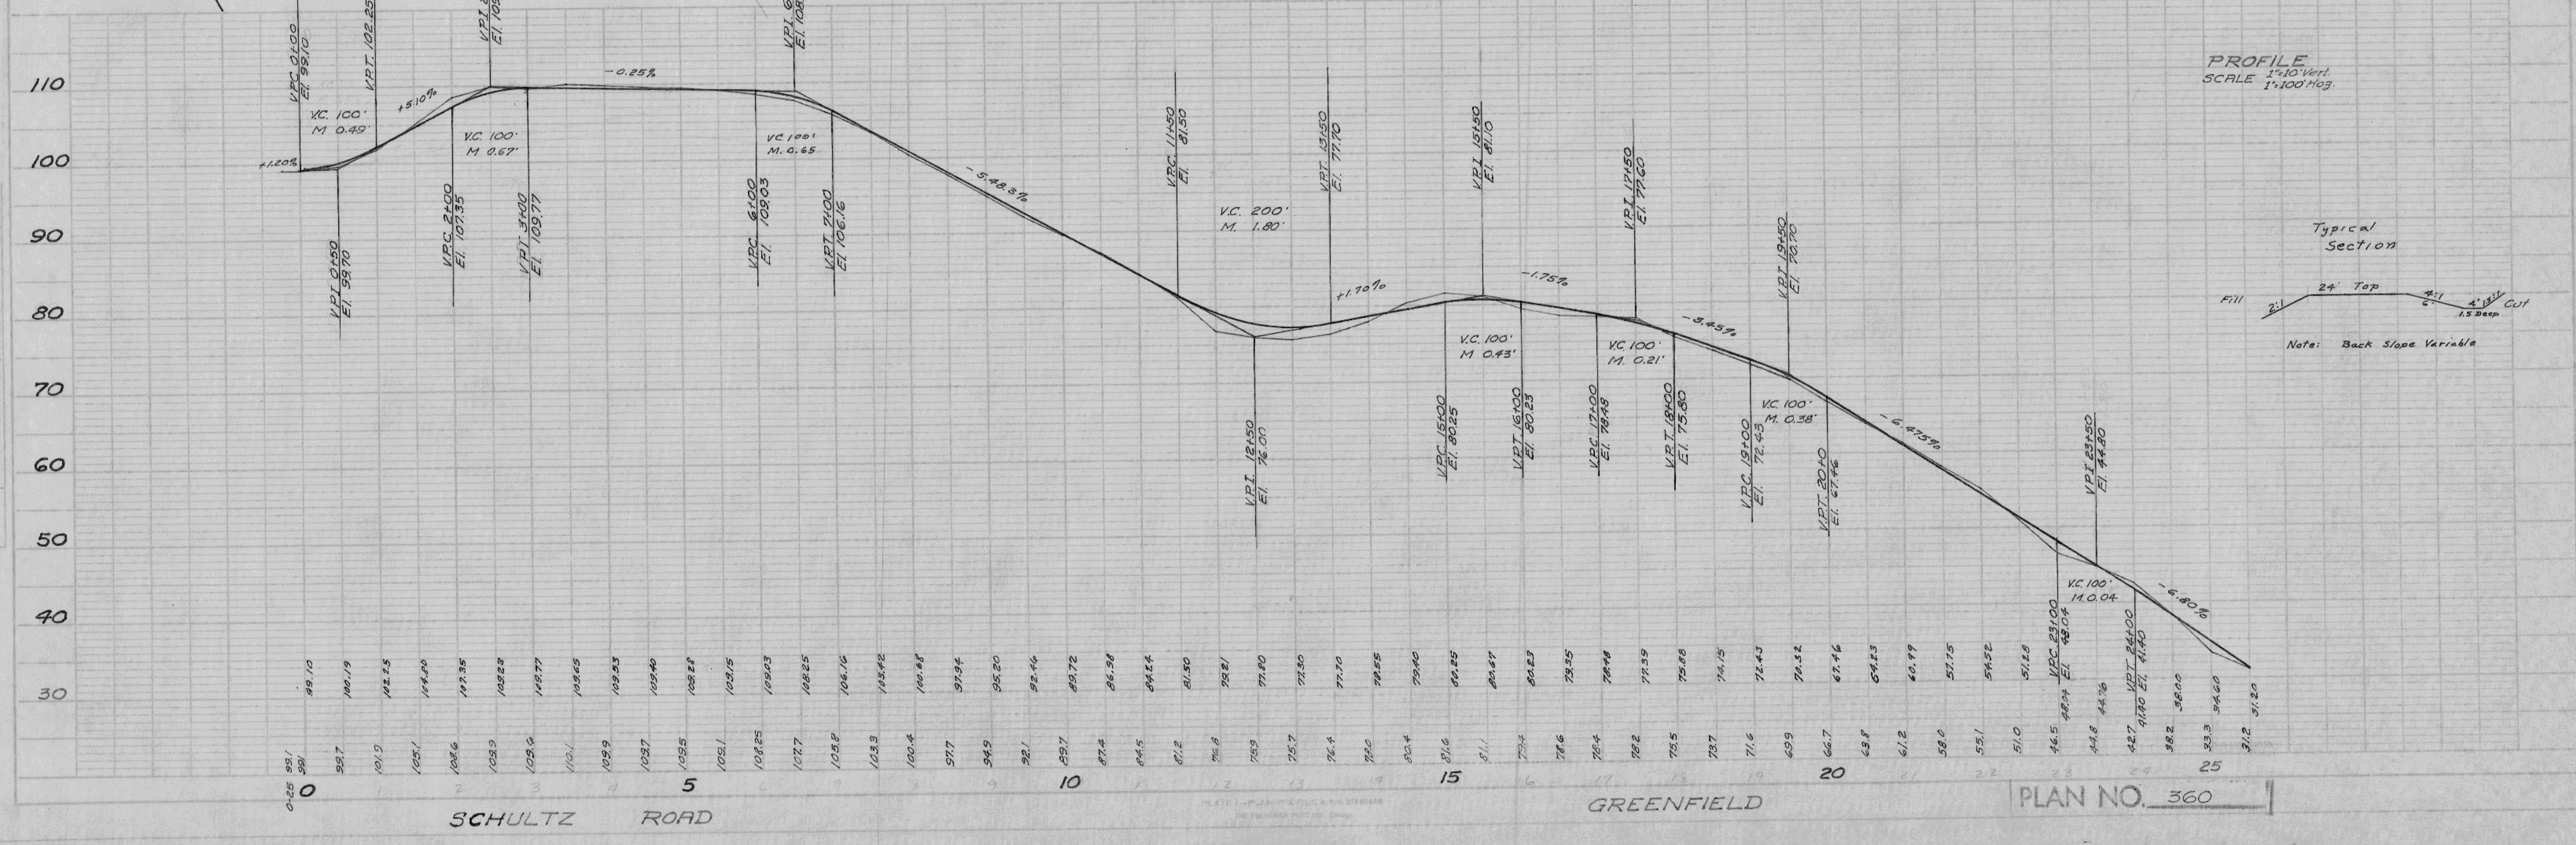

PROFILE
 SCALE 1"=100' Hor.

Typical Section
 24' Top
 2:1 Fill
 4:1 Cut
 1.5' Deep
 Note: Back Slope Variable

PLAN NO. 360