


GERALD A. & JEAN KAMMEL  
0.203 Ac.  
NW¼-SW¼  
SEC. 11, T15N, R6W

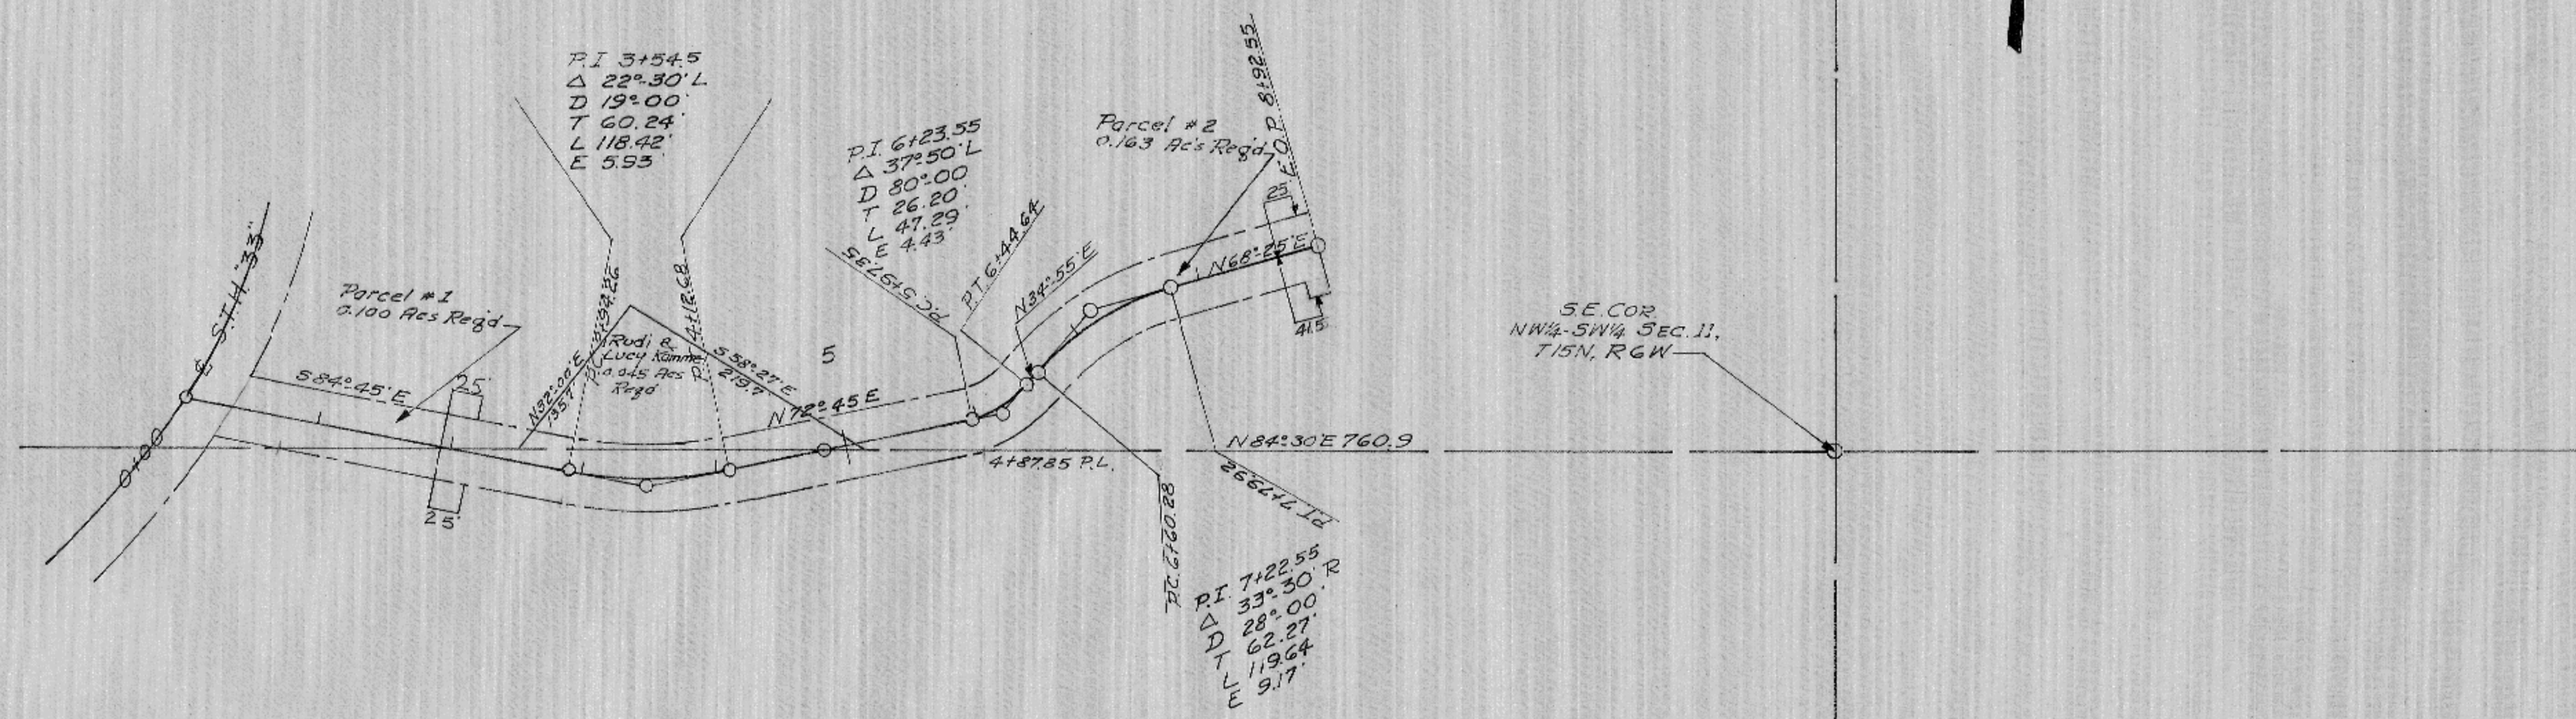

EDWARD W. & CHRISTIANA BAHR  
0.150 Ac.  
SW¼-SW¼  
SEC. 11, T15N, R6W

LOCATION PLAN  
Scale 1"=100'

KAMMEL & BAHR RD.

PLAN No. 393


PLAT  
BY  
DATE

PREPARED BY  
DATE




GERALD A. & JEAN KAMMEL  
 0.263 Ac.  
 NW 1/4 SW 1/4  
 SEC. 11, T. 15N, R. 6W

PLAN	DATE
SURVEYED	
PLOTTED	
CHECKED	
BY	
NOTE BOOK NO.	

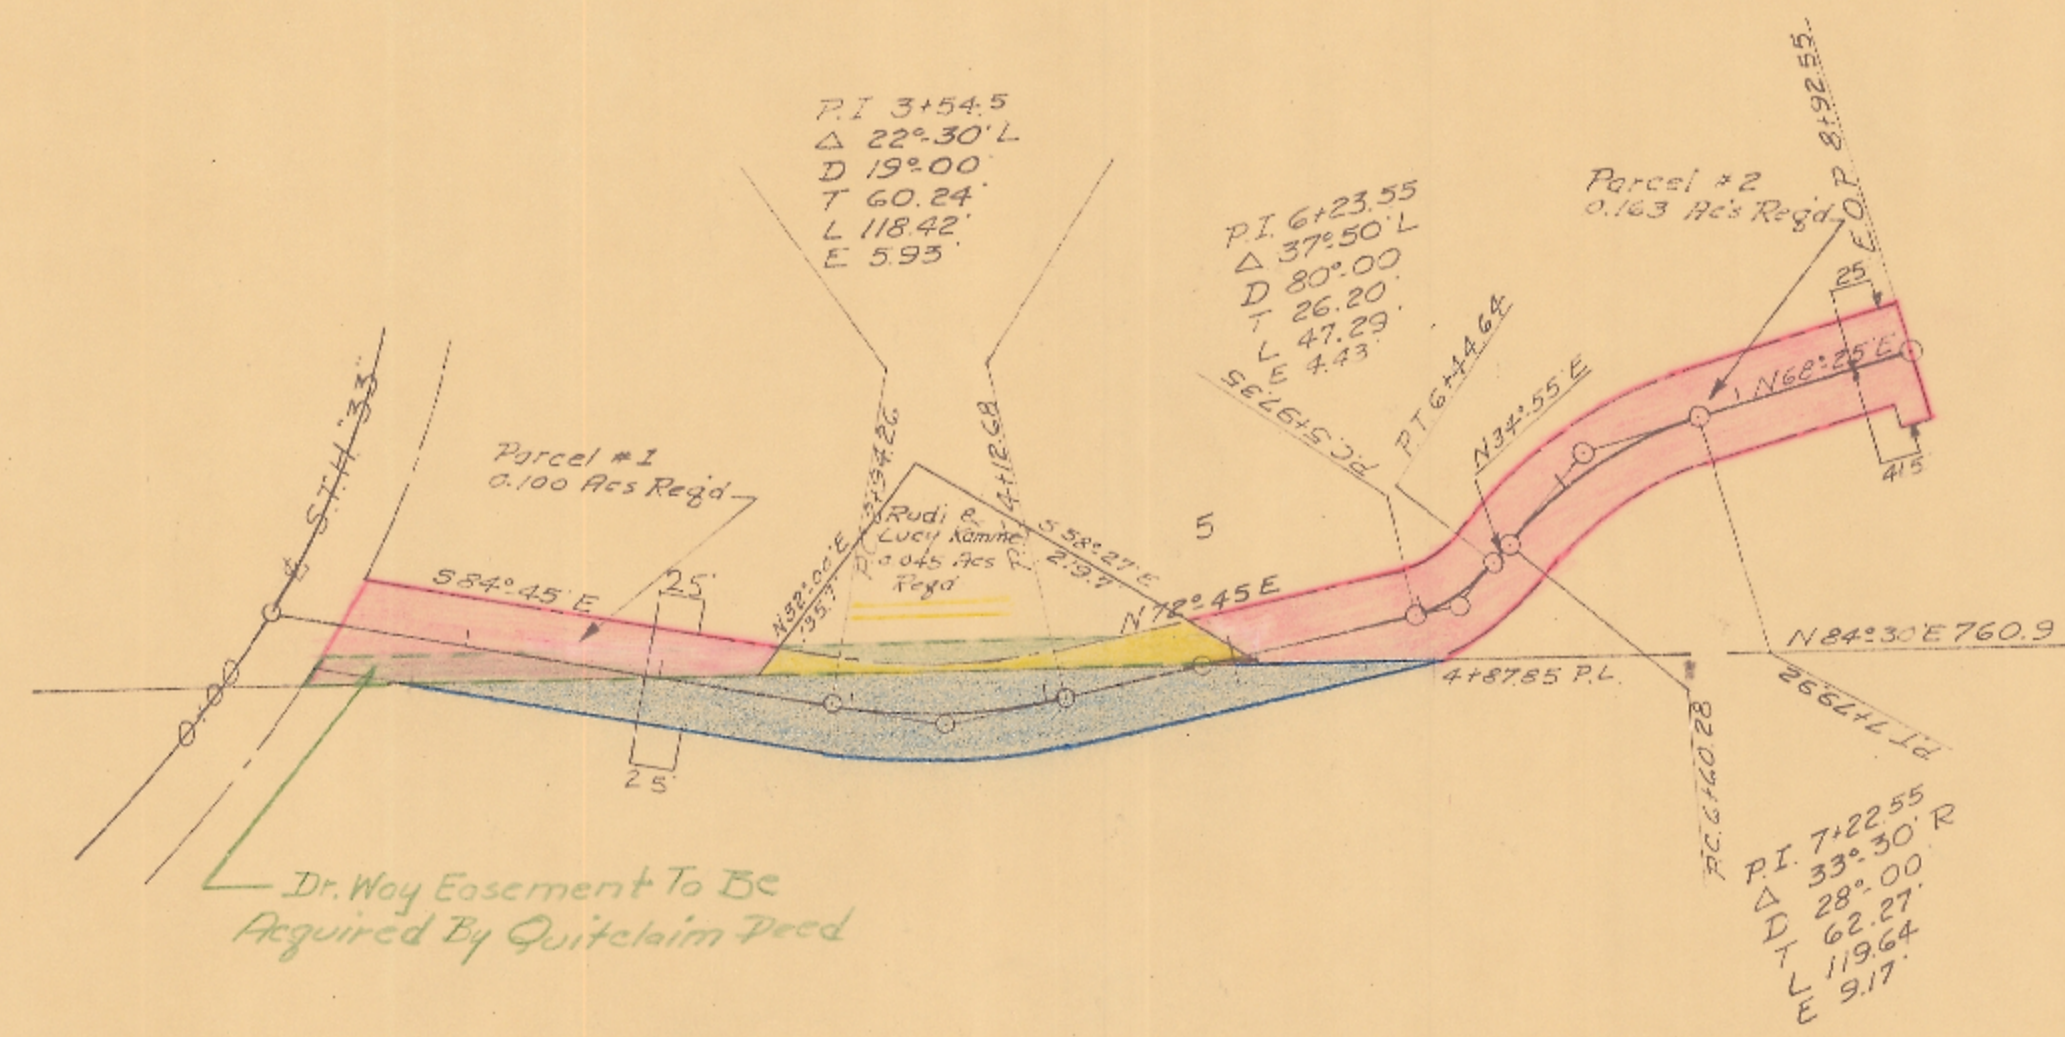

EDWARD W. & CHRISTIANA BAHR  
 0.190 Ac.  
 SW 1/4 SW 1/4  
 SEC. 11, T. 15N, R. 6W

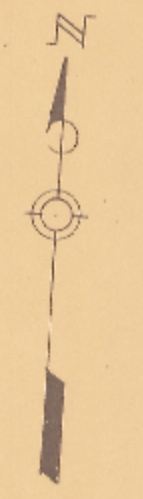

LOCATION PLAN  
 Scale 1" = 100'

PROFILE	DATE
SURVEYED	
PLOTTED	
CHECKED	
BY	
NOTE BOOK NO.	

PLATE 1—PLAN PROFILE B. P.A. STANDARD  
 THE FREDERICK POST CO., Chicago

# 393