



6-4-68
7-1-68
HGN
HGN & DHS
F-98

6-17-68
7-9-68
HGN
HGN & DHS
F-99


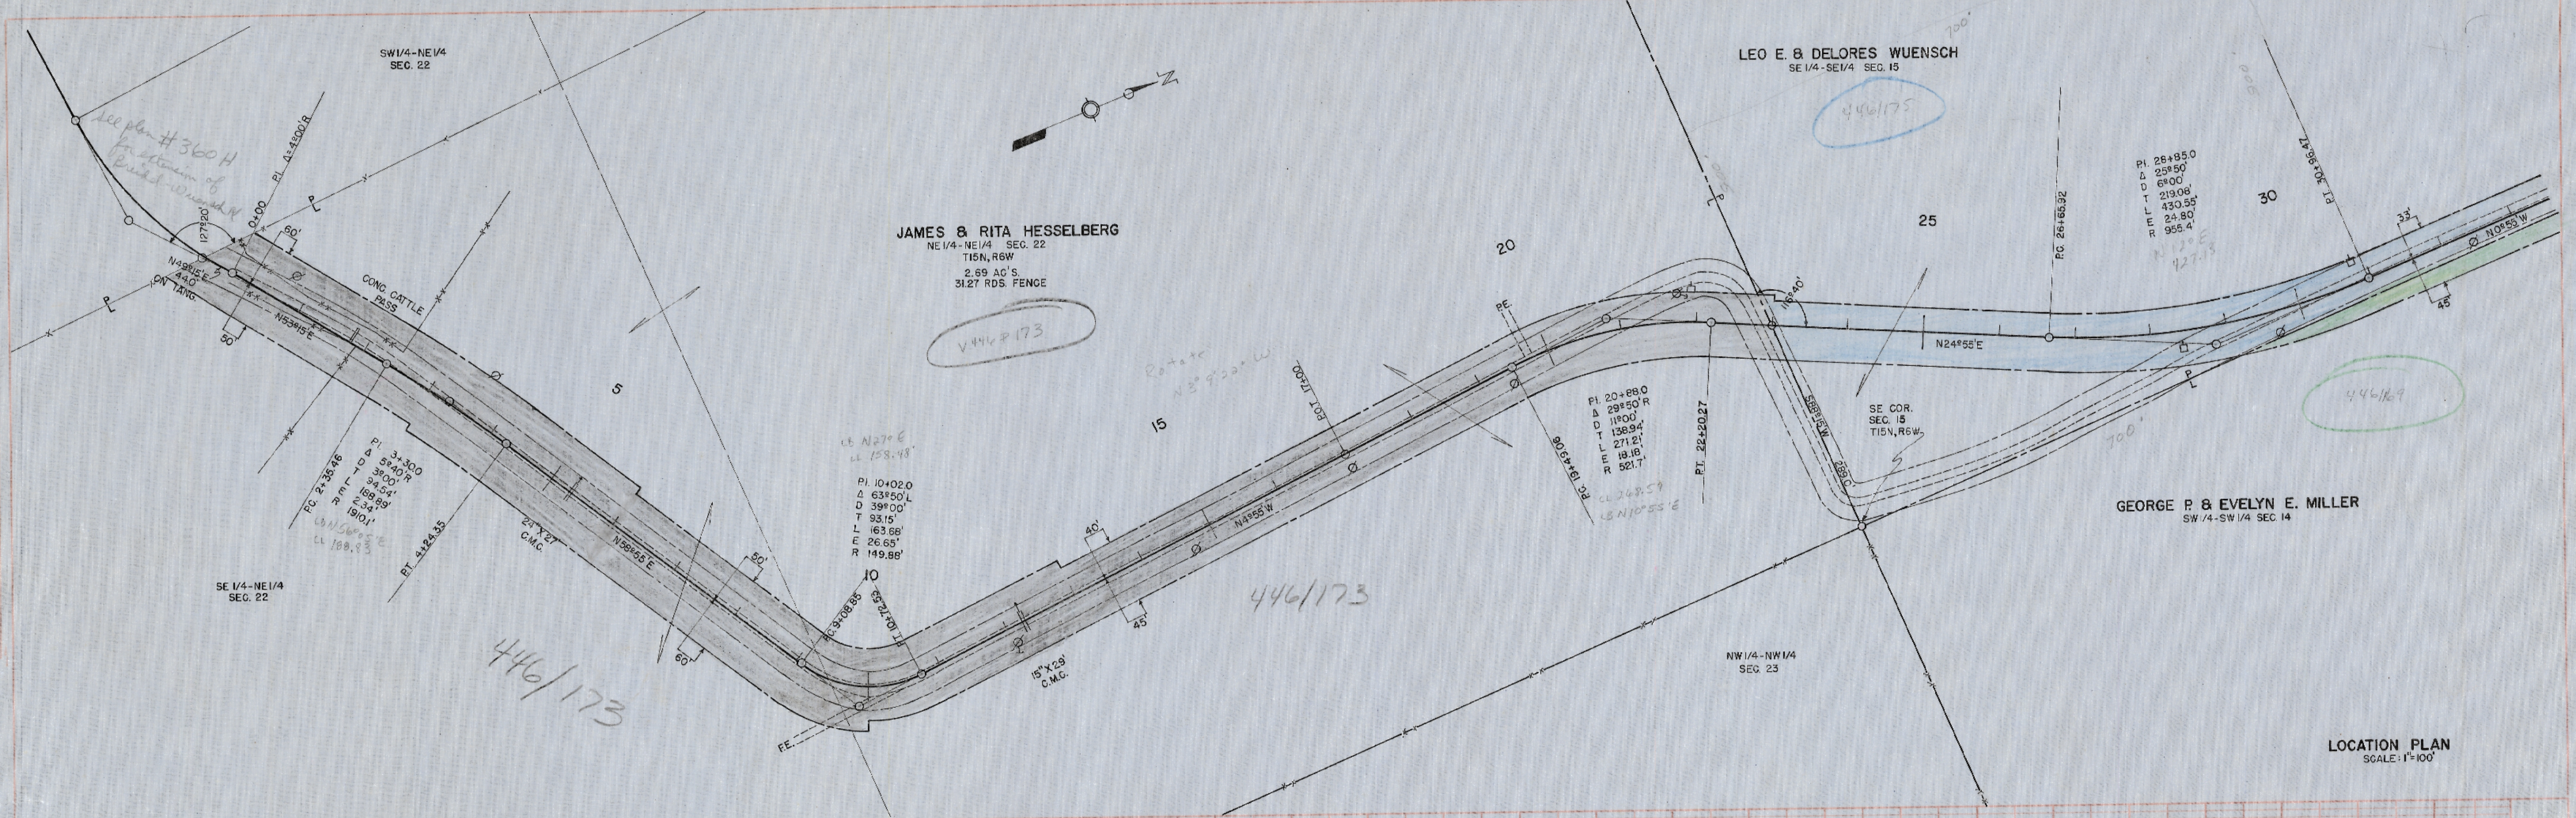


LOCATION PLAN
SCALE: 1"=100'

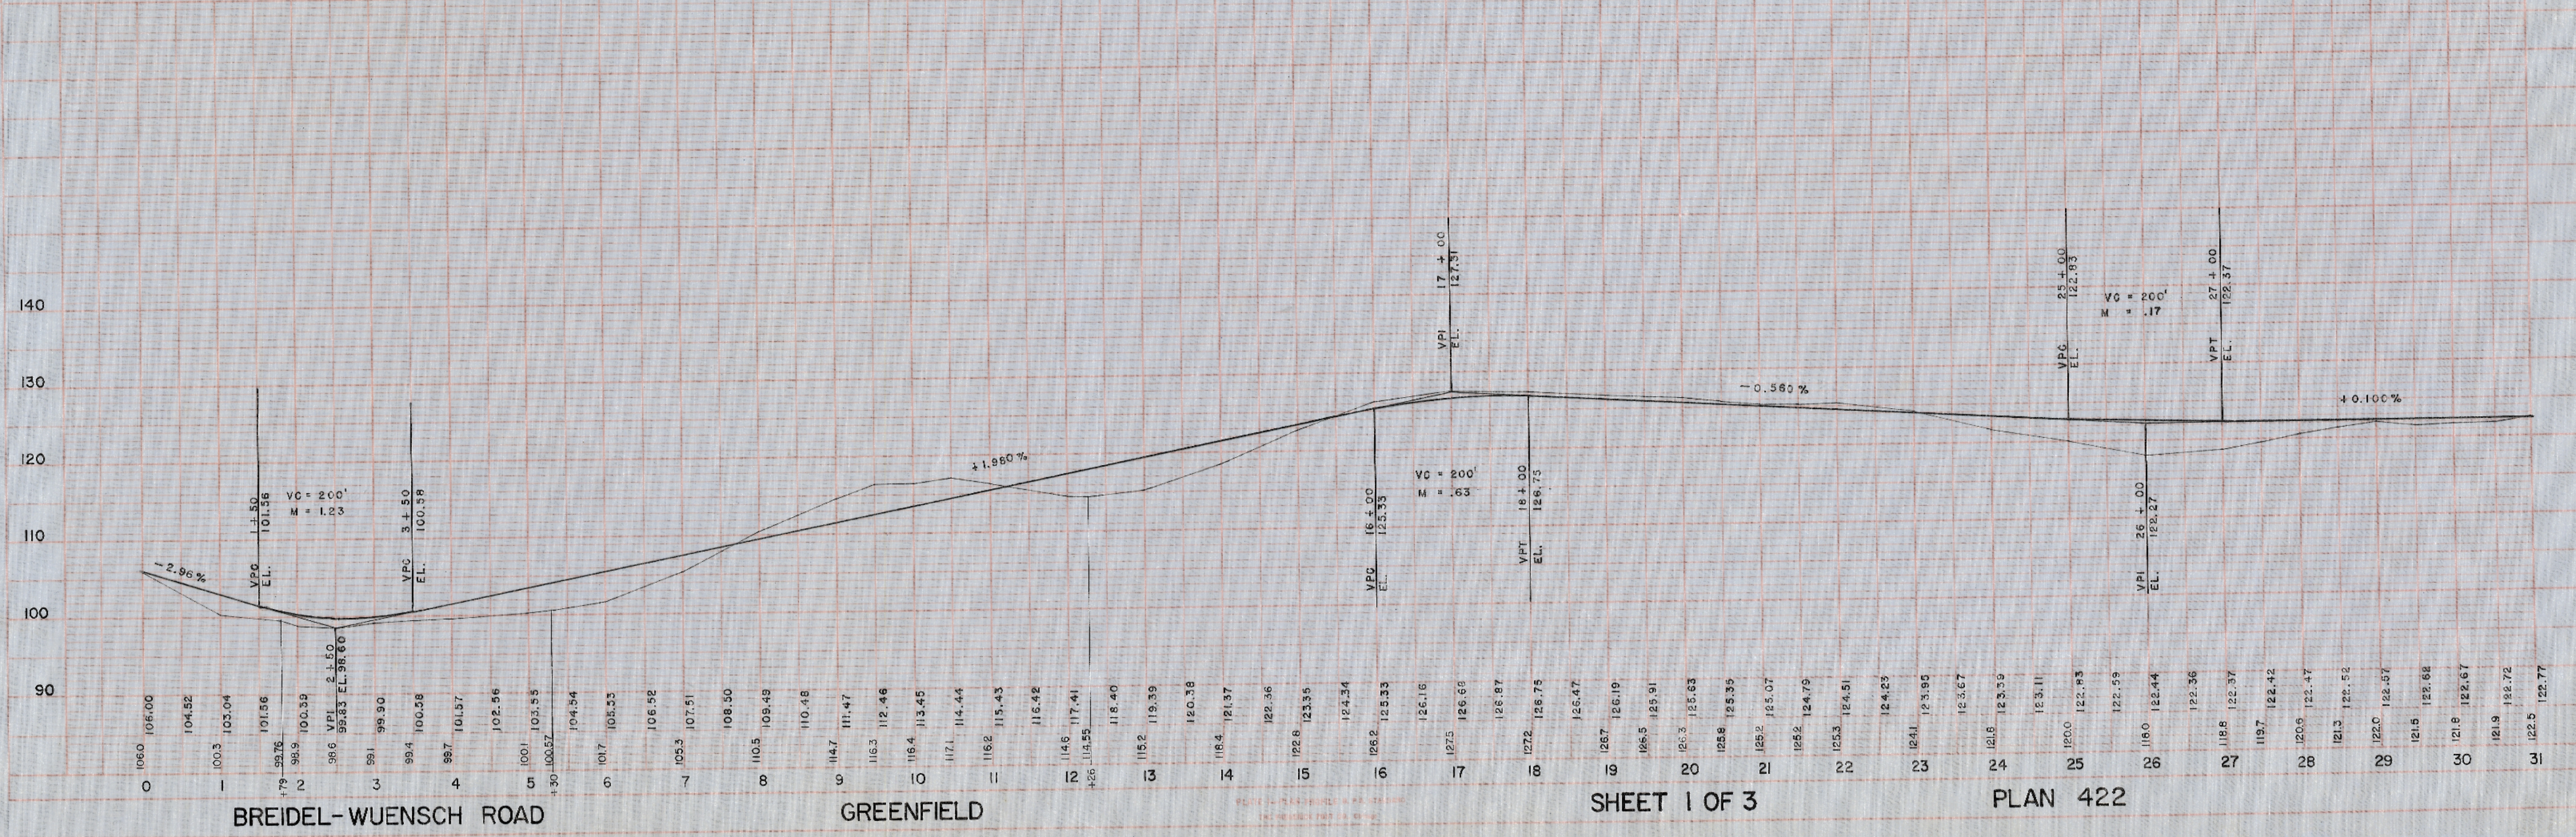

REVISIONS
 5-4-68
 7-1-68
 PLAN
 F-98

HGN
 HGN B. DHS
 6-17-68
 7-9-68
 PLAN
 F-99

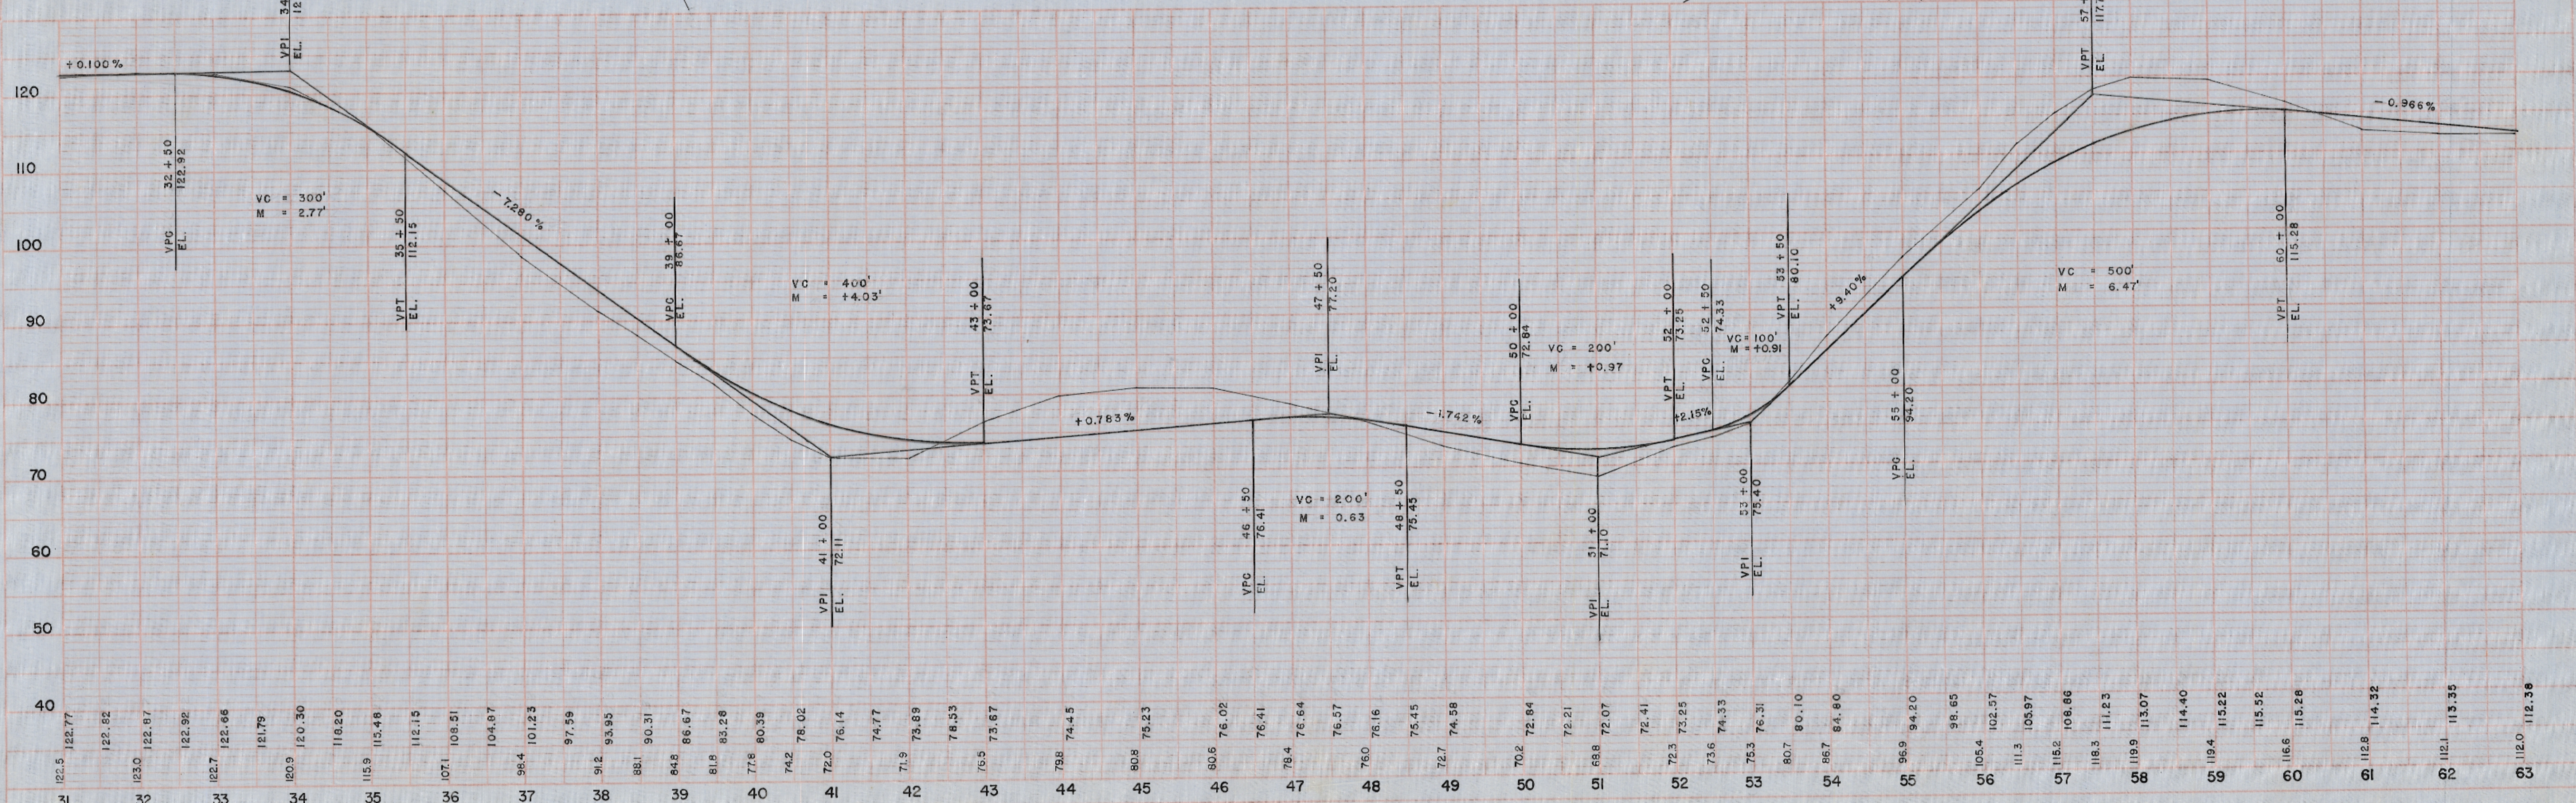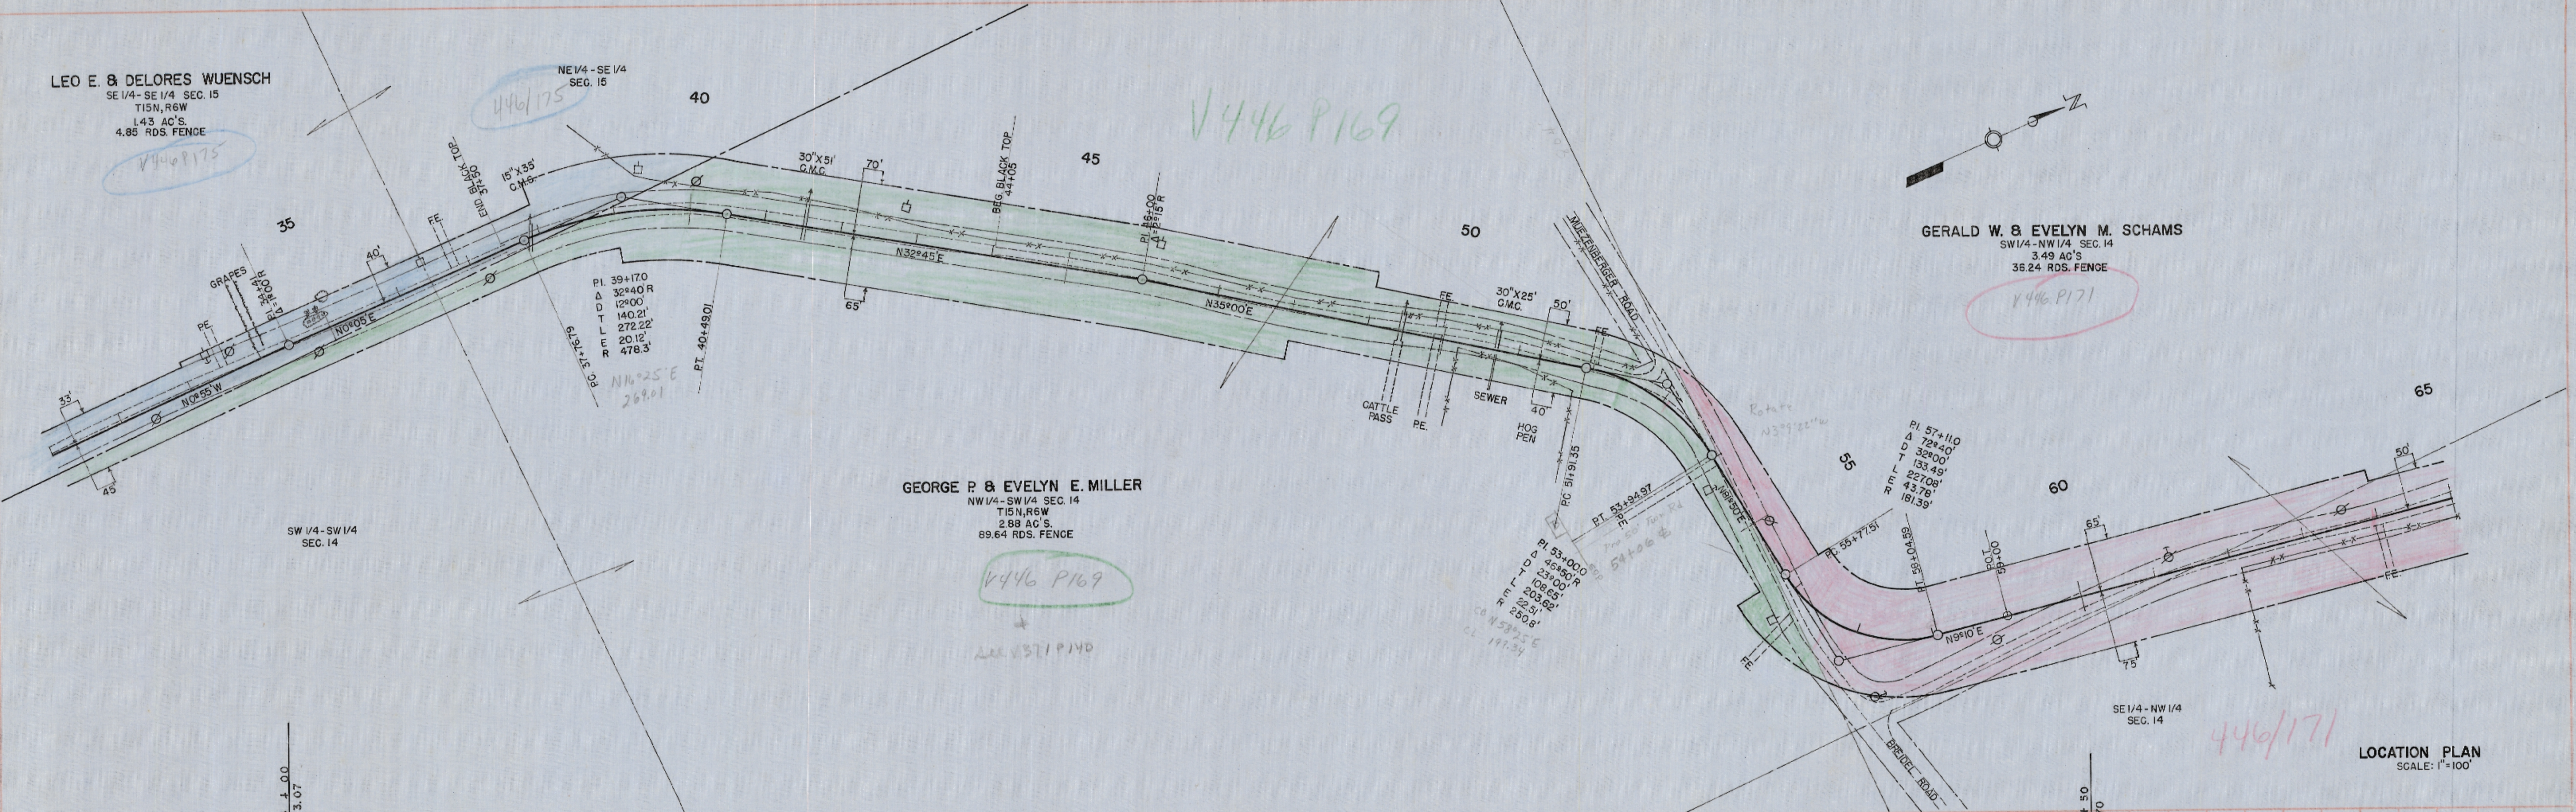

BREIDEL-WUENSCH ROAD

GREENFIELD

SHEET 2 OF 3

PLAN 422

