
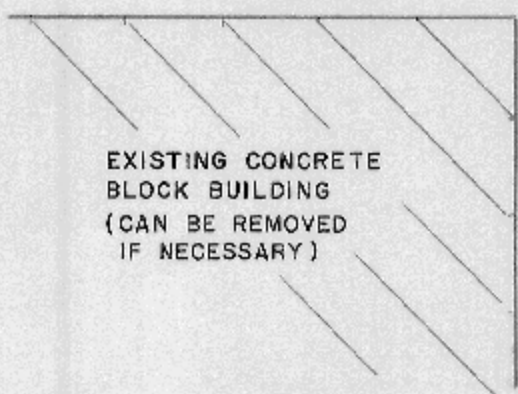




1" = 6'

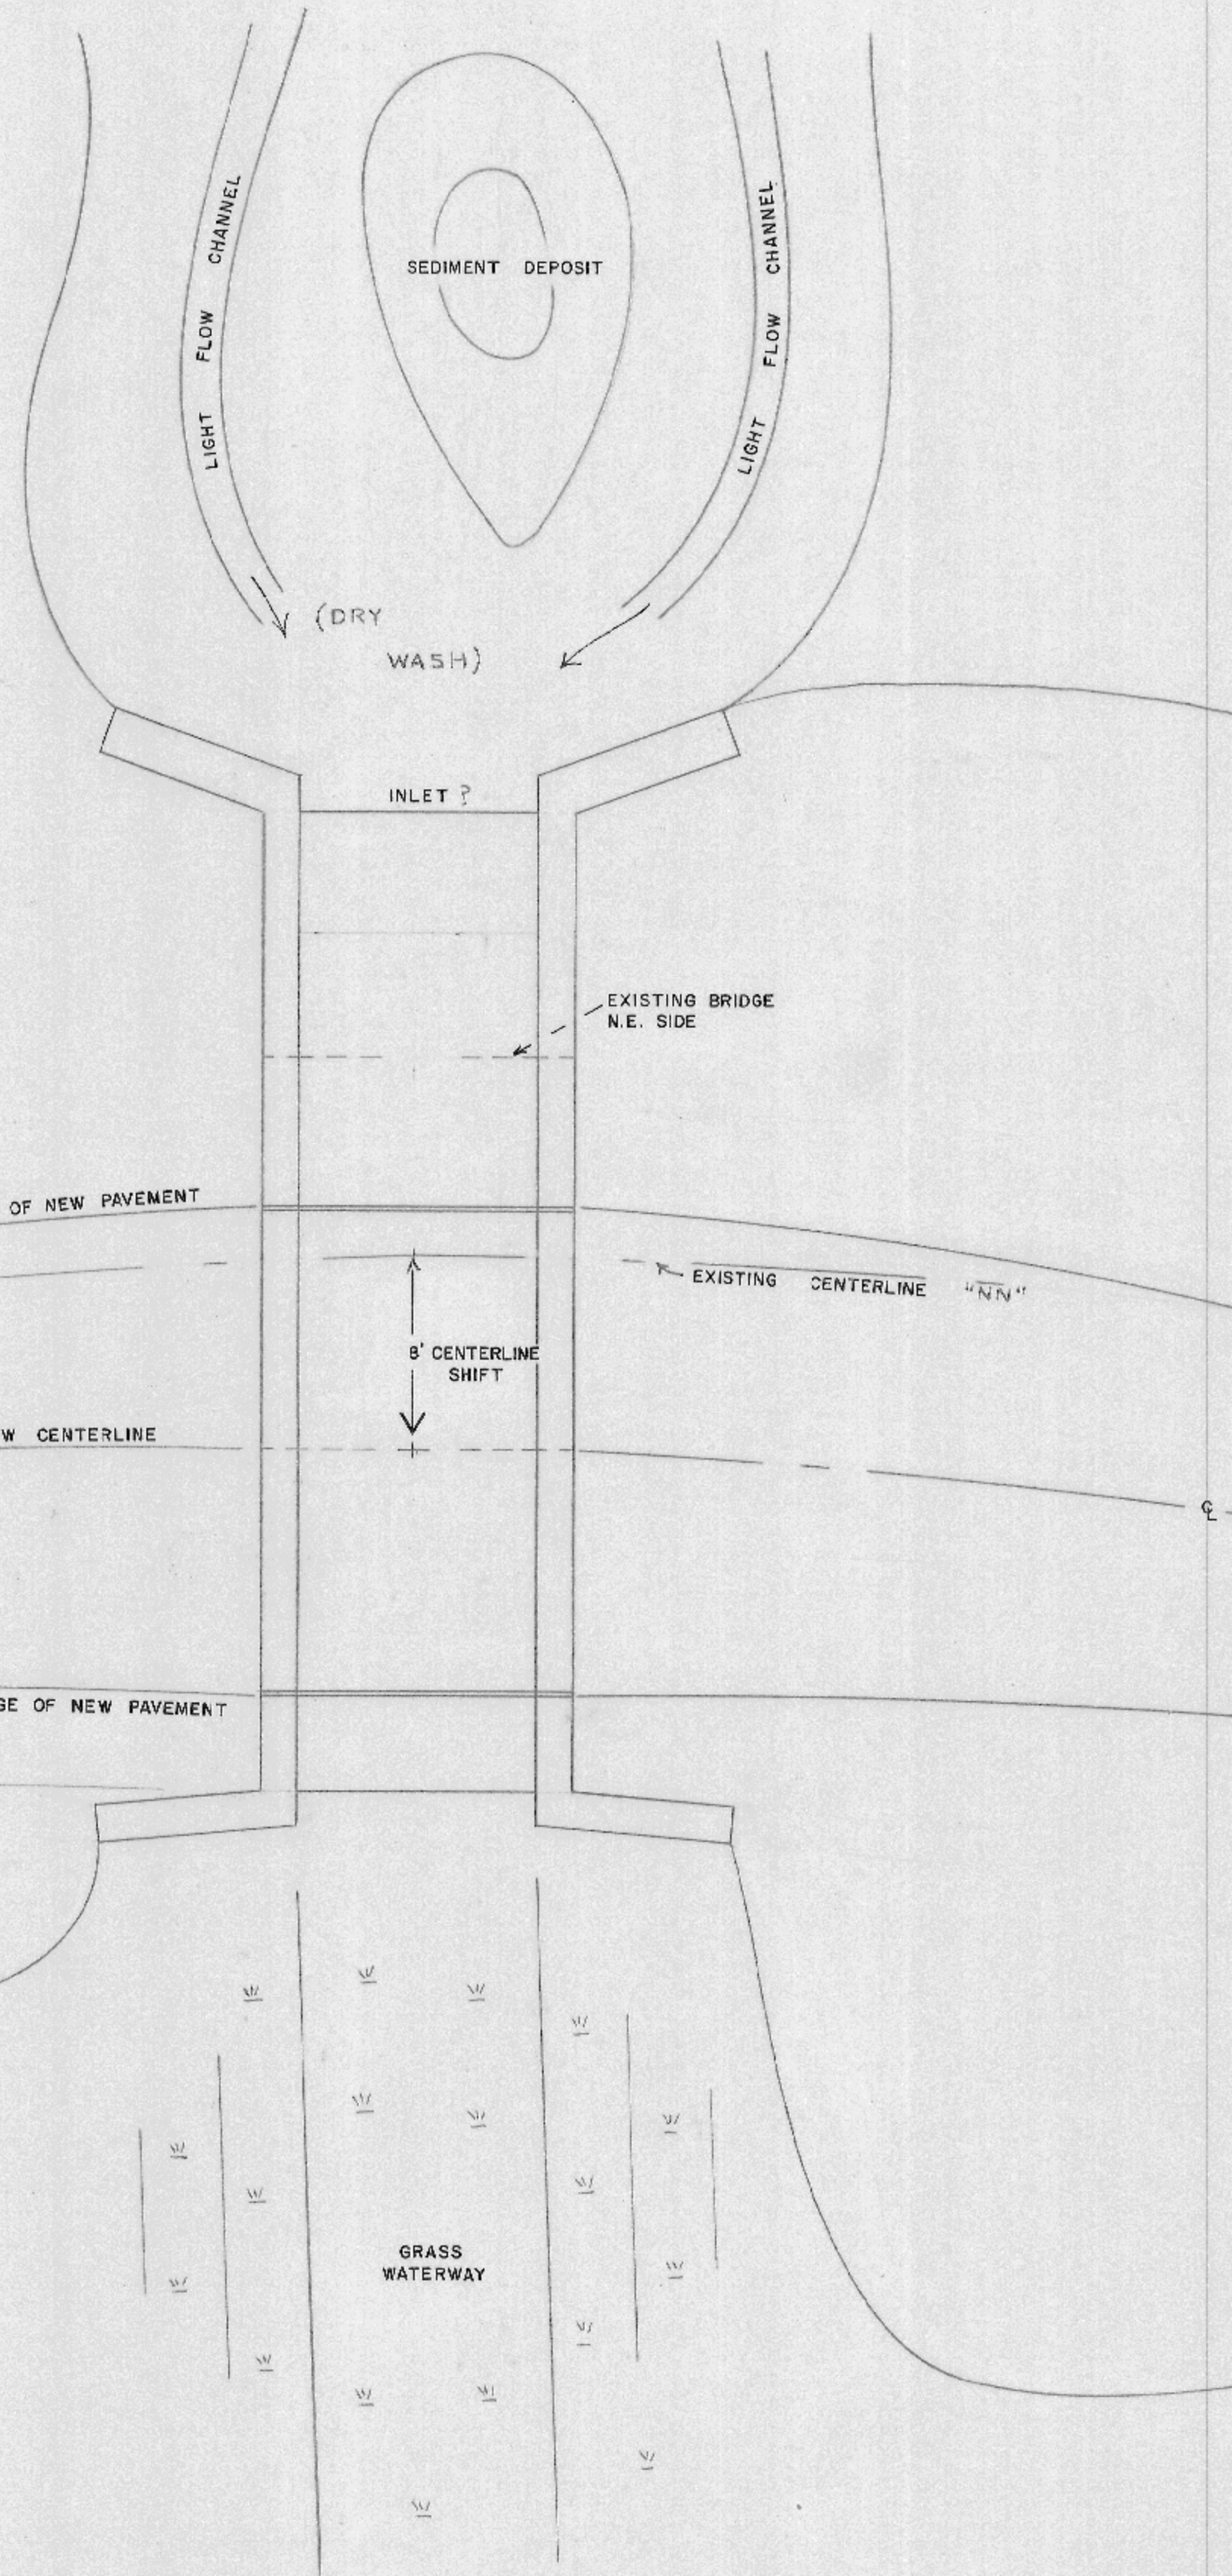

BRIDGE No. 86

(EXISTING 8/02/95)

1" = 3'

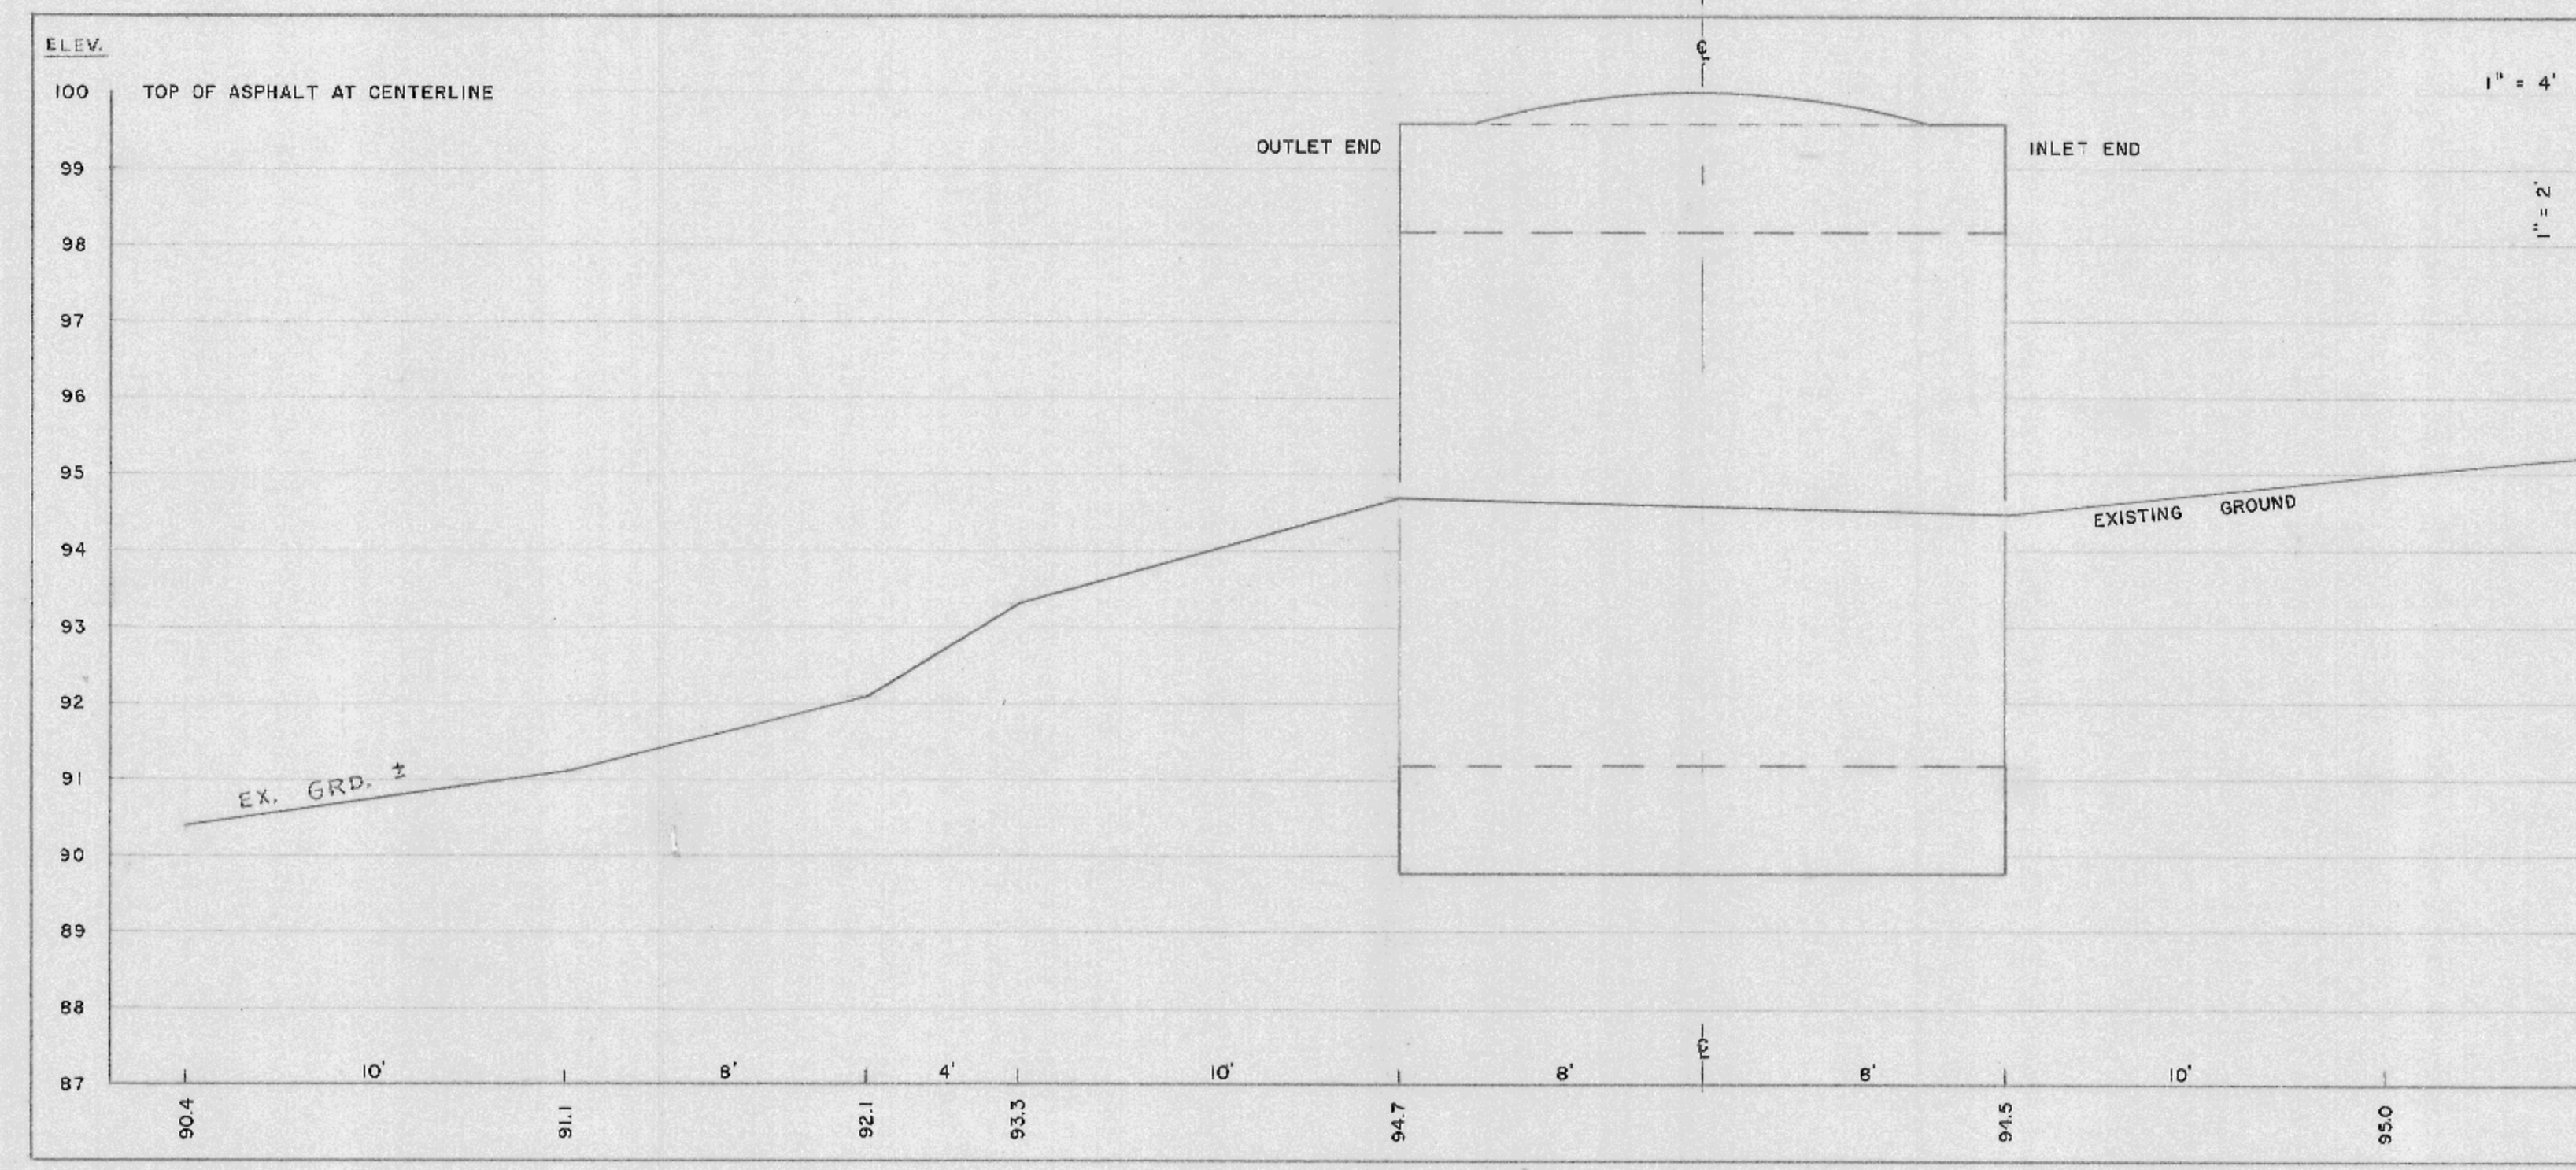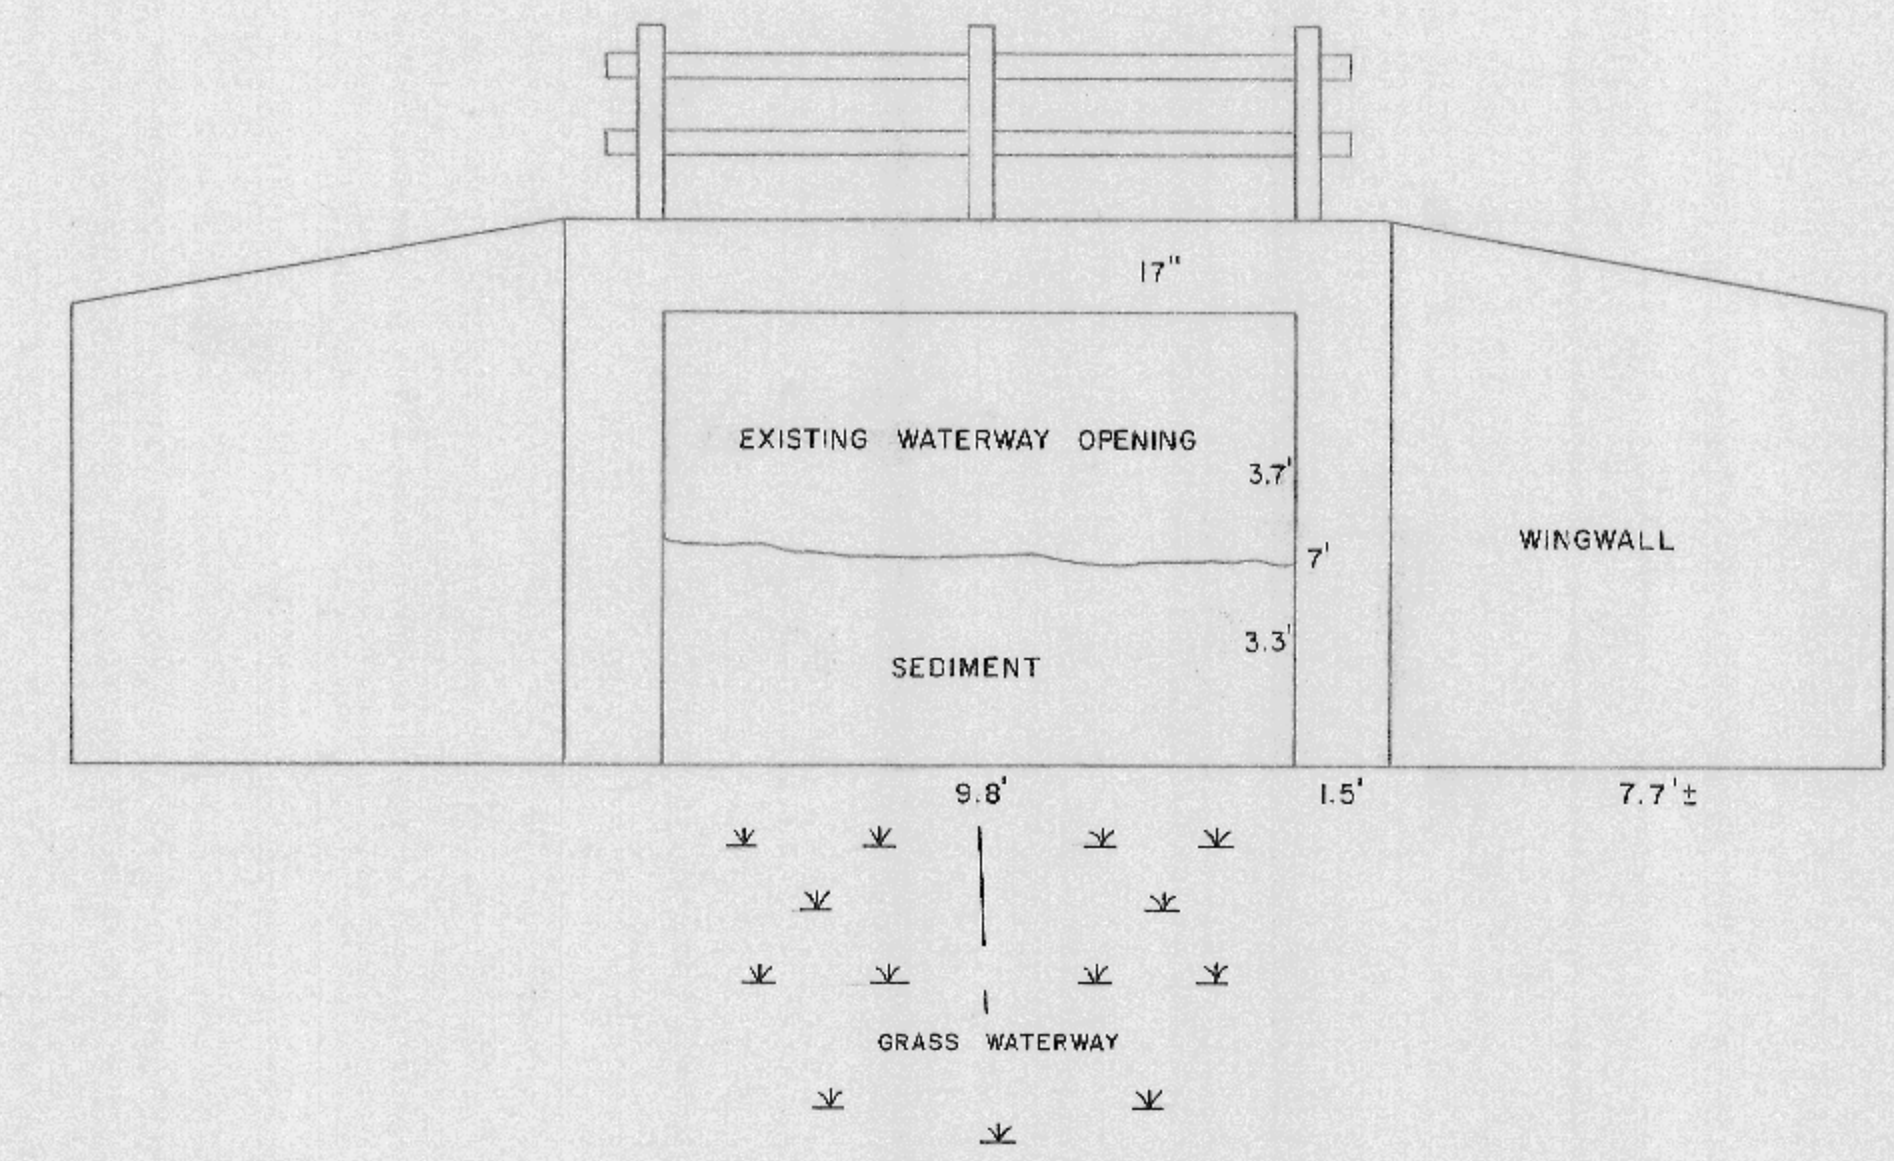


BRIDGE No. 86

LACROSSE COUNTY HIGHWAY DEPARTMENT

ROLAND GULLICKSON HIGHWAY COMMISSIONER

ROAD: COUNTY ROAD NN	TOWN: GREENFIELD
SURVEYED BY: COUNTY SURVEYORS OFFICE	DATE: 8/02/95
FIELD BOOK	
LEVEL BOOK	
DRAWN BY: P.F. FOLLANSBEE	DATE
SCALE	
CHECKED BY	DATE
APPROVED BY: W.C. JUNG, COUNTY SURVEYOR	DATE 8/23/95

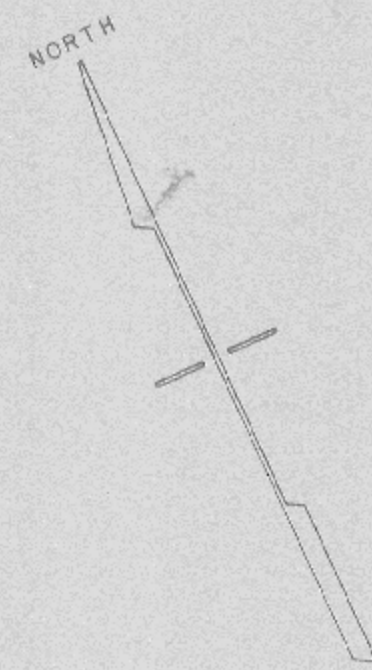

1" = 6'





EXISTING CONCRETE BLOCK BUILDING (CAN BE REMOVED IF NECESSARY)

BRIDGE No. 86

(EXISTING 8/02/95)

1" = 3'

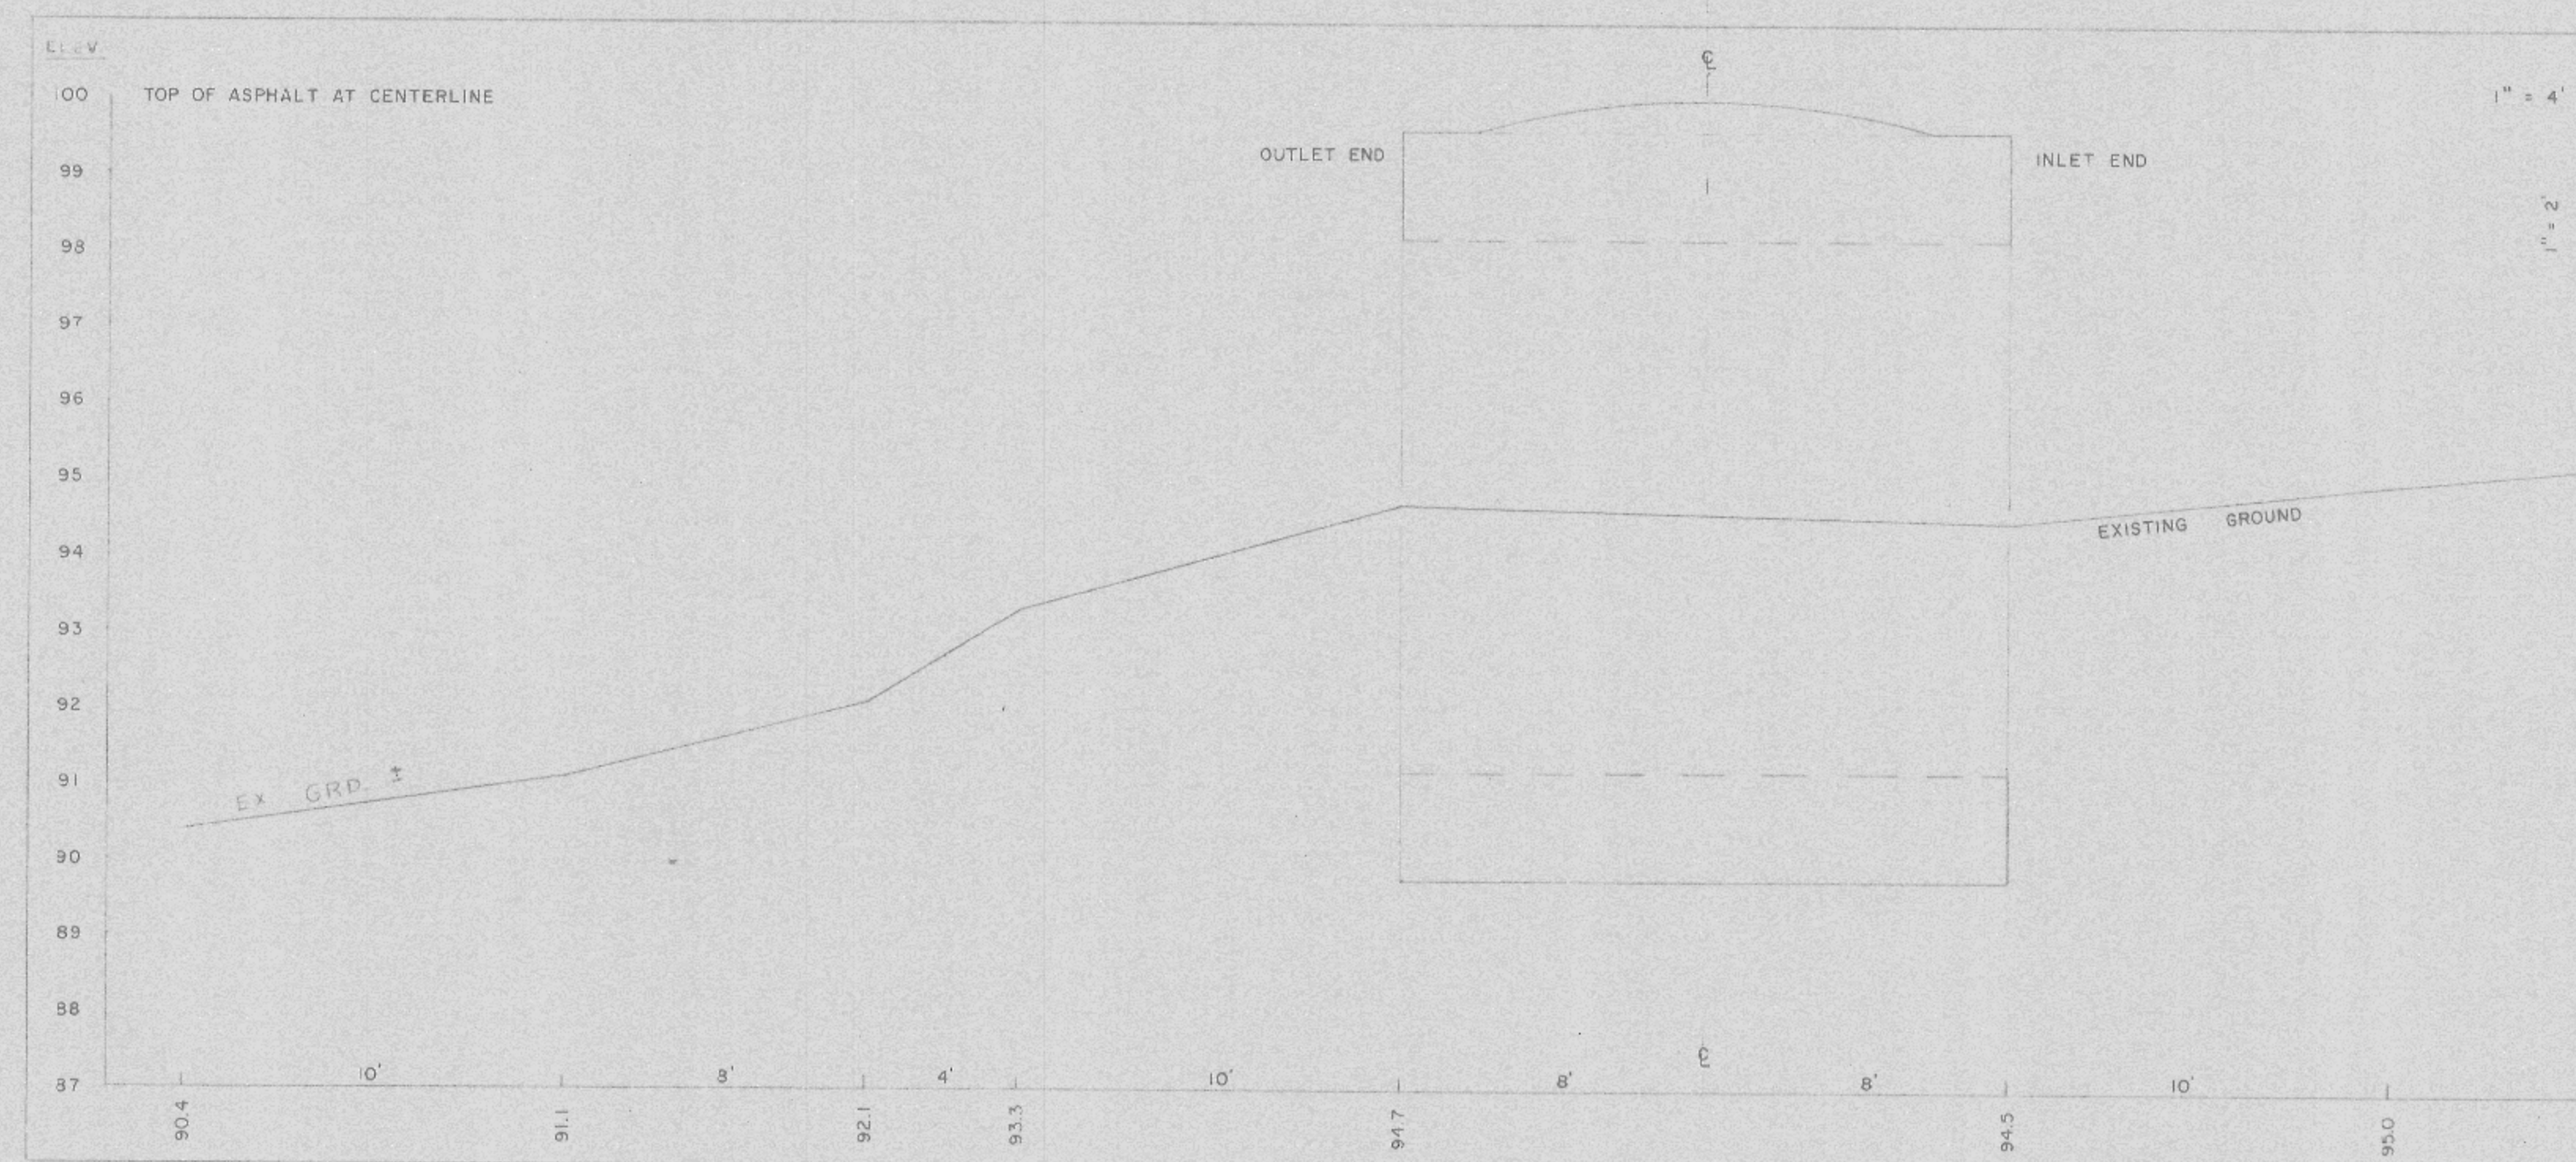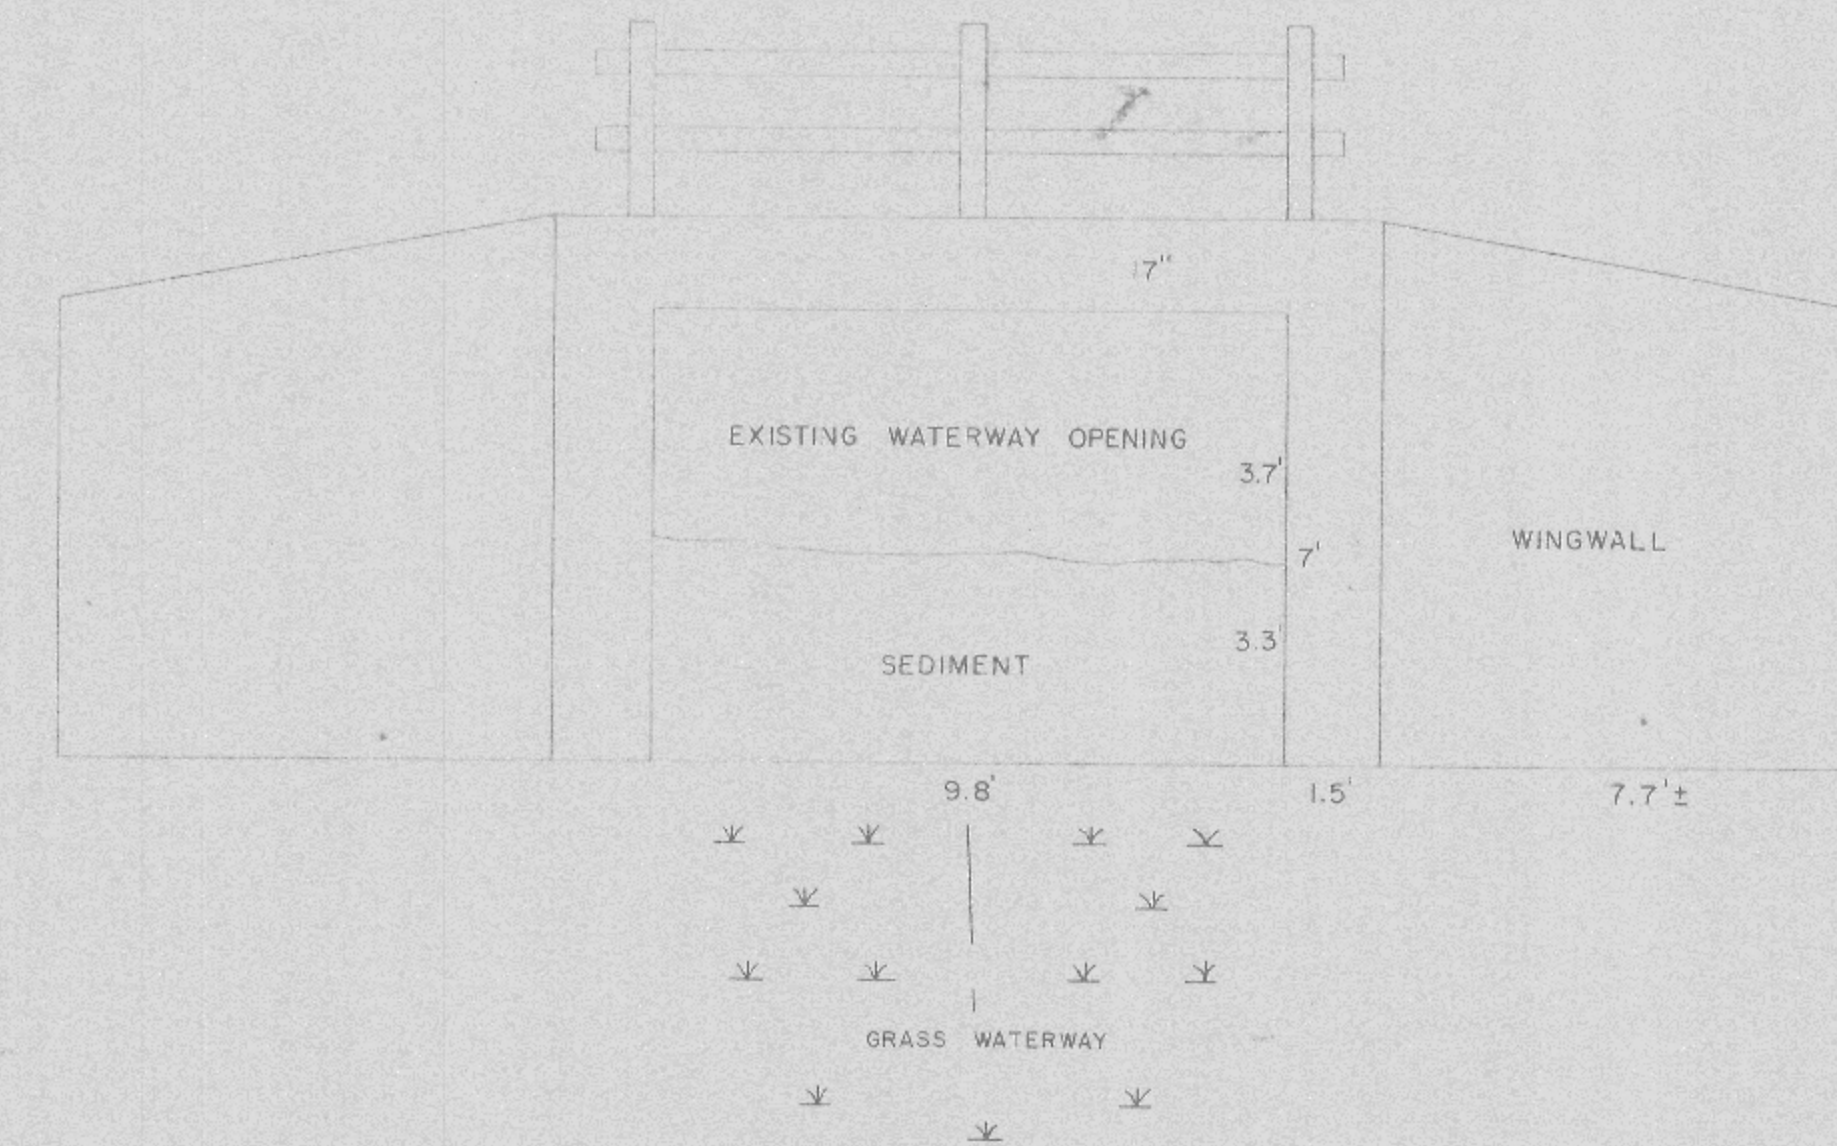

BRIDGE No. 86

LACROSSE COUNTY HIGHWAY DEPARTMENT
ROLAND GULLICKSON HIGHWAY COMMISSIONER

ROAD: COUNTY ROAD NN	TOWN: GREENFIELD
SURVEYED BY: COUNTY SURVEYORS OFFICE	DATE: 8/02/95
FIELD BOOK	
LEVEL BOOK	
DRAWN BY: P.F. FOLLANSBEE	DATE:
SCALE	
CHECKED BY:	DATE:
APPROVED BY: W.C. JUNG, COUNTY SURVEYOR	DATE: 8/23/95