



NOTE: ALL MEASUREMENTS FOR SIGNS ARE FROM FACE OF CURB

TOWN OF SHELBY BIKE TRAIL SHEET 1 OF 2 PLAN 477

SURVEYED R.E.B. 4-2-74  
 DRAWN P.W.J. 4-11-74 SCALE 1"=40'

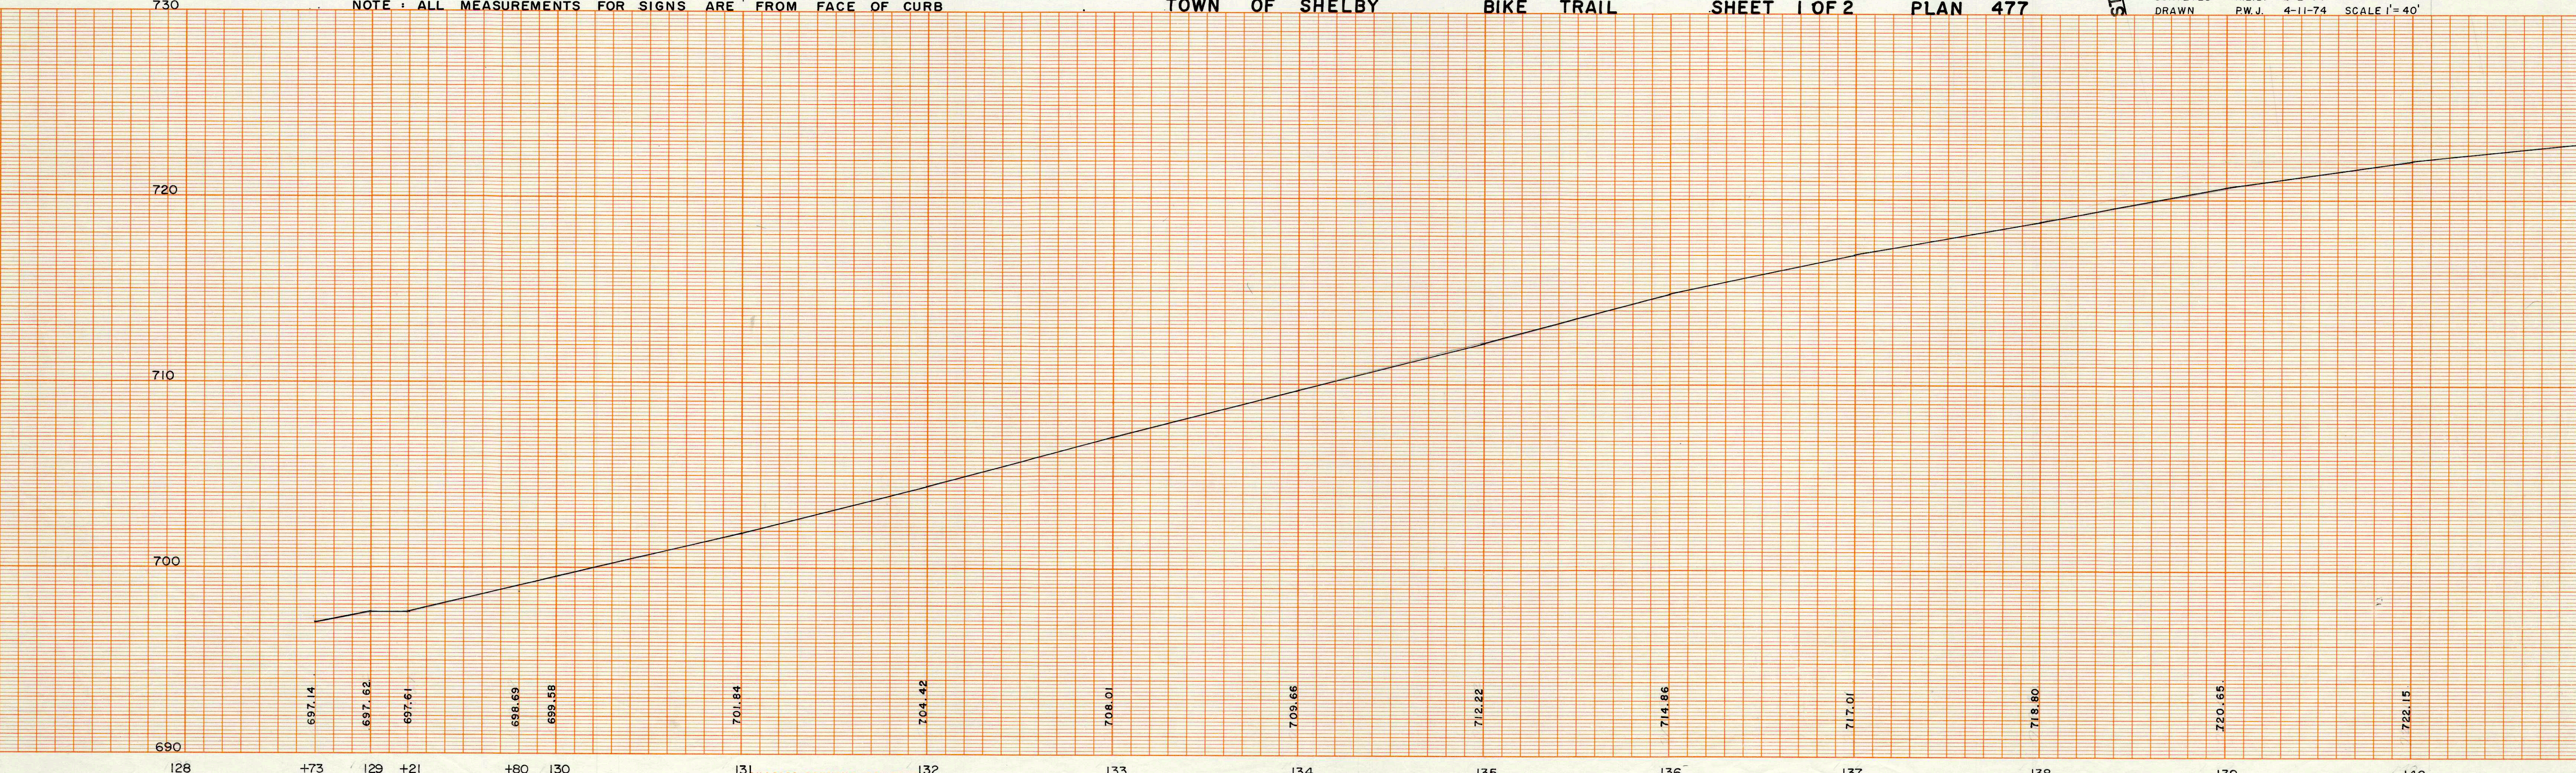

# 477-01

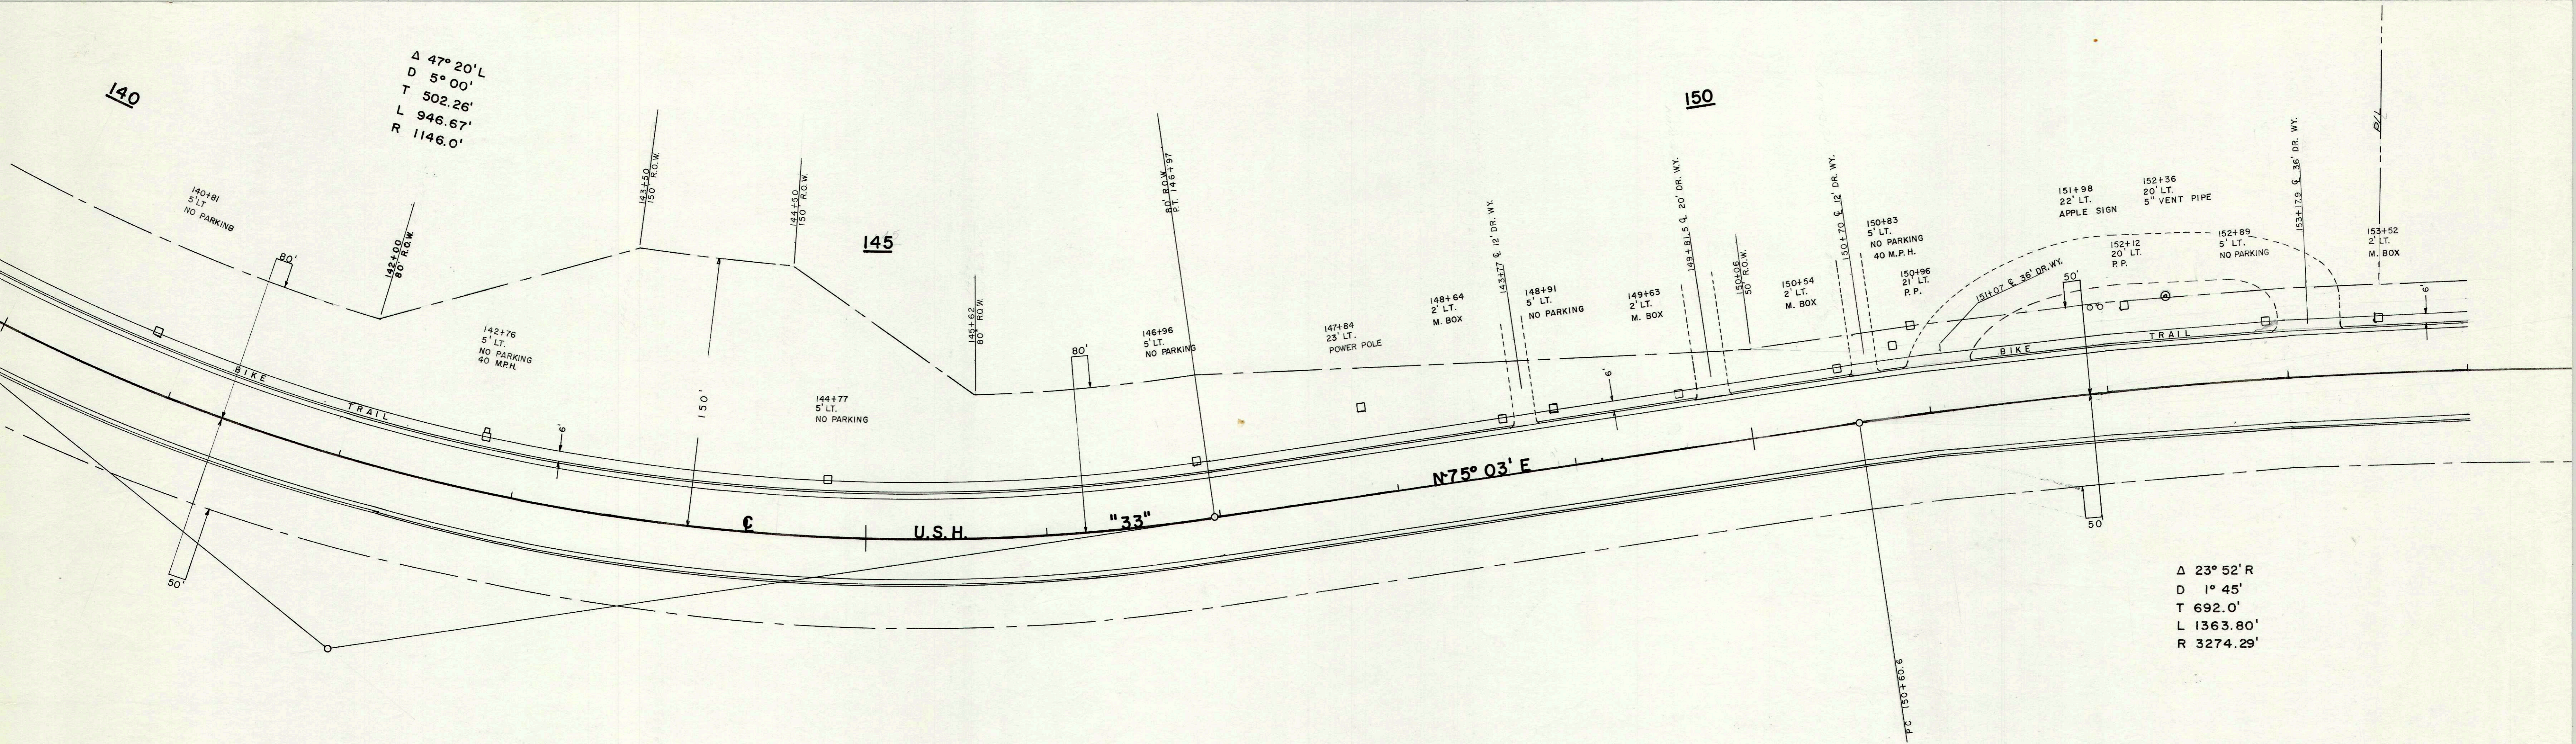

NOTE: ALL MEASUREMENTS FOR SIGNS ARE FROM FACE OF CURB


TOWN OF SHELBY

BIKE TRAIL

SHEET 2 OF 2

SCALE 1"=40'

PLAN NO. 477

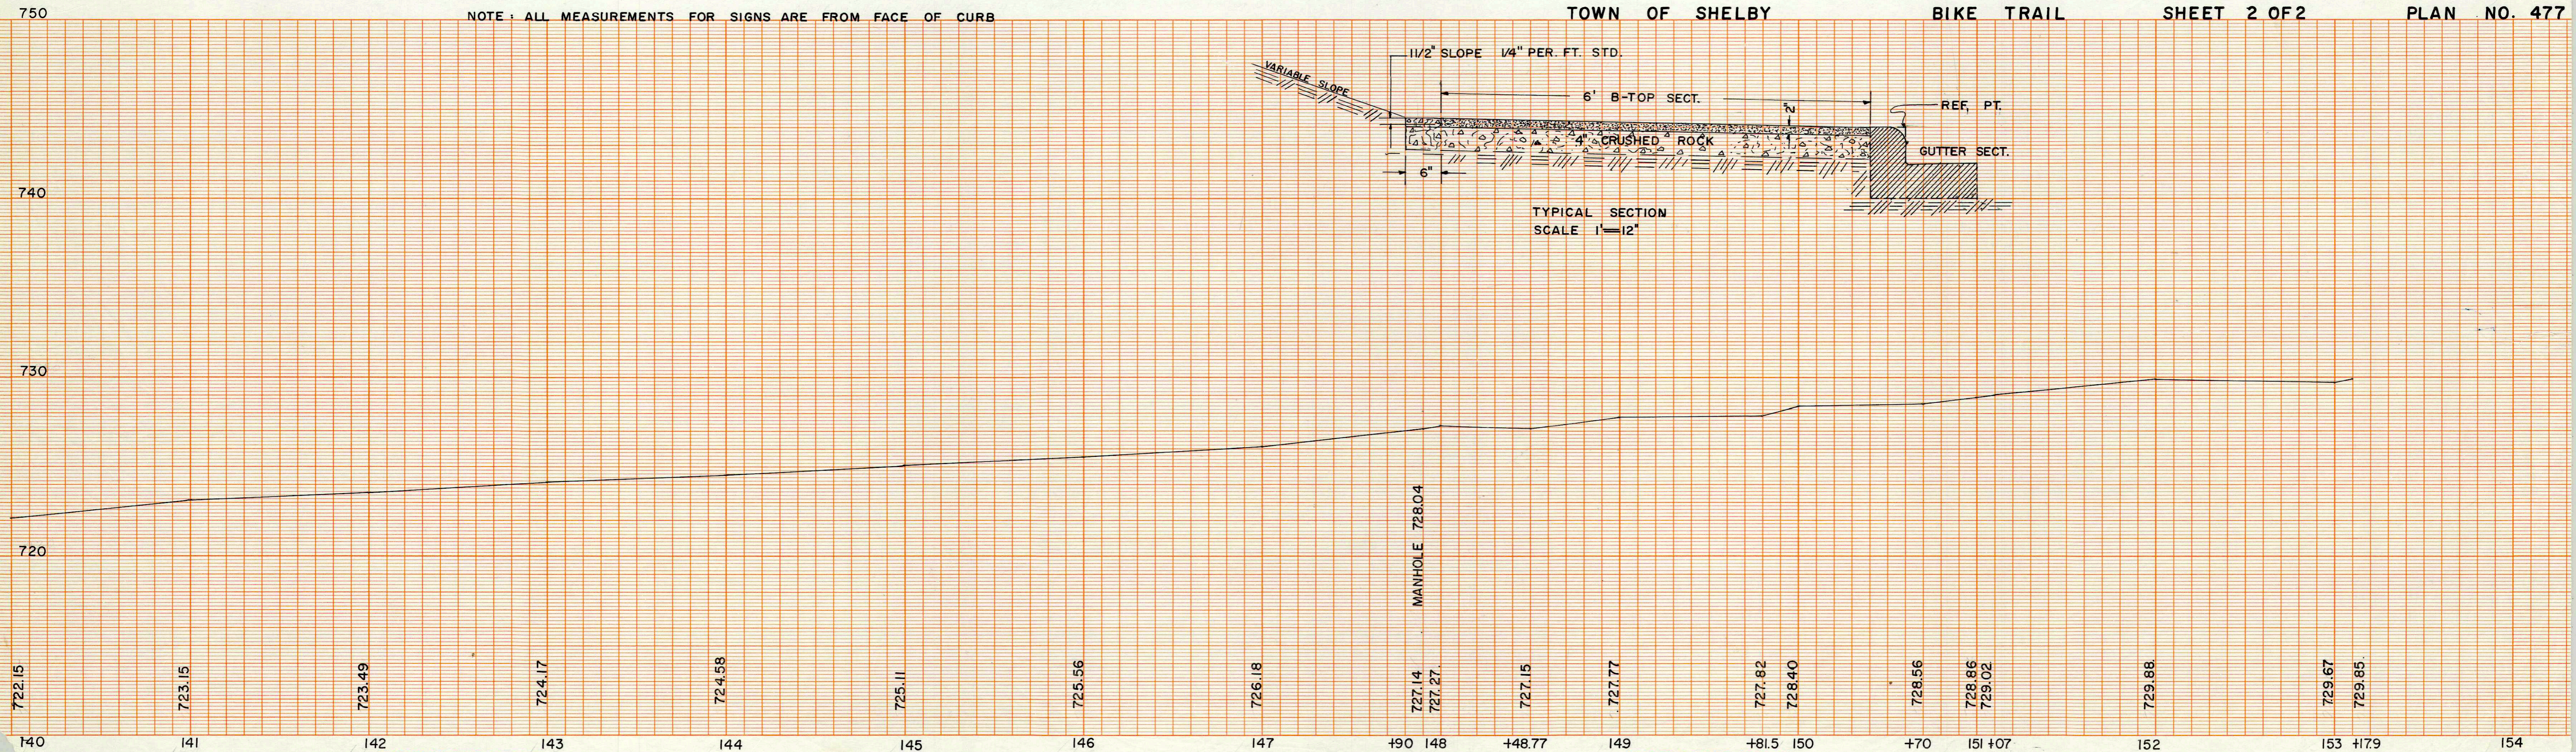

TYPICAL SECTION  
SCALE 1"=12"