



 PROJECT: SE 1/4-SE 1/4 SEC. 2, T17N, R7W HERMAN J. & VERONICA MILLER

 PROJECT: SW 1/4-SW 1/4 SEC. 1, T17N, R7W ARTHUR & VOLBERG SKOGEN & LEILA SCHALLER

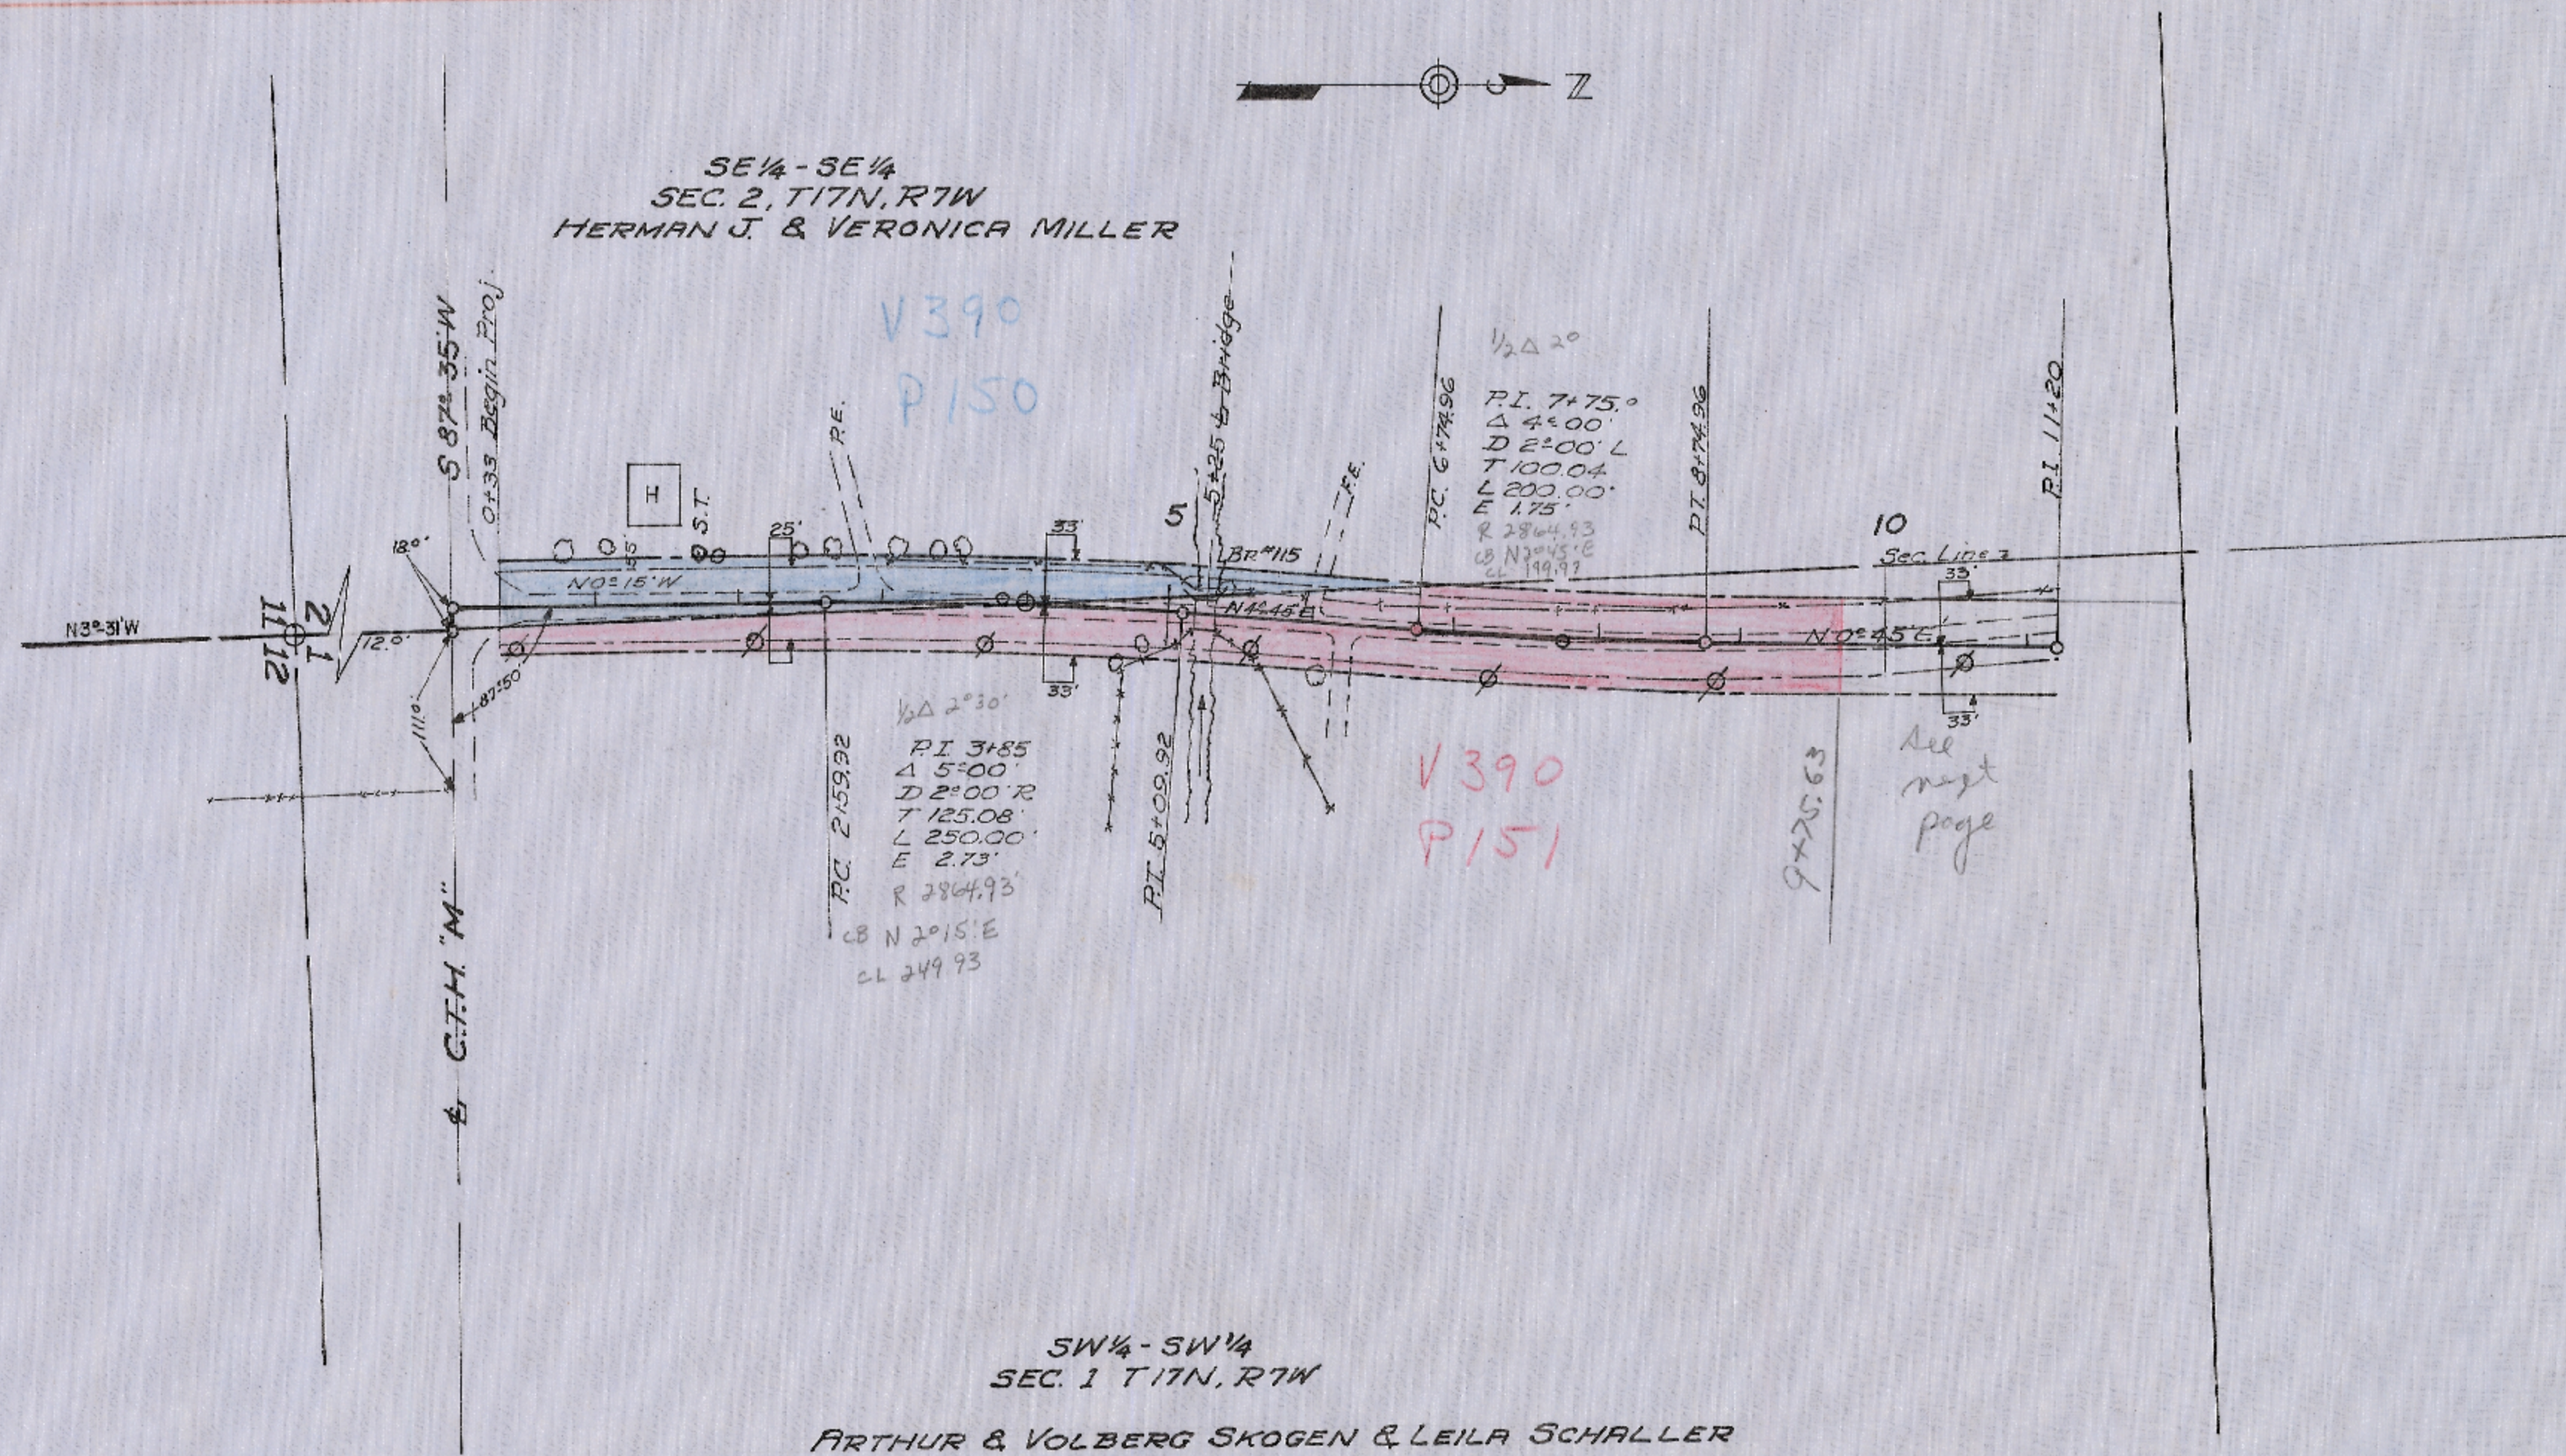

LOCATION PLAN  
 SCALE 1"=100'

B.M. Sta. 13105 El. 804.24  
 " " Spk. in P.P. # K 153, 334 East of 0+00 El. 788.92  
 T.B.M. Spk. in 24" Tree, 65' Lt. Sta. 0+96 El. 782.40  

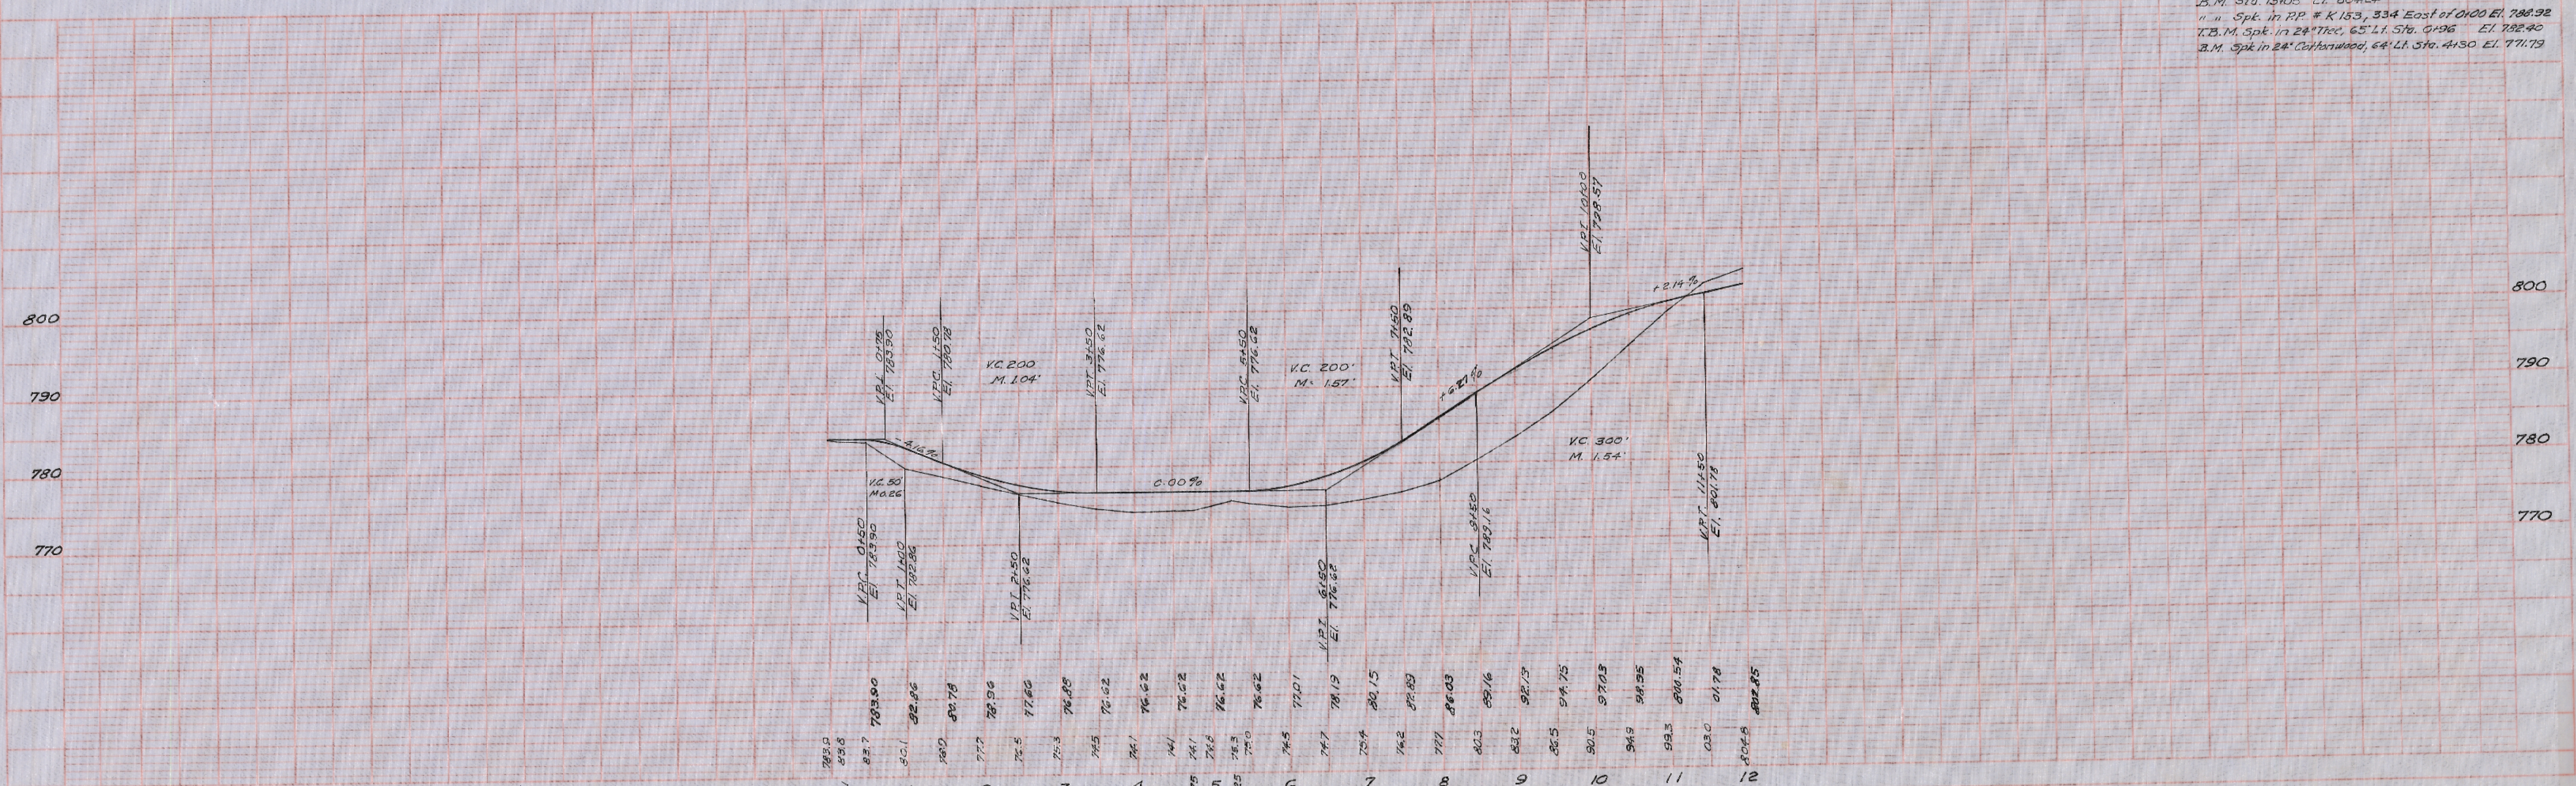



C.T.H. "W"

SHEET 1 OF 4

PLAN NO. 362

REVISIONS  
 DATE BY  
 10/15/52 R.E.S.

PROFILE  
 DATE BY  
 10/15/52

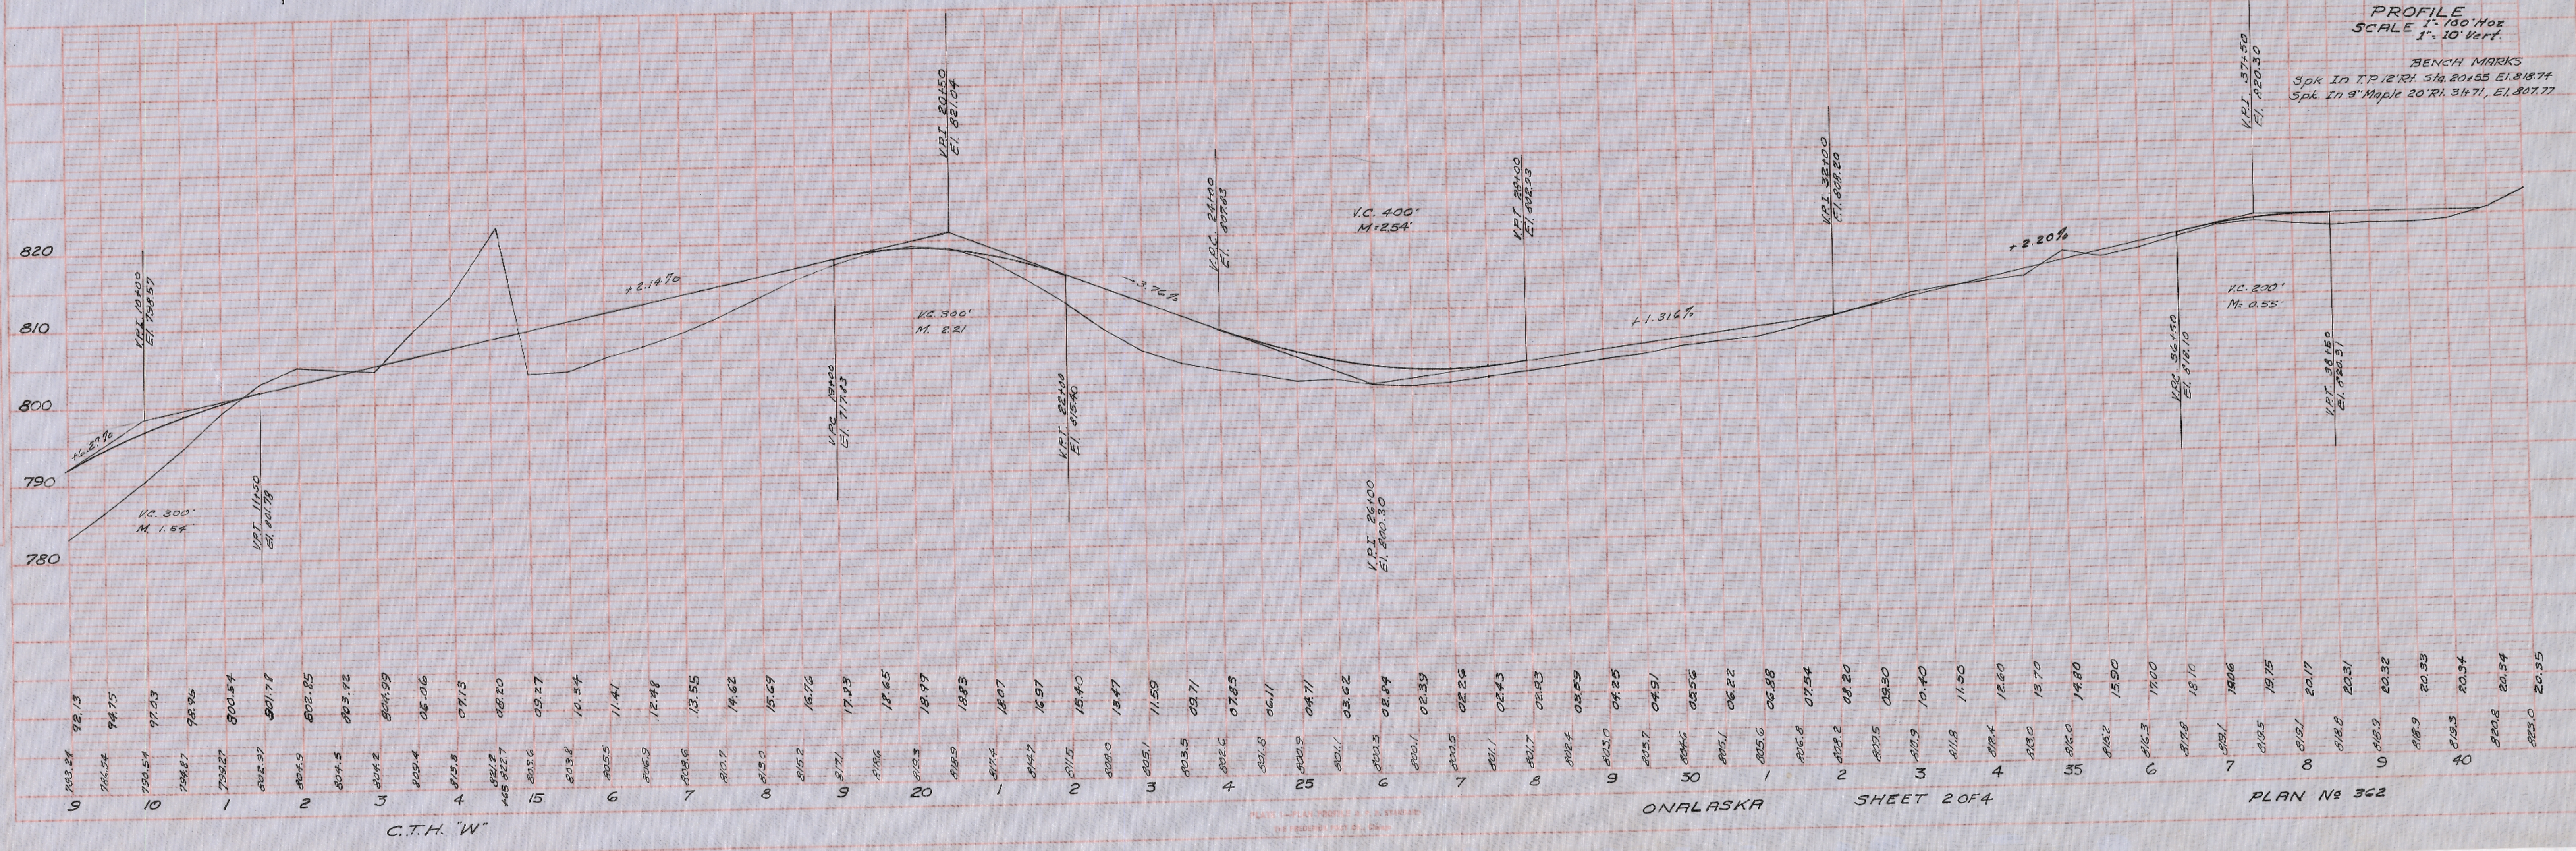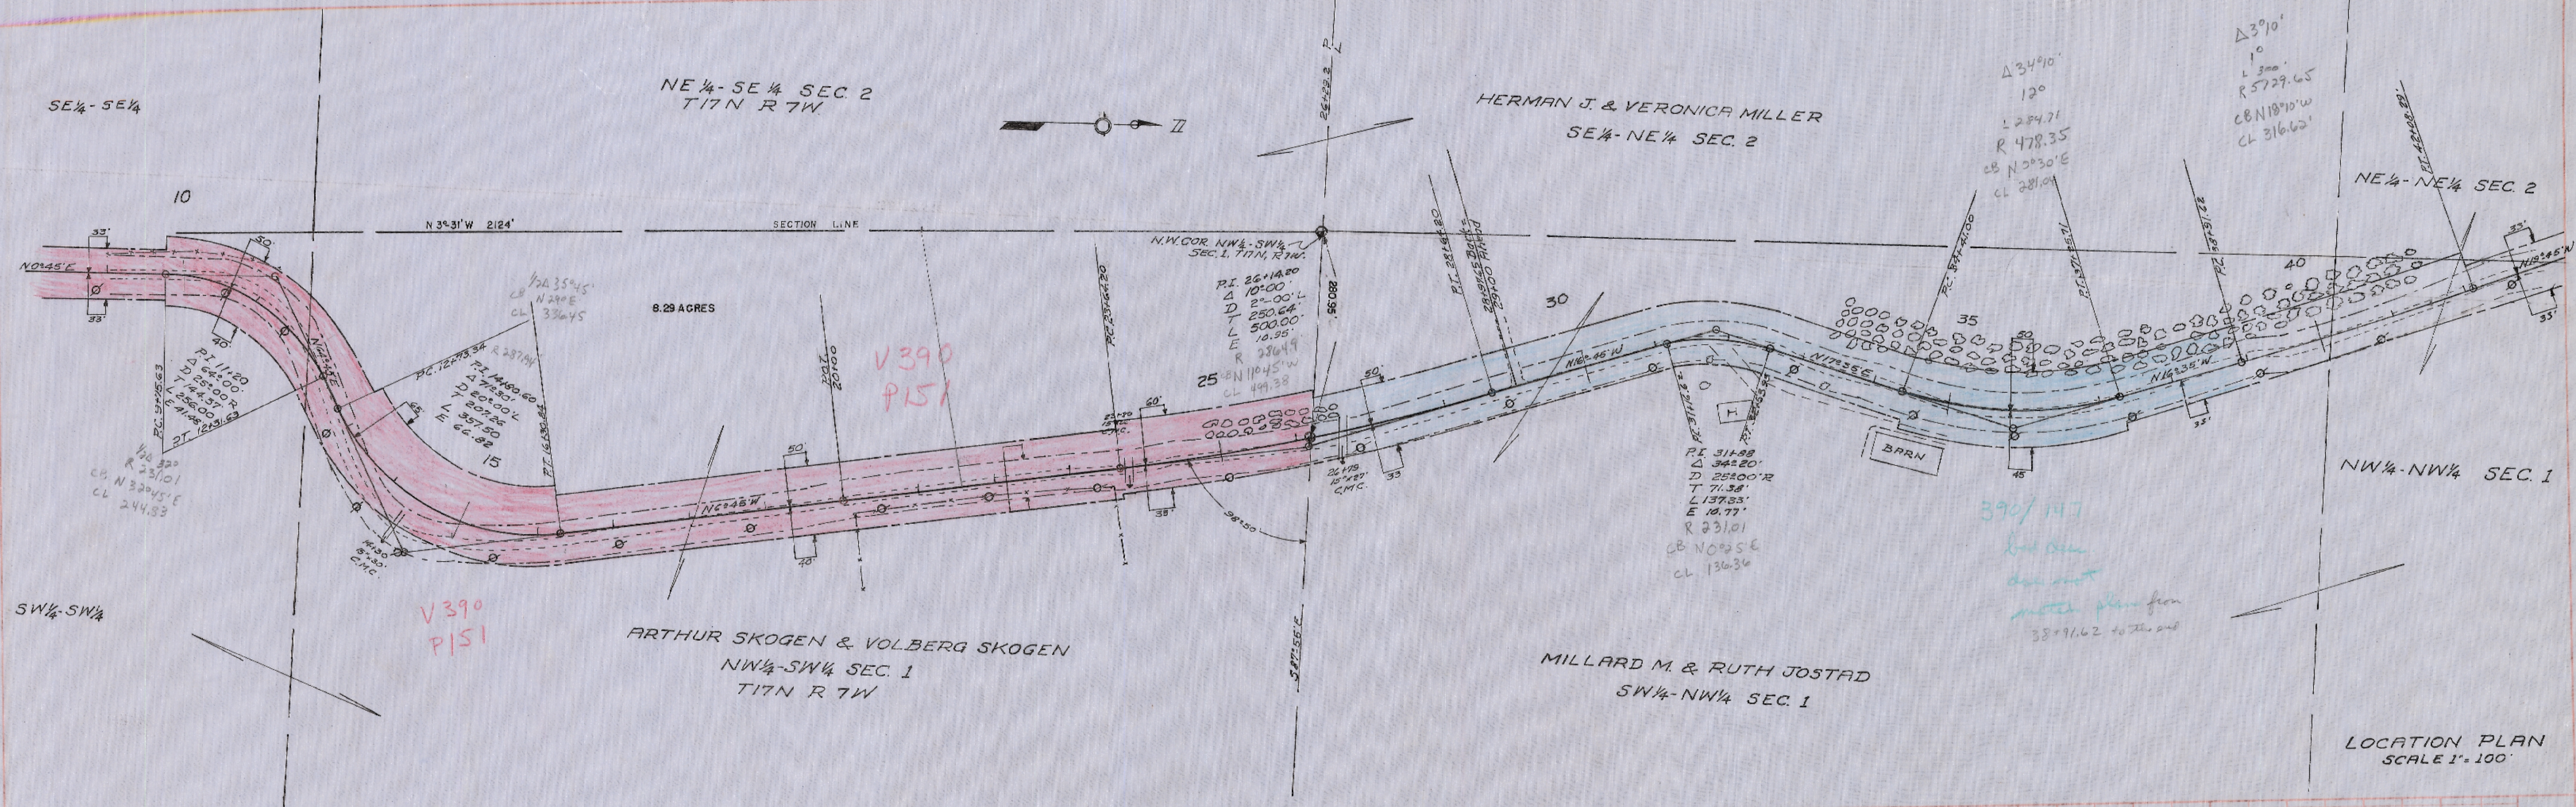




HERMAN J. & VERONICA MILLER  
 SE 1/4 - NE 1/4 SEC. 2

MILLARD M. & RUTH JOSTAD  
 SW 1/4 - NW 1/4 SEC. 1  
 T17N R7W


NE 1/4 - NE 1/4 SEC. 2

NW 1/4 - NW 1/4 SEC. 1

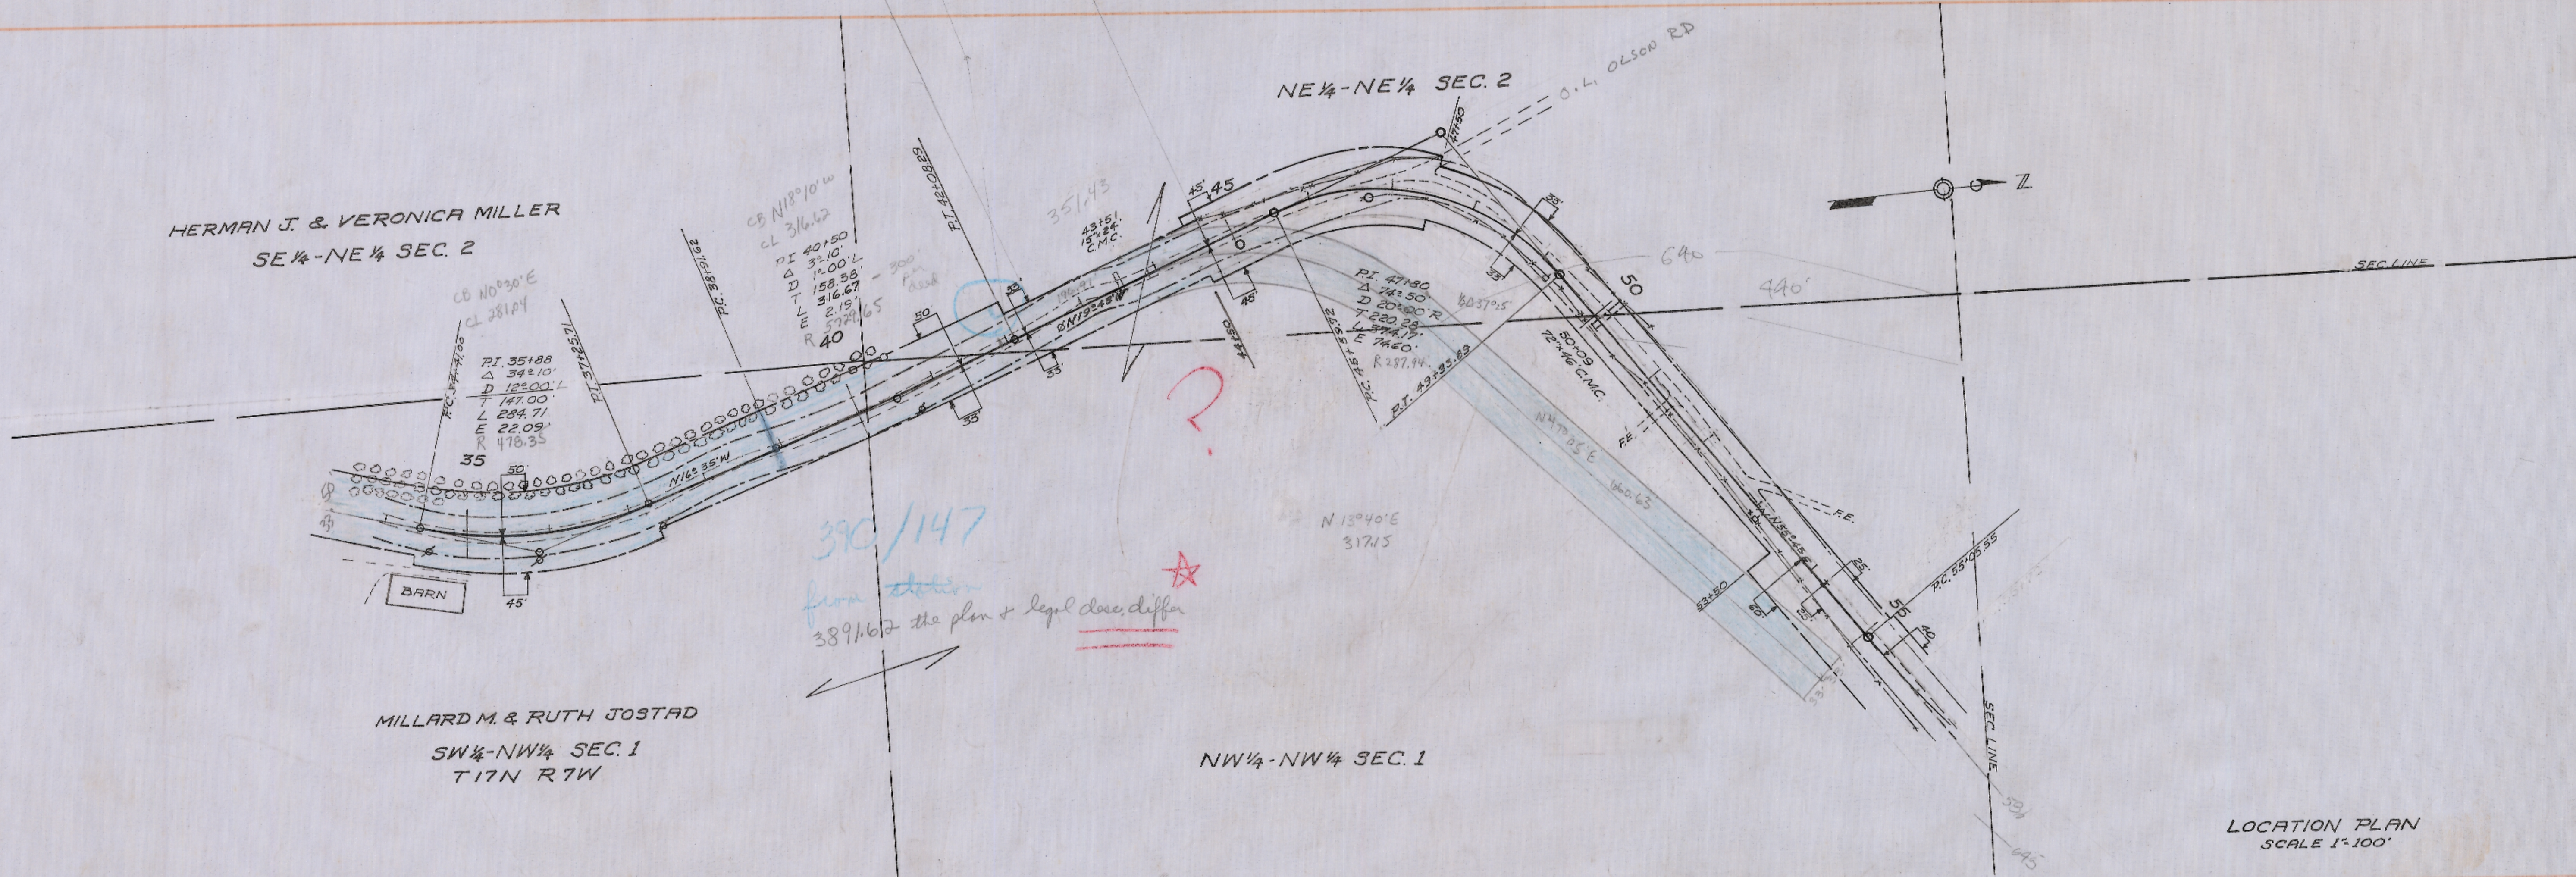

LOCATION PLAN  
 SCALE 1"=100'

PROFILE  
 SCALE 1"=100' HORIZ.  
 1"=10' VERT.  
 B.M. Spk in TP 8' RR. 54' 42160 El. 820.05  
 B.M. Spk in TP Int. C.T.H. W & Olson Rd. El. 822.10

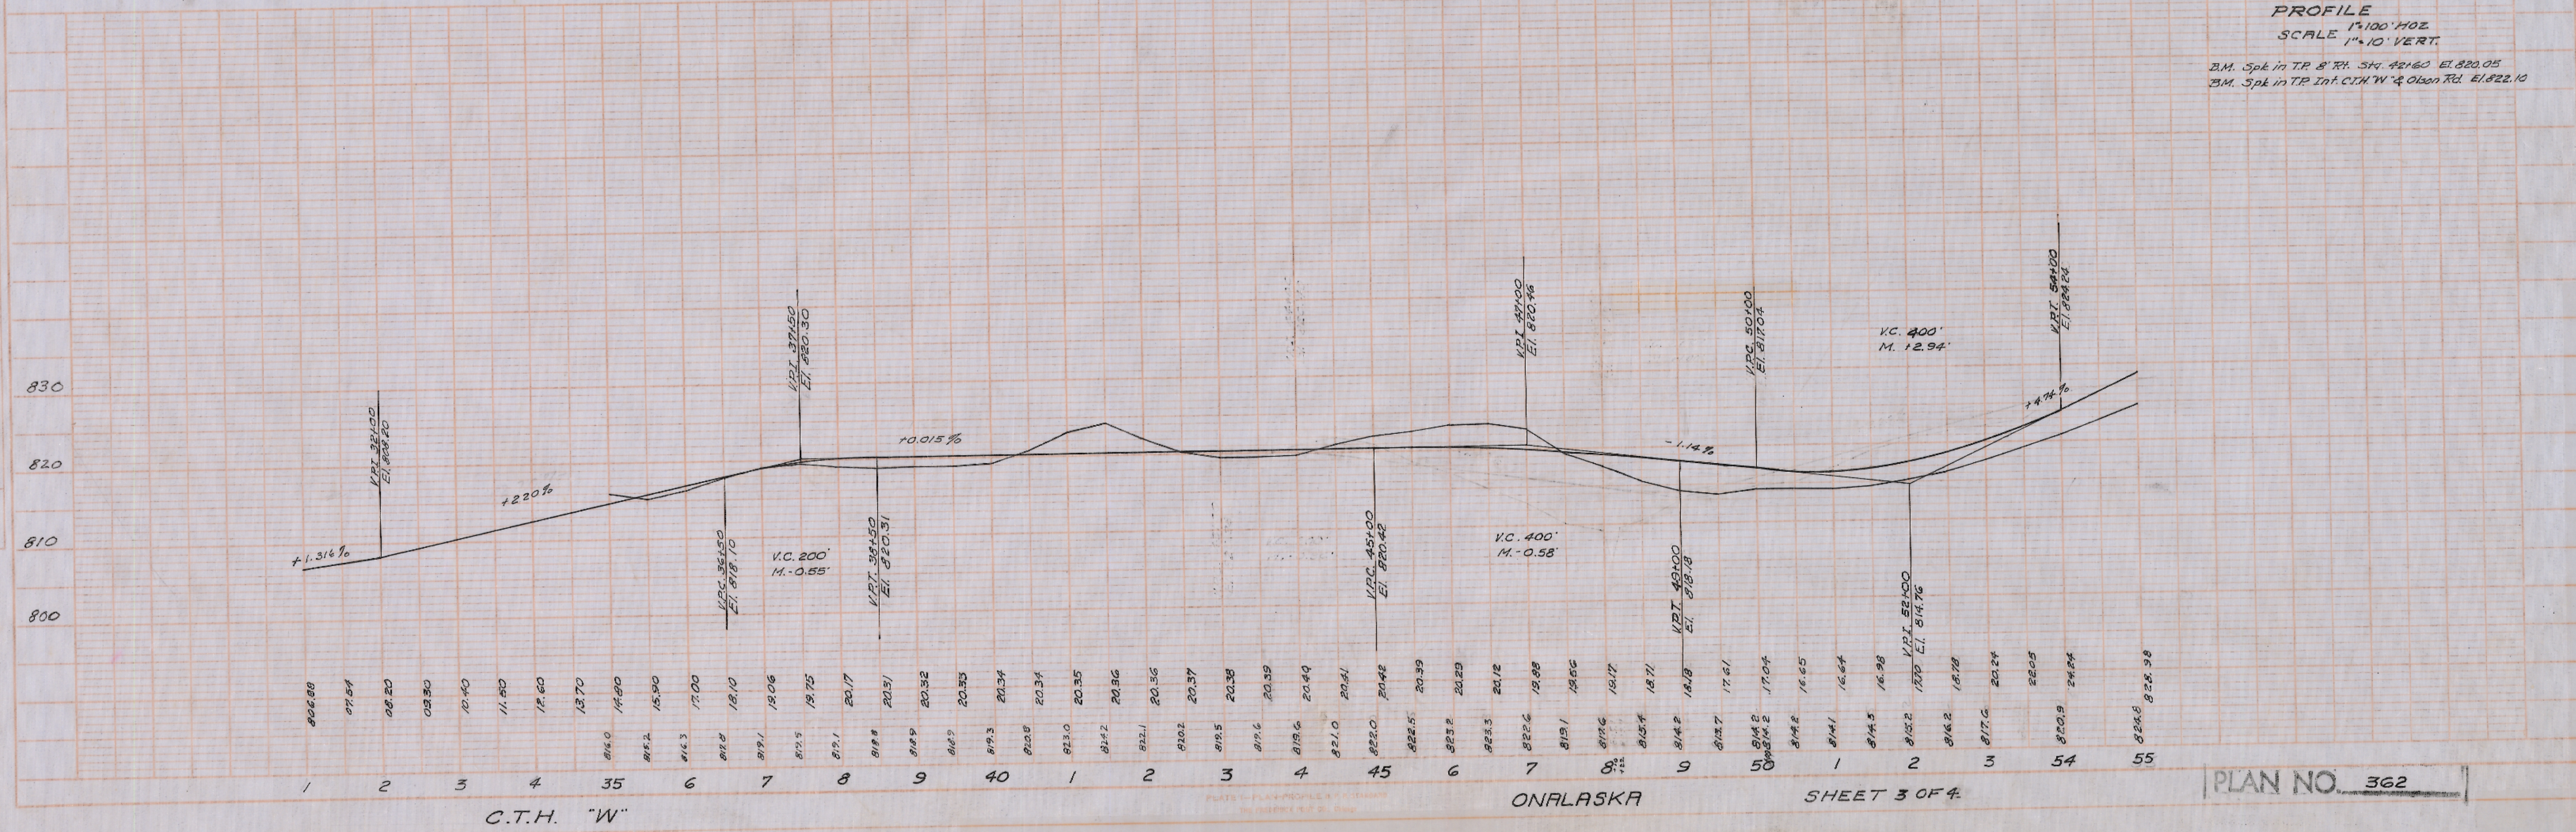

C.T.H. "W"

ONALASKA

SHEET 3 OF 4

PLAN NO. 362



