


DATE: 4.30.64
 DRAWN BY: J.S.M.
 CHECKED BY: J.S.M.
 PROJECT: ONLASK

DATE: 4.30.64
 DRAWN BY: J.S.M.
 CHECKED BY: J.S.M.
 PROJECT: ONLASK



LOCATION PLAN
 scale 1"=100'

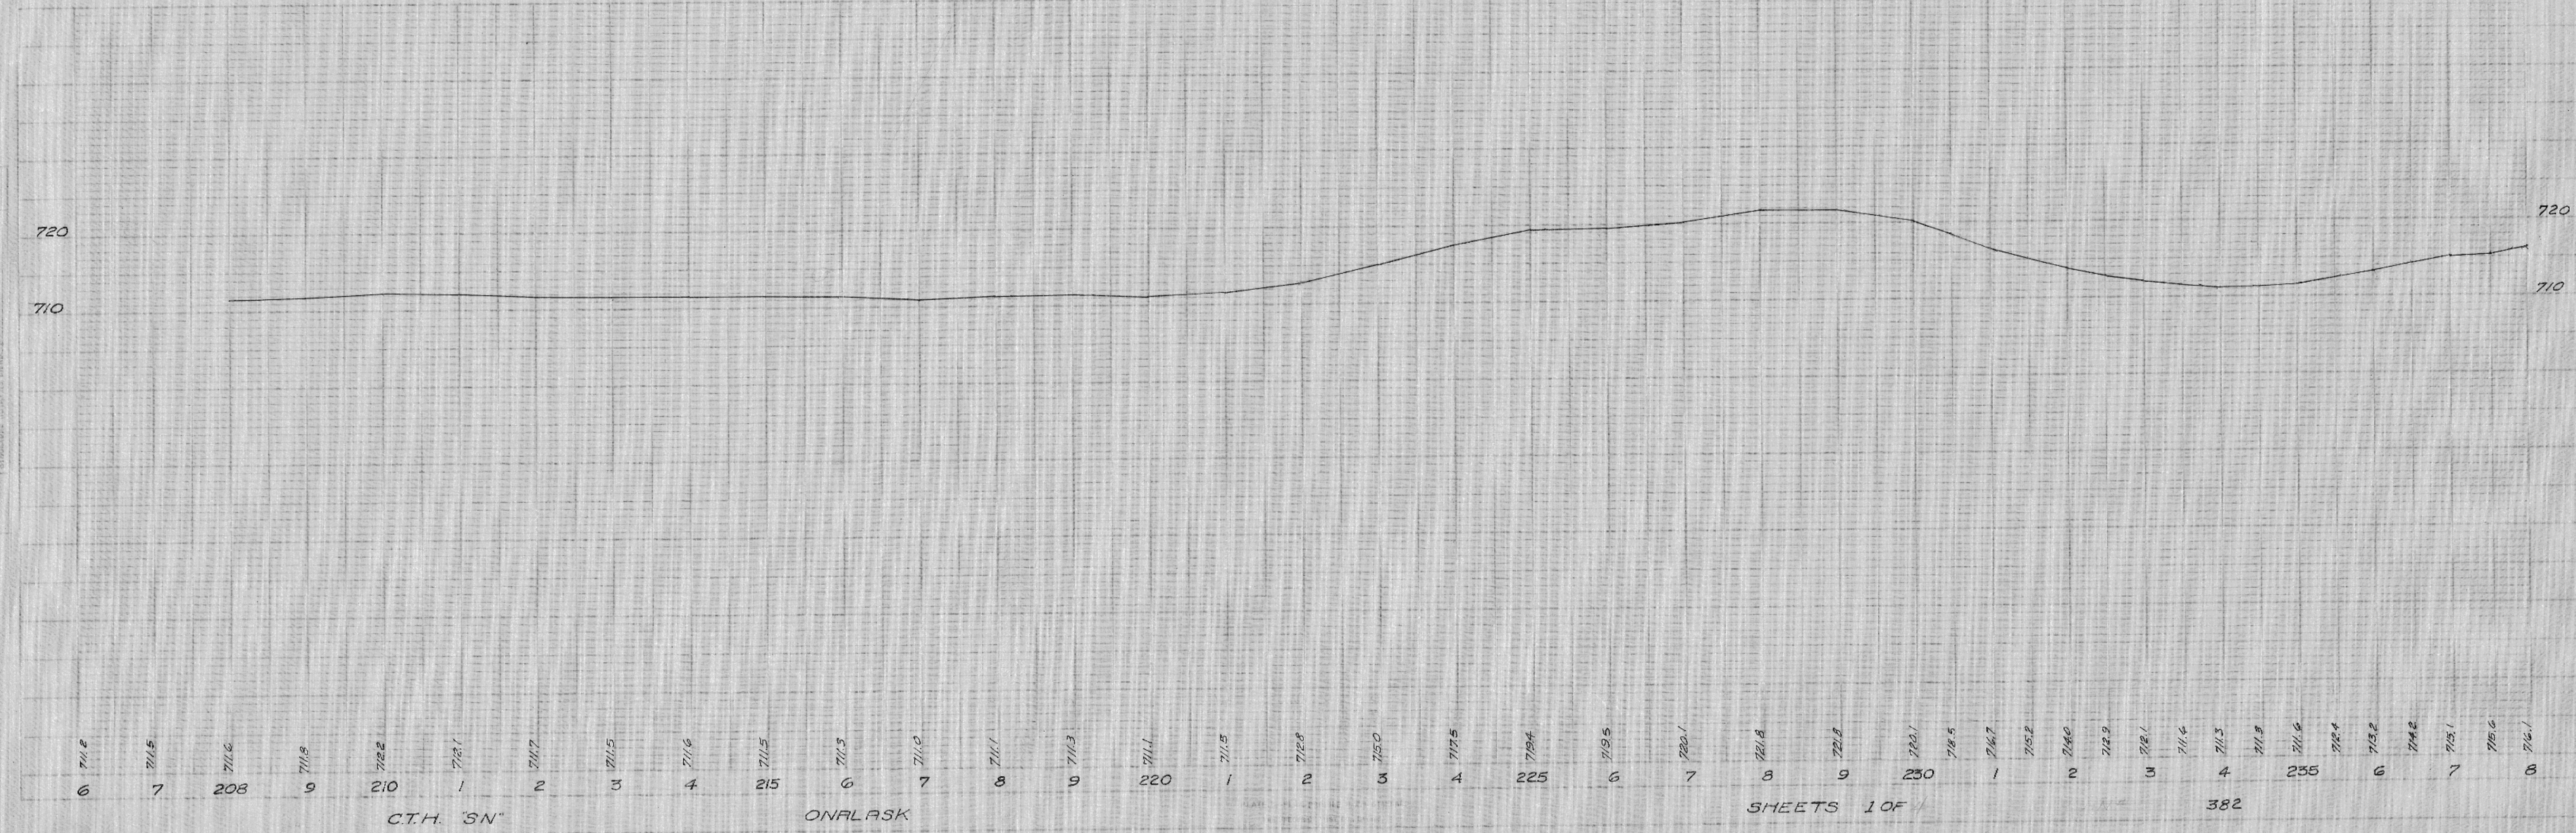

C.T.H. 'SN'



ONLASK

SHEETS 10F

382

4-24-64
 4-30-64
 J.E.M.
 R.E.D.
 152

4-24-64
 4-30-64
 J.E.M.
 R.E.D.
 155

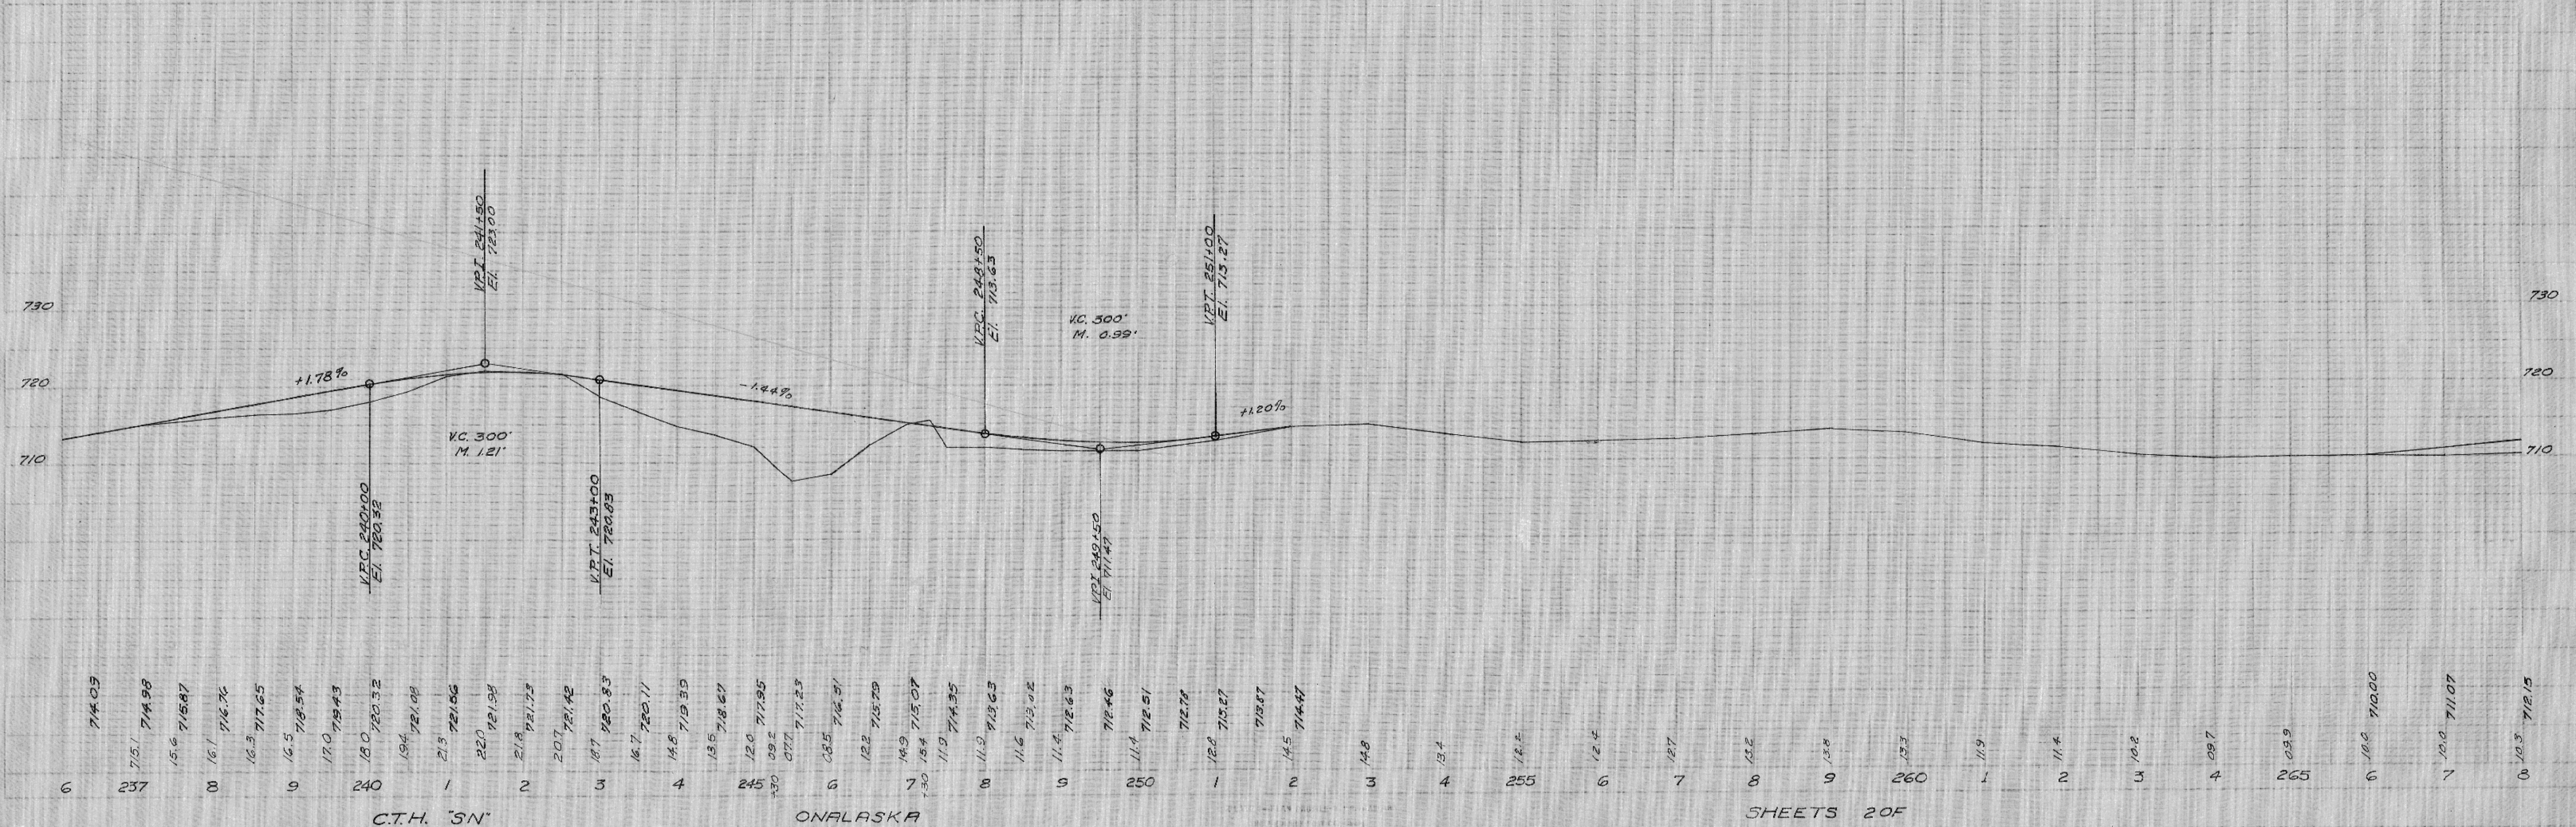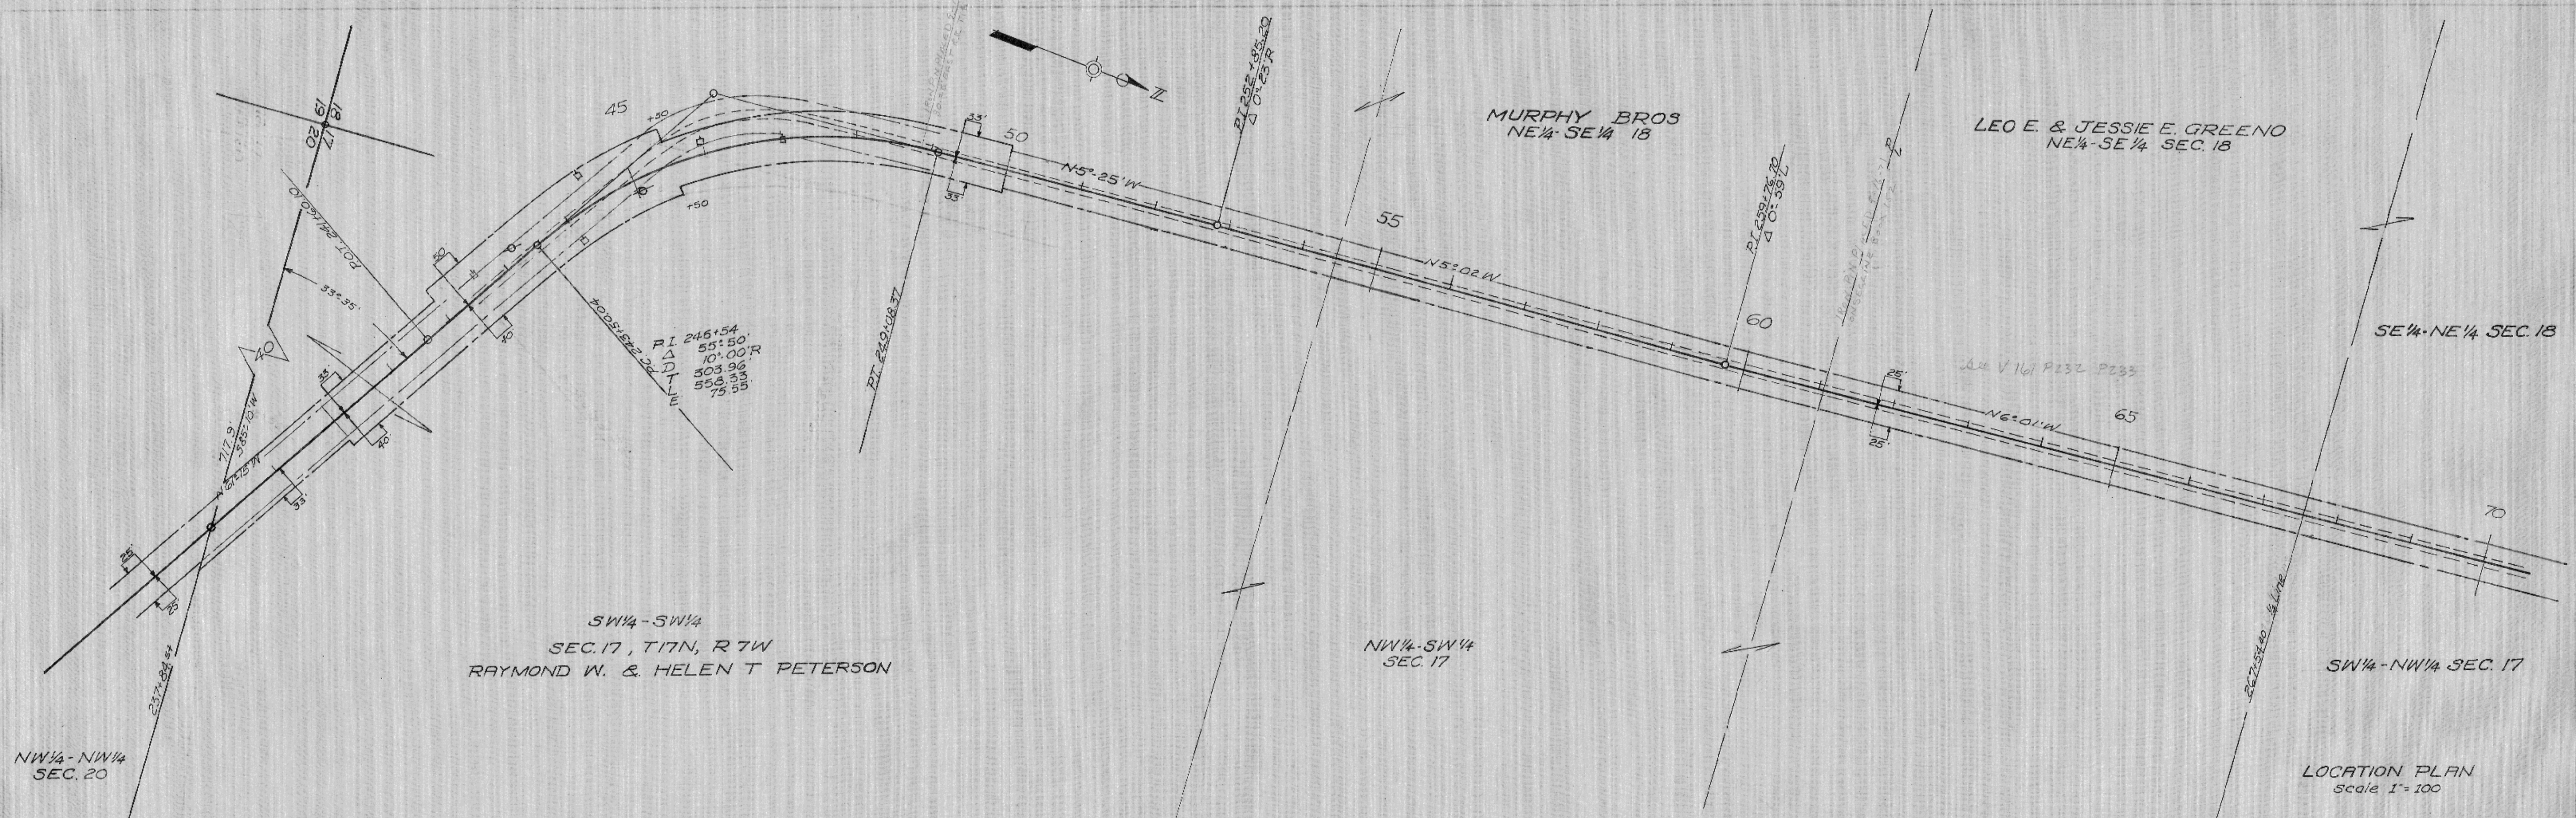

C.T.H. 'SN'

ONALASKA

SHEETS 20F


DATE: 5-5-64
 5-16-64
 J.S.M.
 R.E.B.
 102

DATE: 5-5-64
 5-16-64
 J.S.M.
 R.E.B.
 155




PLAN NO. 382
DATE
BY
CHECKED
DATE

DATE
BY
CHECKED
DATE

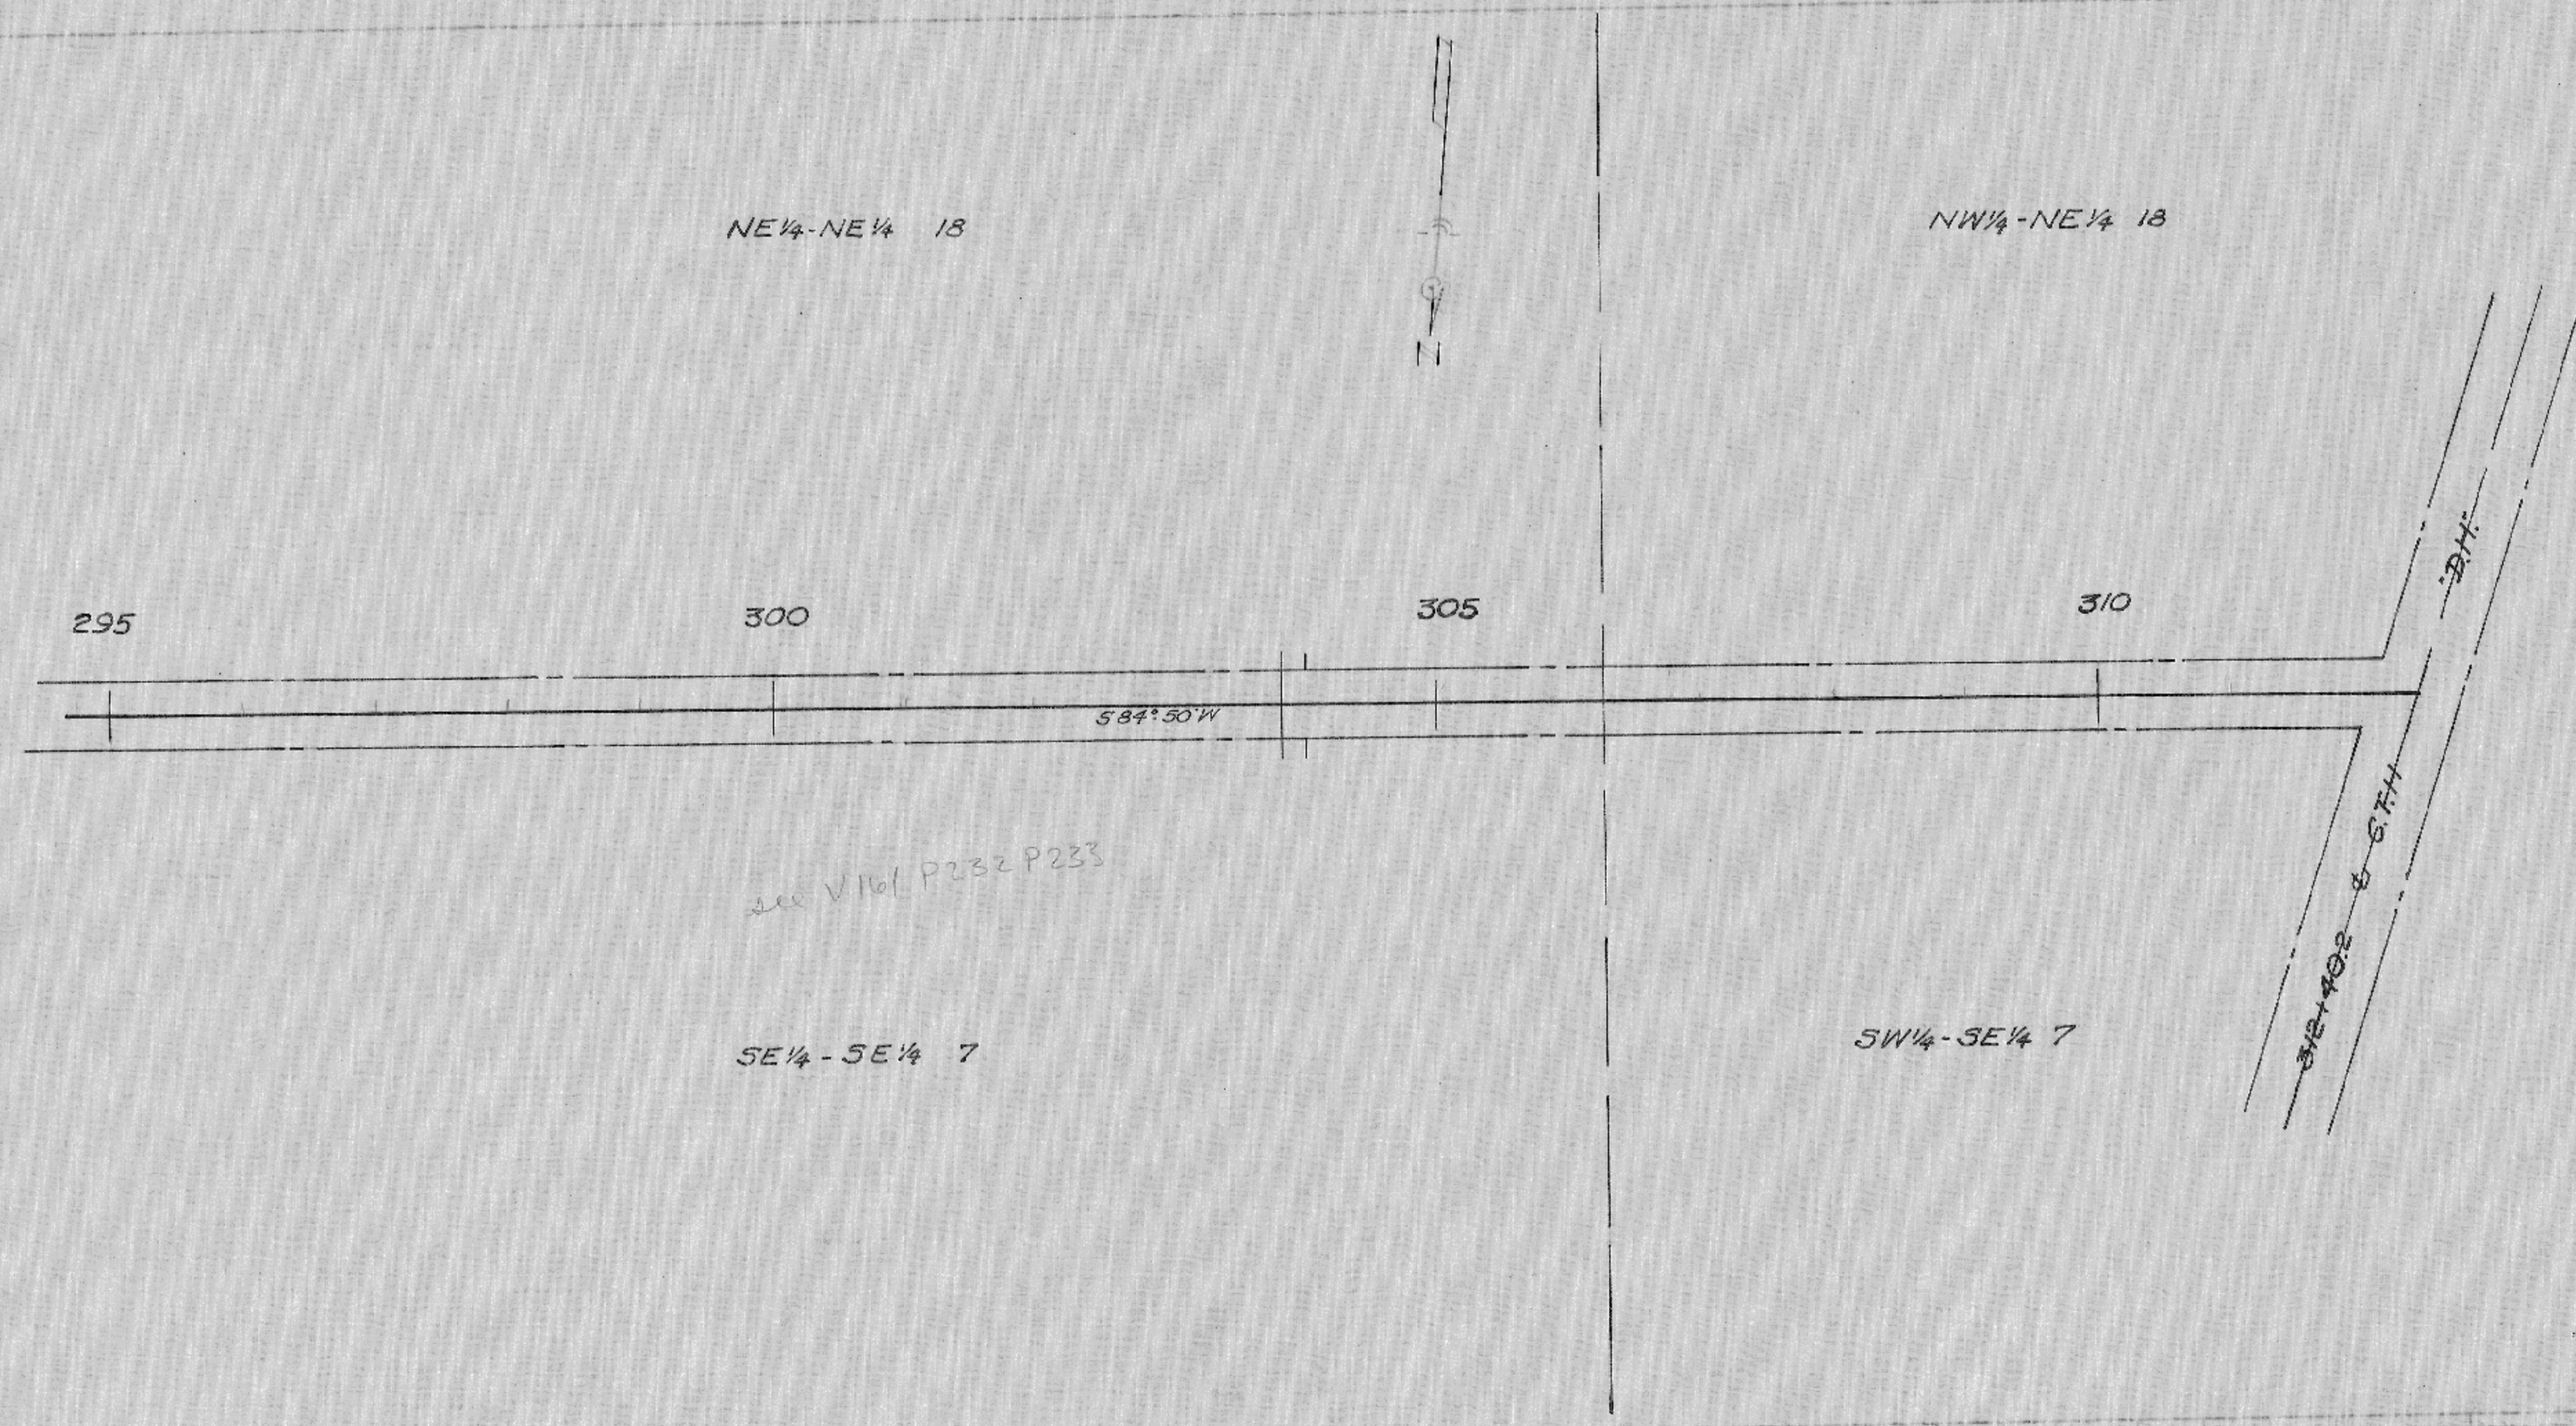


LOCATION PLAN
Scale 1" = 100'


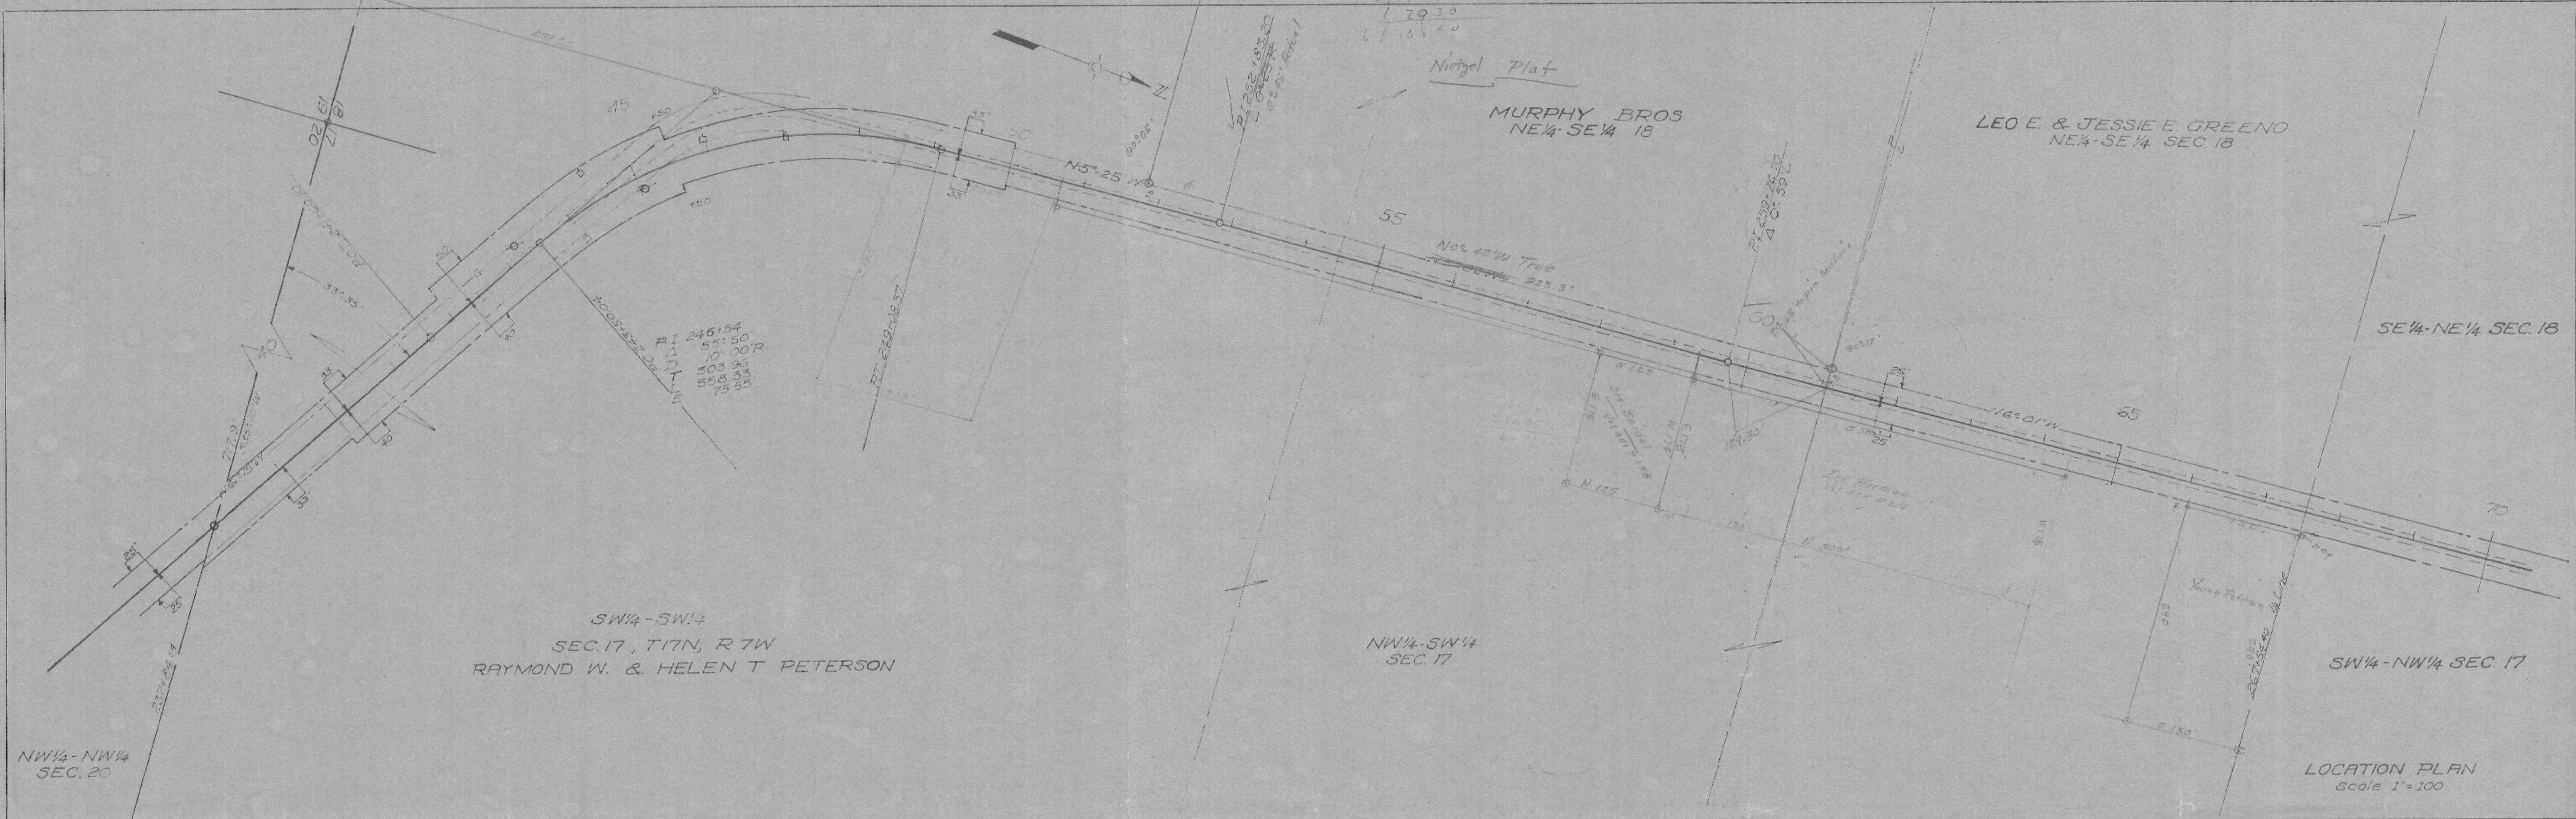

PROFILE	DATE	BY
	7/10/57	J.S.Z.
7. NO.	7.52	

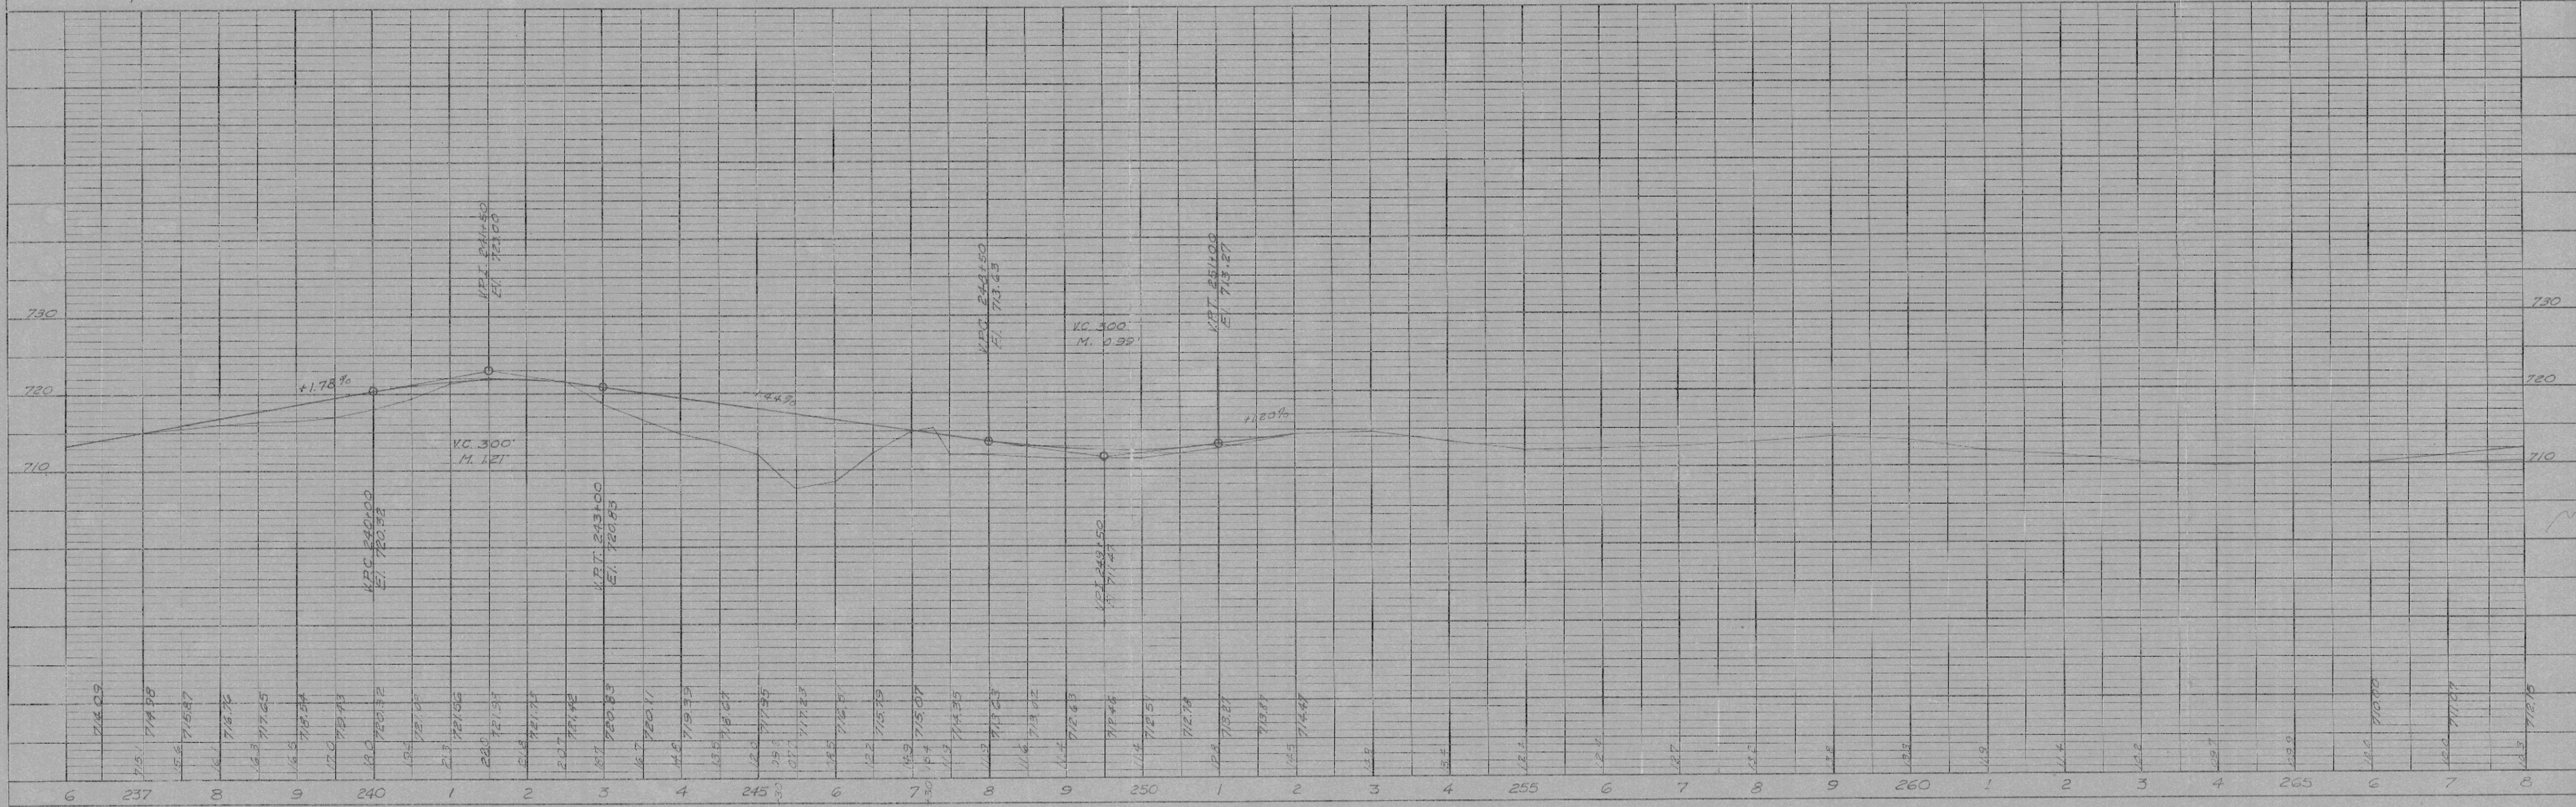

C.T.H. 'SN'

ONALASKA

PLATE 1 - PLAN PROFILE N. P. R. STABERG
THE FREDERICK POST CO., Chicago

SHEETS 20F