
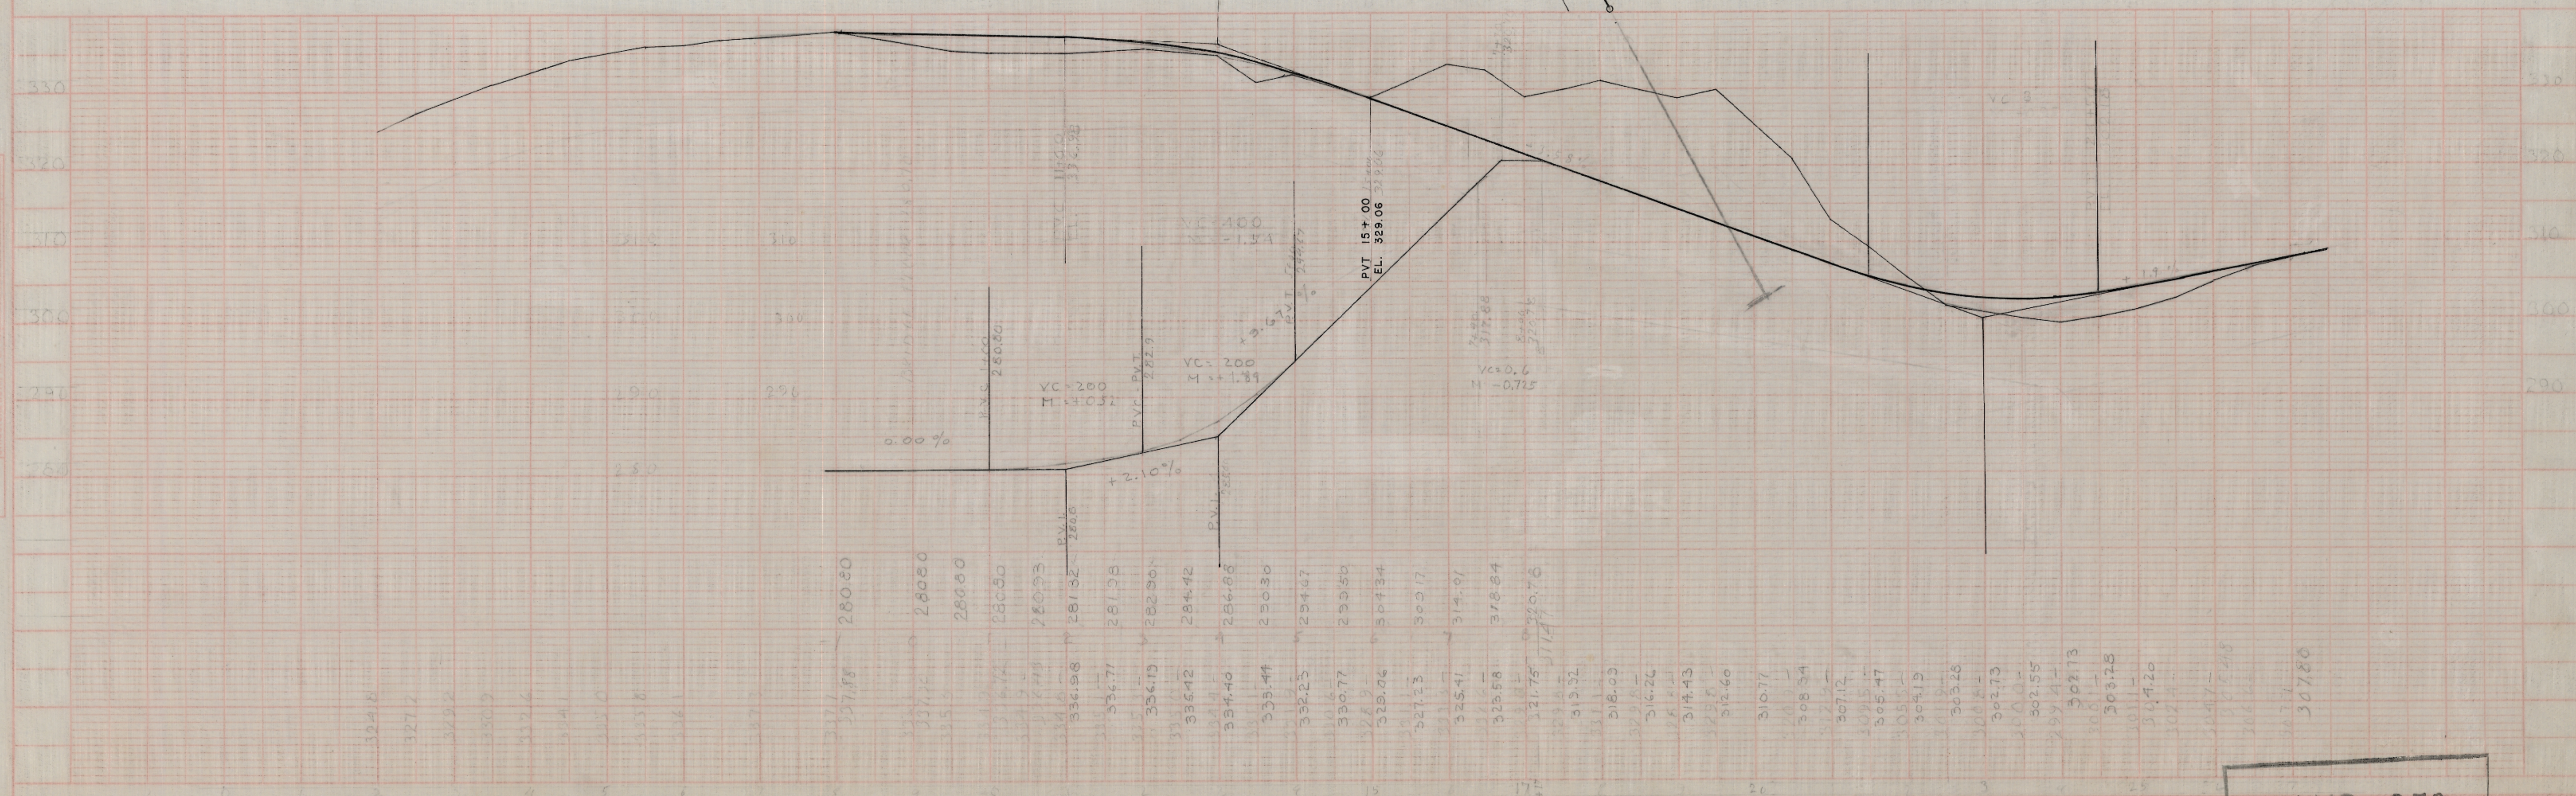


B.P.R. DIVISION	PROJECT	SHEET NUMBER	TOTAL SHEETS
5N	CTH "G" "H" WASHINGTON 532 - 712 - 126	1	2

PLAN	DATE	BY
12/15/57	D.C.	
177		

PROFILE	DATE	BY
12/15/57	D.C.	
178		

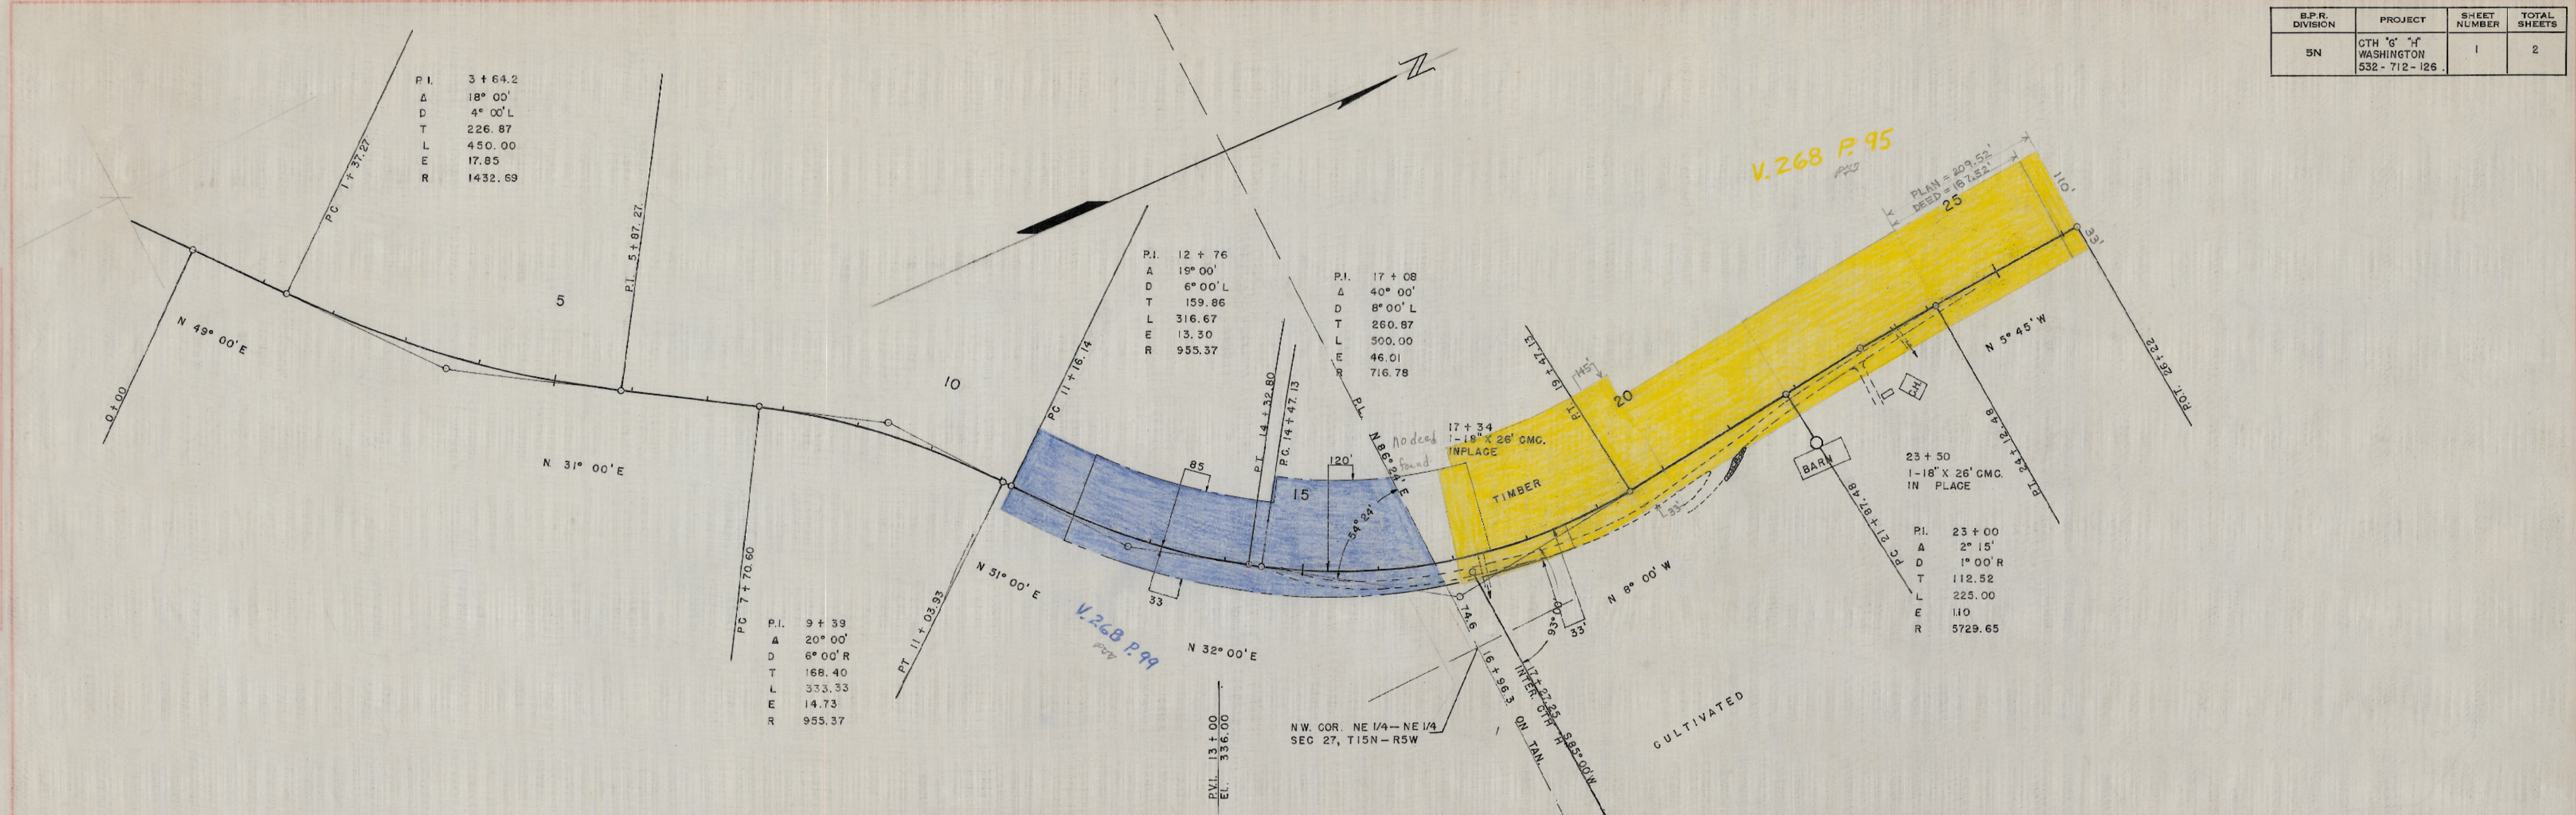

CTH "G" "H" Town of Washington


Sheet 1 of 2

PLAN NO. 272



S.P.R. DIVISION	PROJECT	SHEET NUMBER	TOTAL SHEETS
5N	6TH 'G' 'H' WASHINGTON 532-712-126	1	2

PLAN	DATE
SURVISED PLOTTED NOTE BOOK CHECKED NO. 1177	

PROFILE	DATE
SURVISED PLOTTED NOTE BOOK CHECKED NO. 1177	

