
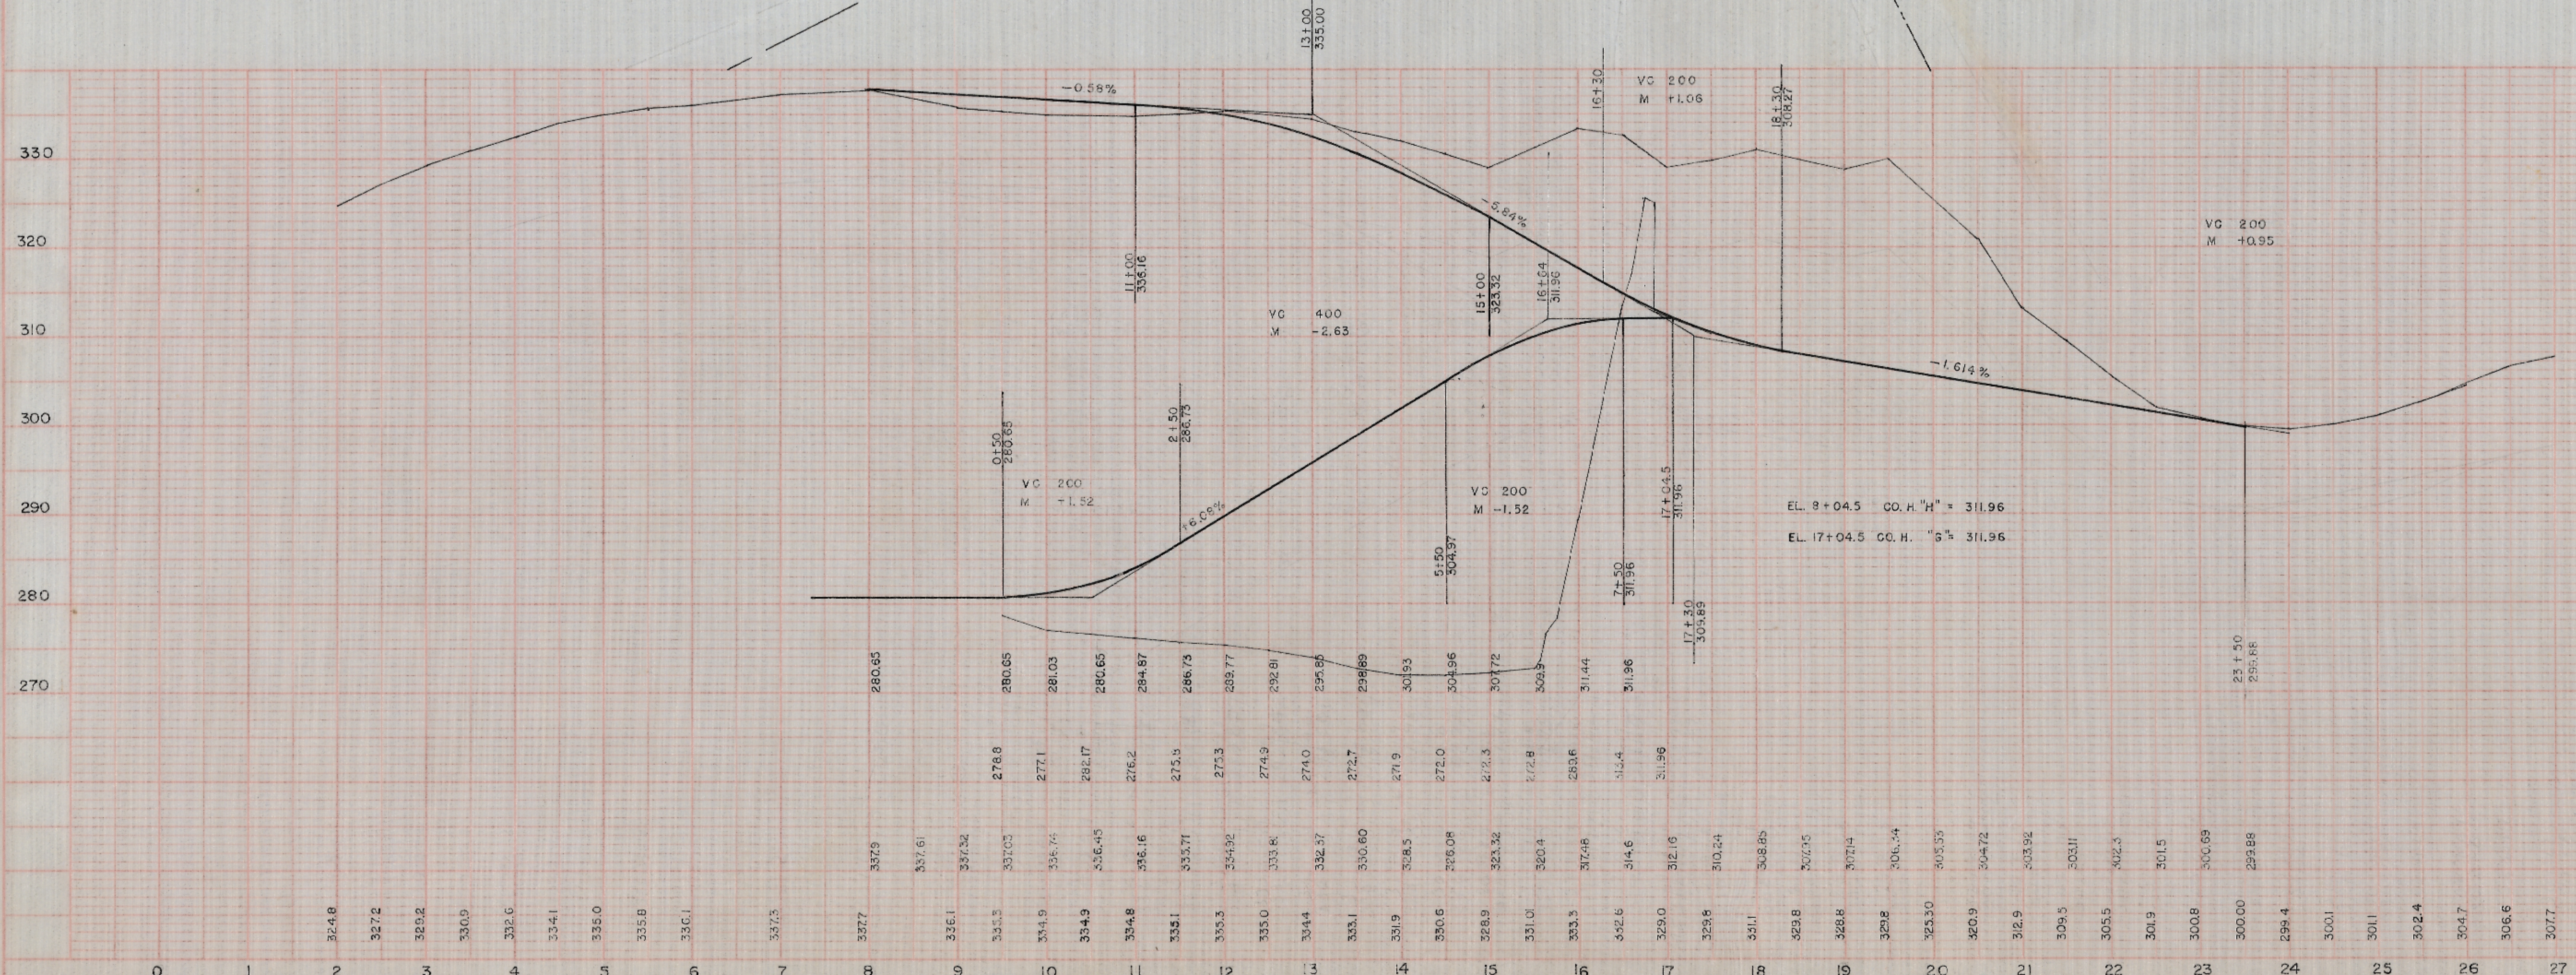


B.P.R. DIVISION	PROJECT	SHEET NUMBER	TOTAL SHEETS
5N			

PLAN
 DRAWN BY
 CHECKED BY
 DATE

PROFILE
 DRAWN BY
 CHECKED BY
 DATE

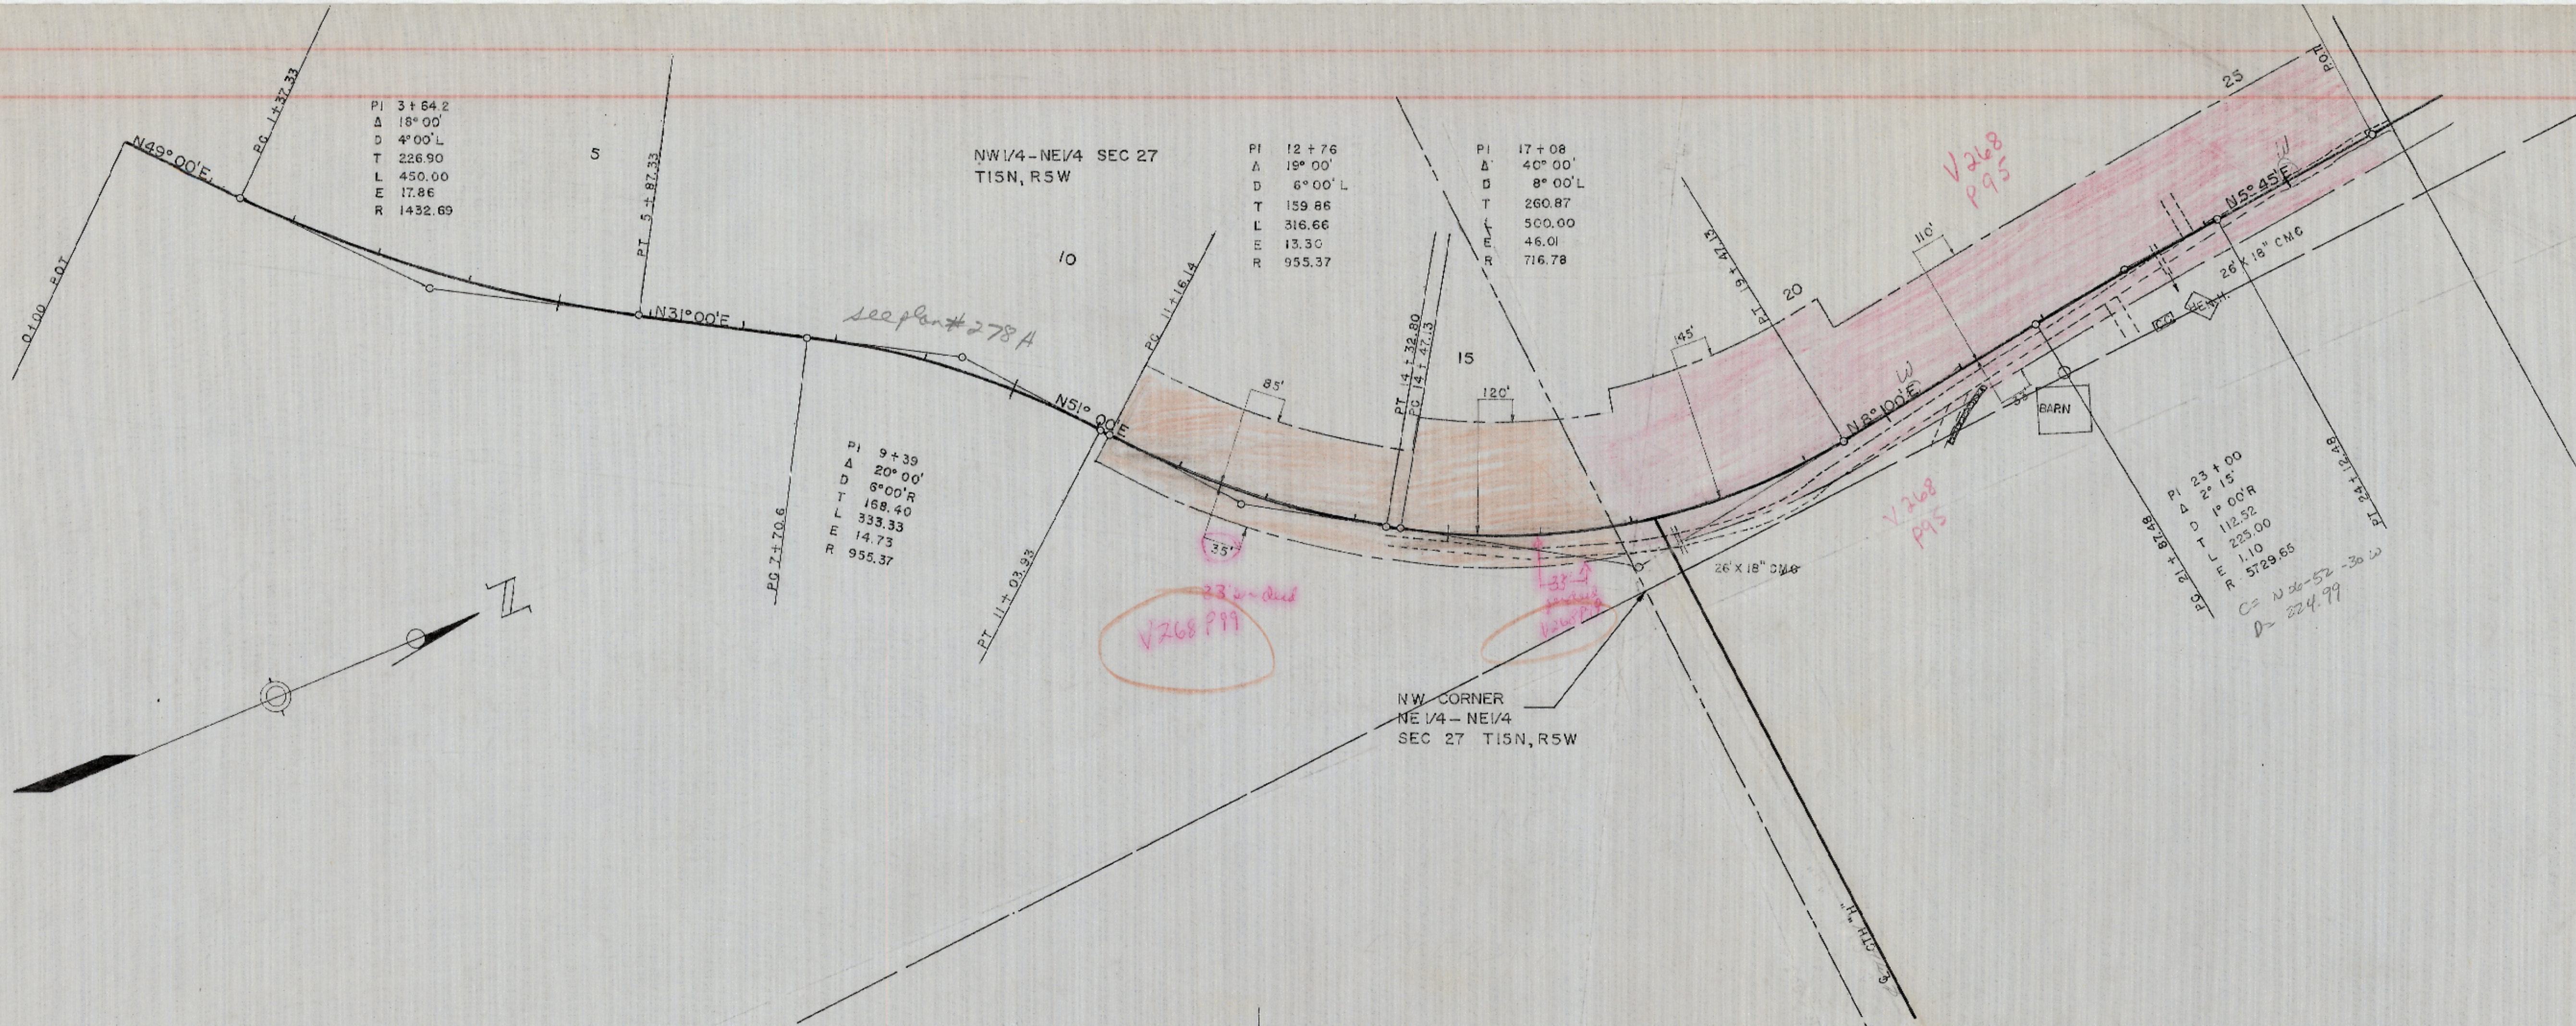

INTERSECTION G&H TOWN OF WASHINGTON

PLAN NO. 275

S.P.R. DIVISION	PROJECT	SHEET NUMBER	TOTAL SHEETS
5N			

PLAN
 DATE
 DRAWN BY
 CHECKED BY
 NO. 177

PROFILE
 DATE
 DRAWN BY
 CHECKED BY



PI	20+44.5
Δ	94°-00'
D	11°-00' L
T	589.36
L	254.54
E	243.22
R	521.67

PI	25+22
Δ	54°-00'
D	11°-00' R
T	265.59
L	490.90
E	63.76
R	521.67

STA. 6+81
 1-60"x34" C.G.M.C.
 IN PLACE

STA. 18+82
 1-18"x40" C.G.M.C.

CTH "H" Town of Washington

CTH "H"

PLAN NO. 275