
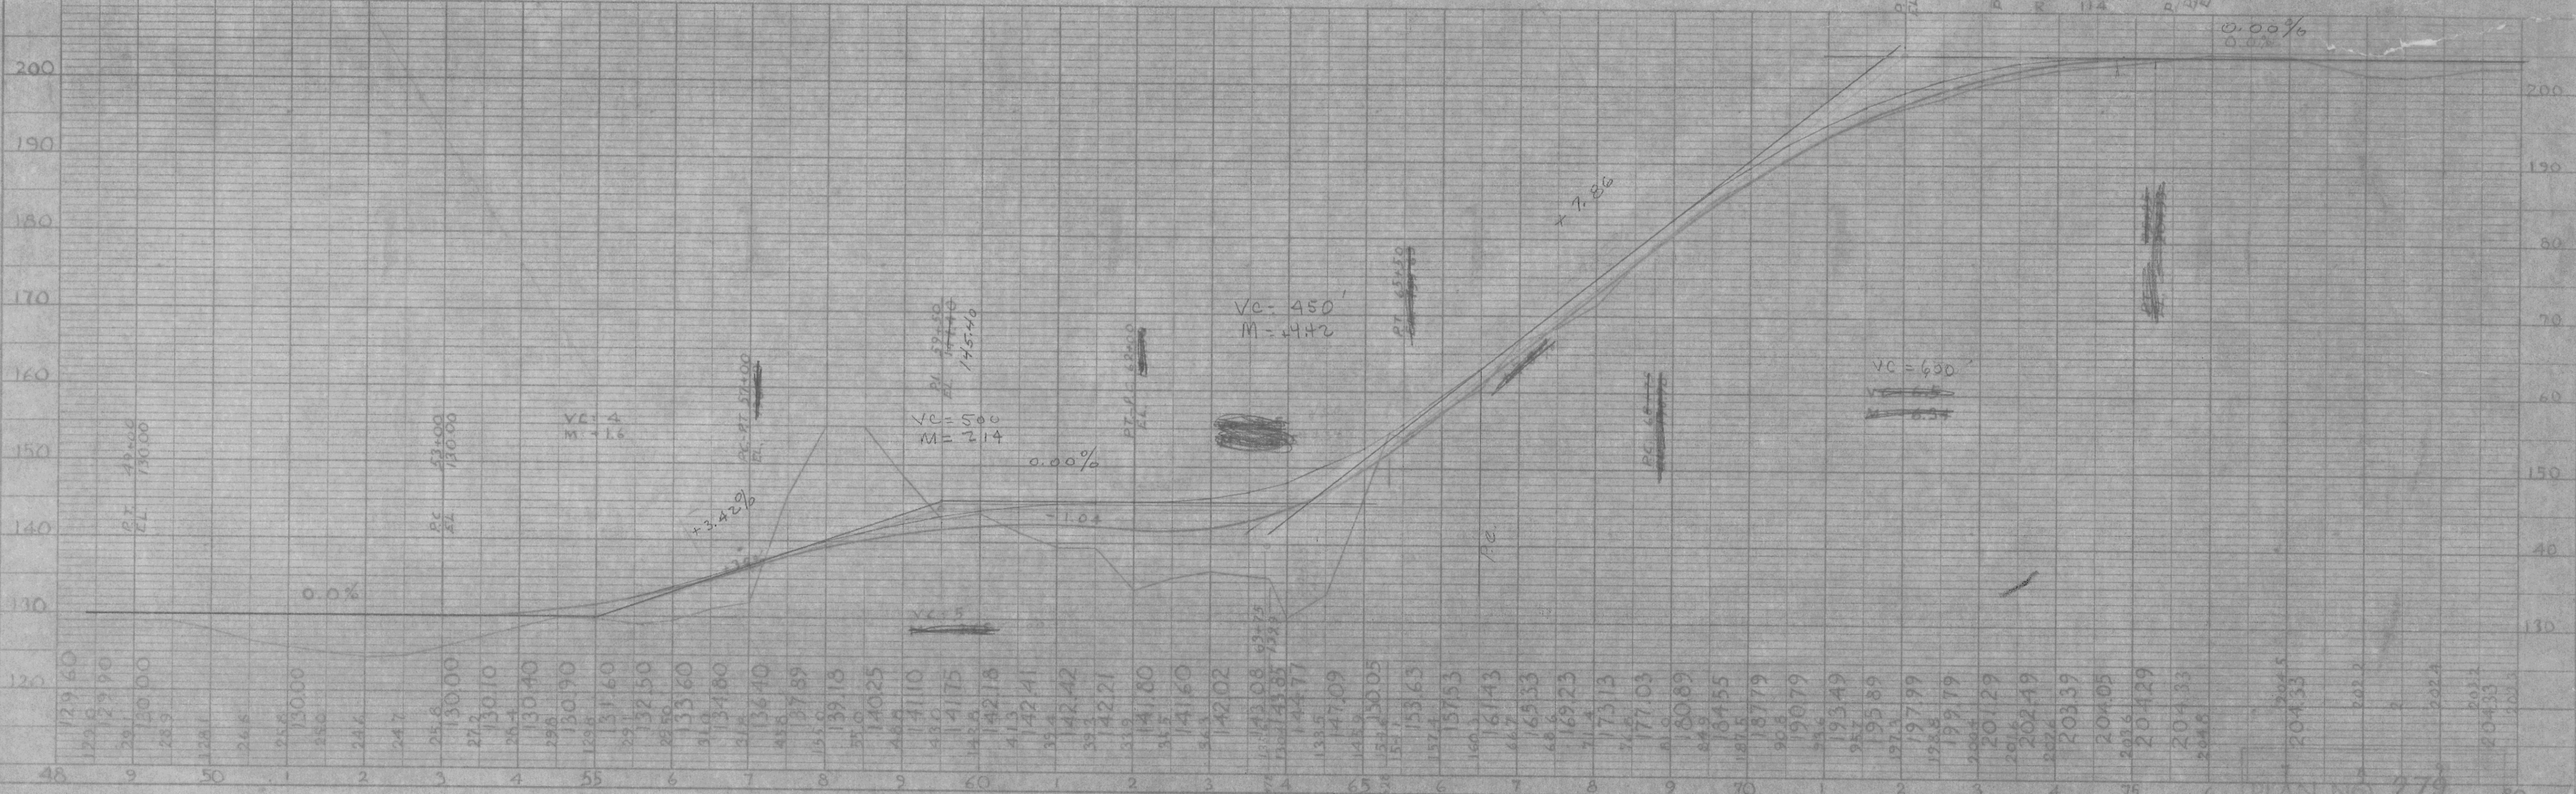


B.P.R. DIVISION	PROJECT	SHEET NUMBER	TOTAL SHEETS
SN	WASHINGTON Co. I.G. 61	3	3



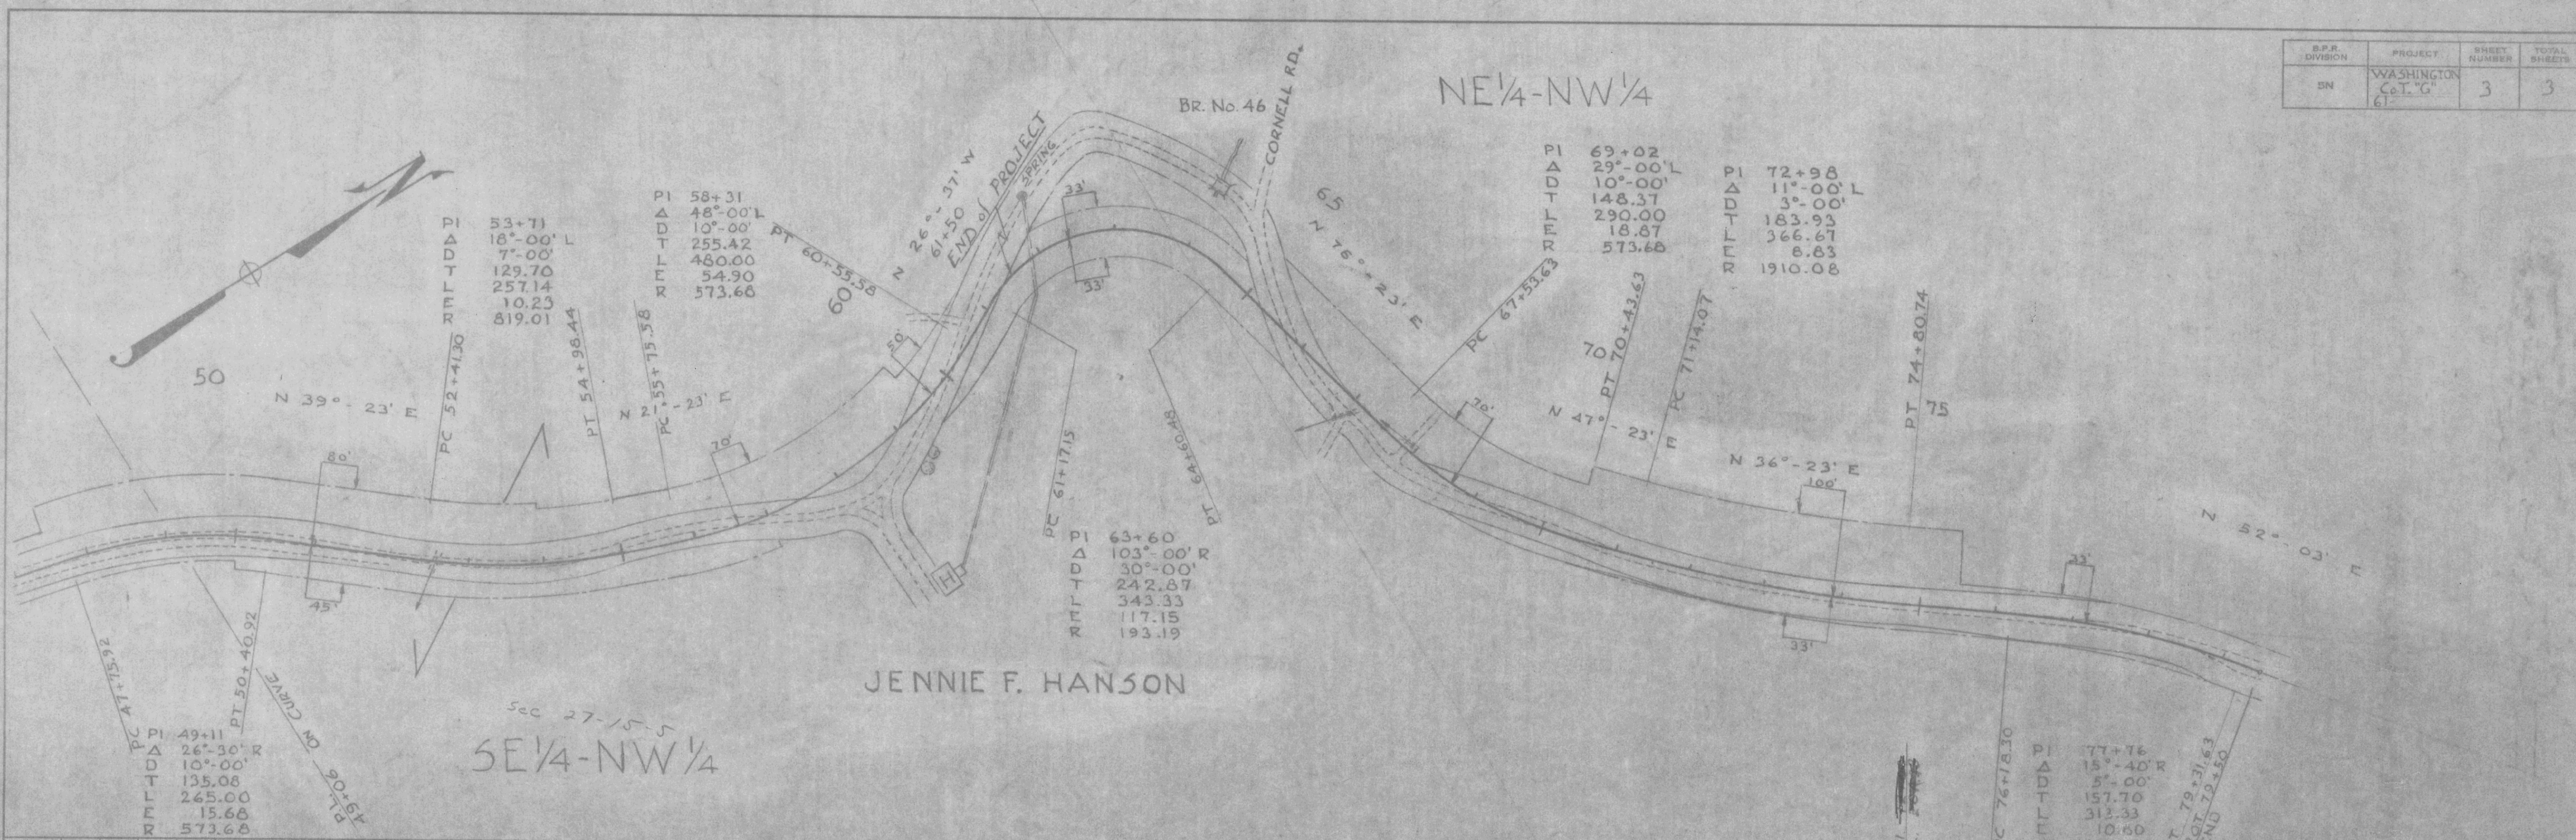

LA CROSSE COUNTY HIGHWAY DEPARTMENT

PLATE 1 - PLAN - PROFILE & V.C. TOWN WASHINGTON

CTH. "G" PLAN NO. 279