

DATE
9-11-68
C-1758

BY
REB
DHS

PROJECT
ALPHABETICALLY CHECKED
BY: DT. OF HIGHWAYS


PLAN
NOTE BOOK
NO. 180

DATE
9-11-68
C-1758


BY
REB
DHS

PROJECT
ALPHABETICALLY CHECKED
BY: DT. OF HIGHWAYS

PLAN
NOTE BOOK
NO. 173

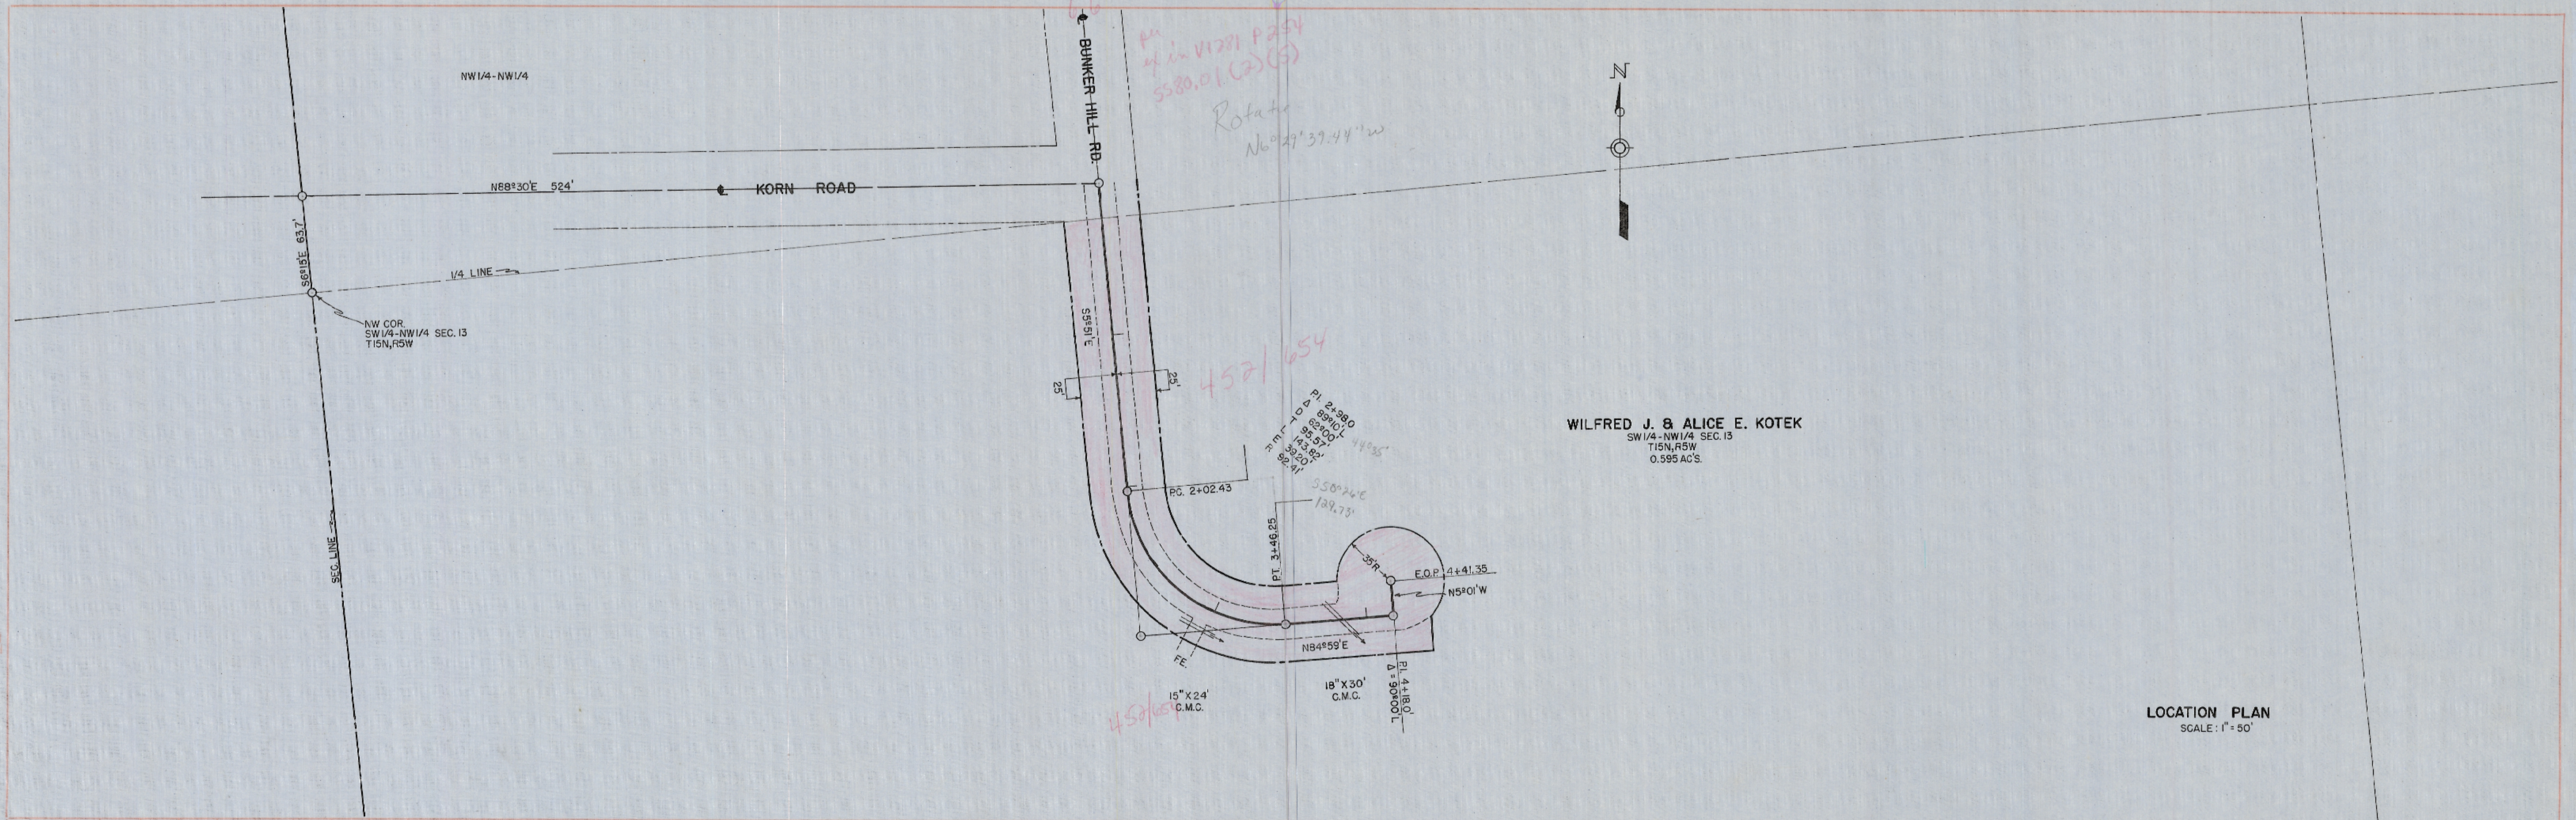

LOCATION PLAN
SCALE: 1" = 50'

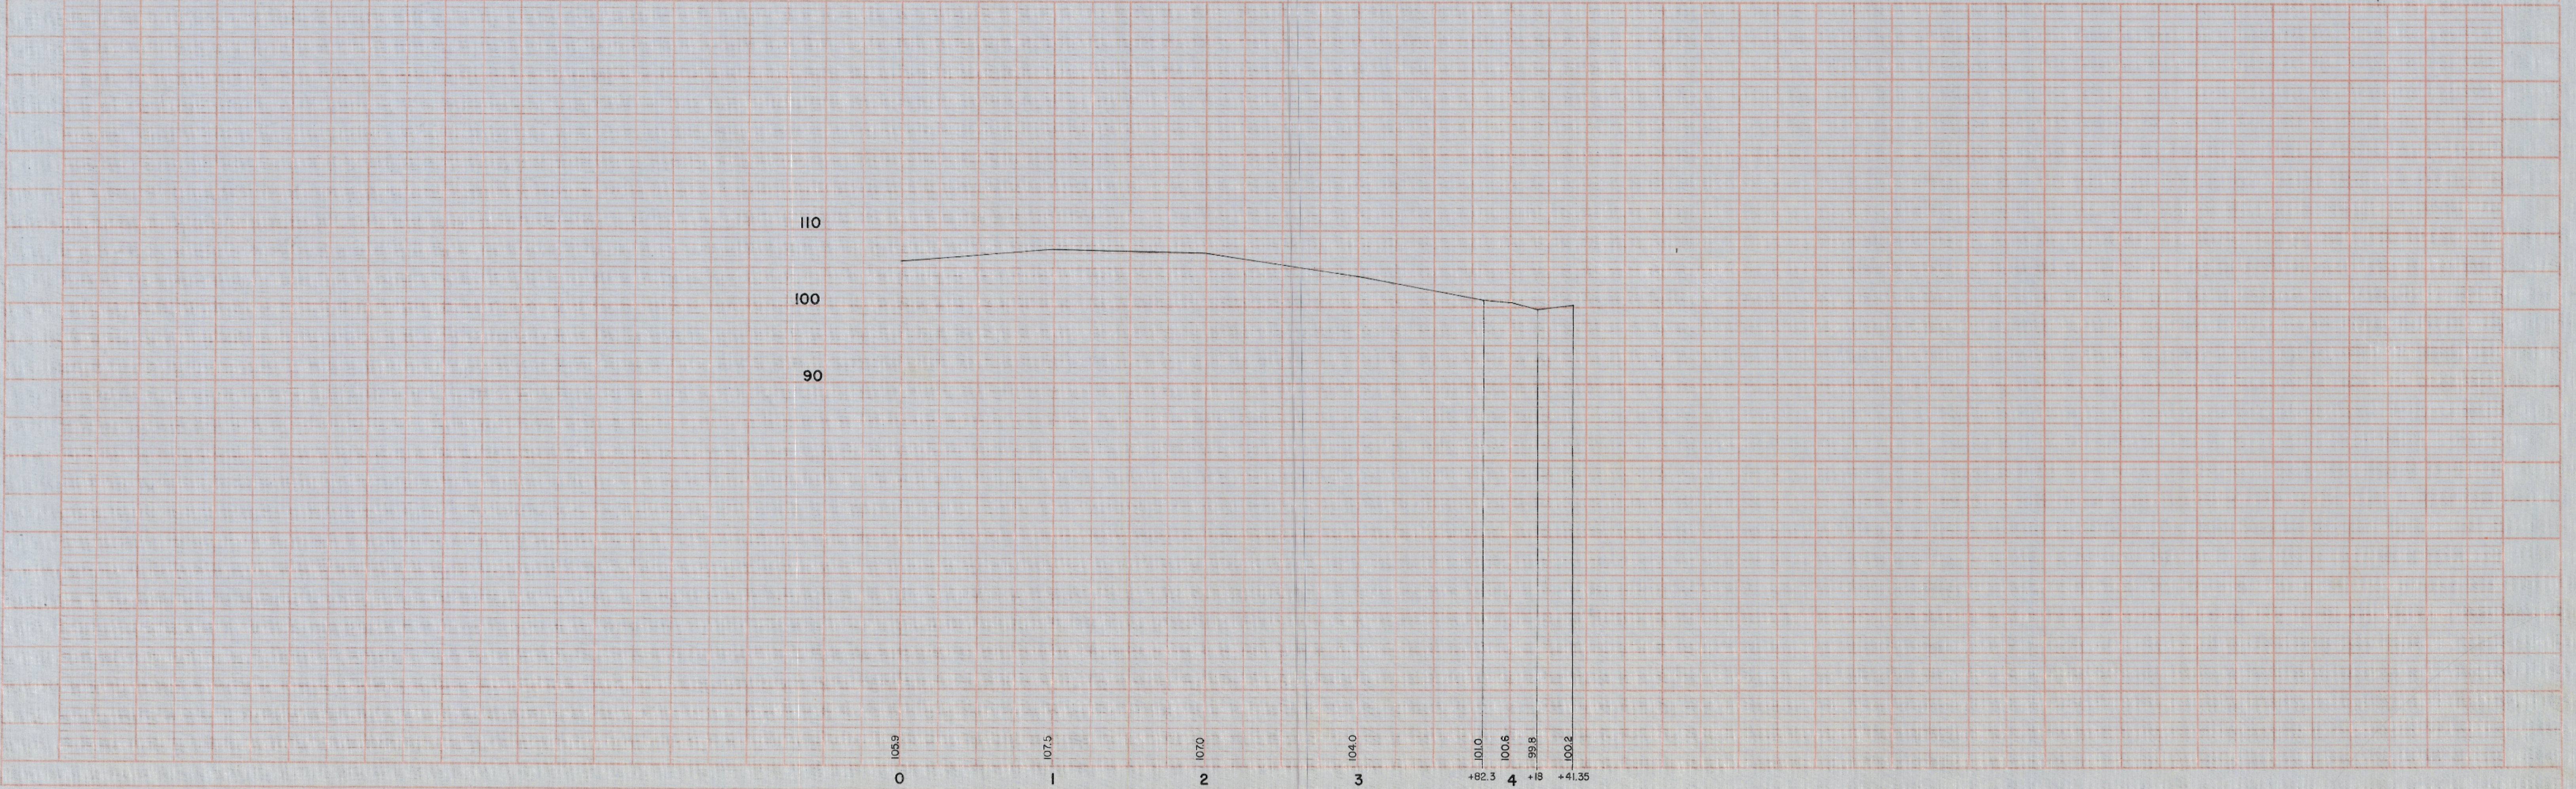

KOTEK ROAD

WASHINGTON

SHEET 1 OF 1

PLAN 424