


DATE: 6/19/73
 BY: R.F.B.
 L.E.H.
 PLAN
 NOTE BOOK, PLANS CHECKED
 BY: M.W. CHECKED
 NO. 6+2763

DATE: 6/19/73
 BY: R.F.B.
 L.E.H.
 PROFILE
 NOTE BOOK, PLANS CHECKED
 BY: M.W. CHECKED
 NO. 177

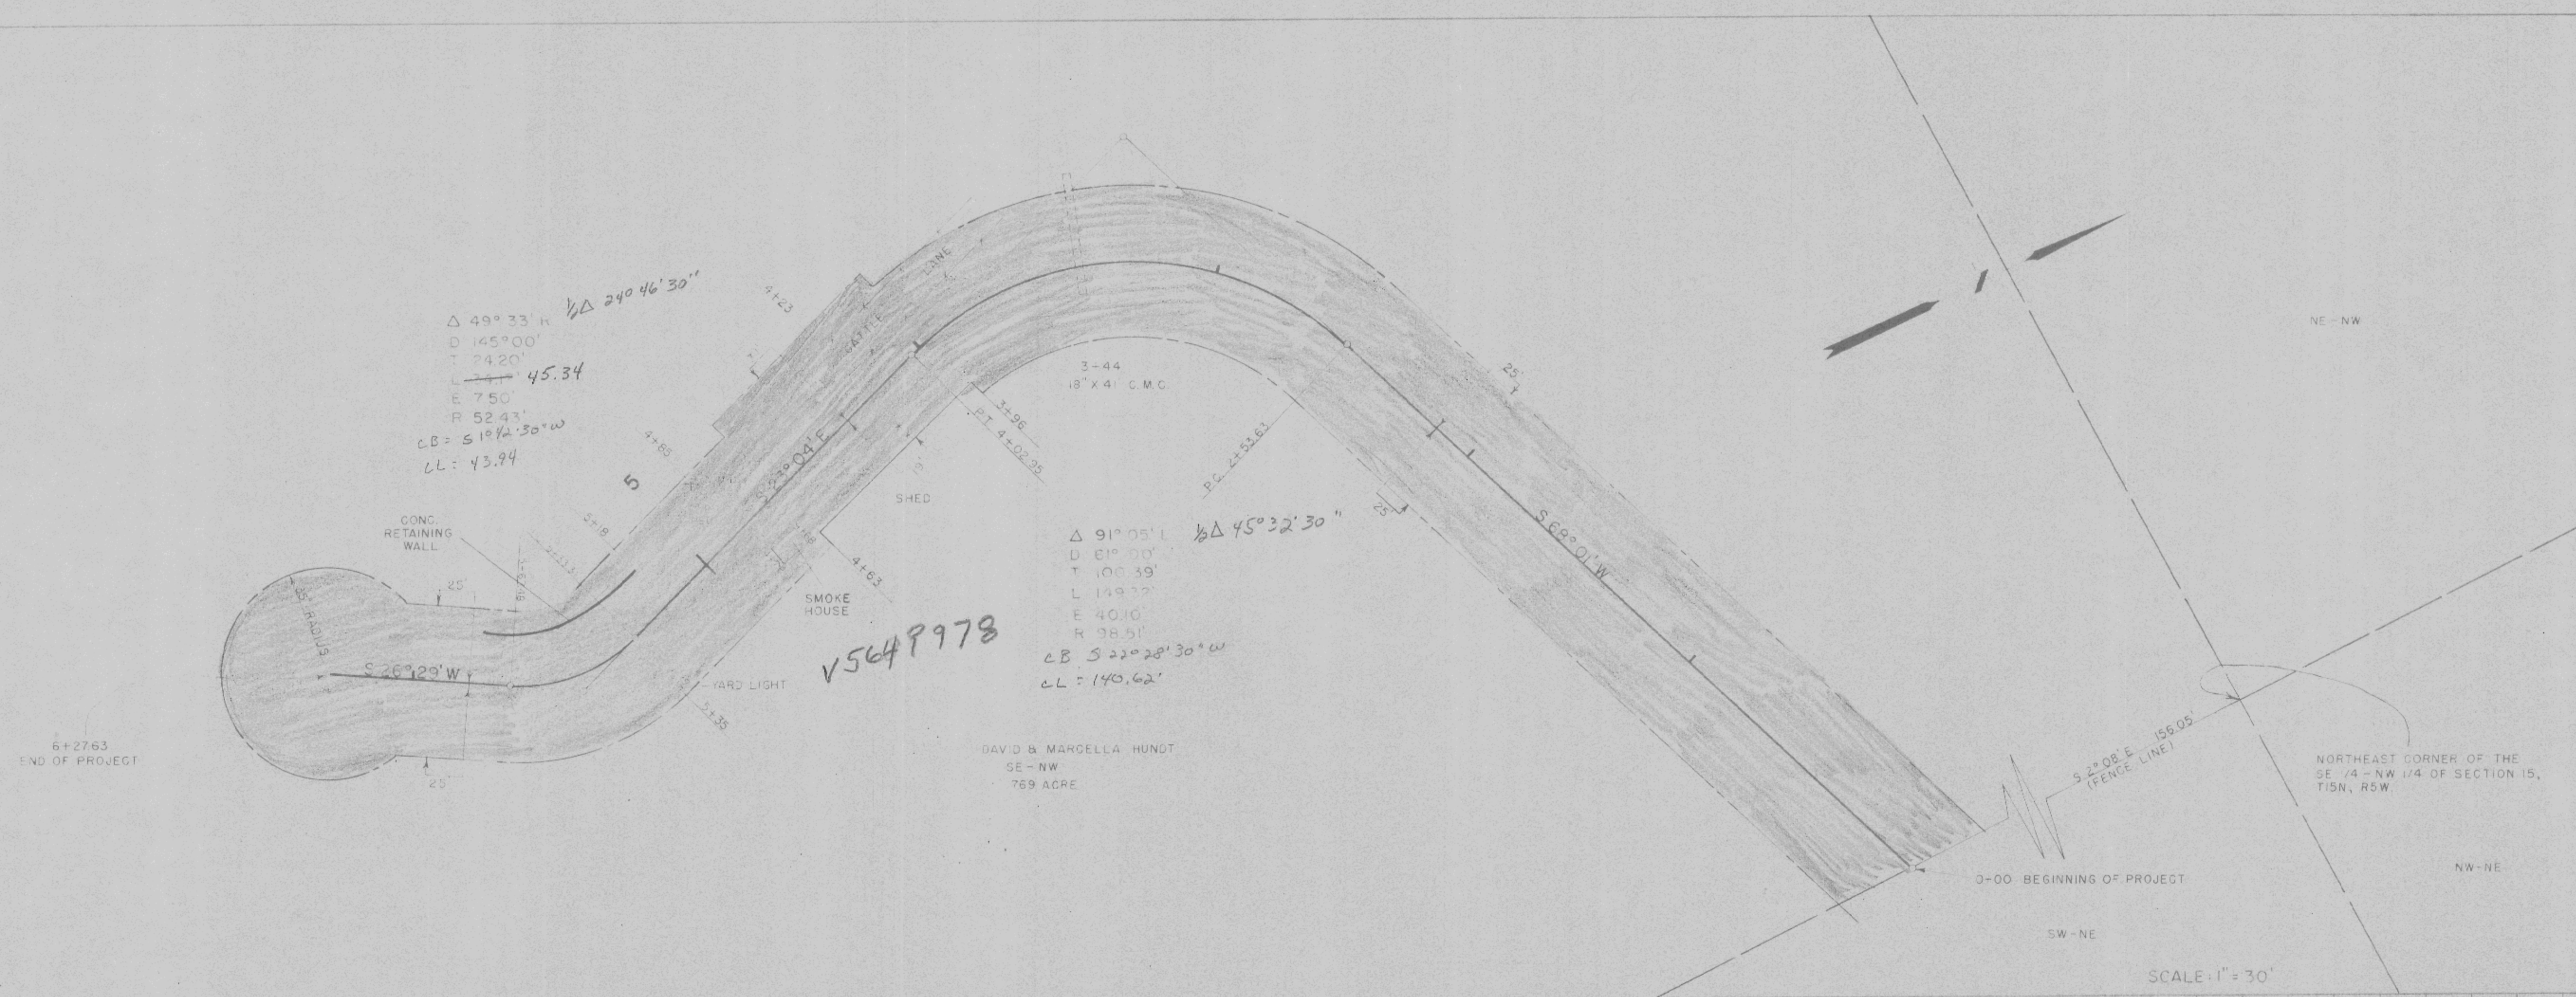

PLAN
 SURVEYED 6/19/75
 PLOTTED 6/25/75
 NOTE BOOK ALIGNMENT CHECKED
 No. 173
 R.E.B.
 L.E.H.

PROFILE
 SURVEYED 6/19/75
 PLOTTED 6/25/75
 NOTE BOOK GRADE CHECKED
 No. 173
 R.E.B.
 L.E.H.

