



# SCHEDULE OF LANDS & INTERESTS REQUIRED

PARCEL NUMBER	OWNER(S)	INTERESTS REQUIRED	FEE ACRES
1	BELINDA J. RADDE	FEE	0.10
	CENTURYLINK	RELEASE OF RIGHTS	
	XCEL ENERGY	RELEASE OF RIGHTS	

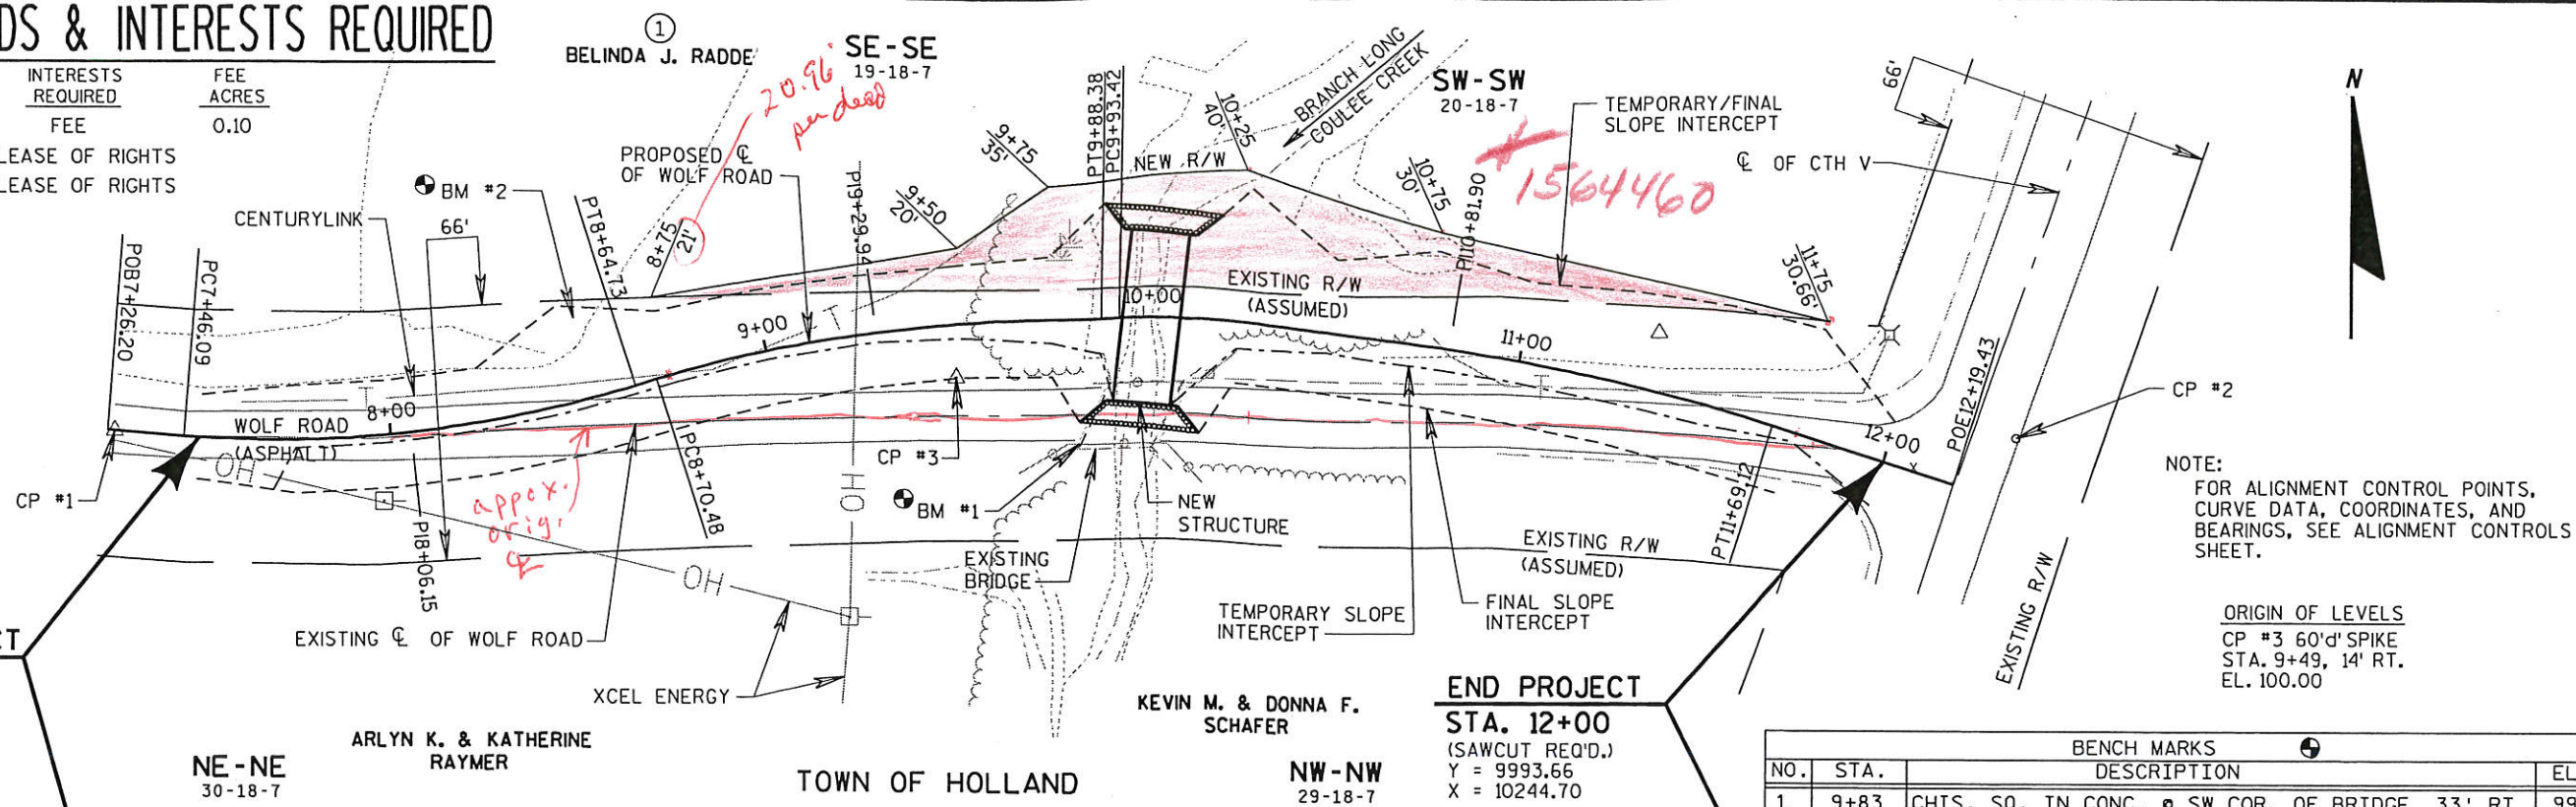

BENCH MARKS			
NO.	STA.	DESCRIPTION	ELEV.
1	9+83	CHIS. SQ. IN CONC. @ SW COR. OF BRIDGE, 33' RT.	99.66
2	8+54	SET RR SPK IN 10" TREE, 21' LT.	105.47

EARTHWORK SUMMARY	
STA. 7+50.00 TO STA. 12+00.00	L = 175'
EXC. COMMON	K = 23
FILL	
SHR. = 30%	
BORROW	

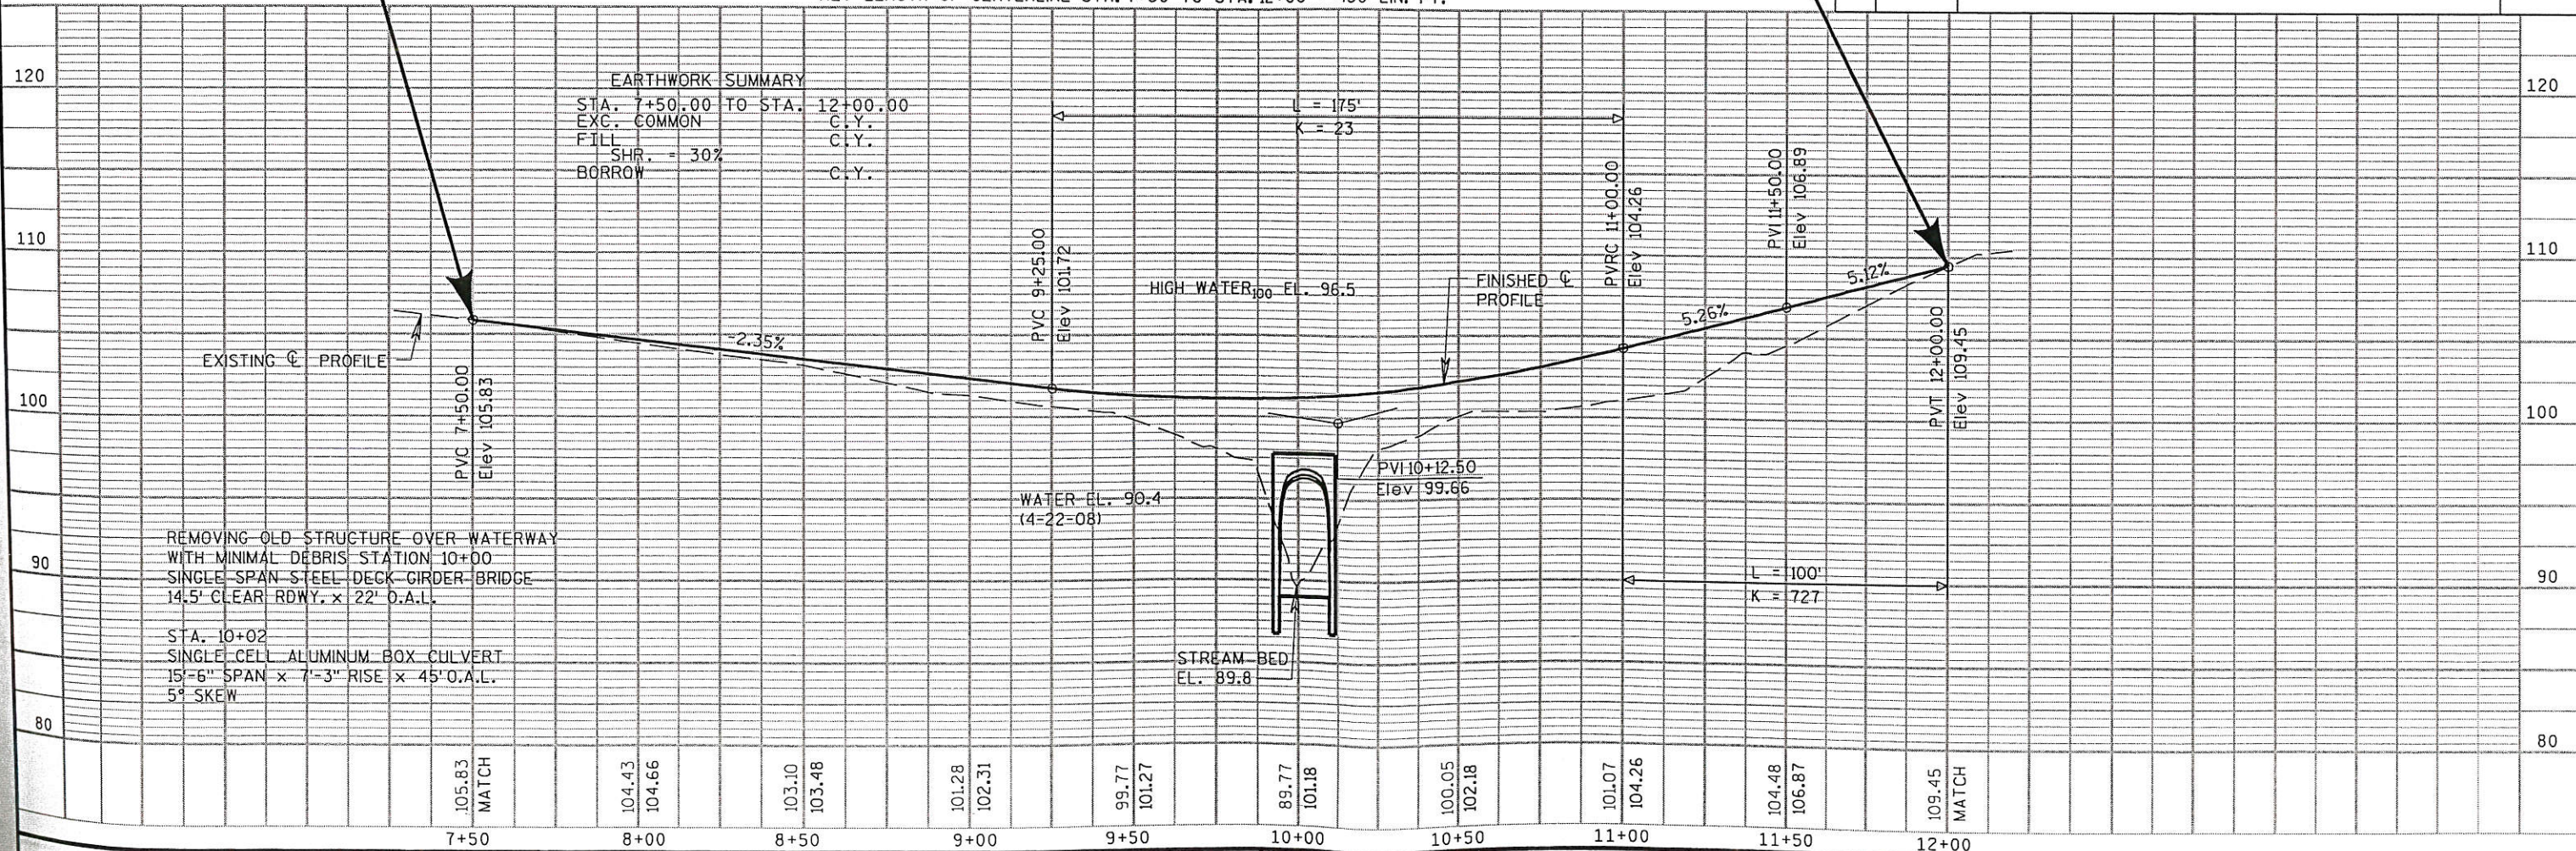

114