

TRANSPORTATION PROJECT PLAT NO: 7067-00-00-4.03

LOT 1 AND OUTLOT 1 OF HOPE ADDITION, LOT 1 OF LA CROSSE COUNTY C.S.M. V.5/P.131, DOC# 1091617, LOT 1 OF LA CROSSE COUNTY C.S.M. V.2/P.54, DOC# 927511, LOT 1 AND LOT 2 OF BEVERLY HILLS ADDITION AND PART OF THE SOUTHWEST QUARTER OF THE SOUTHEAST QUARTER OF SECTION 20, TOWNSHIP 17 NORTH, RANGE 7 WEST, TOWN OF ONALASKA AND THE VILLAGE OF HOLMEN, LA CROSSE COUNTY, WISCONSIN.

RELOCATION ORDER C.T.H. SN

(C.T.H. OF-ALPINE LANE)

TO PROPERLY ESTABLISH, LAY OUT, WIDEN, ENLARGE, EXTEND, CONSTRUCT, RECONSTRUCT, IMPROVE, OR MAINTAIN A PORTION OF THE HIGHWAY DESIGNATED ABOVE, LA CROSSE COUNTY HIGHWAY COMMITTEE DEEMS IT NECESSARY TO RELOCATE OR CHANGE SAID HIGHWAY AND ACQUIRE CERTAIN LANDS AND INTERESTS OR RIGHTS IN LANDS FOR THE ABOVE PROJECT.

TO EFFECT THIS CHANGE, PURSUANT TO AUTHORITY GRANTED UNDER SECTION 83.07 AND 83.08, WISCONSIN STATUTES, THE LA CROSSE COUNTY HIGHWAY COMMITTEE HEREBY ORDERS THAT:

1. THAT PORTION OF SAID HIGHWAY AS SHOWN ON THIS PLAT IS LAID OUT AND ESTABLISHED TO THE LINES AND WIDTHS AS SO SHOWN FOR THE ABOVE PROJECT.
2. THE LANDS OR INTERESTS OR RIGHTS IN LANDS AS SHOWN ON THIS PLAT ARE REQUIRED BY THE LA CROSSE COUNTY HIGHWAY COMMITTEE FOR THE ABOVE PROJECT AND SHALL BE ACQUIRED IN THE NAME OF LA CROSSE COUNTY, PURSUANT TO THE PROVISIONS OF SECTION 83.07 AND 83.08, WISCONSIN STATUTES.

FOR ADDITIONAL INFORMATION REFER TO THE TITLE SHEET, SHEET 2 OF 2 OF TRANSPORTATION PROJECT PLAT 7067-00-00. RECORDED AS DOCUMENT #1692141 AND FILED IN THE OFFICE OF THE REGISTER OF DEEDS IN LA CROSSE COUNTY.


POINT NO.	S/T	COURSE	NORTH	EAST	COORDINATE
207	175+96.26	11.00°	171351.79	448995.27	
217	175+92.35	39.00°	171350.53	449078.53	
218	175+94.12	44.87°	171351.18	449055.95	
301	177+17.28	24.50°	171358.36	448908.25	
302	178+33.42	24.54°	171373.22	448883.93	
307	185+38.19	47.27°	171463.95	448530.83	
308	175+58.19	41.07°	171355.18	449055.95	
309	175+54.49	44.00°	171351.36	448964.35	
310	177+16.38	39.00°	171362.56	448918.96	
311	177+54.08	43.85°	171359.94	448898.71	
312	177+74.60	43.65°	171367.74	448890.72	
313	178+35.26	51.04°	171370.01	448859.07	
314	181+31.11	30.09°	171409.06	448799.23	
315	182+104.11	50.14°	171506.72	448708.55	
316	182+14.05	49.33°	171407.86	448704.55	
317	182+58.82	49.00°	171391.44	448695.04	
318	183+63.87	49.00°	171421.44	448643.83	
319	184+89.49	57.40°	171523.94	448534.61	
320	186+82.56	51.75°	171467.10	448381.07	
321	189+46.58	45.44°	171478.46	448402.03	
322	190+30.00	61.35°	171481.14	448365.53	
323	189+84.82	32.42°	171480.87	448359.94	
324	189+17.97	44.50°	171479.80	448317.74	
325	189+10.21	41.07°	171475.64	448307.42	
326	189+00.66	34.37°	171478.15	448304.92	
327	189+50.00	44.00°	171355.39	448311.56	
328	175+50.00	39.00°	171356.04	448366.12	

POINT NO.	NORTH	EAST	DESCRIPTION	

POINT NO.	BEARING	DISTANCE


PARCEL NUMBER	OWNER	INTEREST REQUIRED	R/W ACRES REQUIRED NEW	R/W ACRES REQUIRED EXISTING	TOTAL	PLE ACRES	TLE ACRES
9	CHONG HENG YANG AND TONG LOR YANG	FEE & TLE	0.08	---	0.08	---	0.08
10	HABITAT FOR HUMANITY, LA CROSSE AREA, INC.	FEE & TLE	0.001	---	0.001	---	0.001
11	DAVID M. PAUDLER AND DAVID J. RITTER	FEE & TLE	0.13	---	0.13	---	0.09
12	SCHOOL DISTRICT OF HOLMEN	FEE & TLE	0.11	---	0.11	---	0.12
13	WISCONSIN DISTRICT OF THE WESLEYAN CHURCH	FEE & TLE	0.13	---	0.13	---	0.12
14	THARREN L. APPELTON AND TRACY L. APPELTON	FEE	0.02	0.05	0.10	---	---
15	ARCHIE ACHTERKIRCH AND PRISCILLA ACHTERKIRCH	FEE & TLE	0.24	0.16	0.40	---	0.17
16	JAMES P. SCHANK AND CAROL SCHANK	TLE	---	---	---	---	0.04
17	MICHAELA A. MCDOWELL AND SUSAN A. MCDOWELL	FEE & TLE	0.002	---	0.002	---	0.01
19	GEORGE H. SCHMIDT AND PATRICK D. SCHMIDT	FEE & TLE	0.04	0.04	0.08	---	0.07

OWNER	RECORDING INFORMATION	PARCEL(S)
VILLAGE OF HOLMEN	UTILITY EASEMENT V.1301/P.802	9
NORTHERN STATES POWER COMPANY (NSP)-dba XCEL ENERGY, INC.	UTILITY EASEMENT V.920/P.237	9, 10
NORTHERN STATES POWER COMPANY (NSP)-dba XCEL ENERGY, INC.	UTILITY EASEMENT V.912/P.227	11, 12
NORTHERN STATES POWER COMPANY (NSP)-dba XCEL ENERGY, INC.	UTILITY EASEMENT V.909/P.984	13
VILLAGE OF HOLMEN	UTILITY EASEMENT V.901/P.863	13 - 15
NORTHERN STATES POWER COMPANY (NSP)-dba XCEL ENERGY, INC.	UTILITY EASEMENT V.903/P.986	15
NORTHERN STATES POWER COMPANY (NSP)-dba XCEL ENERGY, INC.	UTILITY EASEMENT V.910/P.283	19

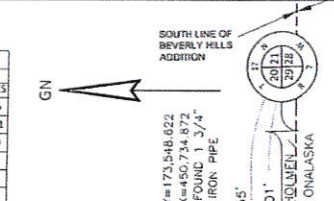


UTILITY NUMBER	OWNER	INTEREST REQUIRED
91	XCEL ENERGY, INC.	RELEASE OF RIGHTS
92	CENTURYLINK	RELEASE OF RIGHTS
93	RIVERLAND ENERGY COOPERATIVE	RELEASE OF RIGHTS
94	VILLAGE OF HOLMEN	RELEASE OF RIGHTS

RESERVED FOR REGISTER OF DEEDS
PROJECT NUMBER 7067-00-00-4.03

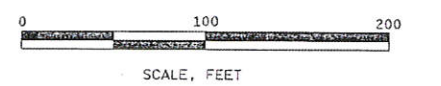

4

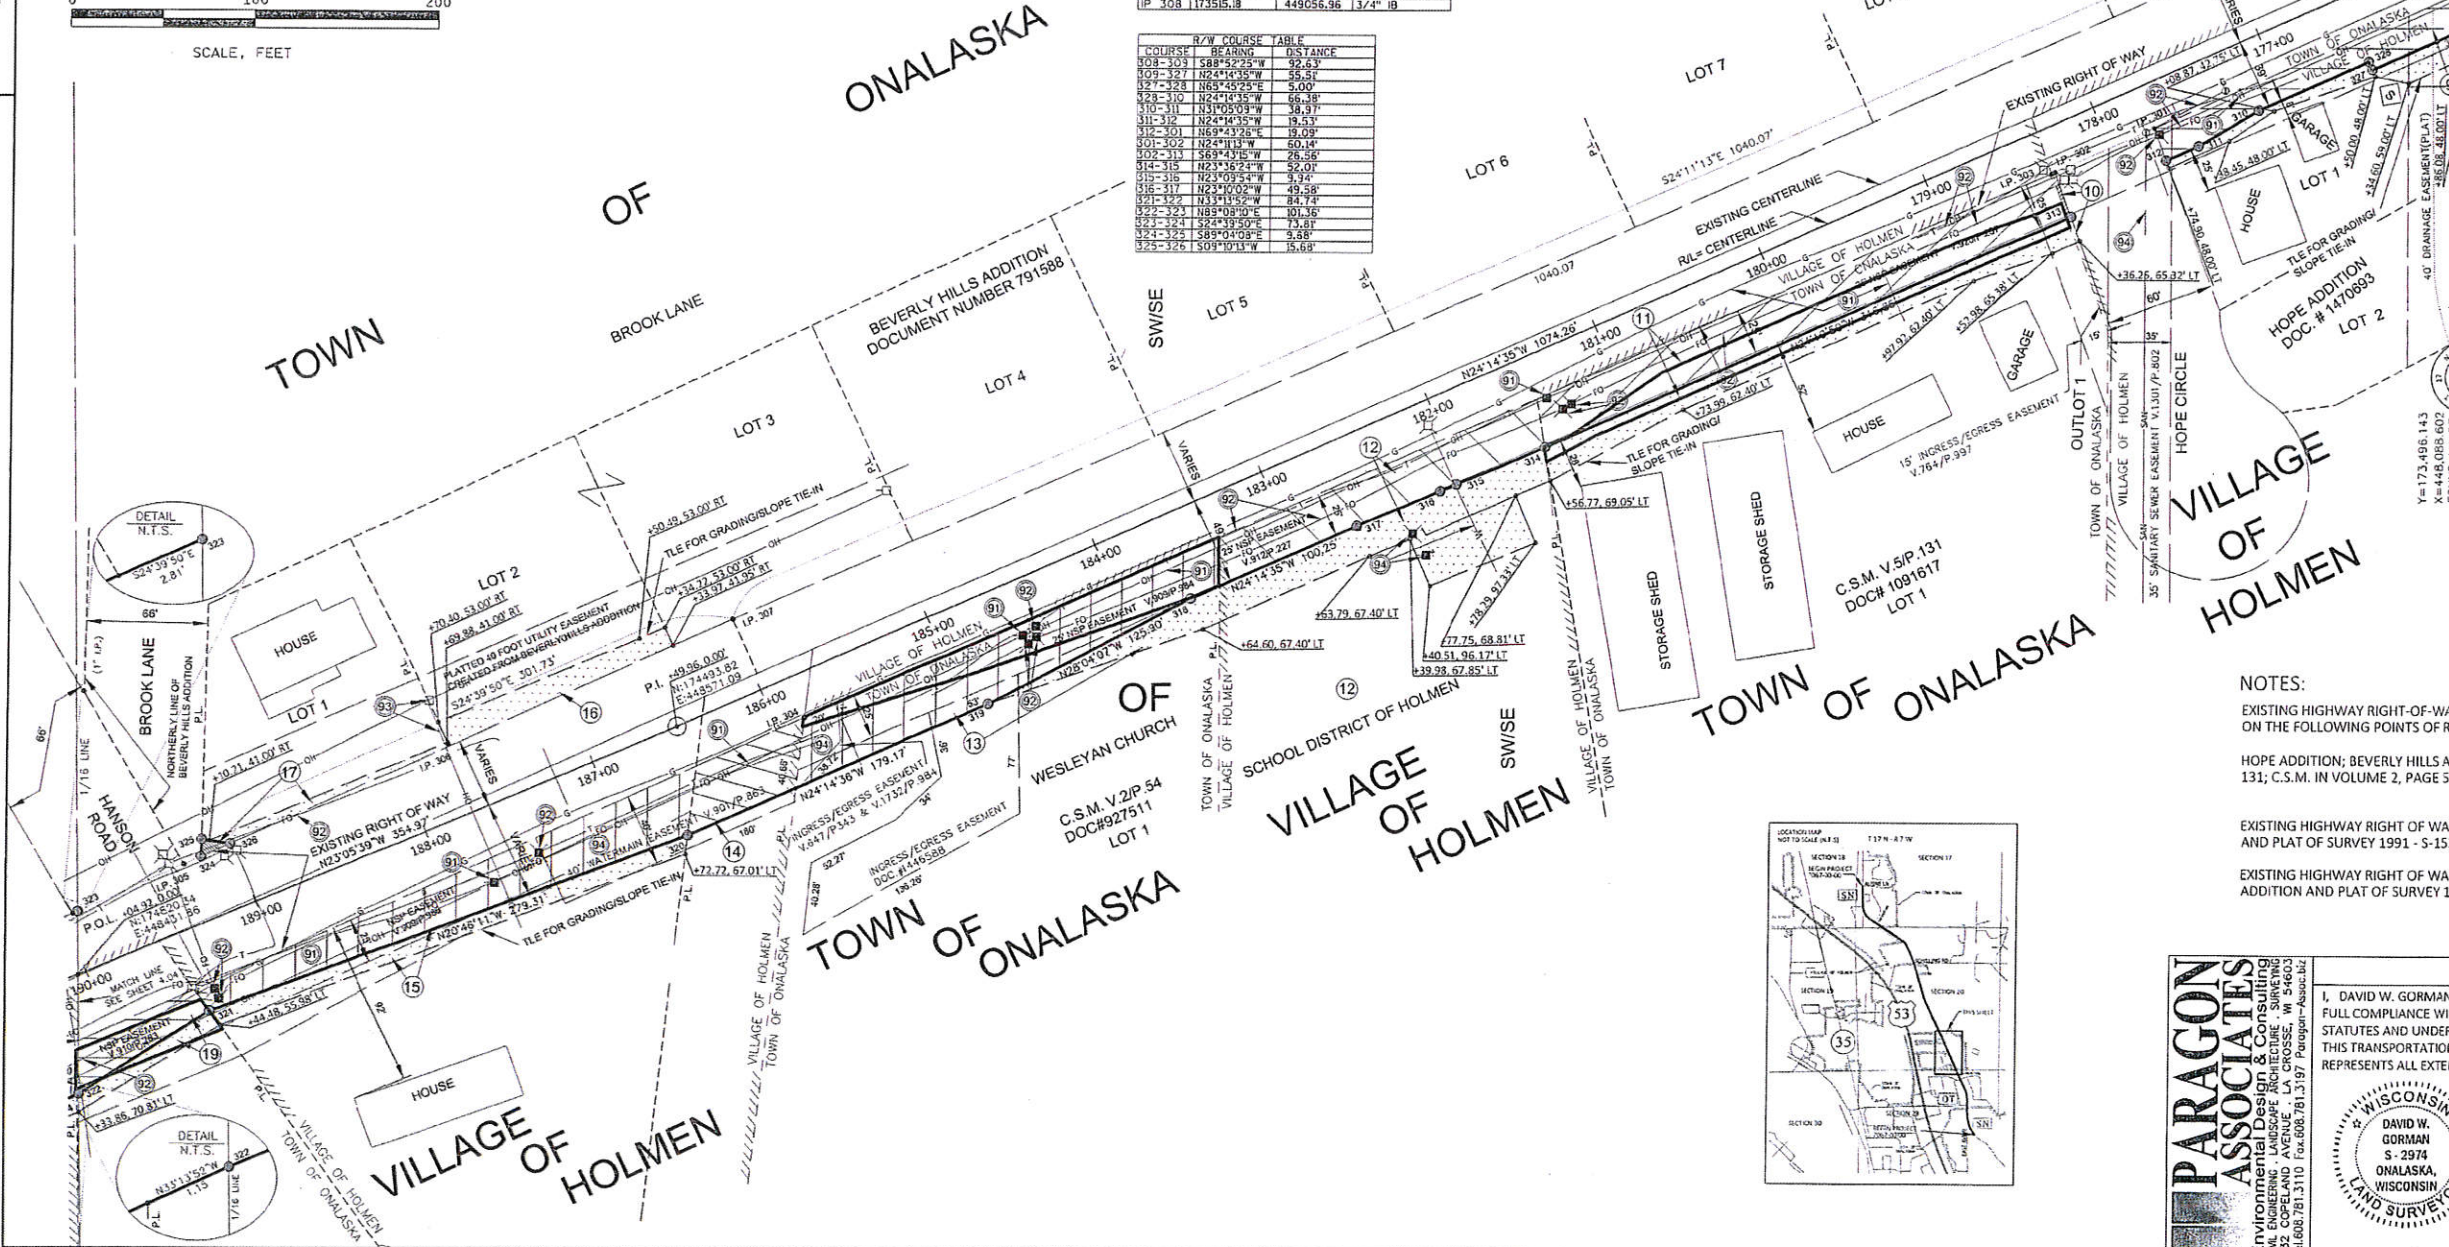

NOTES:
EXISTING HIGHWAY RIGHT-OF-WAY FOR COUNTY TRUNK HIGHWAY SN SHOWN HEREIN IS BASED ON THE FOLLOWING POINTS OF REFERENCE:
HOPE ADDITION; BEVERLY HILLS ADDITION; CERTIFIED SURVEY MAP (C.S.M.) IN VOLUME 5, PAGE 131; C.S.M. IN VOLUME 2, PAGE 54 AND ORDER OF HIGHWAY IN VOLUME 161, PAGE 232.
EXISTING HIGHWAY RIGHT OF WAY FOR BROOK LANE ESTABLISHED FROM BEVERLY HILLS ADDITION AND PLAT OF SURVEY 1991 - S-1533.
EXISTING HIGHWAY RIGHT OF WAY FOR HANSON ROAD ESTABLISHED FROM BEVERLY HILLS ADDITION AND PLAT OF SURVEY 1991 - S-1533.

201

1692356
LACROSSE COUNTY REGISTER OF DEEDS
CHERYL A. MCBRIDE
RECORDED ON 04/26/2017 08:32AM
PLAT FEE: \$25.00
VOLUME: TPP CAB PAGE: 78A
PAGE 1

PARAGON ASSOCIATES
ENVIRONMENTAL DESIGN & CONSTRUCTION
332 COPPELAND AVENUE, LA CROSSE, WI 54603
TEL: 608/781.3110 FAX: 608/781.3197 Paragon-Associates.biz

I, DAVID W. GORMAN, PROFESSIONAL LAND SURVEYOR, HEREBY CERTIFY THAT IN FULL COMPLIANCE WITH THE PROVISIONS OF SECTION 84.095 OF THE WISCONSIN STATUTES AND UNDER THE DIRECTION OF LA CROSSE COUNTY, I HAVE MAPPED THIS TRANSPORTATION PROJECT PLAT AND SUCH PLAT CORRECTLY REPRESENTS ALL EXTERIOR BOUNDARIES OF THE SURVEYED LAND.

SIGNATURE: _____ DATE: 4-25-2017
PRINT NAME: DAVID W. GORMAN
REGISTRATION NUMBER: PLS-2974
THIS PLAT AND RELOCATION ORDER ARE APPROVED FOR
LA CROSSE COUNTY HIGHWAY COMMITTEE
SIGNATURE: _____ DATE: 4/26/17
PRINT NAME: Title of Commissioner

AMD 1

TRANSPORTATION PROJECT PLAT NO: 7067-00-00-4.03-AMENDMENT NO. 1 AMENDS PARCEL NO: 9,10,11,12,13,14,15,16,17,18 AND 19 OF TRANSPORTATION PROJECT PLAT 7067-00-00-4.03, RECORDED AS DOCUMENT NO:1692356, TPP CAB PAGE: 78A

LOT 1 AND OUTLOT 1 OF HOPE ADDITION, LOT 1 OF LA CROSSE COUNTY C.S.M. V.5/P.131, DOC# 1091617, LOT 1 OF LA CROSSE COUNTY C.S.M. V.2/P.54, DOC# 927511, LOT 1 AND LOT 2 OF BEVERLY HILLS ADDITION AND PART OF THE SOUTHWEST QUARTER OF THE SOUTHEAST QUARTER OF SECTION 20, TOWNSHIP 17 NORTH, RANGE 7 WEST, TOWN OF ONALASKA AND THE VILLAGE OF HOLMEN, LA CROSSE COUNTY, WISCONSIN.

RELOCATION ORDER C.T.H. SN (C.T.H. OT-ALPINE LANE)

TO PROPERLY ESTABLISH, LAY OUT, WIDEN, ENLARGE, EXTEND, CONSTRUCT, RECONSTRUCT, IMPROVE, OR MAINTAIN A PORTION OF THE HIGHWAY DESIGNATED ABOVE, LA CROSSE COUNTY HIGHWAY COMMITTEE DEEMS IT NECESSARY TO RELOCATE OR CHANGE SAID HIGHWAY AND ACQUIRE CERTAIN LANDS AND INTERESTS OR RIGHTS IN LANDS FOR THE ABOVE PROJECT.

TO EFFECT THIS CHANGE, PURSUANT TO AUTHORITY GRANTED UNDER SECTION 83.07 AND 83.08, WISCONSIN STATUTES, THE LA CROSSE COUNTY HIGHWAY COMMITTEE HEREBY ORDERS THAT:

- THAT PORTION OF SAID HIGHWAY AS SHOWN ON THIS PLAT IS LAID OUT AND ESTABLISHED TO THE LINES AND WIDTHS AS SO SHOWN FOR THE ABOVE PROJECT.
- THE LANDS OR INTERESTS OR RIGHTS IN LANDS AS SHOWN ON THIS PLAT ARE REQUIRED BY THE LA CROSSE COUNTY HIGHWAY COMMITTEE FOR THE ABOVE PROJECT AND SHALL BE ACQUIRED IN THE NAME OF LA CROSSE COUNTY, PURSUANT TO THE PROVISIONS OF SECTION 83.07 AND 83.08, WISCONSIN STATUTES.

FOR ADDITIONAL INFORMATION REFER TO THE TITLE SHEET, SHEET 2 OF 2 OF TRANSPORTATION PROJECT PLAT 7067-00-00-4.01, RECORDED AS DOCUMENT #1692141 AND FILED IN THE OFFICE OF THE REGISTER OF DEEDS IN LA CROSSE COUNTY.

COORDINATE TABLE - R/W

POINT NO.	STATION	OFFSET	NORTH	EAST
207	175+86.28	33.00	117451.79	448985.27
231	175+22.35	39.00	117359.83	449079.53
238	175+58.12	41.87	117355.18	449055.36
301	177+73.29	24.50	117388.36	448908.63
302	178+34.72	24.50	117421.54	448884.90
313	178+35.28	54.00	117421.01	448893.07
308	175+58.12	41.87	117355.18	449055.36
309	175+94.49	44.00	117353.36	448964.35
310	177+73.29	24.50	117388.36	448908.63
312	177+73.50	44.00	117387.74	448890.72
314	177+73.50	50.79	117406.72	448708.26
315	182+04.11	50.79	117406.72	448708.26
318	182+04.05	49.31	117407.86	448704.58
317	182+04.52	49.50	117421.44	448685.64
318	183+63.87	49.00	117422.84	448643.88
319	184+89.49	57.40	117432.34	448584.64
320	186+67.50	27.10	117487.30	448501.07
321	189+46.58	46.14	117478.36	448412.03
322	190+30.00	81.35	117483.34	448365.59
323	191+16.64	52.89	117493.31	448318.84
324	189+17.87	34.50	117453.80	448397.74
325	189+10.21	41.00	117453.84	448502.42
326	189+10.68	34.91	117438.15	448504.52
327	175+50.00	44.00	117353.38	448941.56
328	175+50.00	39.00	117355.04	448946.72

EXISTING MONUMENTS

POINT	TY	NORTHING	EASTING	DESCRIPTION
IP 207	17351.79	448985.27	3/4" IR	
IP 230	17355.18	449055.36	3/4" IR	
IP 238	17355.18	448955.37	3/4" IR	
IP 301	17388.36	448908.63	1" O.D. PIPE	
IP 302	17421.54	448884.90	1" O.D. PIPE	
IP 313	17421.01	448893.07	1" O.D. PIPE	
IP 308	17355.18	449055.36	3/4" IR	
IP 309	17353.36	448964.35	3/4" IR	
IP 310	17388.36	448908.63	3/4" IR	
IP 312	17387.74	448890.72	3/4" IR	
IP 314	17406.72	448708.26	3/4" IR	
IP 315	17406.72	448708.26	3/4" IR	
IP 318	17407.86	448704.58	3/4" IR	
IP 317	17421.44	448685.64	3/4" IR	
IP 318	17422.84	448643.88	3/4" IR	
IP 319	17432.34	448584.64	3/4" IR	
IP 320	17487.30	448501.07	3/4" IR	
IP 321	17478.36	448412.03	3/4" IR	
IP 322	17483.34	448365.59	3/4" IR	
IP 323	17493.31	448318.84	3/4" IR	
IP 324	17453.80	448397.74	3/4" IR	
IP 325	17453.84	448502.42	3/4" IR	
IP 326	17438.15	448504.52	3/4" IR	
IP 327	17353.38	448941.56	3/4" IR	
IP 328	17355.04	448946.72	3/4" IR	

R/W COURSE TABLE


COURSE	BEARING	DISTANCE
103-109	S89°42'30"W	24.24
109-127	N24°14'35"W	55.57
127-128	S89°42'30"W	50.00
128-130	N24°14'35"W	66.38
130-311	N31°03'09"W	38.37
311-312	N24°14'35"W	19.53
312-301	S89°42'30"W	24.24
001-302	N24°14'35"W	60.14
302-313	S89°42'30"W	26.56
014-315	S2°11'02"W	32.01
315-317	N23°10'02"W	49.58
317-322	S13°11'02"W	84.38
322-323	S89°08'10"E	101.30
323-324	S24°33'50"E	71.97
324-325	S89°08'10"E	101.30
325-326	S09°07'11"W	15.89

SCHEDULE OF LANDS AND INTERESTS REQUIRED

PARCEL NUMBER	OWNER	INTEREST REQUIRED	R/W ACRES REQUIRED		TOTAL ACRES
			NEW	EXISTING	
9	CHONG NENG YANG AND TONG LOR YANG	FEE & TLE	0.08	0.08	0.05
10	HABITAT FOR HUMANITY, LA CROSSE AREA, INC.	FEE & TLE	0.001	0.001	0.001
11	DAVID M. PAUDLER AND DAVID J. RITTER	FEE & TLE	0.19	0.19	0.09
12	SCHOOL DISTRICT OF HOLMEN	FEE & TLE	0.11	0.11	0.12
13	WISCONSIN DISTRICT OF THE WESLEYAN CHURCH	FEE & TLE	0.18	0.18	0.12
14	THARREN L. APPLETON AND TRACY L. APPLETON	FEE	0.05	0.05	0.10
15	ARCHIE ACHTERMIRCH AND PRISCILLA ACHTERMIRCH	FEE & TLE	0.24	0.16	0.40
16	JAMES P. SCHANK AND CAROL SCHANK	TLE	---	---	0.04
17	MICHAEL A. MCDOWELL AND SUSAN A. MCDOWELL	FEE & TLE	0.002	0.002	0.01
19	GEORGE H. SCHMIDT AND PATRICIA D. SCHMIDT	FEE & TLE	0.04	0.04	0.02


EASEMENT TABLE

OWNER	RECORDING INFORMATION	PARCEL(S)
VILLAGE OF HOLMEN	UTILITY EASEMENT V.1301/P.802	9
NORTHERN STATES POWER COMPANY (NSP)-dba XCEL ENERGY, INC.	UTILITY EASEMENT V.9301/P.237	9, 10
NORTHERN STATES POWER COMPANY (NSP)-dba XCEL ENERGY, INC.	UTILITY EASEMENT V.912/P.227	11, 12
NORTHERN STATES POWER COMPANY (NSP)-dba XCEL ENERGY, INC.	UTILITY EASEMENT V.909/P.984	13
VILLAGE OF HOLMEN	UTILITY EASEMENT V.901/P.863	13, 15
NORTHERN STATES POWER COMPANY (NSP)-dba XCEL ENERGY, INC.	UTILITY EASEMENT V.909/P.986	15
NORTHERN STATES POWER COMPANY (NSP)-dba XCEL ENERGY, INC.	UTILITY EASEMENT V.910/P.283	19

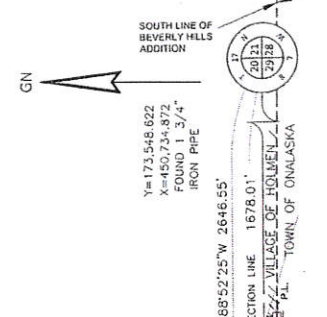

UTILITY INTEREST REQUIRED

UTILITY NUMBER	OWNER	INTEREST REQUIRED
91	XCEL ENERGY, INC.	RELEASE OF RIGHTS
92	CENTURYLINK	RELEASE OF RIGHTS
93	RIVERLAND ENERGY COOPERATIVE	RELEASE OF RIGHTS
94	VILLAGE OF HOLMEN	RELEASE OF RIGHTS

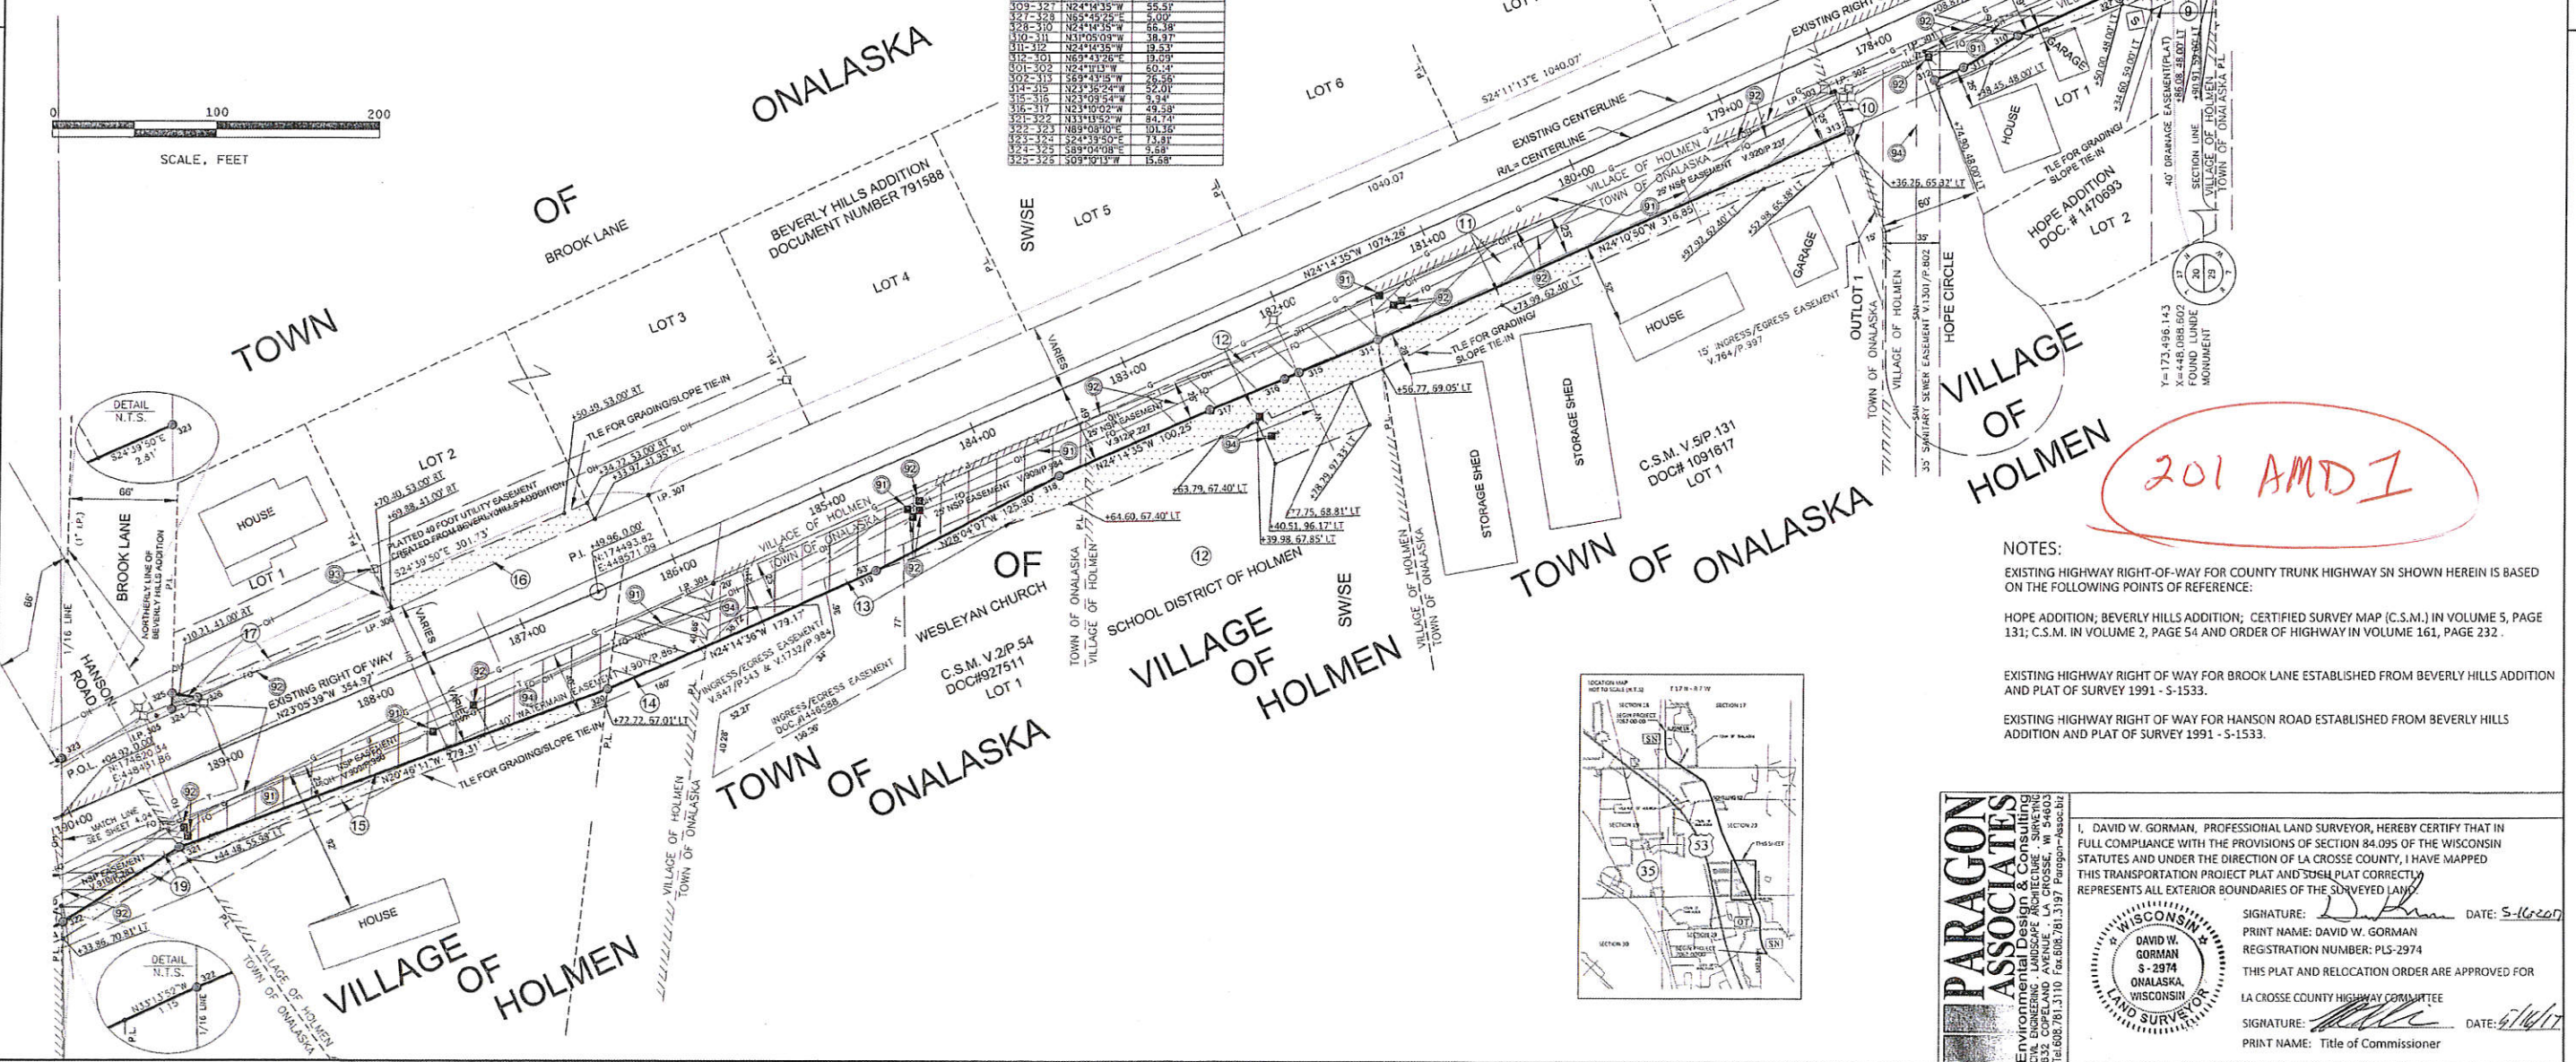

NOTES:
 EXISTING HIGHWAY RIGHT-OF-WAY FOR COUNTY TRUNK HIGHWAY SN SHOWN HEREIN IS BASED ON THE FOLLOWING POINTS OF REFERENCE:
 HOPE ADDITION; BEVERLY HILLS ADDITION; CERTIFIED SURVEY MAP (C.S.M.) IN VOLUME 5, PAGE 131; C.S.M. IN VOLUME 2, PAGE 54 AND ORDER OF HIGHWAY IN VOLUME 161, PAGE 232.
 EXISTING HIGHWAY RIGHT OF WAY FOR BROOK LANE ESTABLISHED FROM BEVERLY HILLS ADDITION AND PLAT OF SURVEY 1991 - S-1533.
 EXISTING HIGHWAY RIGHT OF WAY FOR HANSON ROAD ESTABLISHED FROM BEVERLY HILLS ADDITION AND PLAT OF SURVEY 1991 - S-1533.

PARAGON ASSOCIATES
 Environmental Design & Consulting
 CIVIL ENGINEERING, LANDSCAPE ARCHITECTURE, SURVEYING
 632 COPELAND AVENUE, LA CROSSE, WI 54603
 TEL: 608.781.1310 FAX: 608.781.1319 Paragon-associates.com

I, DAVID W. GORMAN, PROFESSIONAL LAND SURVEYOR, HEREBY CERTIFY THAT IN FULL COMPLIANCE WITH THE PROVISIONS OF SECTION 84.095 OF THE WISCONSIN STATUTES AND UNDER THE DIRECTION OF LA CROSSE COUNTY, I HAVE MAPPED THIS TRANSPORTATION PROJECT PLAT AND SDH PLAT CORRECTLY REPRESENTS ALL EXTERIOR BOUNDARIES OF THE SURVEYED LAND.

SIGNATURE: *David W. Gorman* DATE: 5/16/2017
 PRINT NAME: DAVID W. GORMAN
 REGISTRATION NUMBER: PLS-2974
 THIS PLAT AND RELOCATION ORDER ARE APPROVED FOR
 LA CROSSE COUNTY HIGHWAY COMMITTEE
 SIGNATURE: *[Signature]* DATE: 5/16/17
 PRINT NAME: Title of Commissioner


TRANSPORTATION PROJECT PLAT NO: 7067-00-00-4.03-AMENDMENT NO. 2
AMENDS PARCEL NO: 10,11,12,13,14 AND 16 OF TRANSPORTATION PROJECT
PLAT 7067-00-00-4.03, RECORDED AS DOCUMENT NO:1693534, TPP CAB
PAGE: 81A

LOT 1 AND OUTLOT 1 OF HOPE ADDITION, LOT 1 OF LA CROSSE COUNTY C.S.M. V.5/P.131, DOC# 1091617, LOT 1 OF LA CROSSE COUNTY C.S.M. V.2/P.54, DOC# 927511, LOT 1 AND LOT 2 OF BEVERLY HILLS ADDITION AND PART OF THE SOUTHWEST QUARTER OF THE SOUTHEAST QUARTER OF SECTION 20, TOWNSHIP 17 NORTH, RANGE 7 WEST, TOWN OF ONALASKA AND THE VILLAGE OF HOLMEN, LA CROSSE COUNTY, WISCONSIN.

RELOCATION ORDER C.T.H. SN

(C.T.H. OT-ALPINE LANE)

TO PROPERLY ESTABLISH, LAY OUT, WIDEN, ENLARGE, EXTEND, CONSTRUCT, RECONSTRUCT, IMPROVE, OR MAINTAIN A PORTION OF THE HIGHWAY DESIGNATED ABOVE, LA CROSSE COUNTY HIGHWAY COMMITTEE DEEMS IT NECESSARY TO RELOCATE OR CHANGE SAID HIGHWAY AND ACQUIRE CERTAIN LANDS AND INTERESTS OR RIGHTS IN LANDS FOR THE ABOVE PROJECT.

TO EFFECT THIS CHANGE, PURSUANT TO AUTHORITY GRANTED UNDER SECTION 33.07 AND 83.08, WISCONSIN STATUTES, THE LA CROSSE COUNTY HIGHWAY COMMITTEE HEREBY ORDERS THAT:

1. THAT PORTION OF SAID HIGHWAY AS SHOWN ON THIS PLAT IS LAID OUT AND ESTABLISHED TO THE LINES AND WIDTHS AS SO SHOWN FOR THE ABOVE PROJECT.
2. THE LANDS OR INTERESTS OR RIGHTS IN LANDS AS SHOWN ON THIS PLAT ARE REQUIRED BY THE LA CROSSE COUNTY HIGHWAY COMMITTEE FOR THE ABOVE PROJECT AND SHALL BE ACQUIRED IN THE NAME OF LA CROSSE COUNTY, PURSUANT TO THE PROVISIONS OF SECTION 83.07 AND 83.08, WISCONSIN STATUTES.

FOR ADDITIONAL INFORMATION REFER TO THE TITLE SHEET, SHEET 2 OF 2 OF TRANSPORTATION PROJECT PLAT 7067-00-00-4.01, RECORDED AS DOCUMENT #1692141 AND FILED IN THE OFFICE OF THE REGISTER OF DEEDS IN LA CROSSE COUNTY.


POINT NO.	STATION	OFFSET	NORTH	EAST
PARCEL NUMBER	OWNER/OWNER	INTEREST	R/W ACRES REQUIRED	NEW	EXISTING	TOTAL	P/E	T/E
9	CHONG NENG YANG AND TONG LOR YANG	FEE & T/E	0.08	---	0.08	---	---	0.08
10	HABITAT FOR HUMANITY, LA CROSSE AREA, INC.	FEE	0.04	---	0.04	---	---	0.04
11	DAVID M. PAUDLER AND DAVID J. RITTER	FEE & T/E	0.19	---	0.19	---	---	0.19
12	SCHOOL DISTRICT OF HOLMEN	FEE & T/E	0.12	---	0.12	---	---	0.12
13	WISCONSIN DISTRICT OF THE WESLEYAN CHURCH	FEE & T/E	0.18	---	0.18	---	---	0.18
14	THARREN L. APLETON AND TRACY L. APLETON	FEE & T/E	0.05	0.05	0.10	---	---	0.10
15	ARCHIE ACHTERGIRCH AND FRISILLA ACHTERGIRCH	FEE & T/E	0.24	0.16	0.40	---	---	0.40
16	JAMES P. SCHANK AND CAROL SCHANK	FEE & T/E	0.03	---	0.03	---	---	0.03
17	MICHAEL A. MCDOWELL AND SUSAN A. MCDOWELL	FEE & T/E	0.002	---	0.002	---	---	0.002
19	GEORGE H. SCHMIDT AND PATRICIA D. SCHMIDT	FEE & T/E	0.04	0.04	0.08	---	---	0.08

OWNER	RECORDING INFORMATION	PARCEL(S)
VILLAGE OF HOLMEN	UTILITY EASEMENT V.1301/P.202	9
NORTHERN STATES POWER COMPANY (NSP)-dba XCEL ENERGY, INC.	UTILITY EASEMENT V.920/P.237	9, 10
NORTHERN STATES POWER COMPANY (NSP)-dba XCEL ENERGY, INC.	UTILITY EASEMENT V.912/P.227	11, 12
NORTHERN STATES POWER COMPANY (NSP)-dba XCEL ENERGY, INC.	UTILITY EASEMENT V.909/P.284	13
VILLAGE OF HOLMEN	UTILITY EASEMENT V.901/P.263	13-15
NORTHERN STATES POWER COMPANY (NSP)-dba XCEL ENERGY, INC.	UTILITY EASEMENT V.909/P.286	15
NORTHERN STATES POWER COMPANY (NSP)-dba XCEL ENERGY, INC.	UTILITY EASEMENT V.910/P.233	19

R/W COURSE	TABLE	OFFSET	DISTANCE

POINT	TY	(NORTHING)	X (EASTING)	DESCRIPTION

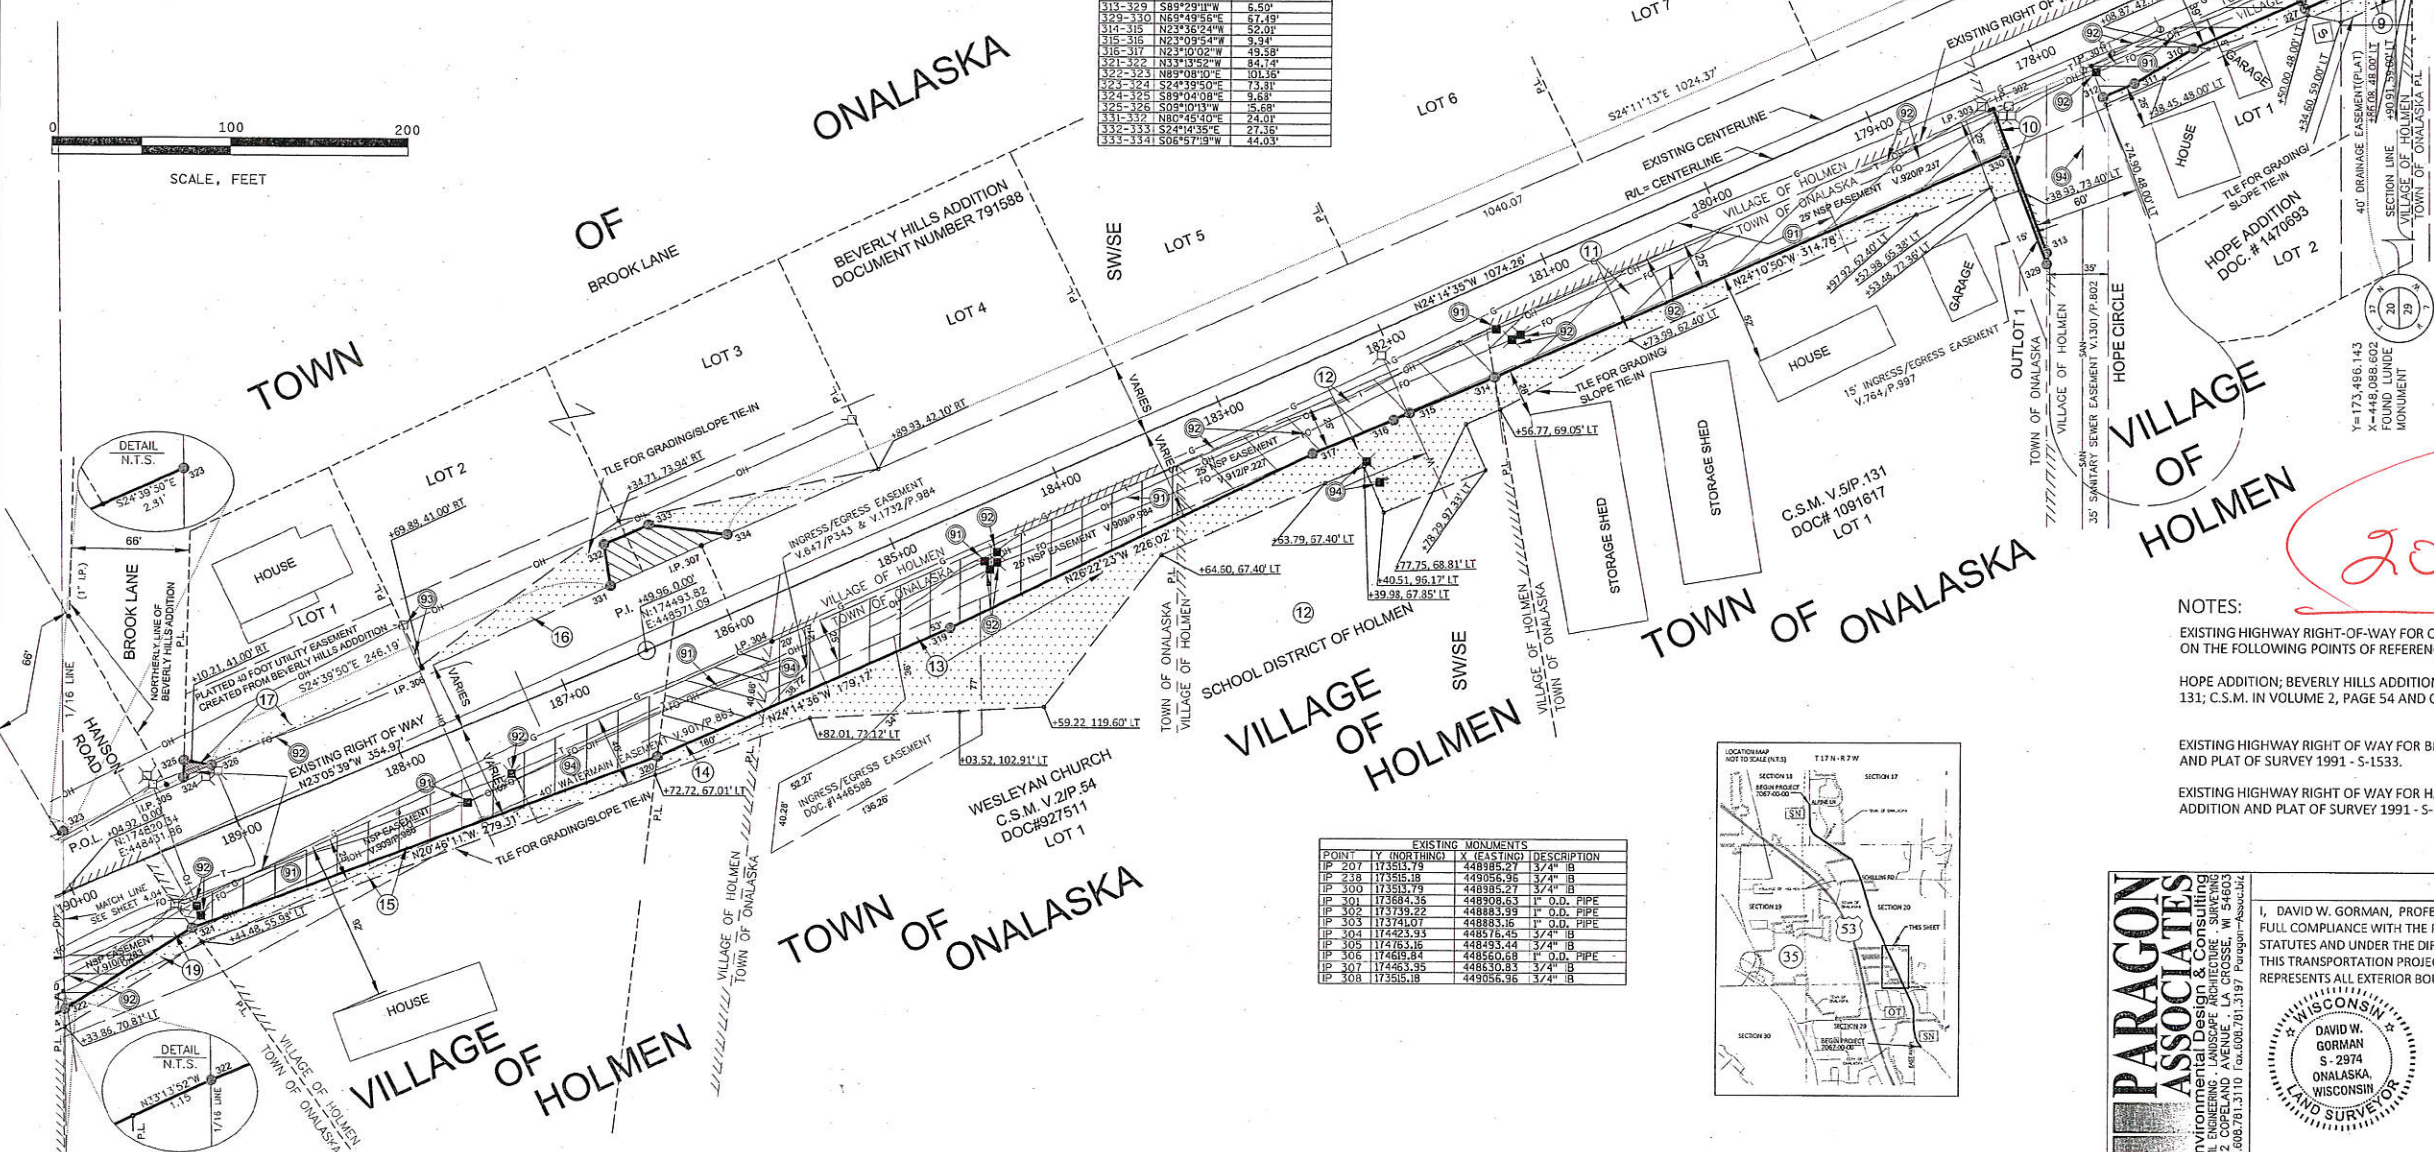

UTILITY NUMBER	OWNER	INTEREST REQUIRED
91	XCEL ENERGY, INC.	RELEASE OF RIGHTS
92	CENTURYLINK	RELEASE OF RIGHTS
93	RIVERLAND ENERGY COOPERATIVE	RELEASE OF RIGHTS
94	VILLAGE OF HOLMEN	RELEASE OF RIGHTS

NOTES:
 EXISTING HIGHWAY RIGHT-OF-WAY FOR COUNTY TRUNK HIGHWAY SN SHOWN HEREIN IS BASED ON THE FOLLOWING POINTS OF REFERENCE:
 HOPE ADDITION; BEVERLY HILLS ADDITION; CERTIFIED SURVEY MAP (C.S.M.) IN VOLUME 5, PAGE 131; C.S.M. IN VOLUME 2, PAGE 54 AND ORDER OF HIGHWAY IN VOLUME 161, PAGE 232.
 EXISTING HIGHWAY RIGHT OF WAY FOR BROOK LANE ESTABLISHED FROM BEVERLY HILLS ADDITION AND PLAT OF SURVEY 1991 - S-1533.
 EXISTING HIGHWAY RIGHT OF WAY FOR HANSON ROAD ESTABLISHED FROM BEVERLY HILLS ADDITION AND PLAT OF SURVEY 1991 - S-1533.

PARAGON ASSOCIATES
 Environmental Design & Consulting
 632 COPELAND AVENUE, LA CROSSE, WI 54601
 TEL: 608.781.3110 FAX: 608.781.3197 Paragon-Associates.biz

I, DAVID W. GORMAN, PROFESSIONAL LAND SURVEYOR, HEREBY CERTIFY THAT IN FULL COMPLIANCE WITH THE PROVISIONS OF SECTION 84.095 OF THE WISCONSIN STATUTES AND UNDER THE DIRECTION OF LA CROSSE COUNTY, I HAVE MAPPED THIS TRANSPORTATION PROJECT PLAT AND SUCH PLAT CORRECTLY REPRESENTS ALL EXTERIOR BOUNDARIES OF THE SURVEYED LAND.

SIGNATURE: *[Signature]* DATE: 8/21/2017
 PRINT NAME: DAVID W. GORMAN
 REGISTRATION NUMBER: PLS-2974
 THIS PLAT AND RELOCATION ORDER ARE APPROVED FOR
 LA CROSSE COUNTY HIGHWAY COMMITTEE
 SIGNATURE: *[Signature]* DATE: 8/21/17
 PRINT NAME: Title of Commissioner

201 AMD # 2

TRANSPORTATION PROJECT PLAT NO: 7067-00-00-4.03-AMENDMENT NO. 3
AMENDS PARCEL NO: 10 OF TRANSPORTATION PROJECT PLAT
7067-00-00-4.03, RECORDED AS DOCUMENT NO:1698420, TPP CAB PAGE:
82A

LOT 1 AND OUTLOT 1 OF HOPE ADDITION, LOT 1 OF LA CROSSE COUNTY C.S.M. V.5/P.131, DOC# 1091617, LOT 1 OF LA CROSSE COUNTY C.S.M. V.2/P.54, DOC# 927511, LOT 1 AND LOT 2 OF BEVERLY HILLS ADDITION AND PART OF THE SOUTHWEST QUARTER OF THE SOUTHEAST QUARTER OF SECTION 20, TOWNSHIP 17 NORTH, RANGE 7 WEST, TOWN OF ONALASKA AND THE VILLAGE OF HOLMEN, LA CROSSE COUNTY, WISCONSIN.

RELOCATION ORDER C.T.H. SN

(C.T.H. OT-ALPINE LANE)

TO PROPERLY ESTABLISH, LAY OUT, WIDEN, ENLARGE, EXTEND, CONSTRUCT, RECONSTRUCT, IMPROVE, OR MAINTAIN A PORTION OF THE HIGHWAY DESIGNATED ABOUT, LA CROSSE COUNTY HIGHWAY COMMITTEE DEEMS IT NECESSARY TO RELOCATE OR CHANGE SAID HIGHWAY AND ACQUIRE CERTAIN LANDS AND INTERESTS OR RIGHTS IN LANDS FOR THE ABOVE PROJECT.

TO EFFECT THIS CHANGE, PURSUANT TO AUTHORITY GRANTED UNDER SECTION 83.07 AND 83.08, WISCONSIN STATUTES, THE LA CROSSE COUNTY HIGHWAY COMMITTEE HEREBY ORDERS THAT:

- THAT PORTION OF SAID HIGHWAY AS SHOWN ON THIS PLAT IS LAID OUT AND ESTABLISHED TO THE LINES AND WIDTHS AS SO SHOWN FOR THE ABOVE PROJECT.
- THE LANDS OR INTERESTS OR RIGHTS IN LANDS AS SHOWN ON THIS PLAT ARE REQUIRED BY THE LA CROSSE COUNTY HIGHWAY COMMITTEE FOR THE ABOVE PROJECT AND SHALL BE ACQUIRED IN THE NAME OF LA CROSSE COUNTY, PURSUANT TO THE PROVISIONS OF SECTION 83.07 AND 83.08, WISCONSIN STATUTES.

FOR ADDITIONAL INFORMATION REFER TO THE TITLE SHEET, SHEET 2 OF 2 OF TRANSPORTATION PROJECT PLAT 7067-00-00-4.01, RECORDED AS DOCUMENT #1692141 AND FILED IN THE OFFICE OF THE REGISTER OF DEEDS IN LA CROSSE COUNTY.


POINT NO.	STATION	COORDINATE	NORTH	EAST
207	175+86.28	33.00	173511.79	448985.27
237	175+92.35	39.00	173508.53	449079.53
238	175+98.42	45.00	173505.27	449173.79
501	177+73.28	24.50	173584.35	448908.53
302	178+31.42	24.50	173392.22	448883.99
307	185+98.19	42.21	174563.95	448994.34
309	175+94.48	44.00	173511.79	448984.35

R/W COURSE	BEARING	DISTANCE
308-309	S88°52'25"W	92.53'
309-310	N24°14'35"W	55.31'

PARCEL NUMBER	OWNER/OWNER	INTEREST REQUIRED		R/W ACRES REQUIRED			PLE	TLE
		NEW	EXISTING	TOTAL	ACRES	ACRES		
9	CHONG NENG YANG AND TONG LOR YANG	FEE & TLE	0.08	—	0.08	—	—	0.05
10	HABITAT FOR HUMANITY, LA CROSSE AREA, INC.	FEE	0.012	—	0.012	—	—	—
11	DAVID M. PAUDLER AND DAVID L. RITTER	FEE & TLE	0.19	—	0.19	—	—	0.09
12	SCHOOL DISTRICT OF HOLMEN	FEE & TLE	0.12	—	0.12	—	—	0.12
13	WISCONSIN DISTRICT OF THE WESLEYAN CHURCH	FEE & TLE	0.18	—	0.18	—	—	0.21
14	THARREN L. APPLETON AND TRACY L. APPLETON	FEE & TLE	0.05	0.05	0.10	—	—	0.02
15	ARCHIE ACHTERIRCH AND PRISCILLA ACHTERIRCH	FEE & TLE	0.24	0.16	0.40	—	—	0.17
16	JAMES P. SCHANK AND CAROL SCHANK	FEE & TLE	0.03	—	0.03	—	—	0.08
17	MICHAEL A. MCDOWELL AND SUSAN A. MCDOWELL	FEE & TLE	0.002	—	0.002	—	—	0.01
19	GEORGE H. SCHMIDT AND PATRICIA D. SCHMIDT	FEE & TLE	0.04	0.04	0.08	—	—	0.02

OWNER	RECORDING INFORMATION		PARCEL(S)
	UTILITY EASEMENT	PARCEL(S)	
VILLAGE OF HOLMEN	UTILITY EASEMENT V.1301/P.802	9	9
NORTHERN STATES POWER COMPANY (NSP)-dba XCEL ENERGY, INC.	UTILITY EASEMENT V.910/P.237	9, 10	9, 10
NORTHERN STATES POWER COMPANY (NSP)-dba XCEL ENERGY, INC.	UTILITY EASEMENT V.912/P.227	11, 12	11, 12
NORTHERN STATES POWER COMPANY (NSP)-dba XCEL ENERGY, INC.	UTILITY EASEMENT V.909/P.984	13	13
VILLAGE OF HOLMEN	UTILITY EASEMENT V.901/P.863	13 - 15	13 - 15
NORTHERN STATES POWER COMPANY (NSP)-dba XCEL ENERGY, INC.	UTILITY EASEMENT V.909/P.986	15	15
NORTHERN STATES POWER COMPANY (NSP)-dba XCEL ENERGY, INC.	UTILITY EASEMENT V.910/P.283	19	19

CURVE	RIGHT-OF-WAY CURVE TABLE			
	R	L	LCB	LCH
336-337	55.00'	28.63'	574°23'51"W	28.16'

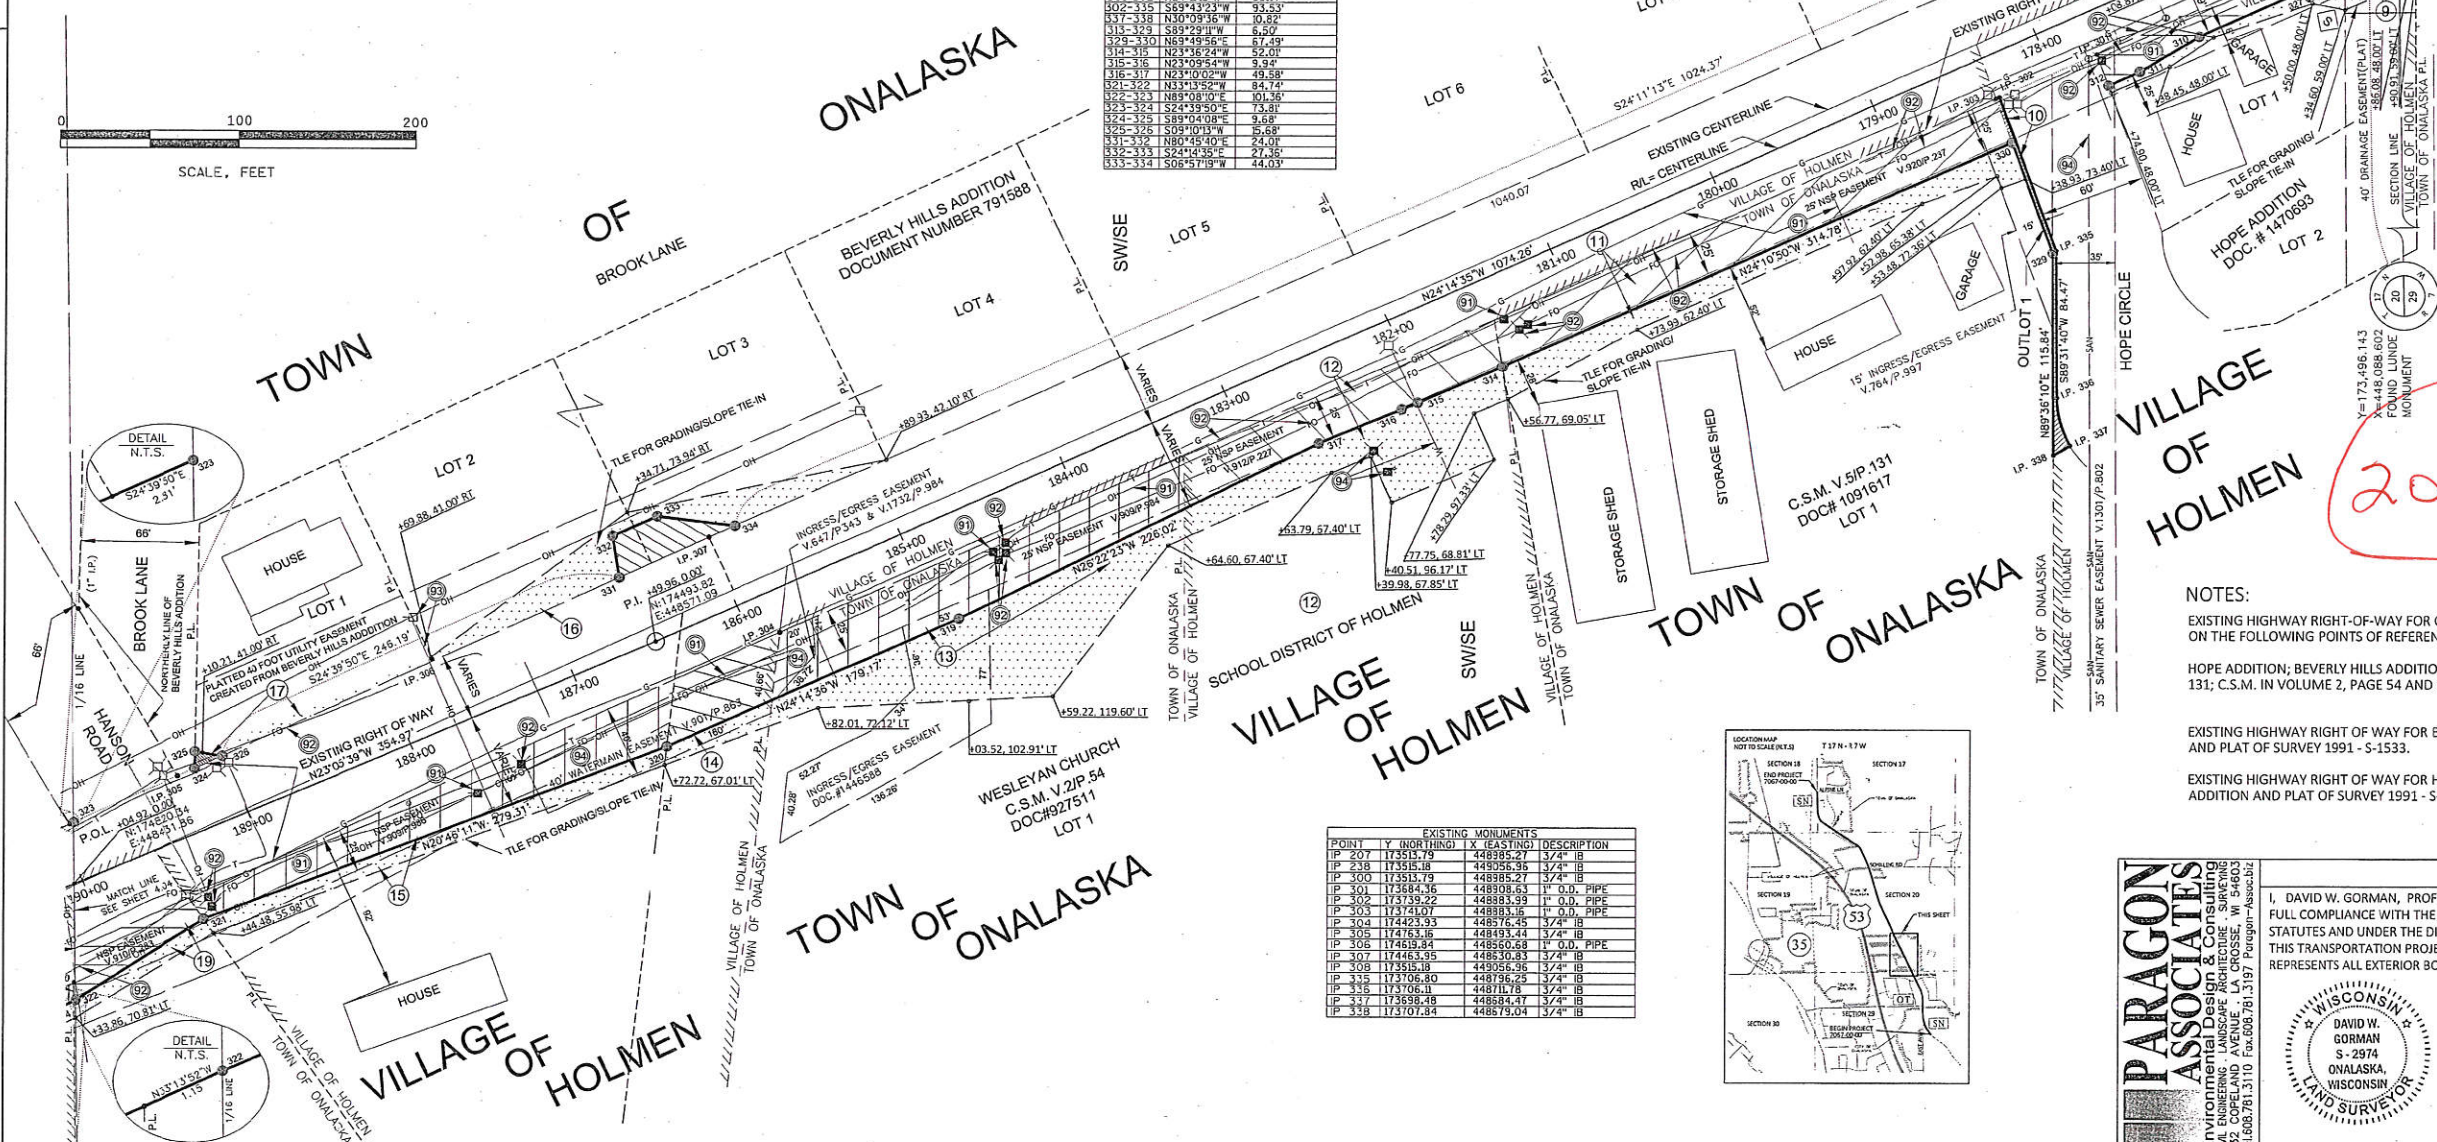

UTILITY NUMBER	OWNER	INTEREST REQUIRED
91	XCEL ENERGY, INC.	RELEASE OF RIGHTS
92	CENTURYLINK	RELEASE OF RIGHTS
93	RIVERLAND ENERGY COOPERATIVE	RELEASE OF RIGHTS
94	VILLAGE OF HOLMEN	RELEASE OF RIGHTS

201 AMD #3

NOTES:
EXISTING HIGHWAY RIGHT-OF-WAY FOR COUNTY TRUNK HIGHWAY SN SHOWN HEREIN IS BASED ON THE FOLLOWING POINTS OF REFERENCE:
HOPE ADDITION; BEVERLY HILLS ADDITION; CERTIFIED SURVEY MAP (C.S.M.) IN VOLUME 5, PAGE 131; C.S.M. IN VOLUME 2, PAGE 54 AND ORDER OF HIGHWAY IN VOLUME 161, PAGE 232.
EXISTING HIGHWAY RIGHT OF WAY FOR BROOK LANE ESTABLISHED FROM BEVERLY HILLS ADDITION AND PLAT OF SURVEY 1991 - S-1533.
EXISTING HIGHWAY RIGHT OF WAY FOR HANSON ROAD ESTABLISHED FROM BEVERLY HILLS ADDITION AND PLAT OF SURVEY 1991 - S-1533.

PARAGON ASSOCIATES
Environmental Design & Consulting
CIVIL ENGINEERING - LANDSCAPE ARCHITECTURE - SURVEYING

I, DAVID W. GORMAN, PROFESSIONAL LAND SURVEYOR, HEREBY CERTIFY THAT IN FULL COMPLIANCE WITH THE PROVISIONS OF SECTION 84.095 OF THE WISCONSIN STATUTES AND UNDER THE DIRECTION OF LA CROSSE COUNTY, I HAVE MAPPED THIS TRANSPORTATION PROJECT PLAT AND SUCH PLAT CORRECTLY REPRESENTS ALL EXTERIOR BOUNDARIES OF THE SURVEYED LAND.

SIGNATURE: *David W. Gorman* DATE: 9-1-2017
PRINT NAME: DAVID W. GORMAN
REGISTRATION NUMBER: PLS-2974
THIS PLAT AND RELOCATION ORDER ARE APPROVED FOR
LA CROSSE COUNTY HIGHWAY COMMITTEE
SIGNATURE: *[Signature]* DATE: 9-1-17
PRINT NAME: Title of Commissioner

TRANSPORTATION PROJECT PLAT NO: 7067-00-00-4.03-AMENDMENT NO. 4
 AMENDS PARCEL NO: 13 OF TRANSPORTATION PROJECT PLAT
 7067-00-00-4.03- AMENDMENT2, RECORDED AS DOCUMENT NO:1698420, TPP
 CAB PAGE: 82A

LOT 1 AND OUTLOT 1 OF HOPE ADDITION, LOT 1 OF LA CROSSE COUNTY C.S.M. V.5/P.131, DOC# 1091617, LOT 1 OF LA CROSSE COUNTY C.S.M. V.2/P.54, DOC# 927511, LOT 1 AND LOT 2 OF BEVERLY HILLS ADDITION AND PART OF THE SOUTHWEST QUARTER OF THE SOUTHEAST QUARTER OF SECTION 20, TOWNSHIP 17 NORTH, RANGE 7 WEST, TOWN OF ONALASKA AND THE VILLAGE OF HOLMEN, LA CROSSE COUNTY, WISCONSIN.

RELOCATION ORDER C.T.H. SN

(C.T.H. OT-ALPINE LANE)

TO PROPERLY ESTABLISH, LAY OUT, WIDEN, ENLARGE, EXTEND, CONSTRUCT, RECONSTRUCT, IMPROVE, OR MAINTAIN A PORTION OF THE HIGHWAY DESIGNATED ABOVE, LA CROSSE COUNTY HIGHWAY COMMITTEE DEEMS IT NECESSARY TO RELOCATE OR CHANGE SAID HIGHWAY AND ACQUIRE CERTAIN LANDS AND INTERESTS OR RIGHTS IN LANDS FOR THE ABOVE PROJECT.

TO EFFECT THIS CHANGE, PURSUANT TO AUTHORITY GRANTED UNDER SECTION 83.07 AND 83.08, WISCONSIN STATUTES, THE LA CROSSE COUNTY HIGHWAY COMMITTEE HEREBY ORDERS THAT:

- THAT PORTION OF SAID HIGHWAY AS SHOWN ON THIS PLAT IS LAID OUT AND ESTABLISHED TO THE LINES AND WIDTHS AS SO SHOWN FOR THE ABOVE PROJECT.
- THE LANDS OR INTERESTS OR RIGHTS IN LANDS AS SHOWN ON THIS PLAT ARE REQUIRED BY THE LA CROSSE COUNTY HIGHWAY COMMITTEE FOR THE ABOVE PROJECT AND SHALL BE ACQUIRED IN THE NAME OF LA CROSSE COUNTY, PURSUANT TO THE PROVISIONS OF SECTION 83.07 AND 83.08, WISCONSIN STATUTES.

FOR ADDITIONAL INFORMATION REFER TO THE TITLE SHEET, SHEET 2 OF 2 OF TRANSPORTATION PROJECT PLAT 7067-00-00-4.01, RECORDED AS DOCUMENT #1692141 AND FILED IN THE OFFICE OF THE REGISTER OF DEEDS IN LA CROSSE COUNTY.

POINT NO.	STATION	OFFSET	NORTH	EAST
207	175+86.28	33.00' LT	173513.79	448985.27
237	175+82.35	39.00' LT	173508.53	449078.53
301	175+82.35	39.00' RT	173515.19	449056.96
301	177+73.28	24.60' LT	173684.36	448908.63
302	178+33.42	24.54' LT	173739.22	448883.99
303	182+58.19	42.22' RT	174463.95	448630.83
303	175+94.49	44.00' LT	173513.56	448964.35
310	177+56.38	39.00' LT	173626.56	448919.86
311	177+56.38	43.85' LT	173633.84	448939.74
312	177+56.38	43.85' LT	173708.70	448801.37
314	181+51.11	60.70' LT	174019.06	448729.28
315	182+04.11	50.10' LT	174066.72	448708.45
316	182+14.05	49.35' LT	174075.86	448704.55
317	182+63.62	45.00' LT	174121.44	448685.04
318	183+63.87	49.00' LT	174212.84	448643.88
319	184+89.49	57.40' LT	174323.94	448584.64
320	186+18.50	57.76' LT	174487.30	448511.07
321	189+46.68	46.44' LT	174748.46	448412.03
322	190+30.00	61.35' LT	174819.34	448369.59
323	189+91.63	32.48' RT	174820.87	448456.94
324	189+17.87	34.50' RT	174753.80	448497.74
325	189+10.21	41.00' RT	174753.64	448507.42
326	189+00.66	34.97' RT	174739.15	448504.92
327	176+50.00	44.00' LT	173563.98	448941.56
328	176+50.00	39.00' LT	173586.04	448946.12
329	178+42.13	108.35' LT	173708.64	448794.87
330	176+37.34	51.04' LT	173713.91	448858.25
331	186+54.57	41.72' RT	174514.42	448607.65
332	186+47.51	65.00' RT	174518.28	448631.35
333	186+47.51	65.00' RT	174493.33	448642.60
334	185+82.49	42.92' RT	174449.63	448637.26
335	178+39.89	117.85' LT	173706.80	448796.25
336	178+33.94	105.15' LT	173706.11	448796.25
337	178+78.20	223.19' LT	173698.48	448684.47
338	178+88.36	224.37' LT	173707.84	448679.04


PARCEL NUMBER	OWNER/OWNER	INTEREST REQUIRED	R/W ACRES REQUIRED		PLE	TLE
			NEW	EXISTING		
9	CHONG HENG YANG AND TONG LOR YANG	FEE & TLE	0.08	---	0.08	0.05
10	HABITAT FOR HUMANITY, LA CROSSE AREA, INC.	FEE	0.012	---	0.012	0.02
11	DAVID M. PAUDLER AND DAVID J. RITTER	FEE & TLE	0.19	---	0.19	0.09
12	SCHOOL DISTRICT OF HOLMEN	FEE & TLE	0.12	---	0.12	0.12
13	WISCONSIN DISTRICT OF THE WESLEYAN CHURCH	FEE & TLE	0.18	---	0.18	0.21
14	THARREN L. APPLETON AND TRACY L. APPLETON	FEE & TLE	0.05	0.05	0.10	0.02
15	ARCHIE ACHTERKIRCH AND PRISCILLA ACHTERKIRCH	FEE & TLE	0.24	0.16	0.40	0.17
16	JAMES P. SCHANK AND CAROL SCHANK	FEE & TLE	0.03	---	0.03	0.08
17	MICHAEL A. MCDOWELL AND SUSAN A. MCDOWELL	FEE & TLE	0.002	---	0.002	0.01
19	GEORGE H. SCHMIDT AND PATRICIA D. SCHMIDT	FEE & TLE	0.04	0.04	0.08	0.02

NOTE: OWNERS NAMES ARE SHOWN FOR REFERENCE PURPOSES ONLY AND ARE SUBJECT TO CHANGE PRIOR TO THE TRANSFER OF LAND INTERESTS TO LA CROSSE COUNTY.

OWNER	EASEMENT TABLE	RECORDING INFORMATION	PARCEL(S)
NORTHERN STATES POWER COMPANY (NSP)-dba XCEL ENERGY, INC.	UTILITY EASEMENT V.920/P.237	9, 10	
NORTHERN STATES POWER COMPANY (NSP)-dba XCEL ENERGY, INC.	UTILITY EASEMENT V.912/P.227	11, 12	
NORTHERN STATES POWER COMPANY (NSP)-dba XCEL ENERGY, INC.	UTILITY EASEMENT V.909/P.984	13	
VILLAGE OF HOLMEN	UTILITY EASEMENT V.901/P.863	13-15	
NORTHERN STATES POWER COMPANY (NSP)-dba XCEL ENERGY, INC.	UTILITY EASEMENT V.909/P.986	13-15	
NORTHERN STATES POWER COMPANY (NSP)-dba XCEL ENERGY, INC.	UTILITY EASEMENT V.910/P.283	19	

COURSE	BEARING	DISTANCE
308-309	S88°52'25"W	52.53'
309-311	N24°14'35"W	1074.26'
327-328	N55°45'25"E	5.00'
328-310	N24°14'35"W	66.39'
310-311	N31°05'05"W	19.53'
311-312	N24°14'35"W	19.53'
312-301	N59°43'26"E	15.05'
301-302	N24°14'35"W	66.39'
333-334	S06°57'19"W	44.03'

CURVE	RIGHT-OF-WAY CURVE TABLE	LCR	LCH
336-337	55.00' R	28.68'	574°23'51" W
			28.36'

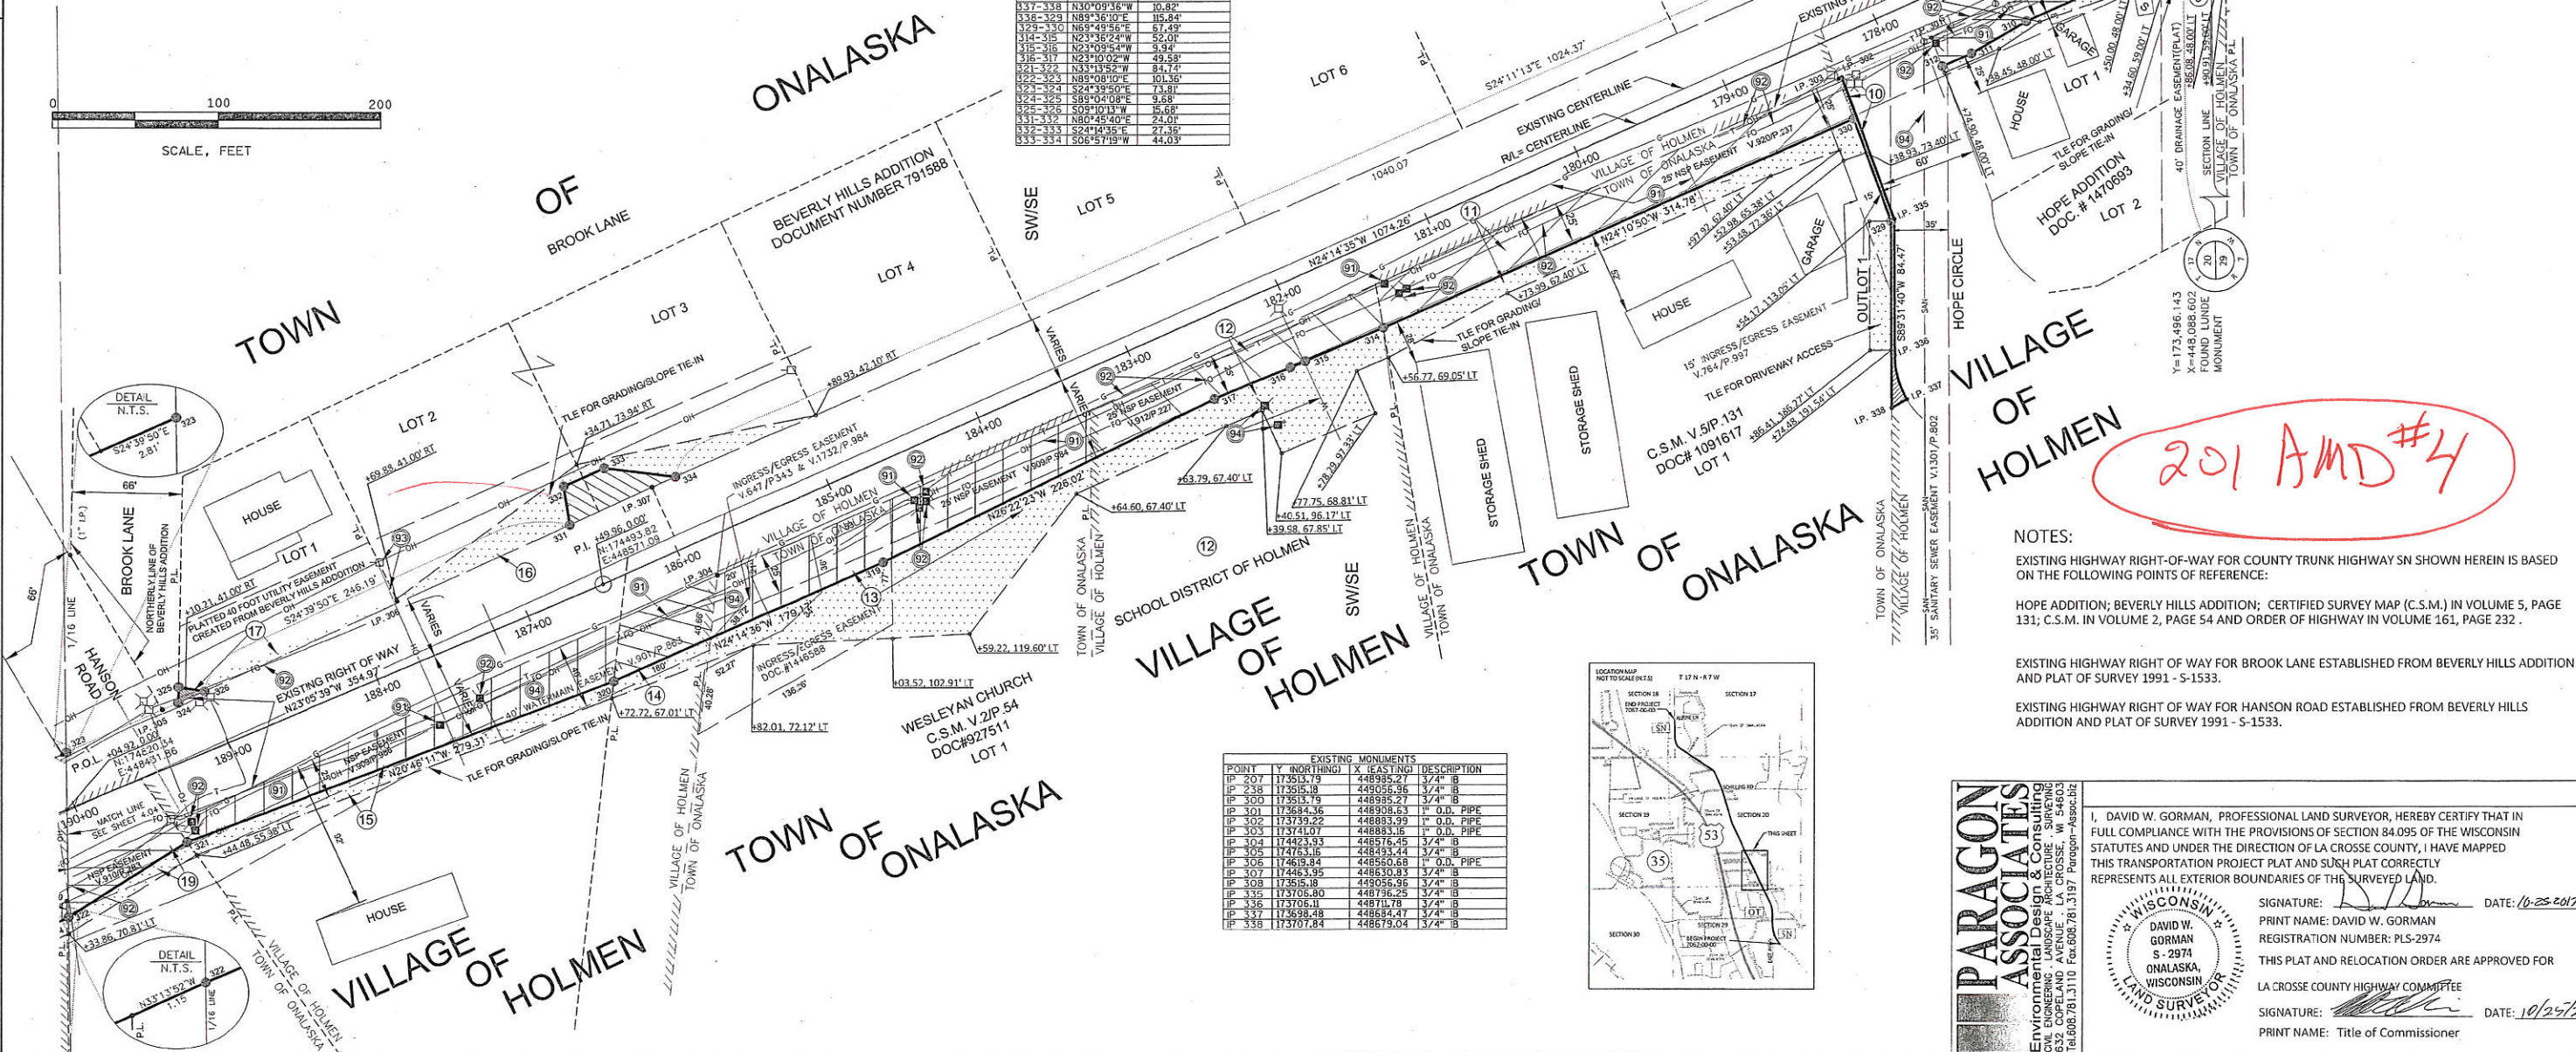

201 AMD #4

NOTES:
 EXISTING HIGHWAY RIGHT-OF-WAY FOR COUNTY TRUNK HIGHWAY SN SHOWN HEREIN IS BASED ON THE FOLLOWING POINTS OF REFERENCE:
 HOPE ADDITION; BEVERLY HILLS ADDITION; CERTIFIED SURVEY MAP (C.S.M.) IN VOLUME 5, PAGE 131; C.S.M. IN VOLUME 2, PAGE 54 AND ORDER OF HIGHWAY IN VOLUME 161, PAGE 232.
 EXISTING HIGHWAY RIGHT OF WAY FOR BROOK LANE ESTABLISHED FROM BEVERLY HILLS ADDITION AND PLAT OF SURVEY 1991 - S-1533.
 EXISTING HIGHWAY RIGHT OF WAY FOR HANSON ROAD ESTABLISHED FROM BEVERLY HILLS ADDITION AND PLAT OF SURVEY 1991 - S-1533.

1701437
 LACROSSE COUNTY
 REGISTER OF DEEDS
 CHERYL A. MCBRIDE
 RECORDED ON
 10/25/2017 12:25PM
 PLAT FEE: \$25.00
 VOLUME: TPP CAB PAGE: 83A
 PAGES: 1

RESERVED FOR REGISTER OF DEEDS
 PROJECT NUMBER: 7067-00-00-4.03

UTILITY NUMBER	OWNER	INTEREST REQUIRED
91	XCEL ENERGY, INC.	RELEASE OF RIGHTS
92	CENTURYLINK	RELEASE OF RIGHTS
93	RIVERLAND ENERGY COOPERATIVE	RELEASE OF RIGHTS
94	VILLAGE OF HOLMEN	RELEASE OF RIGHTS

PARAGON ASSOCIATES
 Environmental Design & Consulting
 CIVIL ENGINEERING, LANDSCAPE ARCHITECTURE, SURVEYING
 532 COPELAND AVENUE, LA CROSSE, WI 54603
 TEL: 608.781.3170 FAX: 608.781.3197 Paragon-associates.com

I, DAVID W. GORMAN, PROFESSIONAL LAND SURVEYOR, HEREBY CERTIFY THAT IN FULL COMPLIANCE WITH THE PROVISIONS OF SECTION 84.095 OF THE WISCONSIN STATUTES AND UNDER THE DIRECTION OF LA CROSSE COUNTY, I HAVE MAPPED THIS TRANSPORTATION PROJECT PLAT AND SLUSH PLAT CORRECTLY REPRESENTS ALL EXTERIOR BOUNDARIES OF THE SURVEYED LAND.

SIGNATURE: *[Signature]* DATE: 10-25-2017
 PRINT NAME: DAVID W. GORMAN
 REGISTRATION NUMBER: PLS-2974
 THIS PLAT AND RELOCATION ORDER ARE APPROVED FOR
 LA CROSSE COUNTY HIGHWAY COMMITTEE
 SIGNATURE: *[Signature]* DATE: 10/25/2017
 PRINT NAME: Title of Commissioner

TRANSPORTATION PROJECT PLAT NO: 7067-00-00-4.03-AMENDMENT NO. 5
AMENDS PARCEL NO: 11 OF TRANSPORTATION PROJECT PLAT
7067-00-00-4.03- AMENDMENT 2, RECORDED AS DOCUMENT NO:1698420, TPP
CAB PAGE: 82A, AND PARCEL NO: 10 OF TRANSPORTATION PROJECT PLAT
7067-00-00-4.03- AMENDMENT 3, RECORDED AS DOCUMENT NO:1699165, TPP
CAB PAGE: 82B
LOT 1 AND OUTLOT 1 OF HOPE ADDITION, LOT 1 OF LA CROSSE COUNTY C.S.M. V.5/P.131, DOC# 1091617, LOT
1 OF LA CROSSE COUNTY C.S.M. V.2/P.54, DOC# 927511, LOT 1 AND LOT 2 OF BEVERLY HILLS ADDITION AND
PART OF THE SOUTHWEST QUARTER OF THE SOUTHEAST QUARTER OF SECTION 20, TOWNSHIP 17 NORTH, RANGE 7
WEST, TOWN OF ONALASKA AND THE VILLAGE OF HOLMEN, LA CROSSE COUNTY, WISCONSIN.

RELOCATION ORDER C.T.H. SN

(C.T.H. OT-ALPINE LANE)

TO PROPERLY ESTABLISH, LAY OUT, WIDEN, ENLARGE, EXTEND, CONSTRUCT, RECONSTRUCT, IMPROVE, OR MAINTAIN A PORTION OF THE
HIGHWAY DESIGNATED ABOUT, LA CROSSE COUNTY HIGHWAY COMMITTEE DEEMS IT NECESSARY TO RELOCATE OR CHANGE SAID HIGHWAY AND
ACQUIRE CERTAIN LANDS AND INTERESTS OR RIGHTS IN LANDS FOR THE ABOVE PROJECT.

TO EFFECT THIS CHANGE, PURSUANT TO AUTHORITY GRANTED UNDER SECTION 83.07 AND 83.08, WISCONSIN STATUTES, THE LA CROSSE
COUNTY HIGHWAY COMMITTEE HEREBY ORDERS THAT:

- THAT PORTION OF SAID HIGHWAY AS SHOWN ON THIS PLAT IS LAID OUT AND ESTABLISHED TO THE LINES AND WIDTHS AS SO
SHOWN FOR THE ABOVE PROJECT.
- THE LANES OR INTERESTS OR RIGHTS IN LANDS AS SHOWN ON THIS PLAT ARE REQUIRED BY THE LA CROSSE COUNTY HIGHWAY
COMMITTEE FOR THE ABOVE PROJECT AND SHALL BE ACQUIRED IN THE NAME OF LA CROSSE COUNTY, PURSUANT TO THE
PROVISIONS OF SECTION 83.07 AND 83.08, WISCONSIN STATUTES.

FOR ADDITIONAL INFORMATION REFER TO THE TITLE SHEET, SHEET 2 OF 2 OF TRANSPORTATION PROJECT PLAT 7067-00-00-4.01,
RECORDED AS DOCUMENT #1692141 AND FILED IN THE OFFICE OF THE REGISTER OF DEEDS IN LA CROSSE COUNTY.

COORDINATE TABLE - R/W

POINT NO.	S/T	NORTH	EAST

R/W COURSE TABLE


COURSE	BEARING	DISTANCE

SCHEDULE OF LANDS AND INTERESTS REQUIRED

PARCEL NUMBER	OWNER	INTEREST REQUIRED	R/W ACRES REQUIRED			P.E.	TLE
			NEW	EXISTING	TOTAL		
9	CHONG NENG YANG AND TONG LOR YANG	FEE & TLE	0.08	---	0.08	---	0.05
10	HABITAT FOR HUMANITY, LA CROSSE AREA, INC.	FEE	0.012	---	0.012	---	0.00
11	DAVID M. PAUDLER AND DAVID J. RITTER	FEE & TLE	0.19	---	0.19	---	0.11
12	SCHOOL DISTRICT OF HOLMEN	FEE & TLE	0.12	---	0.12	---	0.12
13	WISCONSIN DISTRICT OF THE WESLEYAN CHURCH	FEE & TLE	0.18	---	0.18	---	0.21
14	THARREN L. APPLETON AND TRACY L. APPLETON	FEE & TLE	0.05	0.05	0.10	---	0.02
15	ARCHE ACHTERKIRCH AND PRISCILLA ACHTERKIRCH	FEE & TLE	0.34	0.16	0.40	---	0.17
16	JAMES P. SCHANK AND CAROL SCHANK	FEE & TLE	0.03	---	0.03	---	0.08
17	MICHAEL A. MCDOWELL AND SUSAN A. MCDOWELL	FEE & TLE	0.002	---	0.002	---	0.01
19	GEORGE H. SCHMIDT AND PATRICIA D. SCHMIDT	FEE & TLE	0.04	0.04	0.08	---	0.02

EASEMENT TABLE

OWNER	RECORDING INFORMATION	PARCEL(S)
VILLAGE OF HOLMEN	UTILITY EASEMENT V.1301/P.202	9
NORTHERN STATES POWER COMPANY (NSP)-dba XCEL ENERGY, INC.	UTILITY EASEMENT V.920/P.237	9, 10
NORTHERN STATES POWER COMPANY (NSP)-dba XCEL ENERGY, INC.	UTILITY EASEMENT V.912/P.227	11, 12
NORTHERN STATES POWER COMPANY (NSP)-dba XCEL ENERGY, INC.	UTILITY EASEMENT V.909/P.284	13
VILLAGE OF HOLMEN	UTILITY EASEMENT V.909/P.284	13 - 15
NORTHERN STATES POWER COMPANY (NSP)-dba XCEL ENERGY, INC.	UTILITY EASEMENT V.909/P.286	15
NORTHERN STATES POWER COMPANY (NSP)-dba XCEL ENERGY, INC.	UTILITY EASEMENT V.910/P.283	13

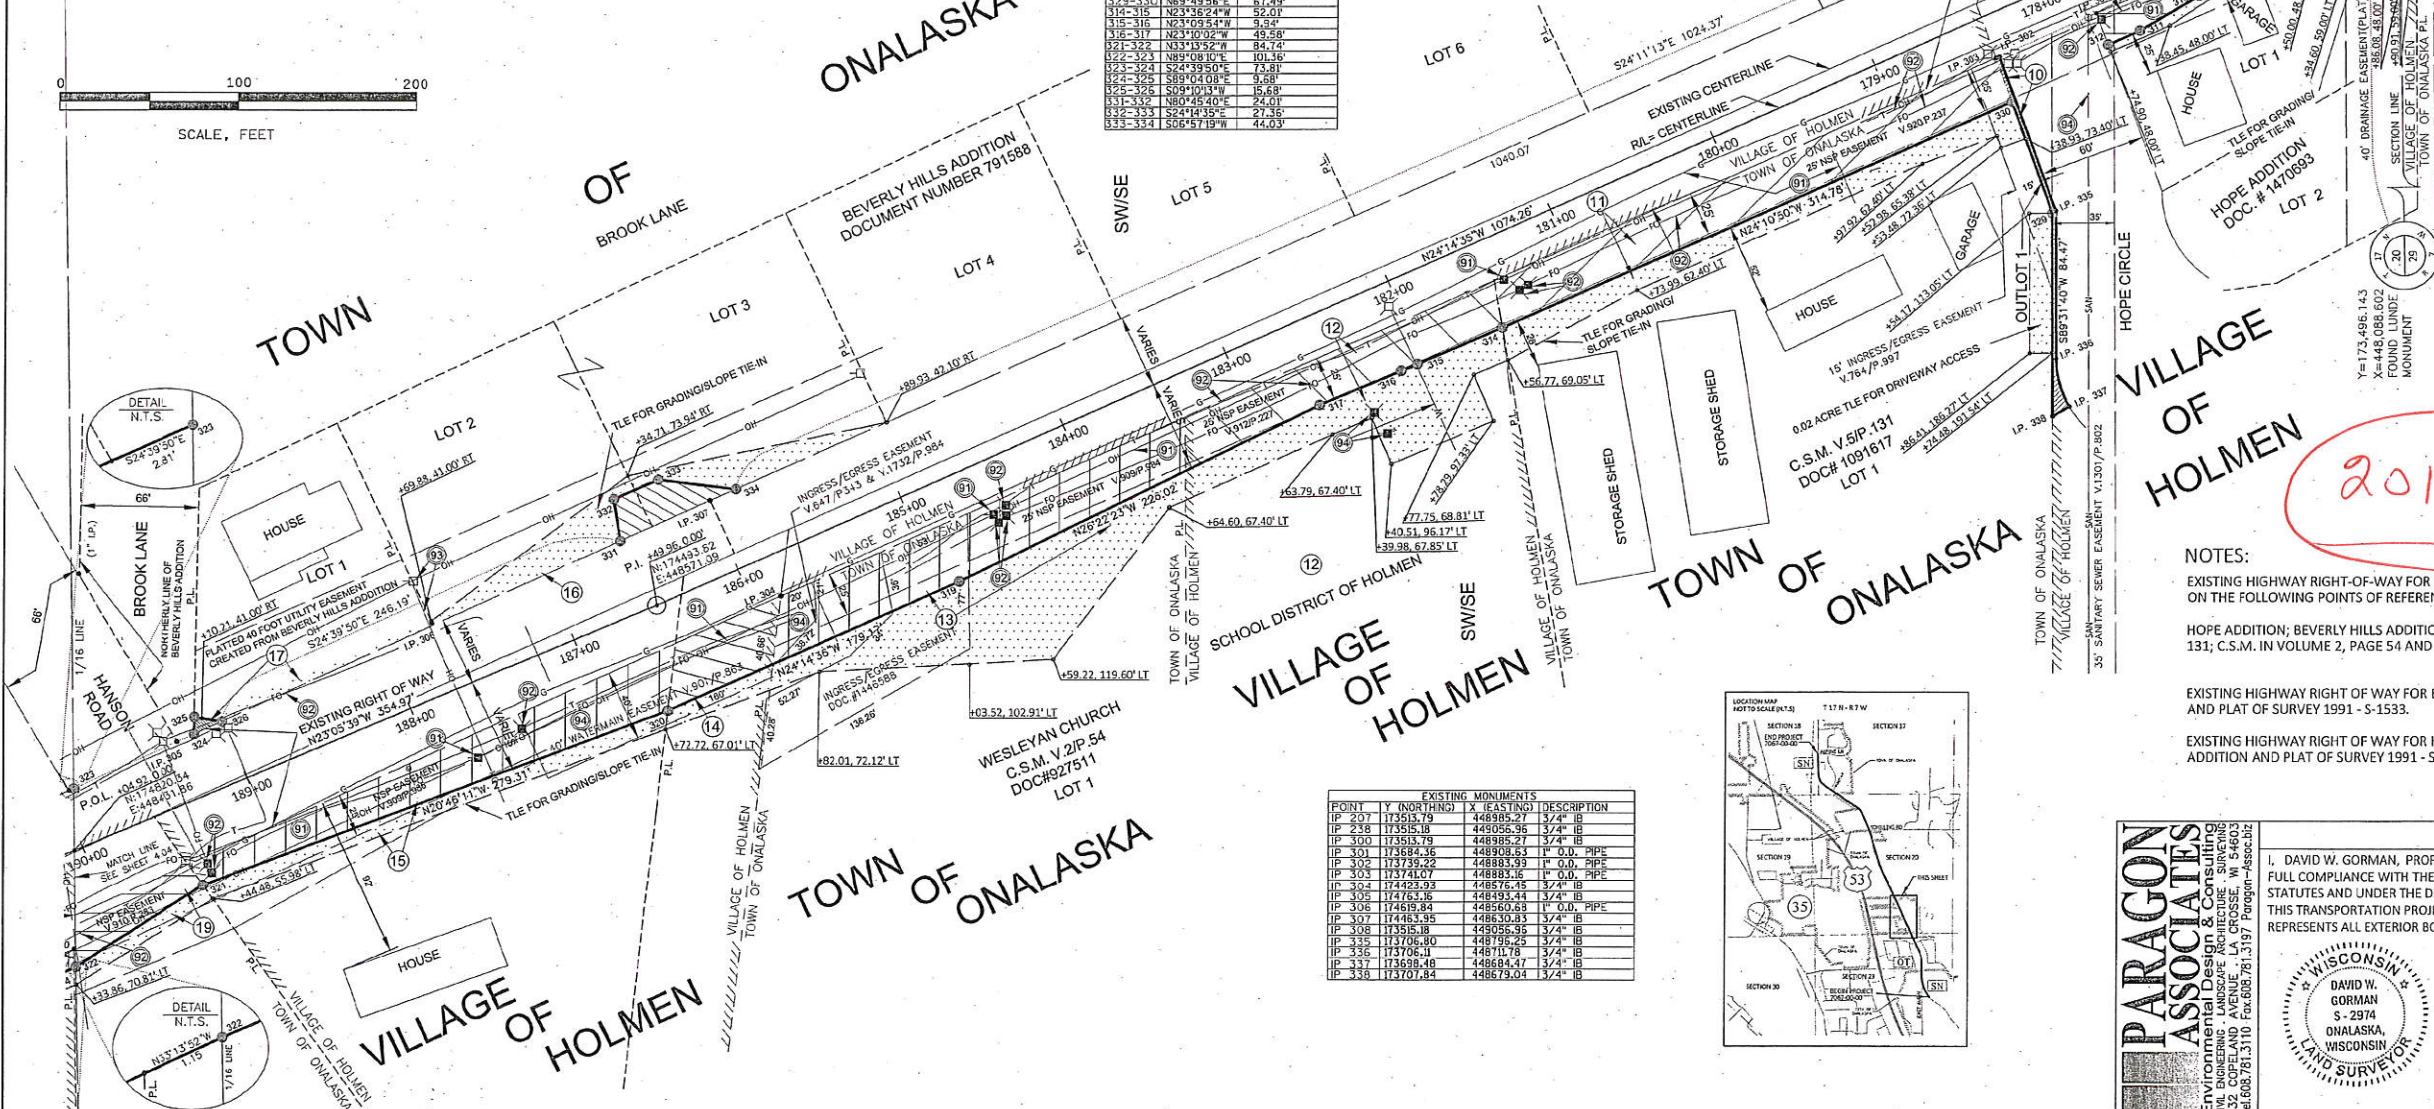

FILE NAME: F:\SURVEY\2016\16-011 COUNTY TRUNK HIGHWAY SN TRANSPORTATION PROJECT PLAT\PHASE 1 DOT STANDARDS PLAT.DWG
APPRAISAL PLAT DATE:

PLAT DATE: 11/8/2017 11:02 AM
PLOT BY: DAVE G
PLOT NAME:

PLAT SCALE: 1 IN=100 FT

7067-00-00-4.03

201 AMD #5

NOTES:
EXISTING HIGHWAY RIGHT-OF-WAY FOR COUNTY TRUNK HIGHWAY SN SHOWN HEREIN IS BASED
ON THE FOLLOWING POINTS OF REFERENCE:
HOPE ADDITION; BEVERLY HILLS ADDITION; CERTIFIED SURVEY MAP (C.S.M.) IN VOLUME 5, PAGE
131; C.S.M. IN VOLUME 2, PAGE 54 AND ORDER OF HIGHWAY IN VOLUME 161, PAGE 232.
EXISTING HIGHWAY RIGHT OF WAY FOR BROOK LANE ESTABLISHED FROM BEVERLY HILLS ADDITION
AND PLAT OF SURVEY 1991 - S-1533.
EXISTING HIGHWAY RIGHT OF WAY FOR HANSON ROAD ESTABLISHED FROM BEVERLY HILLS
ADDITION AND PLAT OF SURVEY 1991 - S-1533.

PARAGON ASSOCIATES
Environmental Design & Consulting
CIVIL ENGINEERING, LANDSCAPE ARCHITECTURE, SURVEYING
532 COPPELAND AVENUE, LA CROSSE, WI 54603
TEL: 608.781.3110 FAX: 608.781.3157 Paragon-assoc.biz

DAVID W. GORMAN
S-2974
ONALASKA,
WISCONSIN
LAND SURVEYOR

I, DAVID W. GORMAN, PROFESSIONAL LAND SURVEYOR, HEREBY CERTIFY THAT IN
FULL COMPLIANCE WITH THE PROVISIONS OF SECTION 84.095 OF THE WISCONSIN
STATUTES AND UNDER THE DIRECTION OF LA CROSSE COUNTY, I HAVE MAPPED
THIS TRANSPORTATION PROJECT PLAT AND SUCH PLAT CORRECTLY
REPRESENTS ALL EXTERIOR BOUNDARIES OF THE SURVEYED LAND.
SIGNATURE: [Signature] DATE: 11-08-2017
PRINT NAME: DAVID W. GORMAN
REGISTRATION NUMBER: PLS-2974
THIS PLAT AND RELOCATION ORDER ARE APPROVED FOR
LA CROSSE COUNTY HIGHWAY COMMITTEE
SIGNATURE: [Signature] DATE: 11/8/17
PRINT NAME: Title of Commissioner