


AMENDS PARCEL 2 OF TRANSPORTATION PROJECT PLAT NO: 5436-00-07 - 4.01 RECORDED AS DOCUMENT NUMBER 1824811 AND FILED IN VOLUME TPPCAB, PAGE 129A.

RELOCATION ORDER CTH M , TOWN OF BARRE, CTH I TO CTH YY, LA CROSSE COUNTY.

TO EFFECT THIS CHANGE, PURSUANT TO AUTHORITY GRANTED UNDER SECTION 83.07 AND 83.08, WISCONSIN STATUTES, THE COUNTY HEREBY ORDERS THAT:

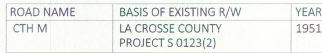

COURSE TABLE			
FROM	TO	BEARING	DISTANCE
21606260020	700	N 001° 12' 58" W	537.77'
701	701	N 001° 12' 58" W	150.00'
701	702	S 89° 54' 00" W	6.51'
702	300	S 89° 54' 00" W	39.25'
300	100	N 00° 06' 21" W	35.00'
100	101	N 09° 10' 44" W	96.30'
101	102	N 00° 06' 00" W	220.00'
102	103	N 05° 48' 38" W	50.25'
103	104	N 00° 06' 00" W	135.00'
104	105	N 15° 18' 55" E	77.80'
105	703	N 89° 54' 00" E	39.31'
703	704	N 89° 54' 00" E	5.27'
704	705	S 00° 12' 58" E	60.00'
705	306	N 89° 54' 00" E	35.30'
306	111	S 00° 06' 21" E	75.00'
111	106	S 09° 11' 46" E	126.59'
110	109	S 00° 06' 21" E	88.76'
109	112	S 00° 06' 21" E	150.00'
108	112	S 89° 53' 39" W	15.73'
112	107	S 05° 40' 46" E	162.01'
107	106	S 11° 12' 15" W	101.98'
306	106	S 00° 06' 21" E	50.00'
303	700	N 00° 89° 54' 00" W	33.96'
700	21606260020	N 00° 12' 58" E	537.77'

PARCEL NUMBER	OWNER(S)	INTEREST REQUIRED	R/W SQUARE FEET REQUIRED			TOTAL SQUARE FEET
			NEW	EXISTING	TOTAL	
1	RODGER H. & CAROL L. SCHOMBERG	FEE/TLE	8689	-	8689	70
2	GOLDEN ACRES GRAIN FARMS, LLC	FEE/TLE	5981	-	5981	22

UTILITY EASEMENT TABLE			
UTILITY NUMBER	PARCEL	RECORDING INFORMATION	NAME
100	1	VOL. 236, PG. 512 DOC 564675	NORTHERN STATES POWER COMPANY (ELECTRIC)

UTILITY INTERESTS REQUIRED		
UTILITY NUMBER	OWNER (S)	INTEREST REQUIRED
100	NORTHERN STATES POWER COMPANY	RELEASE OF RIGHTS

RESERVED FOR REGISTER OF DEEDS
PROJECT NUMBER 5436-00-07-4.01
AMENDMENT NO: 1

