

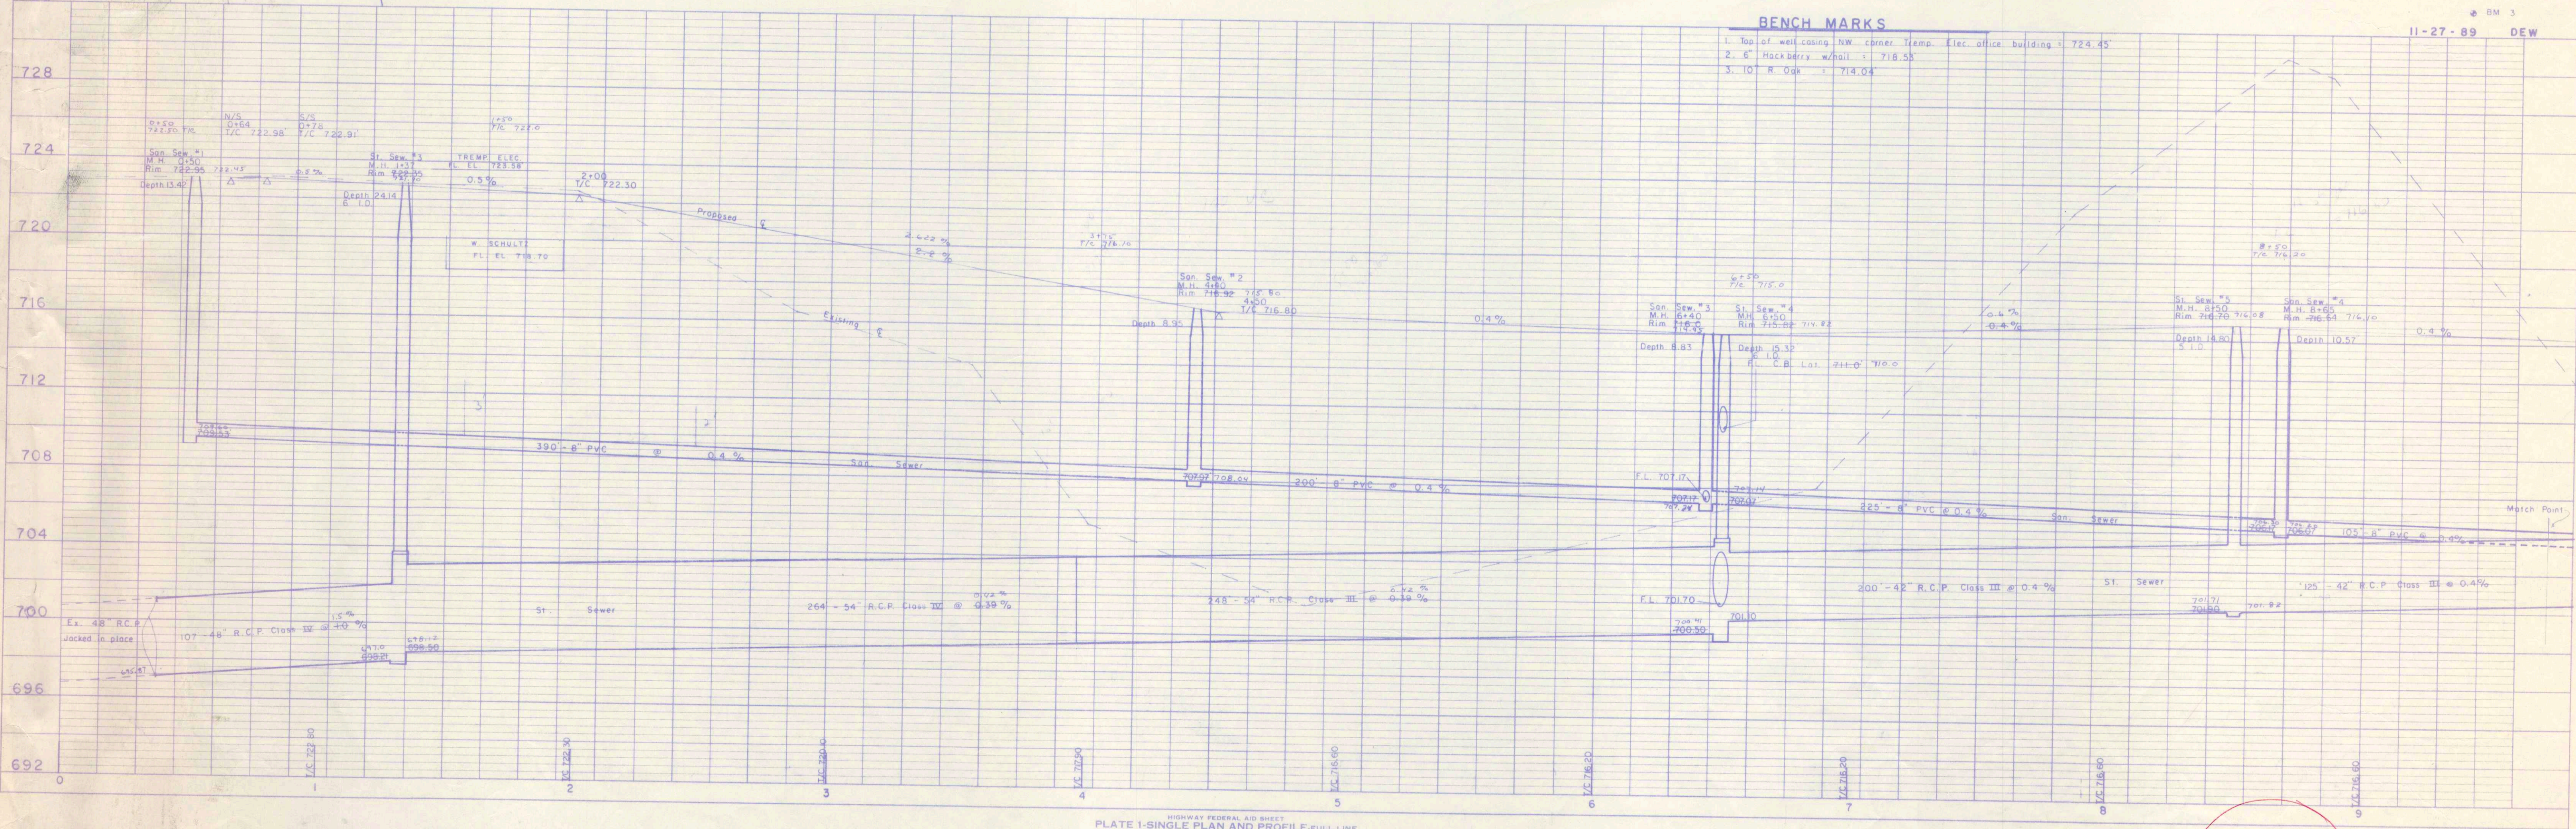


PLAN  
SURVEYED, PLOTTED, CHECKED, REVISIONS  
NO. 1

PROFILE  
SURVEYED, PLOTTED, CHECKED, REVISIONS  
NO. 1

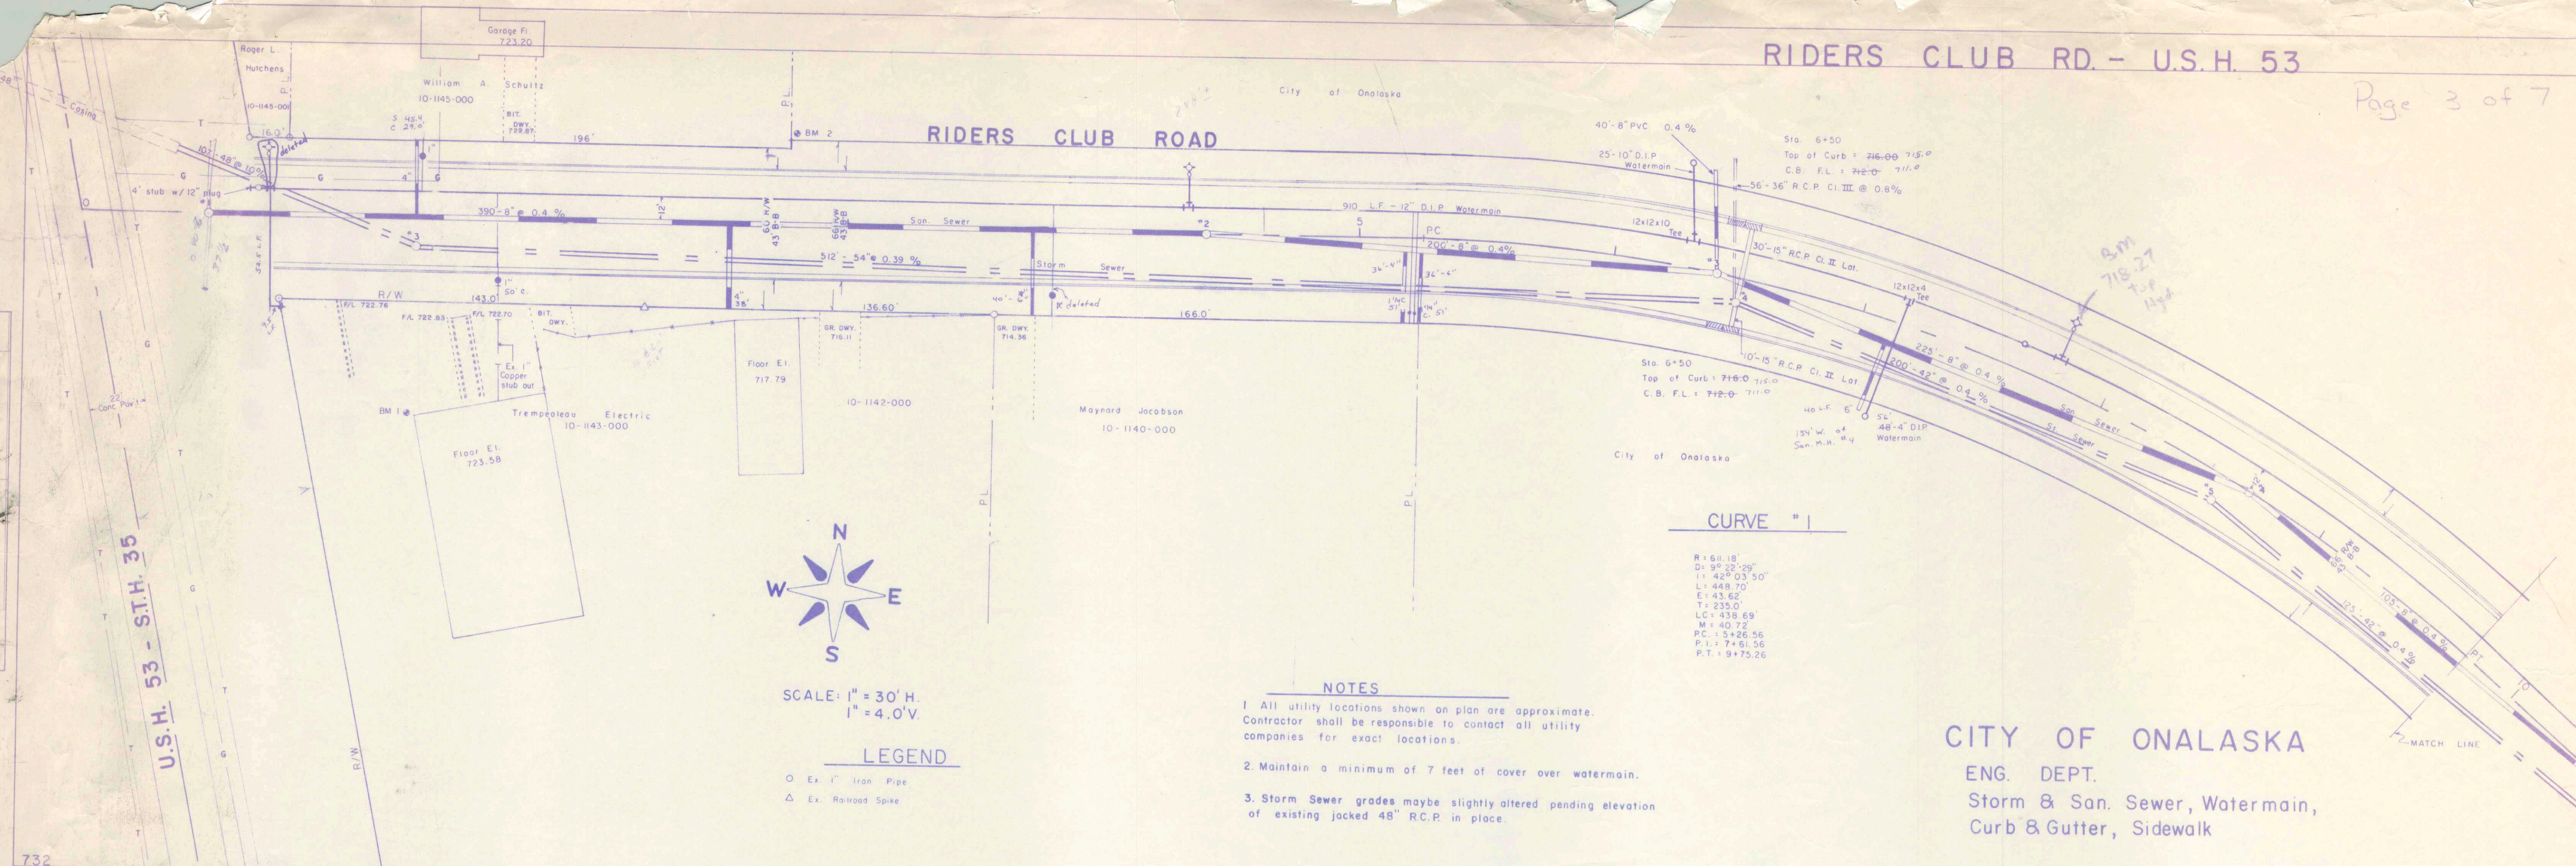


67

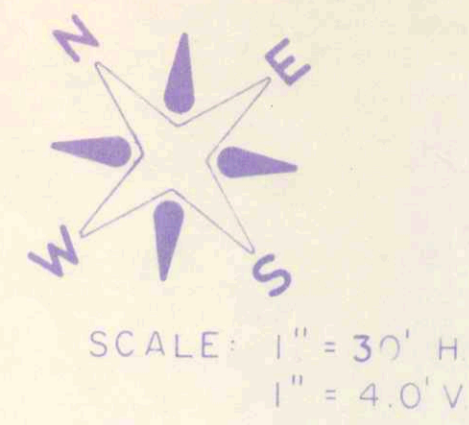

3rd Ave No. Does Not go through here. *af*

PLAN  
SUBMITTED: \_\_\_\_\_  
NOTE BOOK: \_\_\_\_\_  
ALIGNMENT CHECKED: \_\_\_\_\_  
RT OF WAY CHECKED: \_\_\_\_\_  
No. \_\_\_\_\_

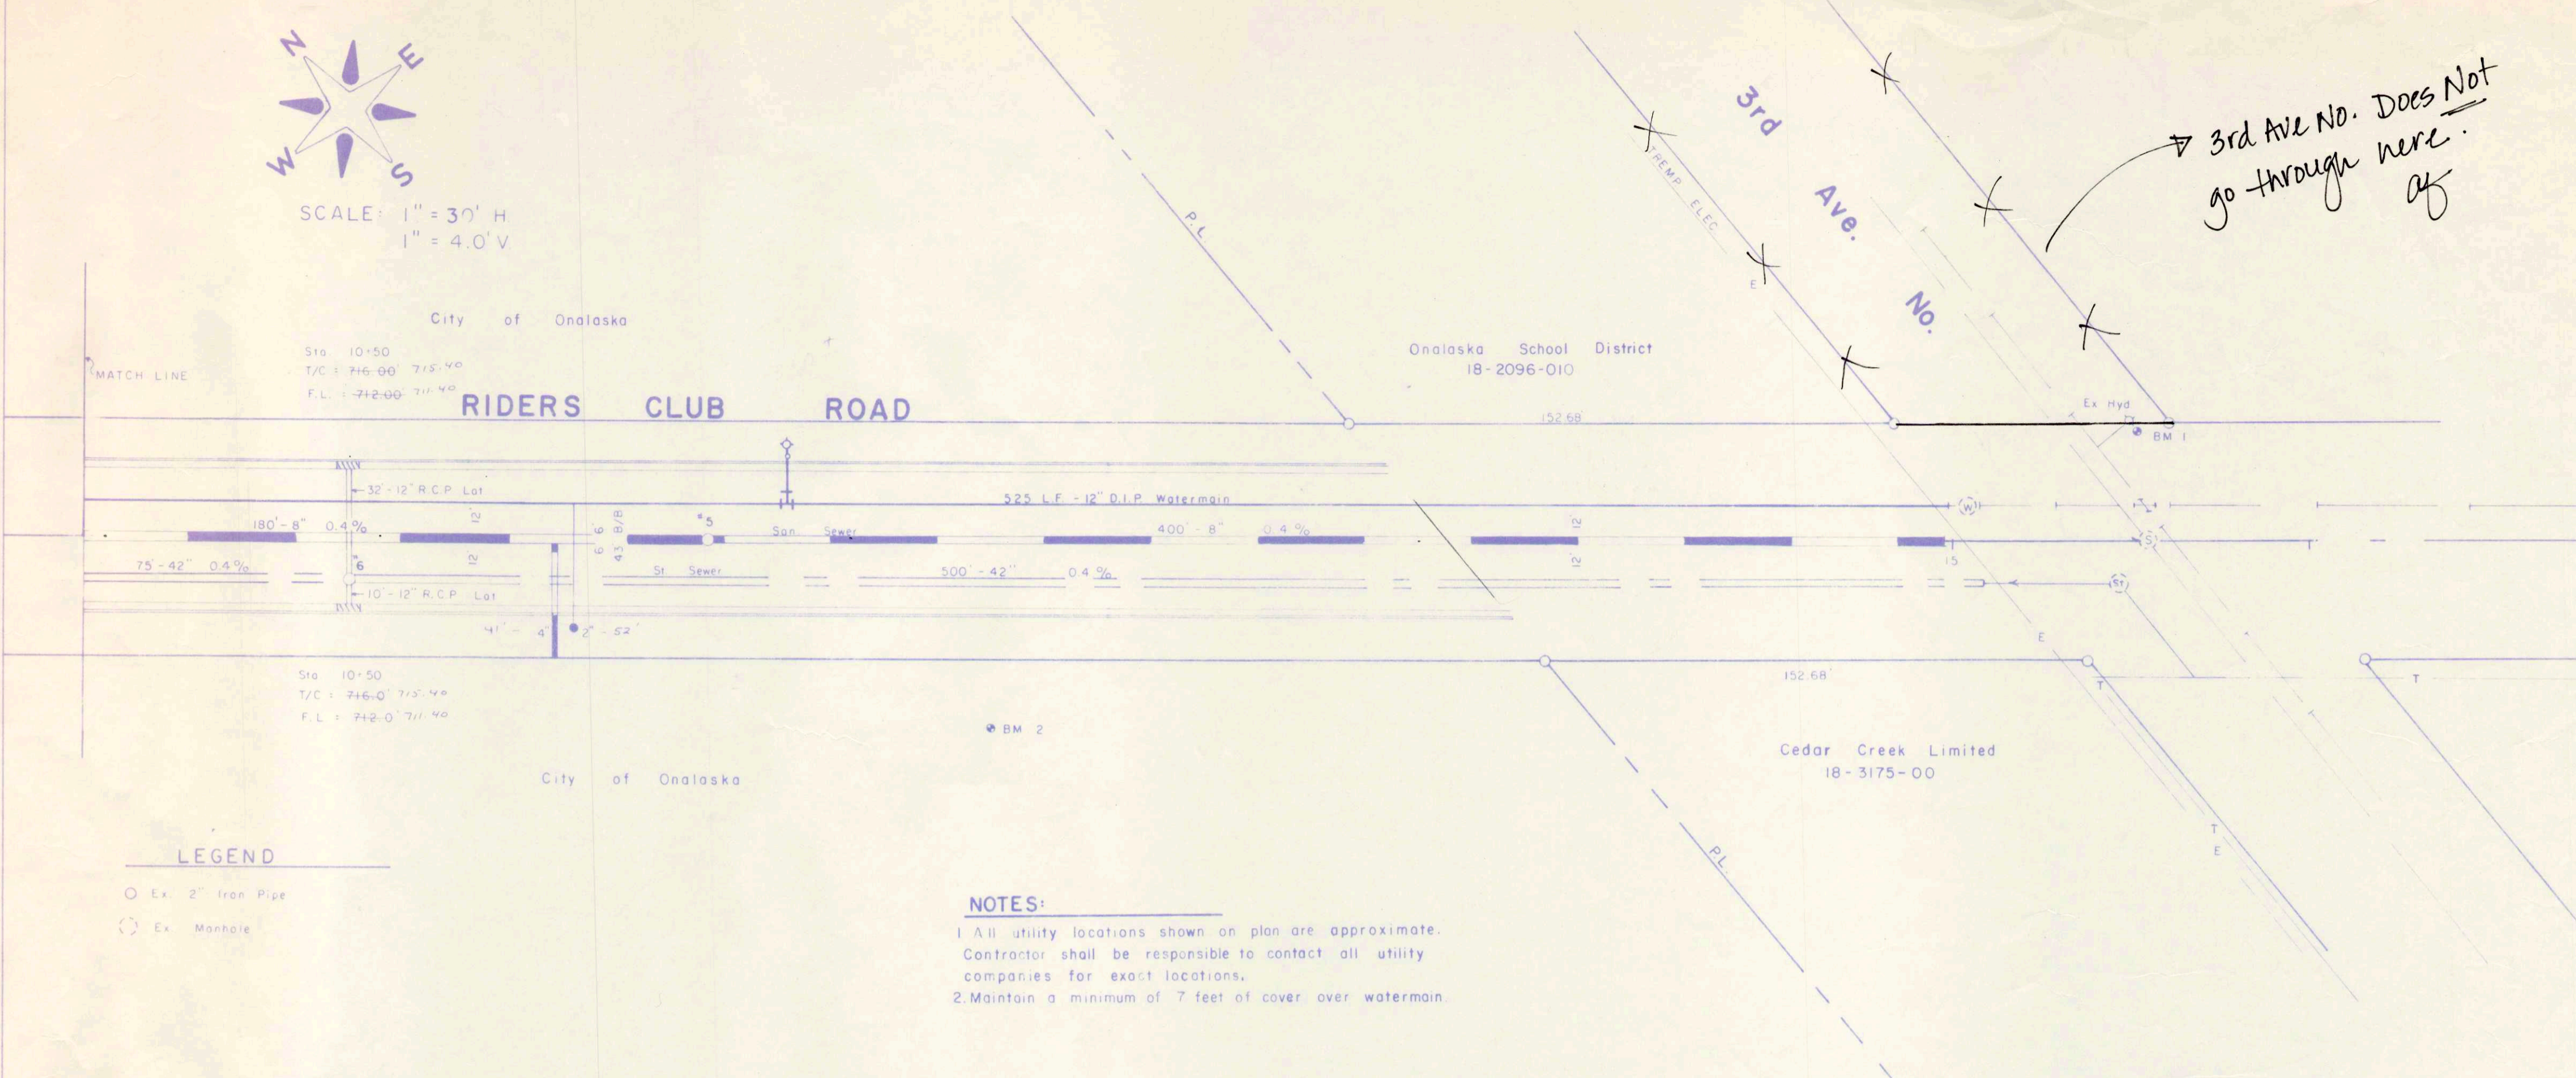


CITY of ONALASKA  
ENG. DEPT.  
Storm & San. Sewer, Watermain,  
Curb & Gutter, Sidewalk

**NOTES:**  
1. All utility locations shown on plan are approximate. Contractor shall be responsible to contact all utility companies for exact locations.  
2. Maintain a minimum of 7 feet of cover over watermain.

**LEGEND**  
○ Ex. 2" Iron Pipe  
⊙ Ex. Manhole

**BENCH MARKS** 11-27-89 DEW

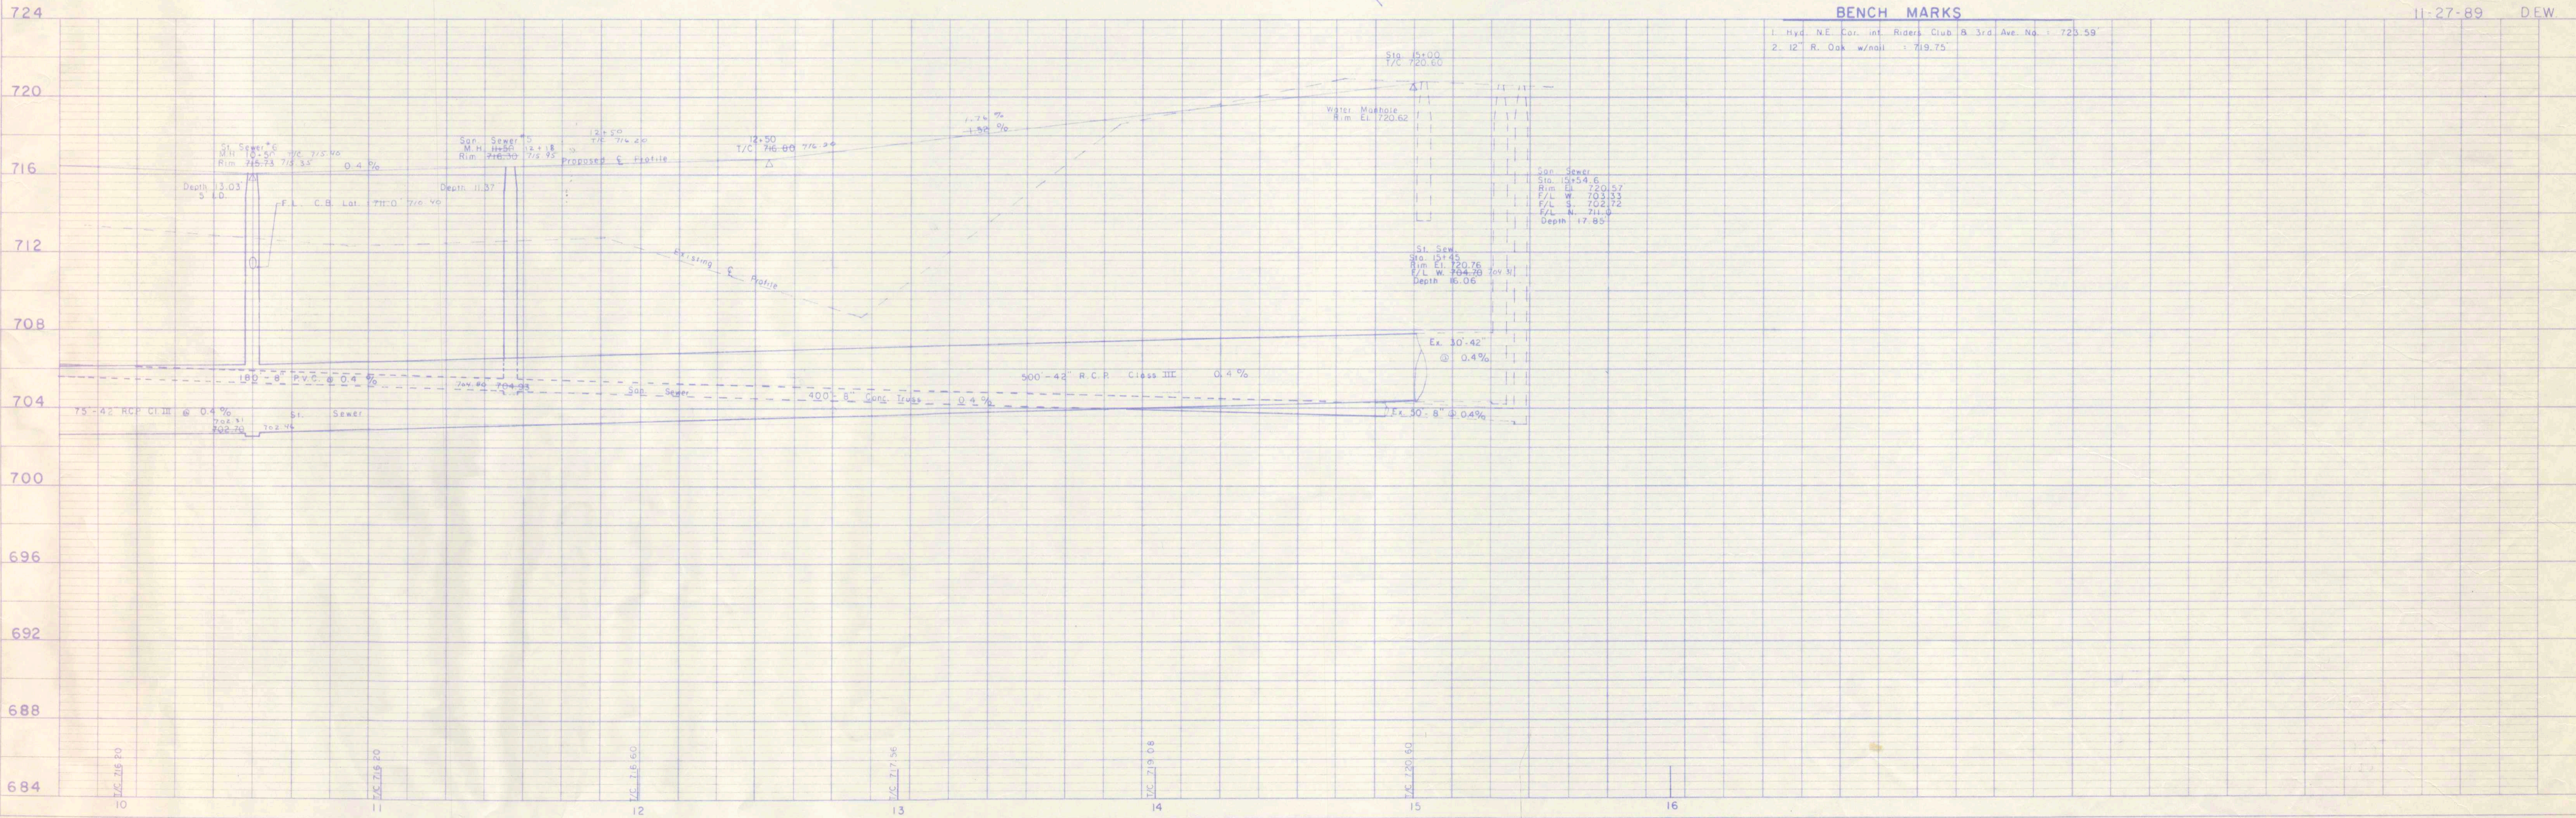

PROFILE  
SUBMITTED: \_\_\_\_\_  
NOTE BOOK: \_\_\_\_\_  
GRADES CHECKED: \_\_\_\_\_  
STRUCTURE NOTATIONS CHECKED: \_\_\_\_\_  
No. \_\_\_\_\_