


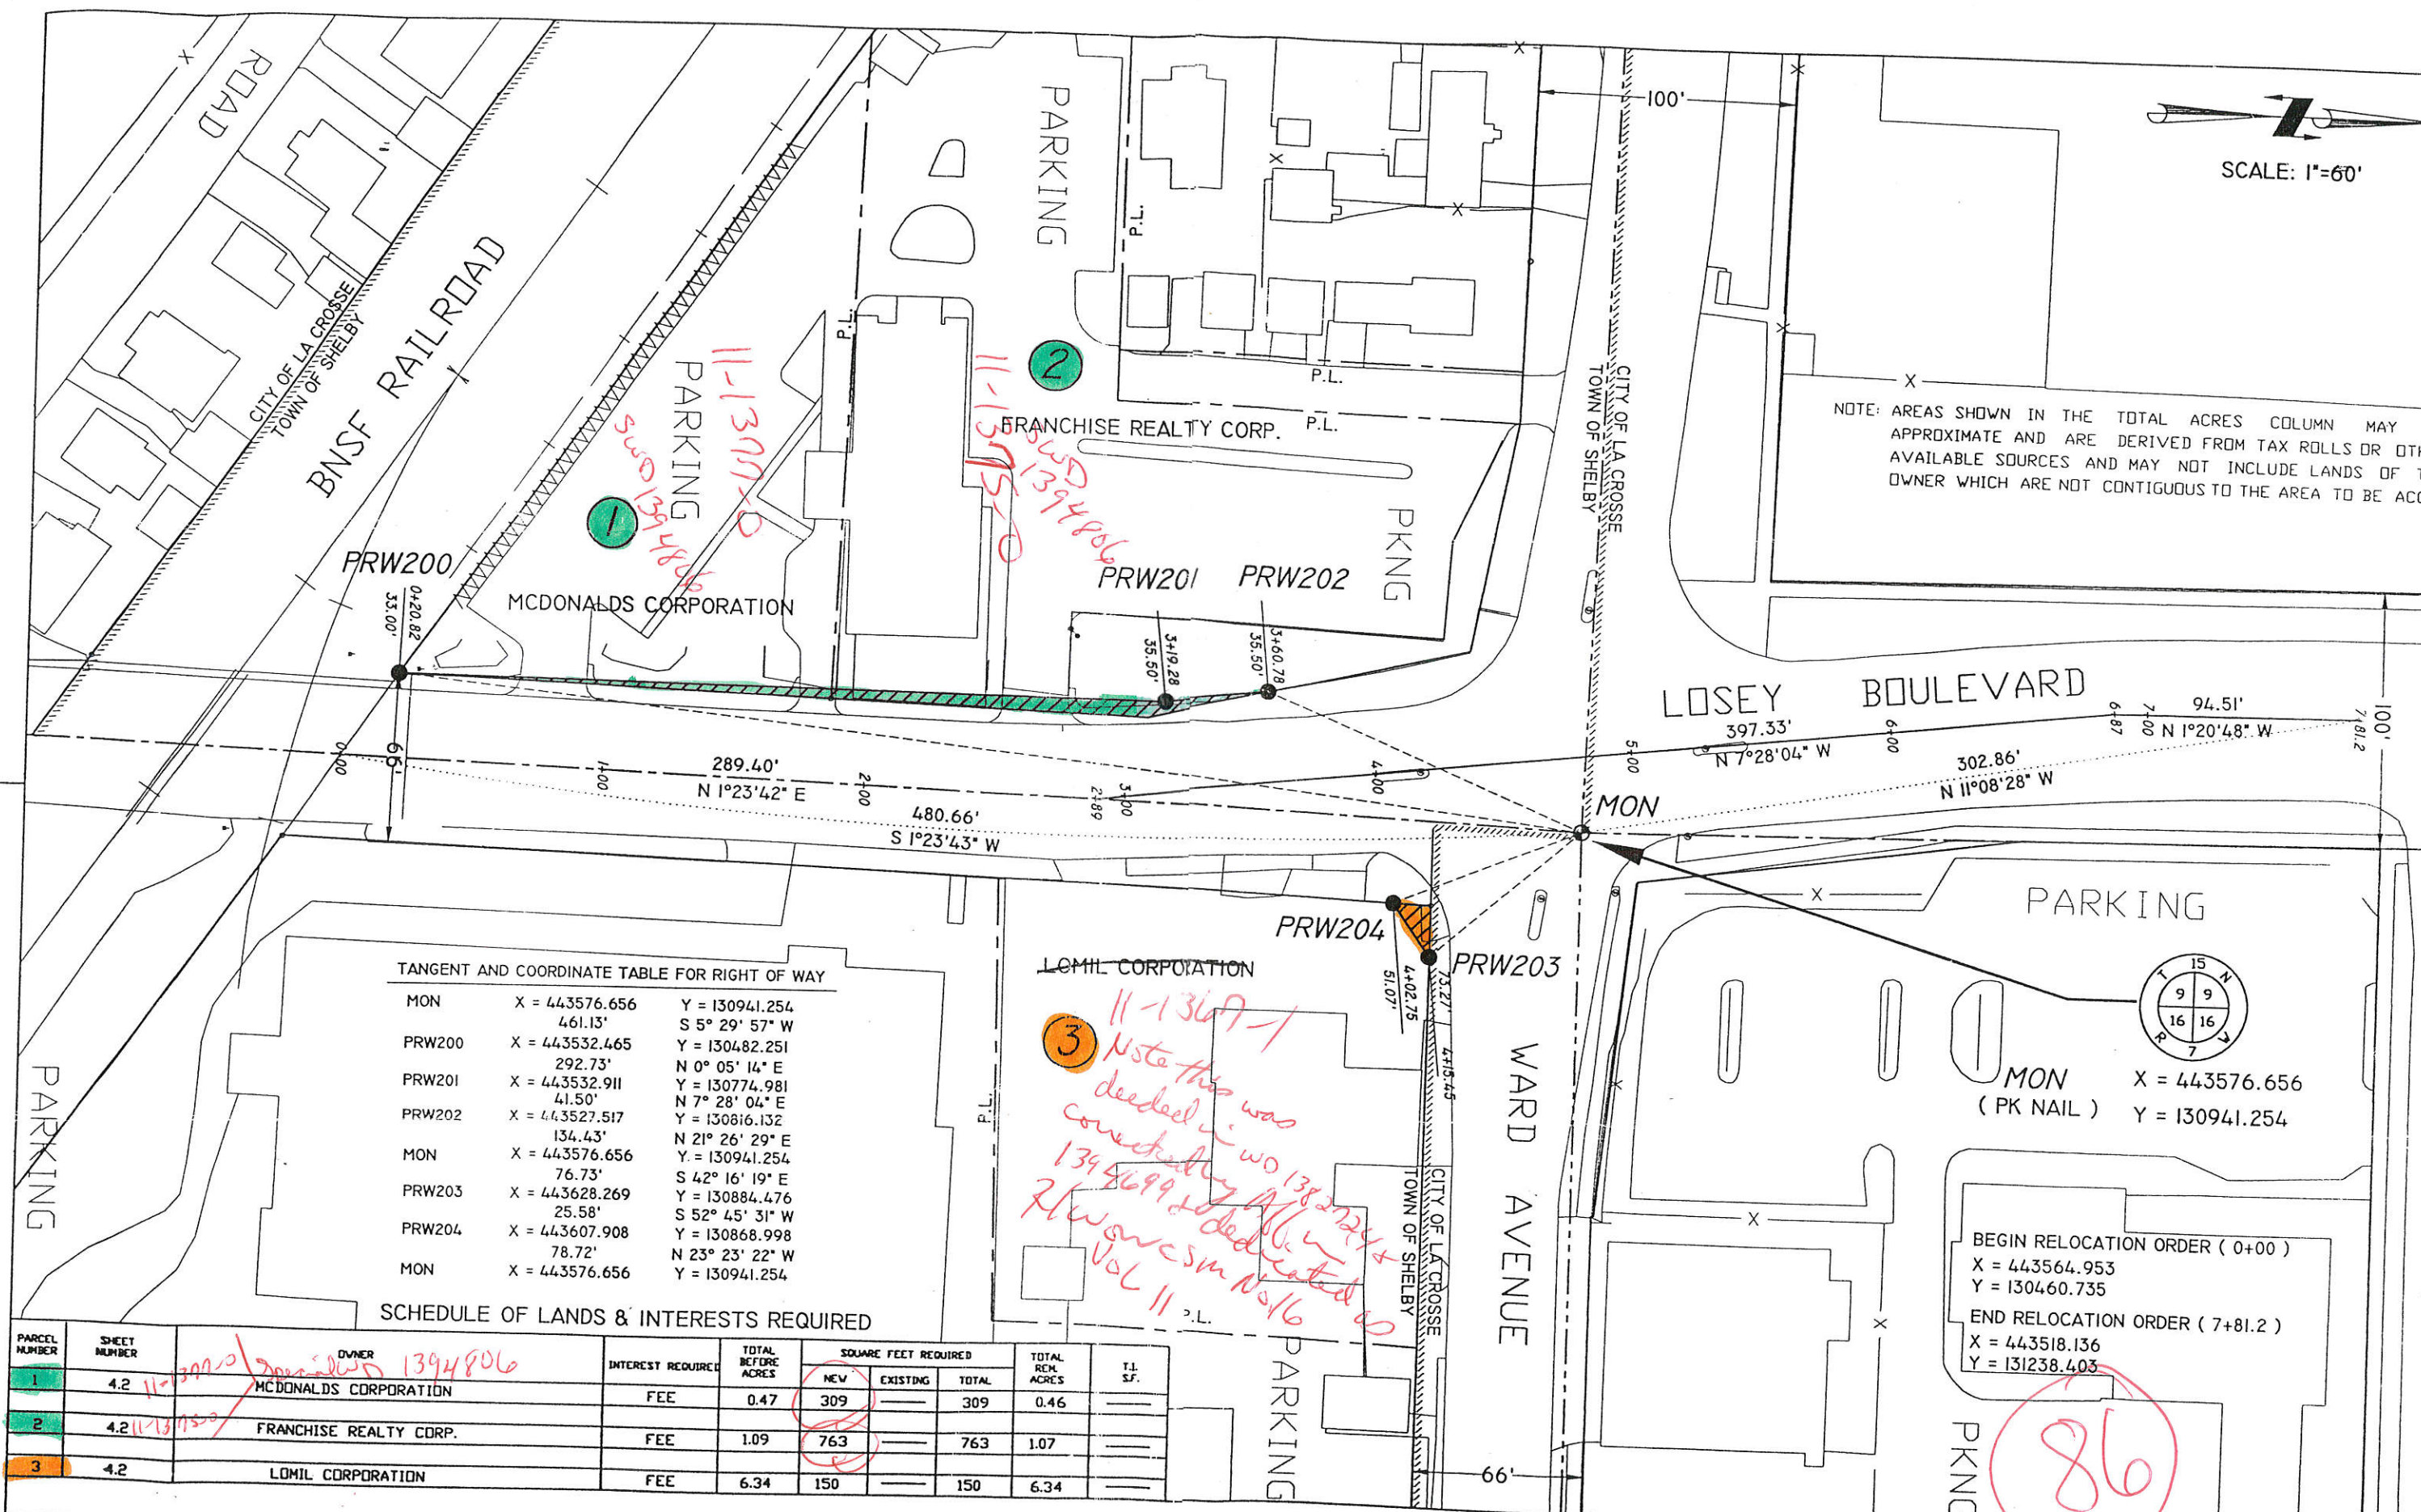

NOTE: AREAS SHOWN IN THE TOTAL ACRES COLUMN MAY BE APPROXIMATE AND ARE DERIVED FROM TAX ROLLS OR OTHER AVAILABLE SOURCES AND MAY NOT INCLUDE LANDS OF THE OWNER WHICH ARE NOT CONTIGUOUS TO THE AREA TO BE ACQUIRED.



TANGENT AND COORDINATE TABLE FOR RIGHT OF WAY

Point	X	Y	Bearing
MON	443576.656	130941.254	
PRW200	443532.465	130482.251	S 5° 29' 57" W
PRW201	443532.911	130774.981	N 0° 05' 14" E
PRW202	443527.517	130816.132	N 7° 28' 04" E
MON	443576.656	130941.254	N 21° 26' 29" E
PRW203	443628.269	130884.476	S 42° 16' 19" E
PRW204	443607.908	130868.998	S 52° 45' 31" W
MON	443576.656	130941.254	N 23° 23' 22" W

SCHEDULE OF LANDS & INTERESTS REQUIRED

PARCEL NUMBER	SHEET NUMBER	OWNER	INTEREST REQUIRED	TOTAL BEFORE ACRES	SQUARE FEET REQUIRED			TOTAL REM. ACRES	T.I. SF.
					NEW	EXISTING	TOTAL		
1	4.2	MCDONALDS CORPORATION	FEE	0.47	309		309	0.46	
2	4.2	FRANCHISE REALTY CORP.	FEE	1.09	763		763	1.07	
3	4.2	LOMIL CORPORATION	FEE	6.34	150		150	6.34	

MON (PK NAIL) X = 443576.656 Y = 130941.254

BEGIN RELOCATION ORDER (0+00)
 X = 443564.953
 Y = 130460.735
 END RELOCATION ORDER (7+81.2)
 X = 443518.136
 Y = 131238.403

86

STATE PROJECT NUMBER: 5991-07-08 HWY: LOSEY BOULEVARD COUNTY: LA CROSSE

FILE NAME: \\s...designfile...\$\$. PLOT DATE: ...\$\$. PLOT BY: ...\$\$. PLOT NAME: ...\$\$. ORG DATE: ...\$\$. DRIGNATOR: ...\$\$. PLOT SCALE: ...\$\$. SHEET NO: 4.2