


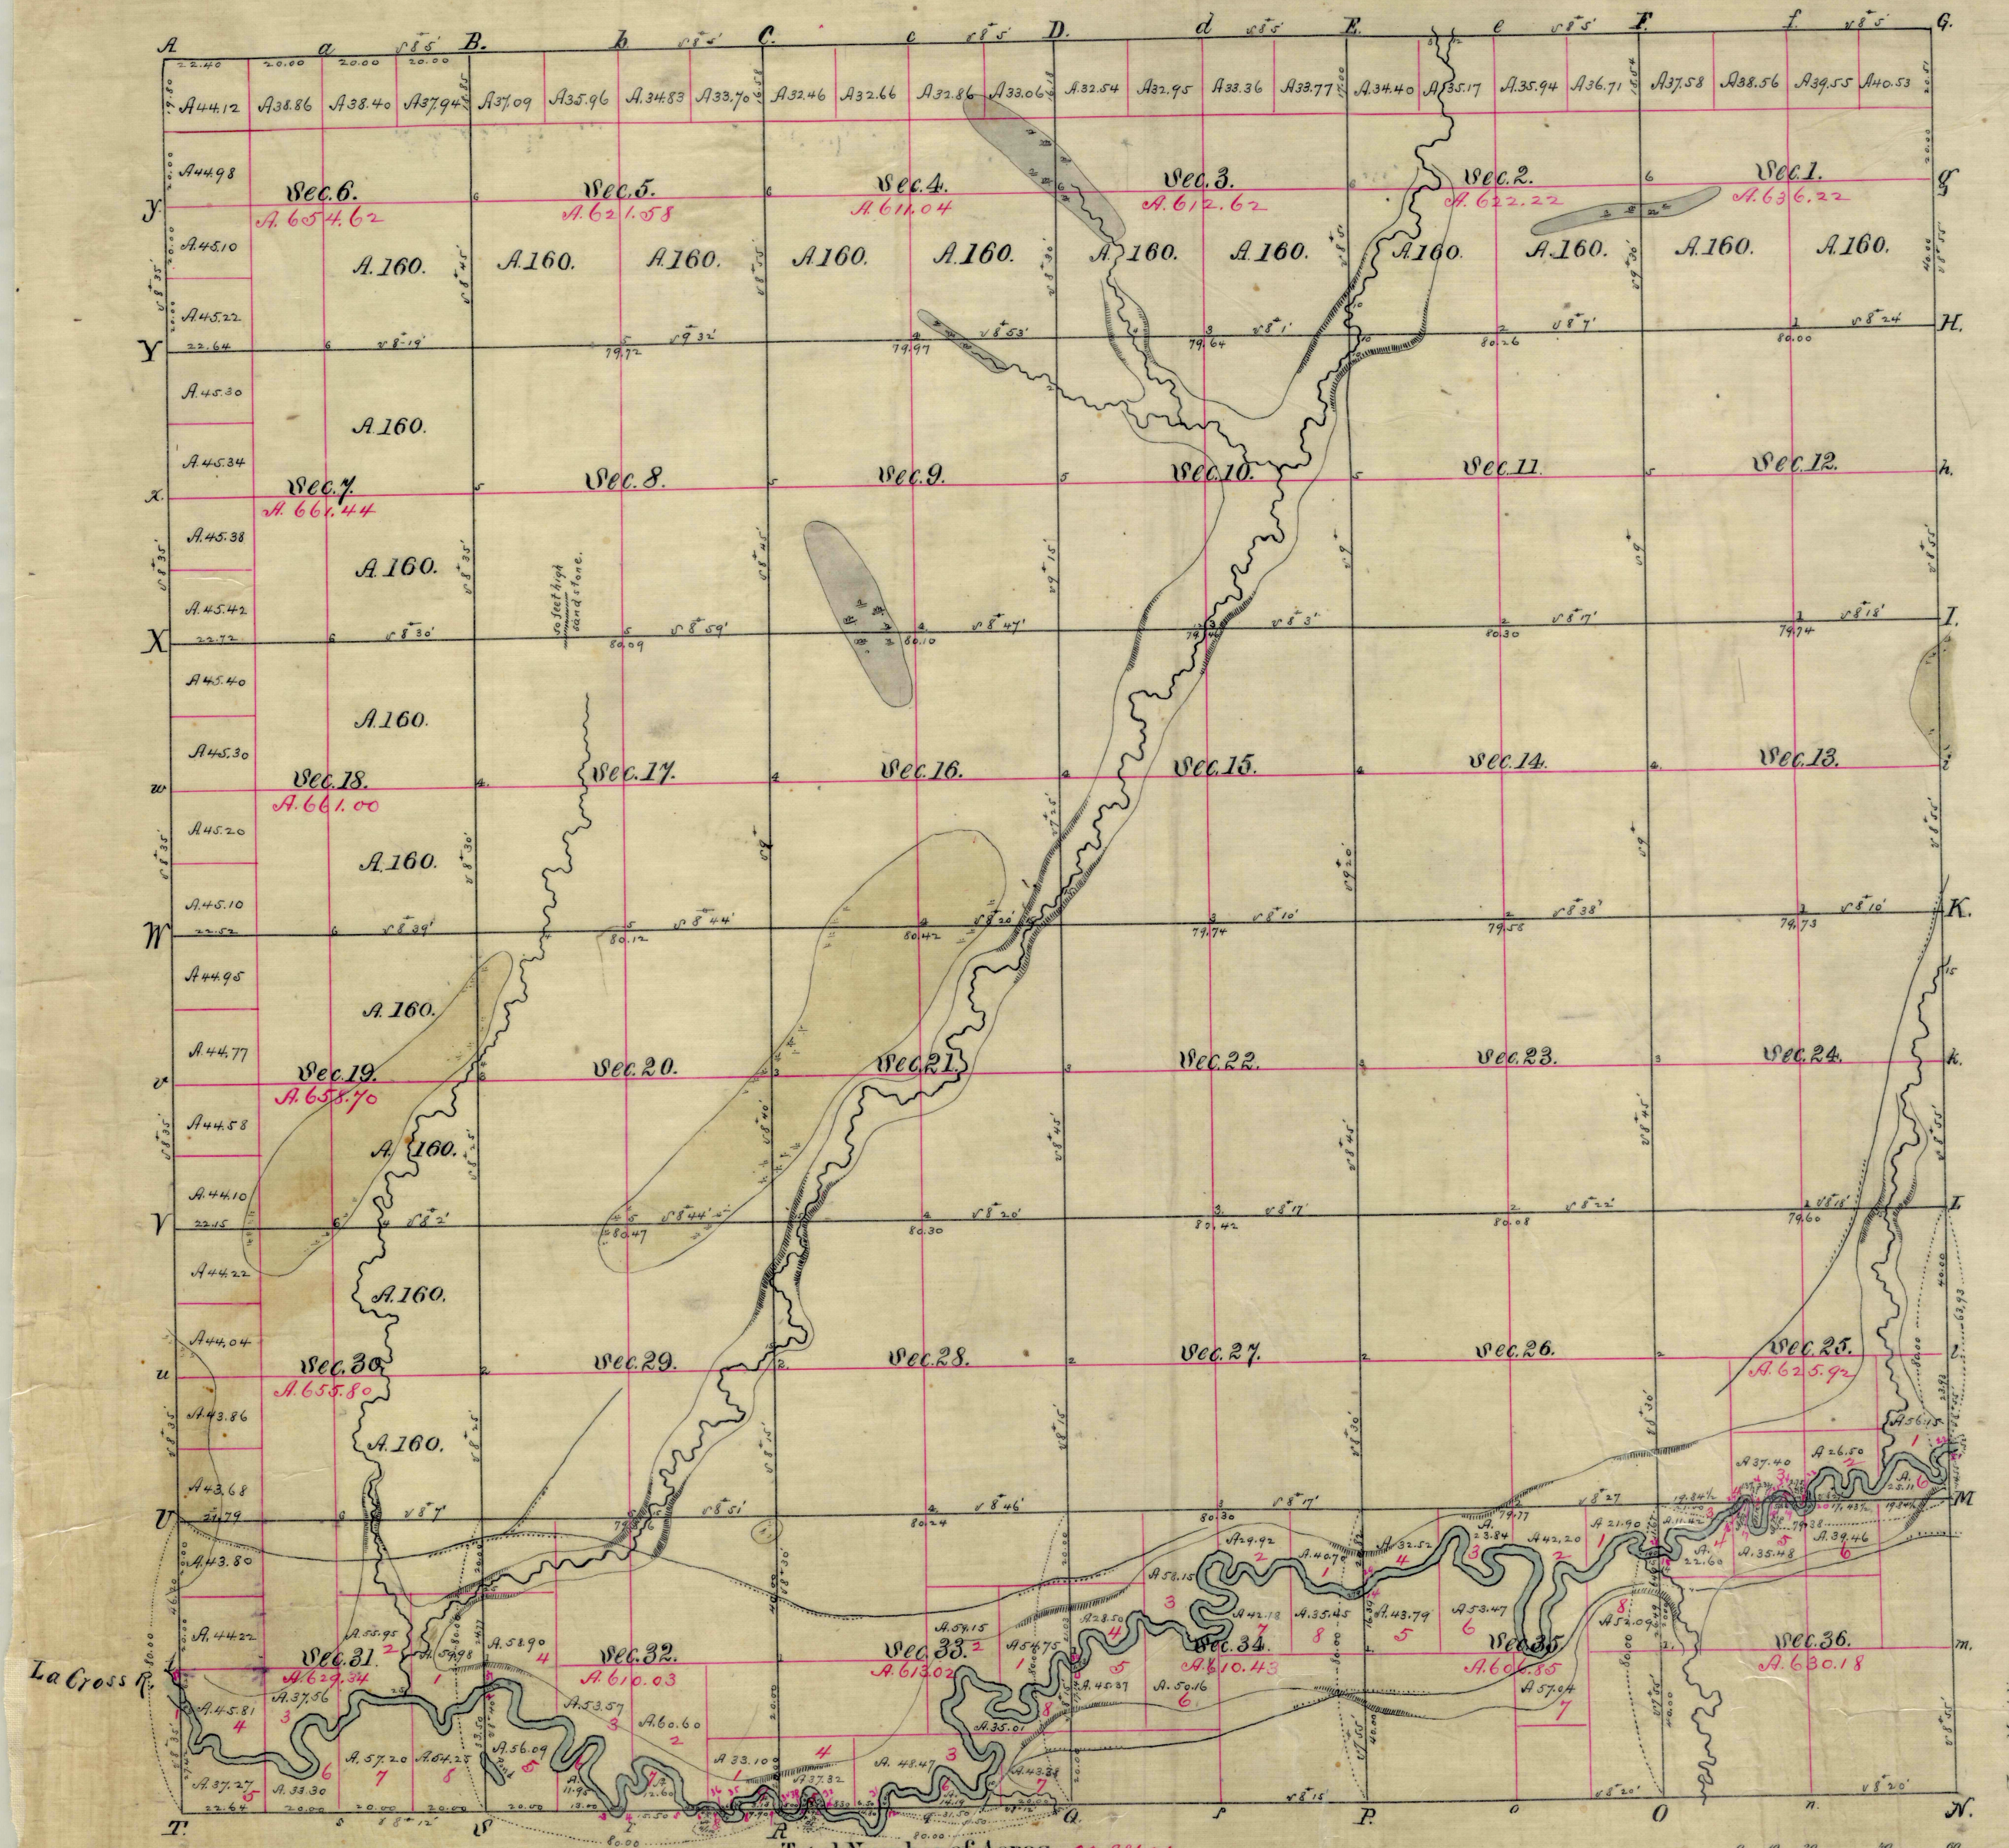

Total Number of Acres - 22,811.01

Surveys Designated.	By Whom Surveyed.	Date of Contract.	Amount of Survey M. Chs. Lks.	When Surveyed.	When Charged in the Sur. Gen. Acct.
Township lines	Leah Biggs.	Aug. 16 th 1845	24. 05. 30	November 1845	
Subdivisions	H. C. Whitteide	Dec. 5 th 1846	85. 03. 69	Feb. + March 1847	

The above map of Township No 17 North of Range No 5 West, 4th Principal Meridian, Wisconsin Territory, is strictly conformable to the field notes of the survey thereof on file in this Office which have been examined and approved.
Surveyor General's Office
Dubuque June 30th 1847
Geo. W. Jones
Sur. Genl.

Meanders of La Crosse River												
Rebs	Courses	Of LH	Rebs	Courses	Of LH	Rebs	Courses	Of LH	Rebs	Courses	Of LH	
Left bank up stream												
1	X 47	5.00	X 20	1.00	X 73	1.50	X 68	3.00	X 38	2.00	X 24	1.50
	X 24 1/2	1.50	X 39 1/2	2.00	X 39 1/2	4.00	X 41 1/2	6.00	X 37	1.00	X 37	1.00
	X 54 1/2	2.50	X 17 1/2	3.00	X 45 1/2	1.00	X 74 1/2	2.00	X 37 1/2	1.50	X 37 1/2	1.50
	X 40 1/2	2.50	X 68 1/2	3.00	X 45 1/2	3.50	X 74 1/2	3.50	X 37 1/2	1.50	X 37 1/2	1.50
	X 54 1/2	2.50	X 31 1/2	1.50	X 72 1/2	2.00	X 43 1/2	1.00	X 37 1/2	1.50	X 37 1/2	1.50
