


Township No. 18, North of Range No. 5 West, of 4th Meridian.

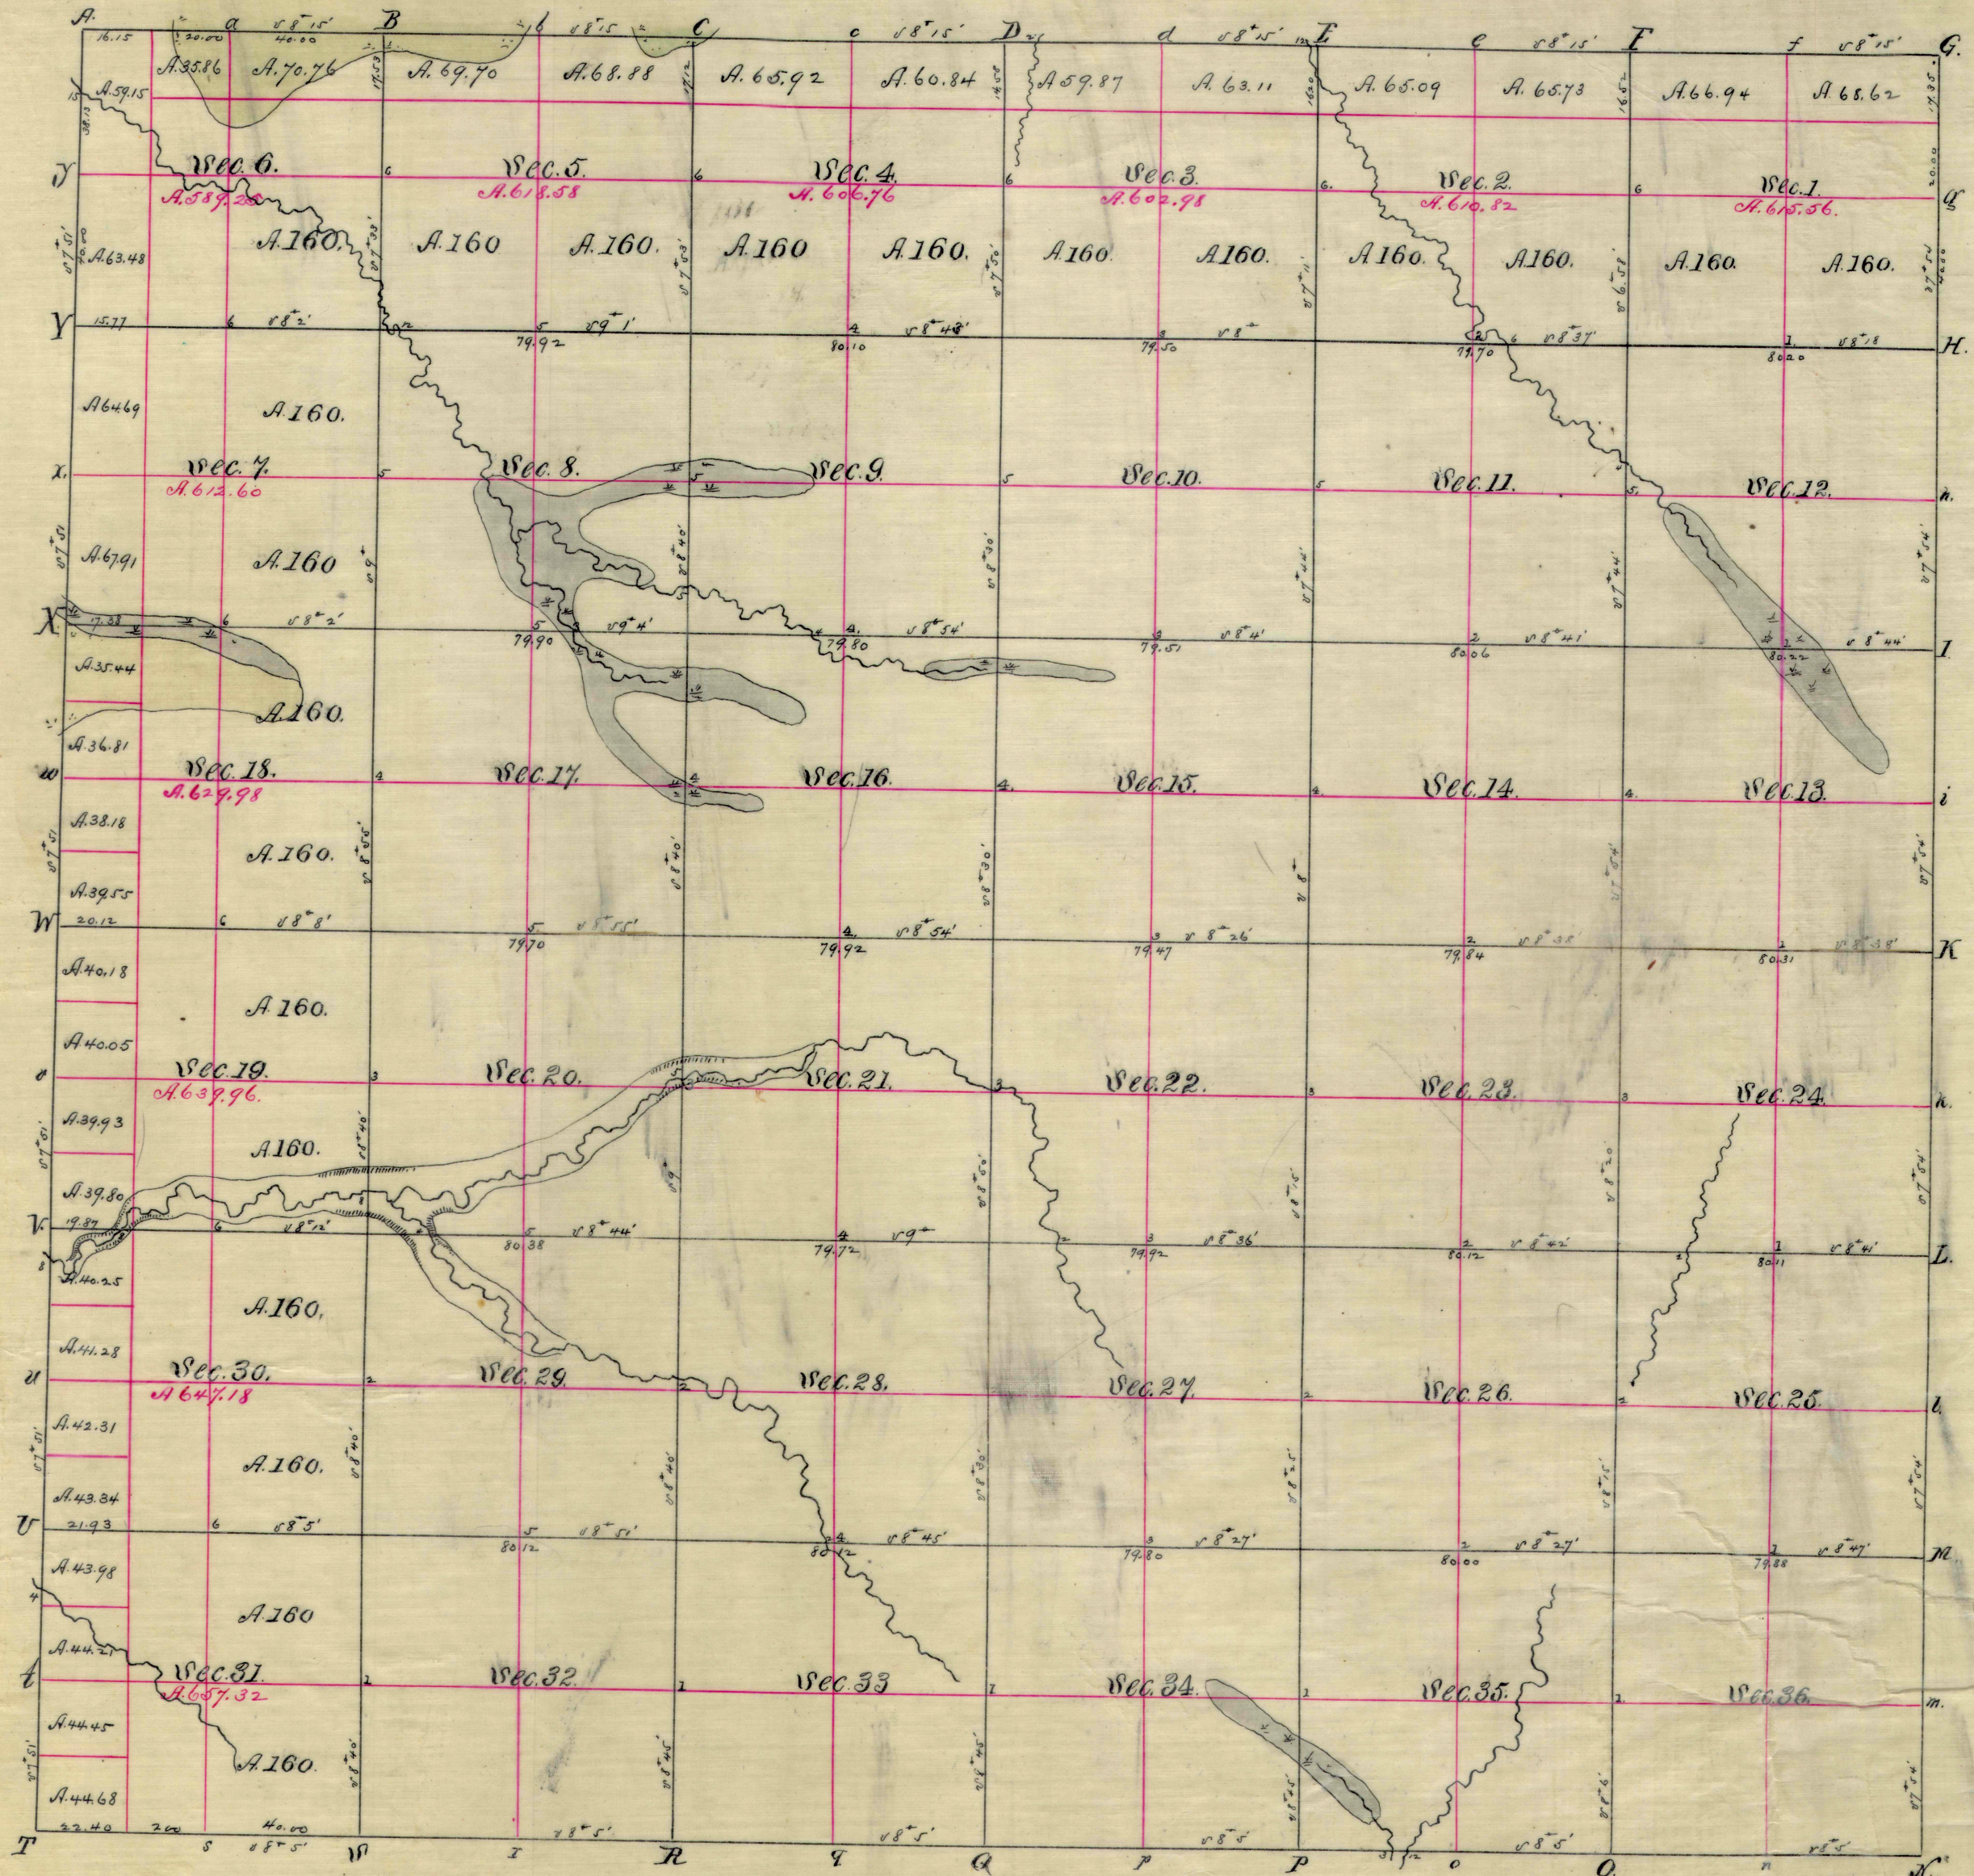

Total Number of Acres - 22,830.99

Surveys Designated	By Whom Surveyed	Date of Contract	Amount of Survey M. Chs. Lks.	When Surveyed	When Charged in the Sur. Gen. Acct.
Township lines.	James E. Freeman	September 4, 1845	17 " 71 " 63	November 1845	
"	Rich. Briggs	August 16, 1845	6 " 02 " 40	November 1845	
Subdivisions.	H. C. Whitridge	December 5, 1846	29 " 55 " 34	March 1847	

The above map of Township No. 18 North of Range No. 5 West 4th Principal Meridian Wisconsin Territory is drawn conformable to the field notes of the survey thereof on file in this Office which have been examined and approved.
Surveyor General's Office
Dubuque June 30th 1847

Jos. W. Jones.
Sur. Genl.

The State of Wisconsin
Department of Public Lands
To All to Whom These Presents shall Come, Greeting
We, John M. Ewing, Chief Clerk of the Land Department of the State of Wisconsin do hereby certify that this copy of plat of Township No. 18 North of Range No. 5 West of 4th Meridian has been duly compared by me with the original plat in this Department and that the same is a true copy thereof and of the whole of such original.
In Testimony whereof I have hereunto set my hand and affixed the official seal of the Commissioners of the Public Lands at the Capitol in the City of Madison this 30th day of June A.D. 1870



John M. Ewing
Chief Clerk