


Township No. 15, North of Range No. 6 West, of 4th Meridian.

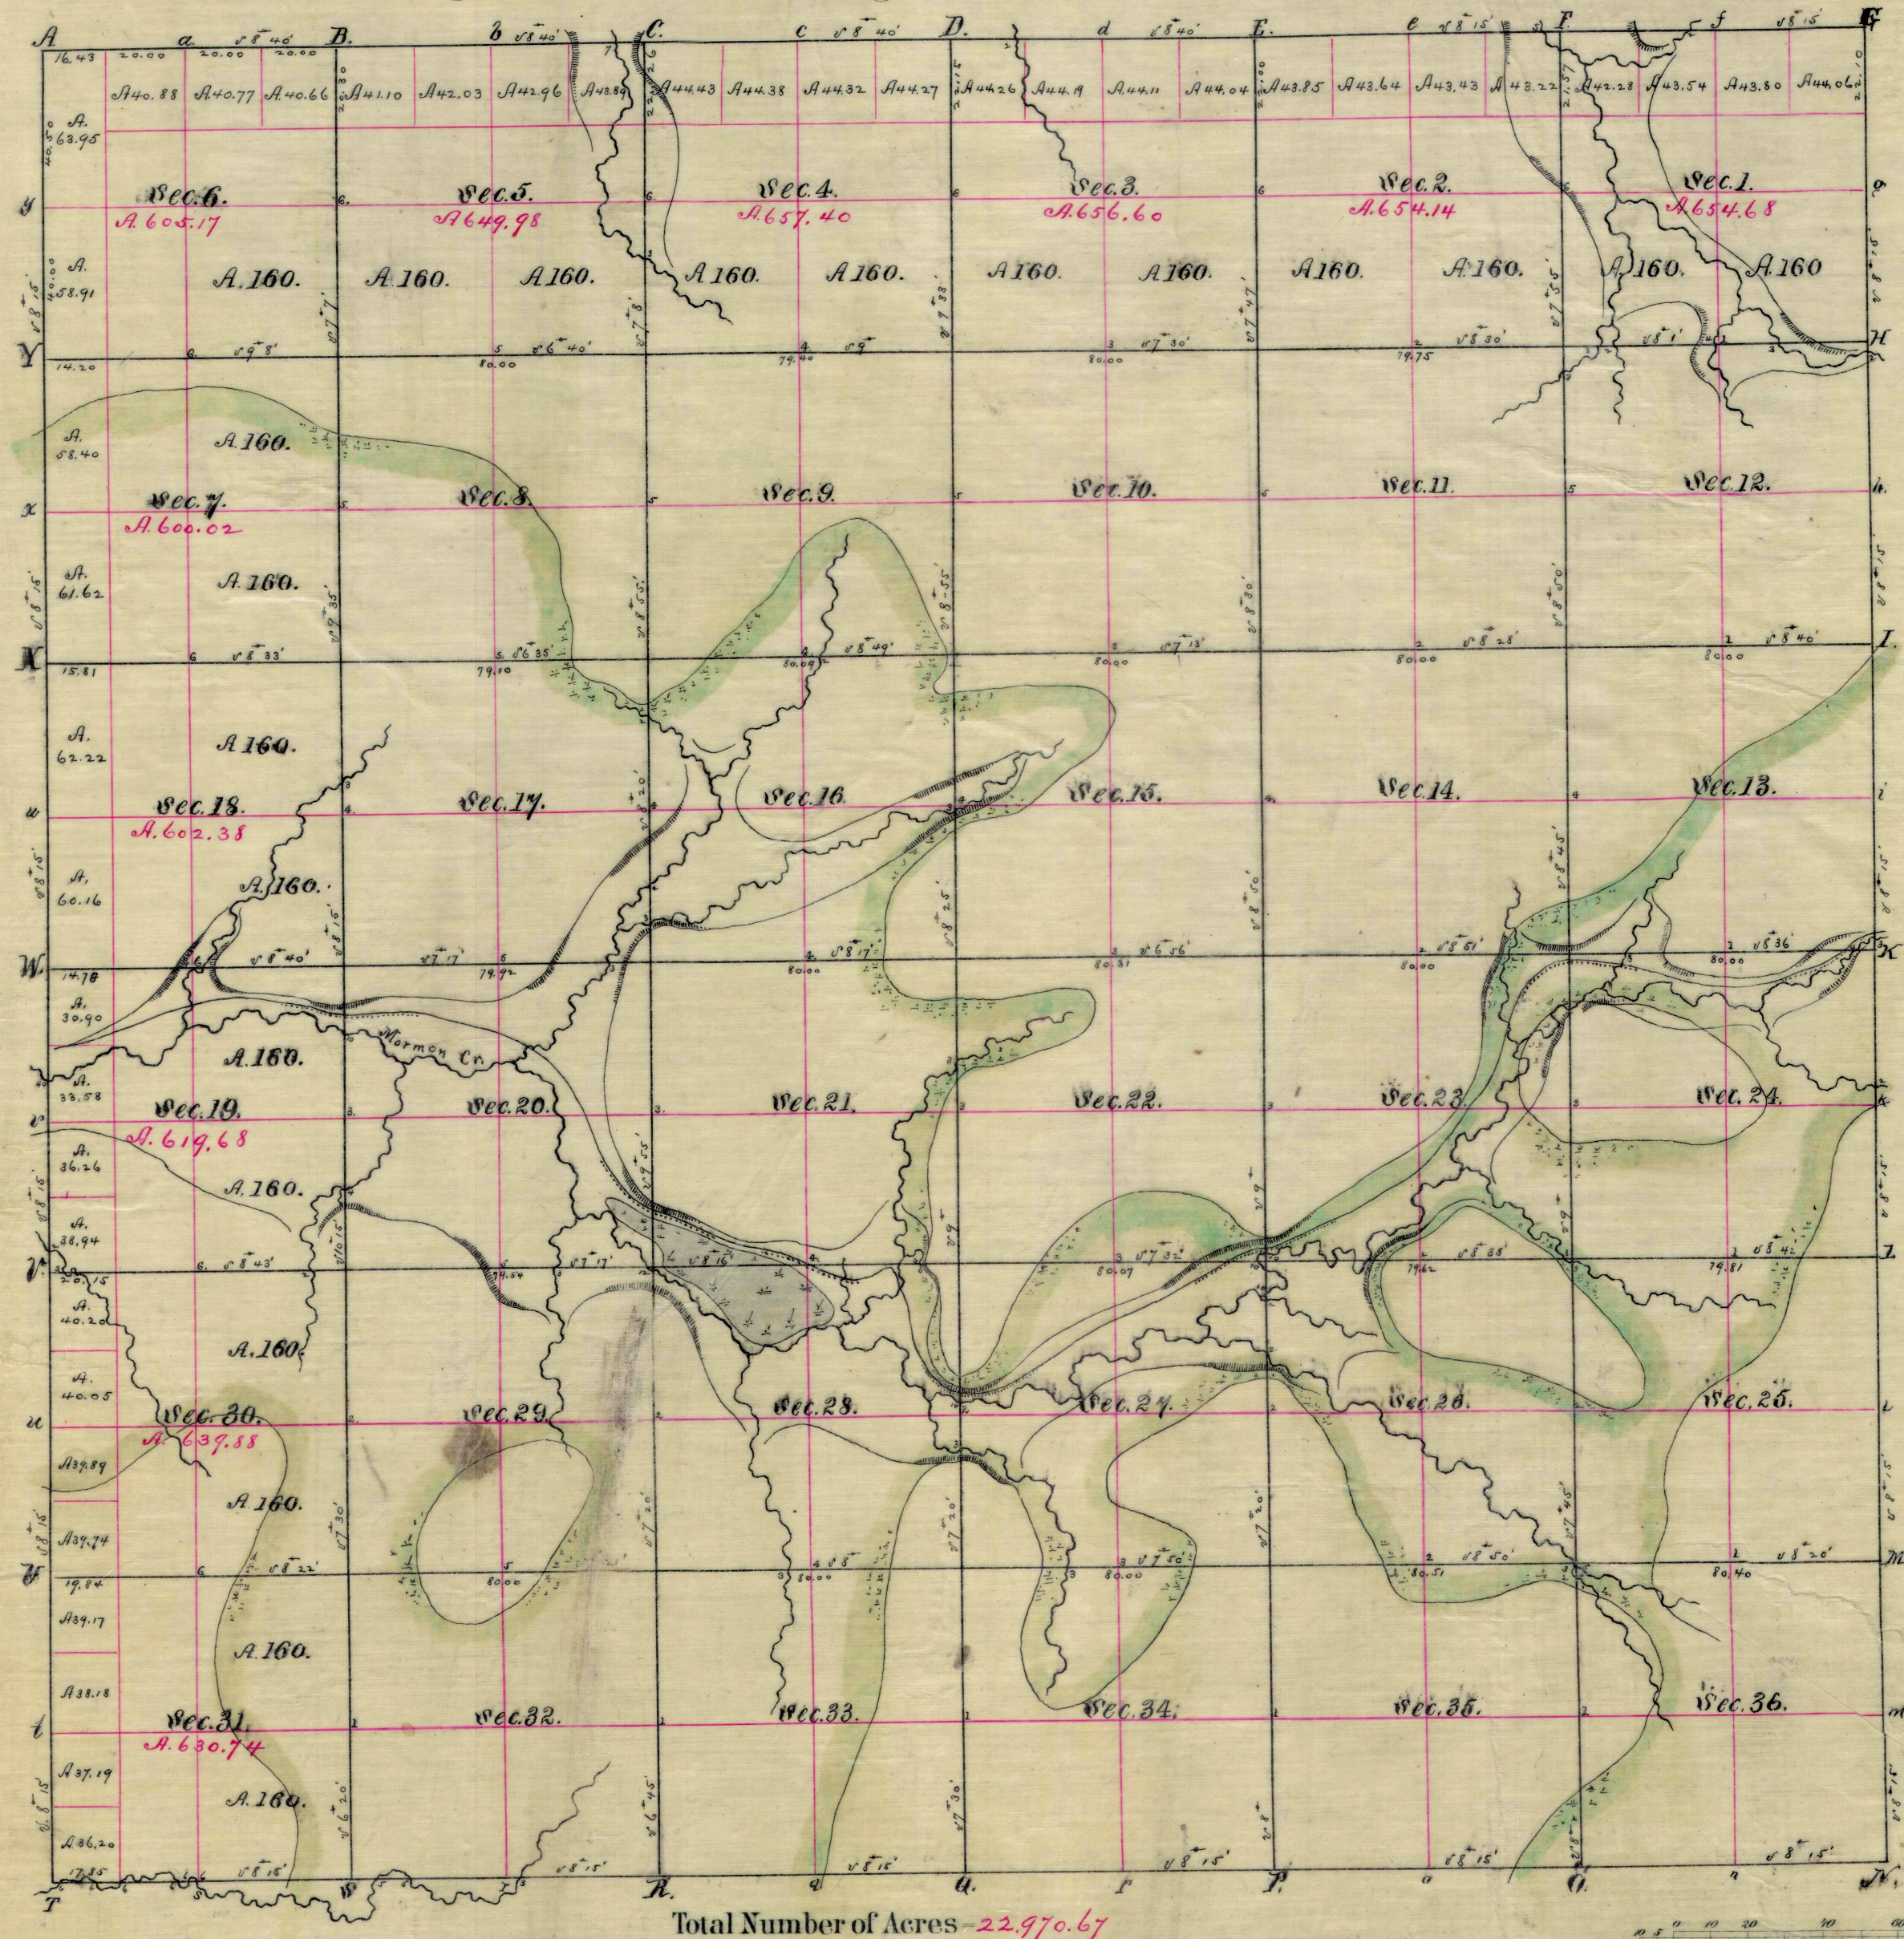

Total Number of Acres - 22,970.67

Surveys Designated.	By Whom Surveyed.	Date of Contract.	Amount of Survey M. Chs. Lks.	When Surveyed.	When Charged in the Sur. Gen. Acct.
Township lines.	Uriah Biggs.	August 16 th 1845	23. 76. 88	Oct & Nov. 1845	
Subdivisions.	A. L. Brown	October 9 th 1846	59. 71. 18	November 1846	

The above Map of Township No. 15 North of Range No. 6 West 4th Principal Meridian Wisconsin Territory is strictly conformable to the field notes of the survey thereof on file in this Office which have been examined and approved.
Surveyor General's Office
Dubuque, April 8th 1847
Geo. W. Jones
Sur. Genl.

The State of Wisconsin
Department of Public Lands
To All to Whom These Presents shall Come, Greeting
I, John H. Ewing, Chief Clerk of the Land Department of the State of Wisconsin do hereby certify that this copy of plat of Township No. 15 North of Range No. 6 West of 4th Meridian has been duly compared by me with the original plat in this Department and that the same is a true copy thereof and of the whole of such original.
In Testimony whereof, I have hereunto set my hand and affixed the official seal of the Commissioners of the Public Lands at the Capitol in the City of Madison this 30th day of June A.D. 1870.
John H. Ewing
Chief Clerk