


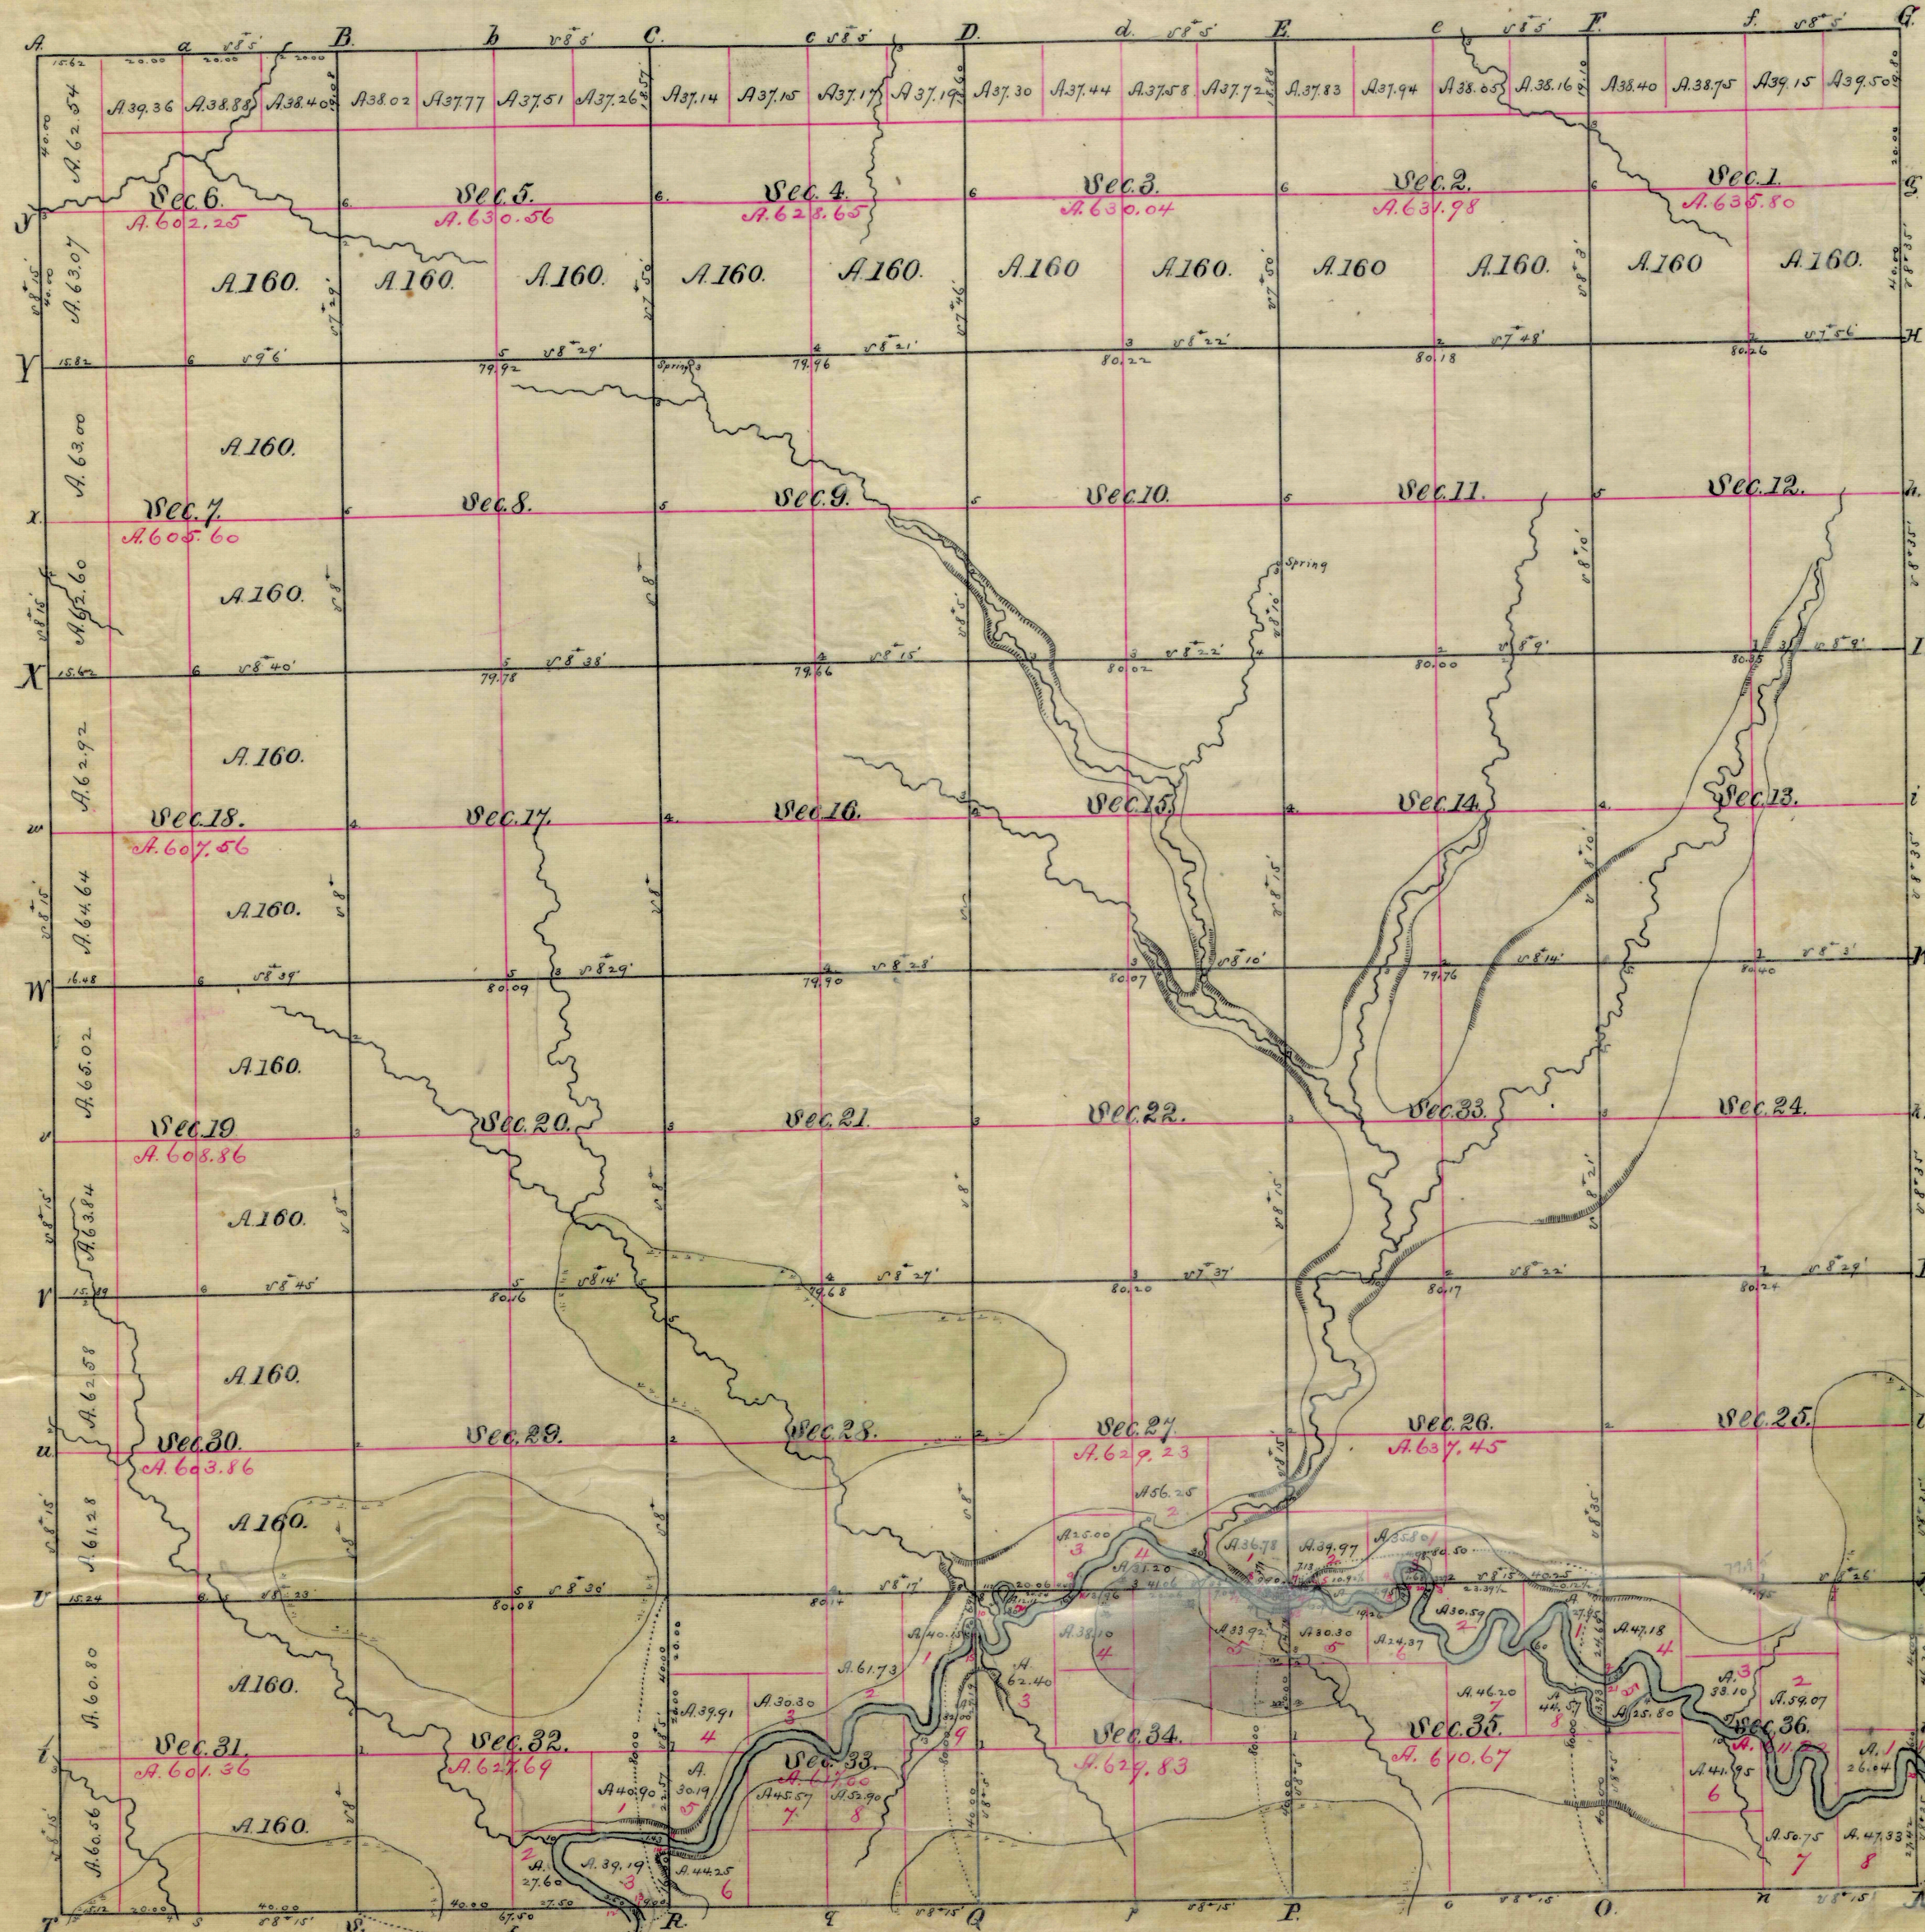

Total Number of Acres 22,669.61

Surveys Designated	By Whom Surveyed	Date of Contract	Amount of Survey M. Chs. Lks.	When Surveyed	When Charged in the Sur. Gen. Acct.
Township lines	Ursah Briggs	Aug 16 th 1845	23. 70. 54	November 1845	
Subdivisions	T. E. Whitely	Decem 5 th 1846	75. 08. 87	February 1847	

The above Map of Township No. 17 North of Range No. 6 West 4th Principal Meridian Wisconsin Territory is strictly conformable to the field notes of the survey thereof on file in this Office which have been examined and approved.
 Surveyor General's Office
 Dubuque June 30th 1847
 Geo. W. Jones
 Sur. Gen.

Meanders of LaCross River											
Runs	Courses	Ch ²	Runs	Courses	Ch ²	Runs	Courses	Ch ²	Runs	Courses	Ch ²
Rightly down stream.						Leftly up stream.					
1	X 46 1/2 N	2.00	4	X 14 N	2.50	13	X 62 N	6.00	19	X 53 E	3.00
	X 81 1/2 N	2.50		X 52 N	2.50		X 63 E	2.00		X 63 E	2.00
	X 33 N	2.00		X 73 N	4.00		X 71 E	2.00		X 71 E	2.00
	X 8 N	1.50		X 69 N	3.00		X 48 N	3.50		X 71 E	2.00
	X 35 E	2.63		X 8 N	2.50		X 13 E	5.00		X 17 N	3.00
