


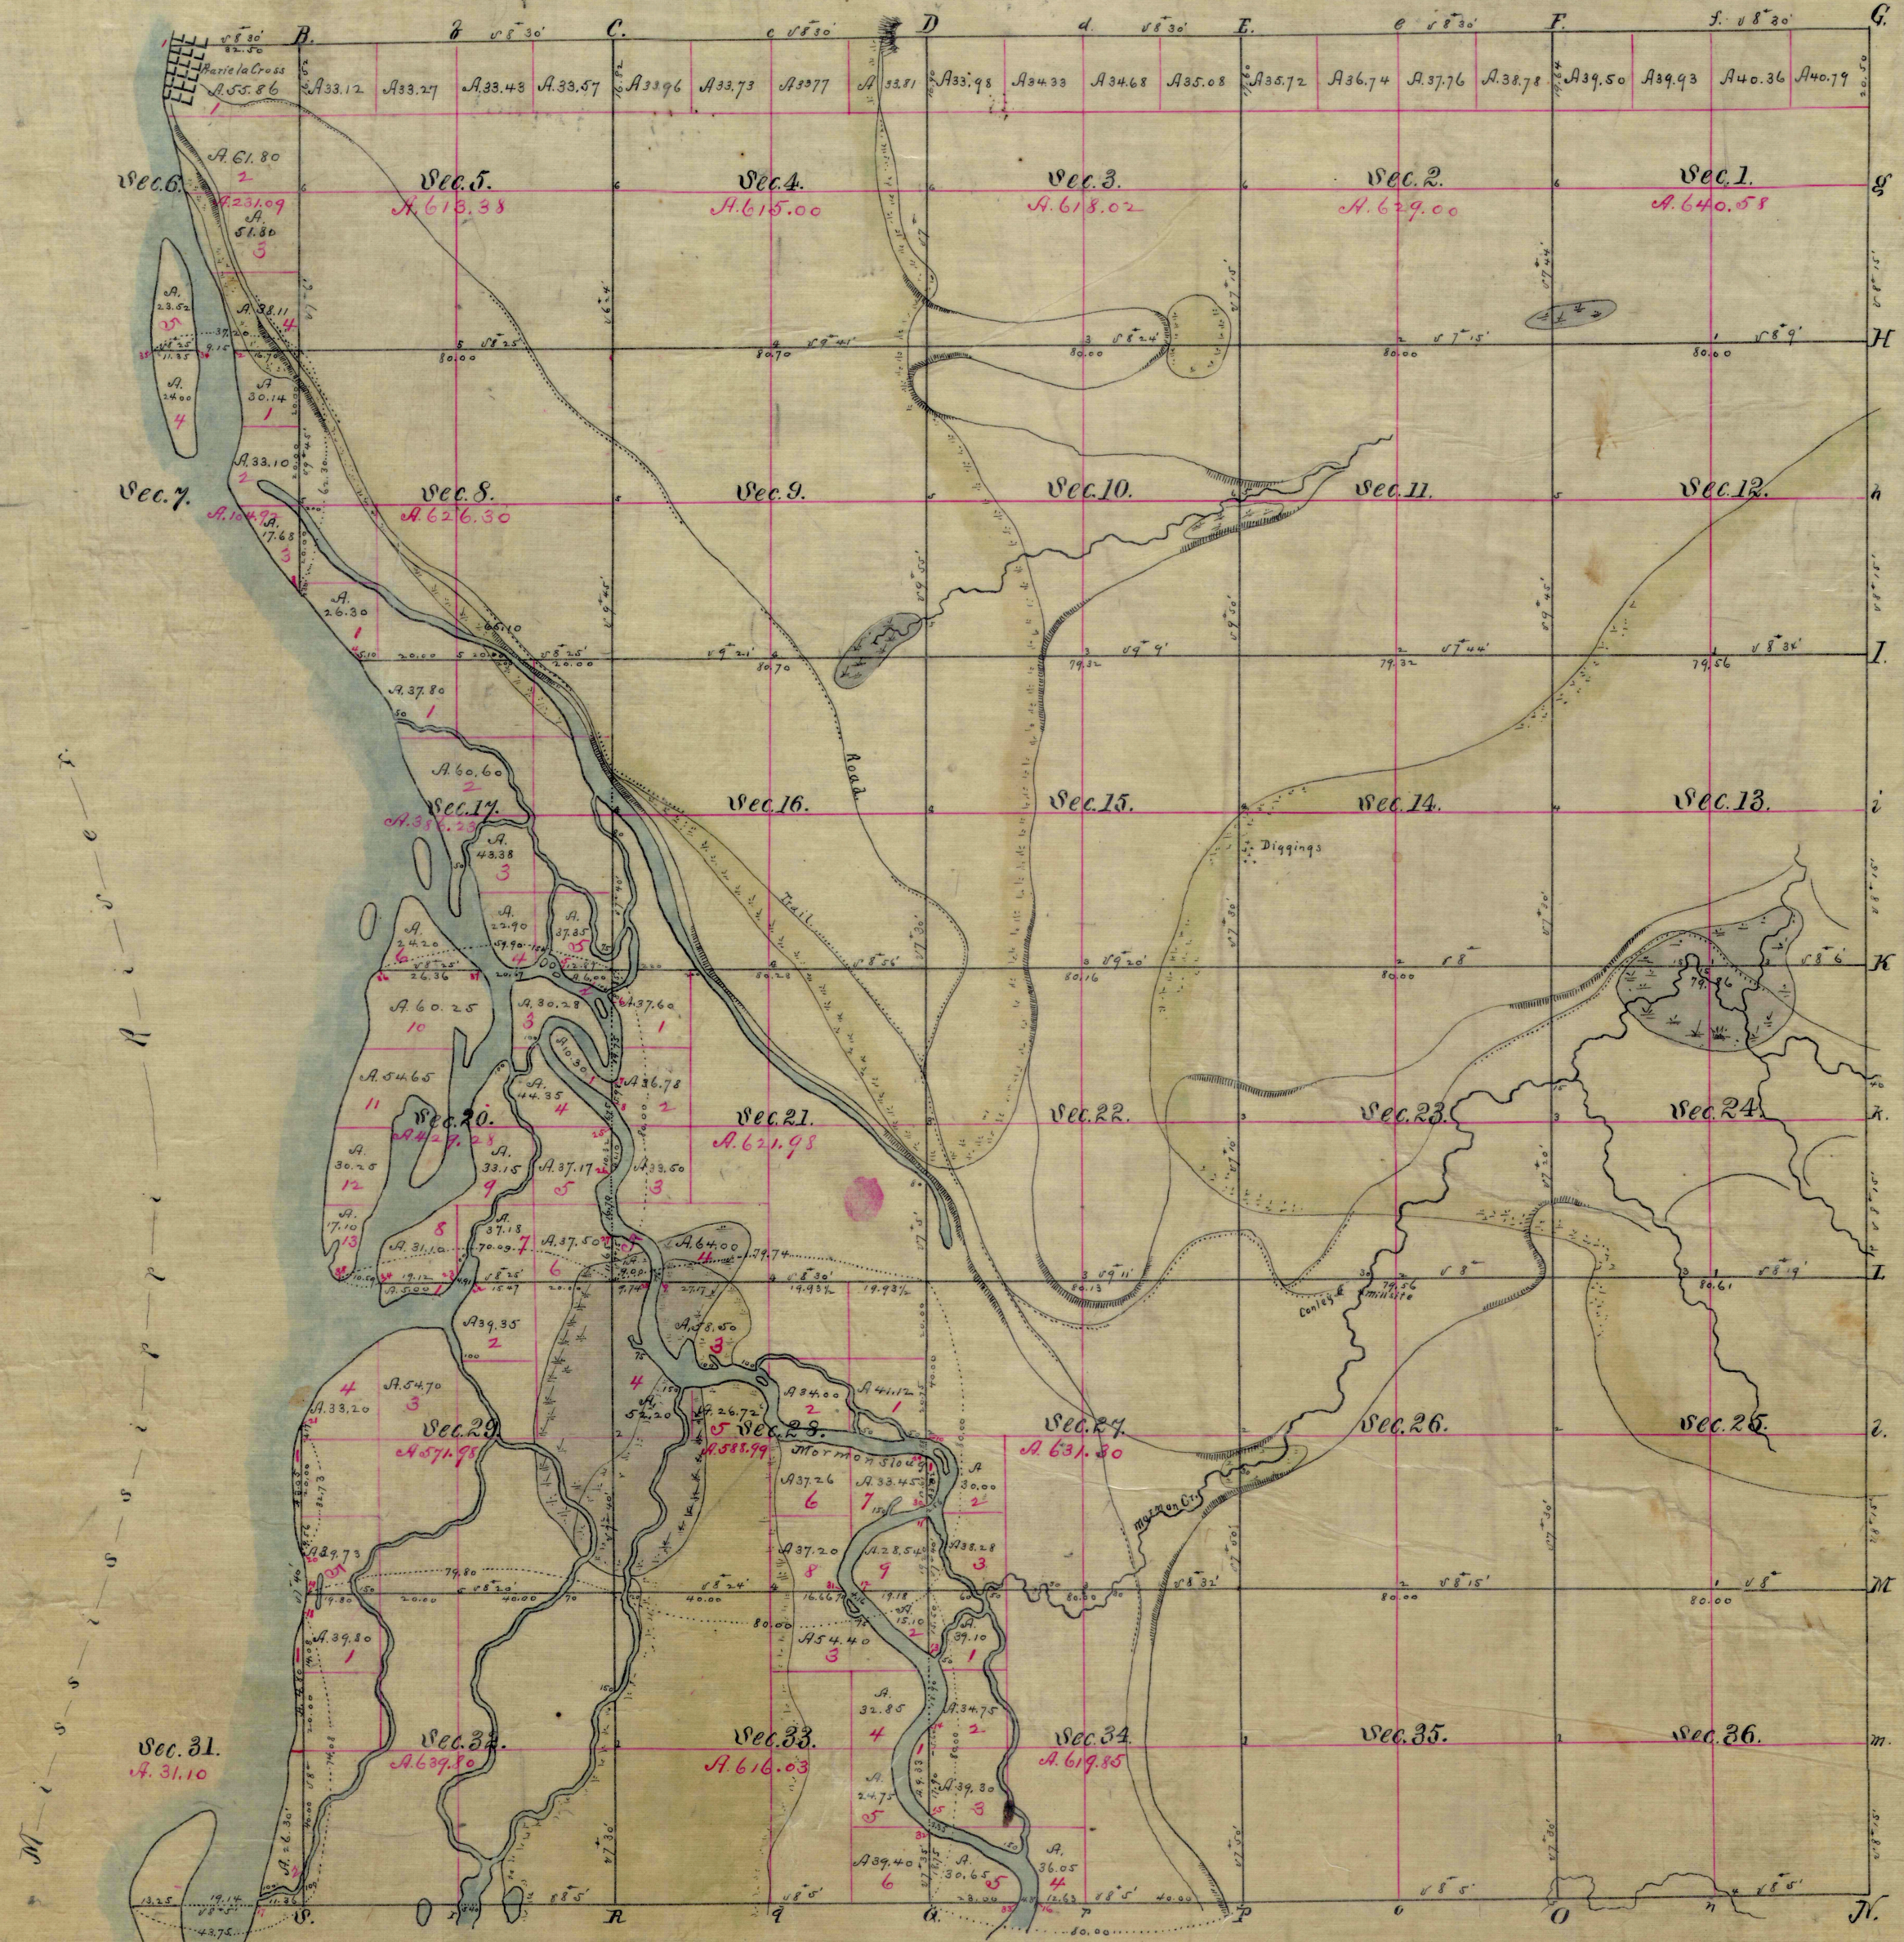

Total Number of Acres = 18,817.88

Surveys Designated.	By Whom Surveyed.	Date of Contract.	Amount of Survey M. Chs. Lks.	When Surveyed.	When Charged in the Sur. Gen. Acct.
Township lines.	Ursah Biggs	Aug. 16 th 1845	16 75 76	Dec + Nov. 1845	
Subdivisions.	A. L. Brown	Oct. 9 th 1846	75 50 04	Dec - 1846	

The above Map of Township No 15 North of Range No 7 West 4th Principal Meridian Wisconsin Territory is strictly conformable to the field notes of the survey thereof on file in this Office which have been examined and approved.
Surveyor General's Office
Dubuque April 8th 1847
Geo. W. Jones.

Meanders of			
Runs	Courses	Dist.	Remarks
1	S 12° E	6.00	Left bank of Miss. River
2	S 2° E	13.00	Right bank of Morran Slough
3	S 13° E	22.50	
4	S 5° E	5.00	
5	S 10° E	2.94	
6	S 12° E	12.00	
7	S 6° E	14.00	
8	S 18° E	9.50	
9	S 34° E	12.50	
10	S 45° E	12.00	
11	S 43° E	12.00	
12	S 37° E	7.50	
13	S 26° E	8.50	
14	S 13° E	1.50	
15	S 4° E	3.02	
16	S 33° E	14.50	
17	S 17° E	12.00	
18	S 22° E	3.50	
19	S 28° E	14.00	
20	S 30° E	14.50	
21	S 25° E	9.50	
22	S 25° E	4.00	
23	S 25° E	4.00	
The State of Wisconsin
Department of Public Lands
To All to Whom These Presents Shall Come, Greeting
I, John H. Cowan, Chief Clerk of the Land Depart-
ment of the State of Wisconsin do hereby certify that a copy of plat of
Township No 15 North of Range No 7 West of 4th Meridian
has been duly compared by me with the original plat on file in this Department
and that the same is a true copy thereof.
In Testimony whereof, I have hereunto
set my hand and the official seal of the Public Lands
at the Capital City of Wisconsin, this 30th day of June 1847.
John H. Cowan, Chief Clerk.