


Meanders of Black River

Posts	Courses	Chs.
Left bank down stream		
9	N 71° W	3.76
	N 60° W	22.10
	N 52° W	5.38
	N 89° W	22.30
	N 46 1/2° W	8.78
	N 20° W	6.65
	N 2 1/2° W	6.06
10	N 61° W	15.50
	S 86 1/2° W	8.38
	S 80° W	7.62
	S 52° W	5.84
	S 55 1/4° W	3.32
12	S 33 1/2° W	4.70
	S 53 1/2° W	5.98
	S 80° W	4.05
	N 77° W	5.50
	S 62 1/2° W	6.68
	N 81 1/4° W	16.50
	N 62 3/4° W	3.85
	N 44° W	3.68
	N 7° W	3.00
13	N 24° E	7.62
	N 51 1/4° W	8.97
	S 88 1/4° W	11.76
	S 55 1/4° W	4.16
	S 36° W	1.46
14	S 44° W	4.25
	S 71° W	5.86
	N 76° W	4.56
	N 44 1/2° W	4.75
	N 17 1/2° W	6.18
	S 56° W	3.78
	S 36° W	7.88
	S 20° W	5.60
15	S 6 1/2° E	10.87
	S 13° W	3.84
	S 3° E	4.38
	S 2 1/2° W	16.50
	S 15° W	12.10
	S 49 1/2° W	6.87
	S 70 1/4° W	7.34
	N 76° W	5.56
	S 79° W	6.16
	S 59° W	6.08
	S 14° W	8.68
	S 2 1/2° E	10.80
16	South	3.60

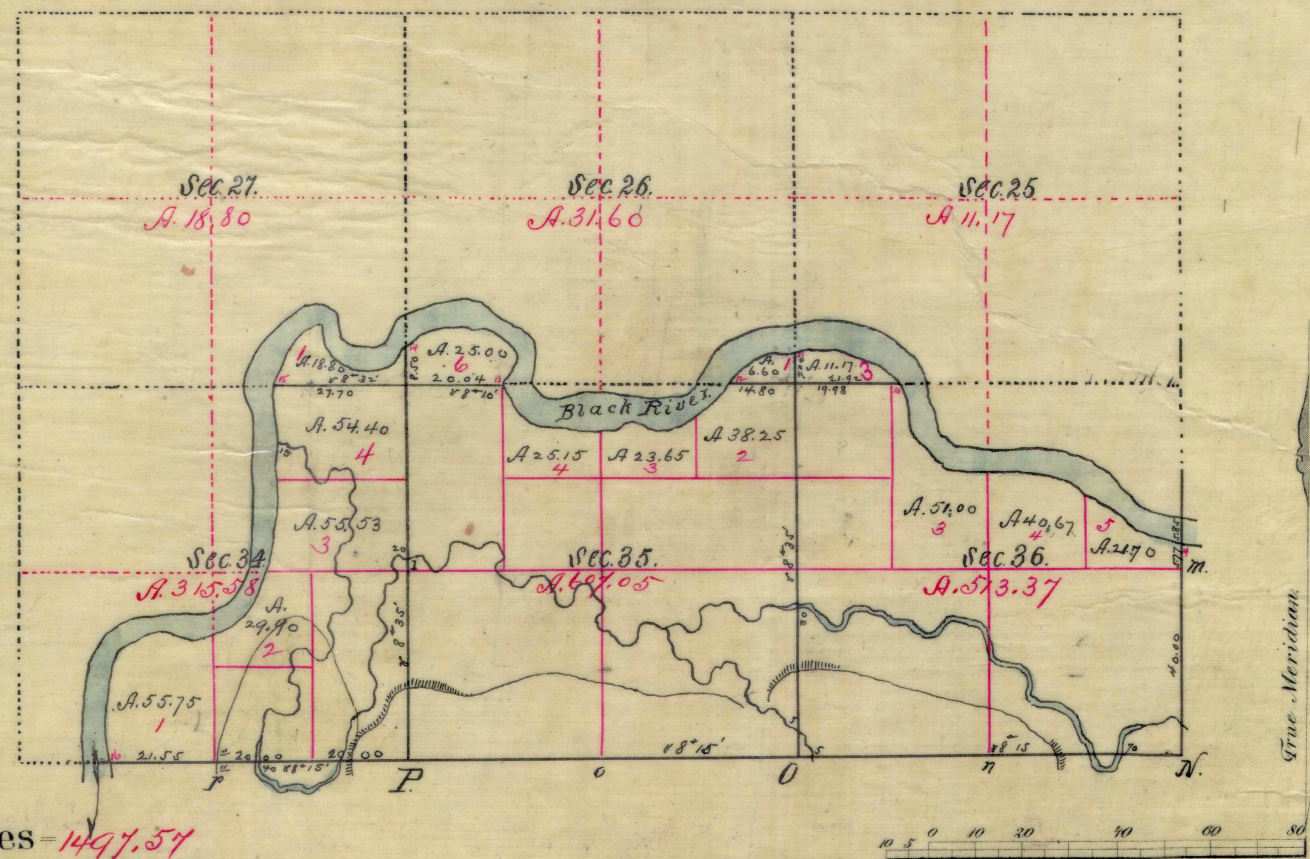

Total Number of Acres = 1497.57

Surveys Designated.	By Whom Surveyed.	Date of Contract.	Amount of Survey M. Chs. Lks.	When Surveyed.	When Charged in the Sur. Gen. Acct.
Township lines.	James E. Freeman	4th Sept. 1845		Jan. + Dec. 45, Jan. + 6	
Subdivisions.	Lyman S. Woodworth	June 22nd 1847		October 1847	

The above Map of Township No. 19 North of Range No. 7 West 4th Principal Meridian Wisconsin Territory is strictly conformable to the field notes of the survey thereof on file in this Office which have been examined and approved.
Surveyor General's Office
Dubuque June 7th 1848
Geo. W. Jones.
Sur. Genl

The State of Wisconsin
Department of Public Lands
To All to Whom These Presents shall Come, Greeting.
I, John M. Ewing, Chief Clerk of the Land Department of the State of Wisconsin do hereby certify that this copy of plat of Township No. 19 North of Range No. 7 West of 4th Meridian has been duly compared by me with the original plat in this Department and that it is a true copy thereof and of the whole of such original.
In Testimony whereof, I have hereunto set my hand and affixed the official seal of the Commissioners of the Public Lands at the Capitol in the City of Madison, this 30th day of June A.D. 1848.
John M. Ewing
Chief Clerk

