


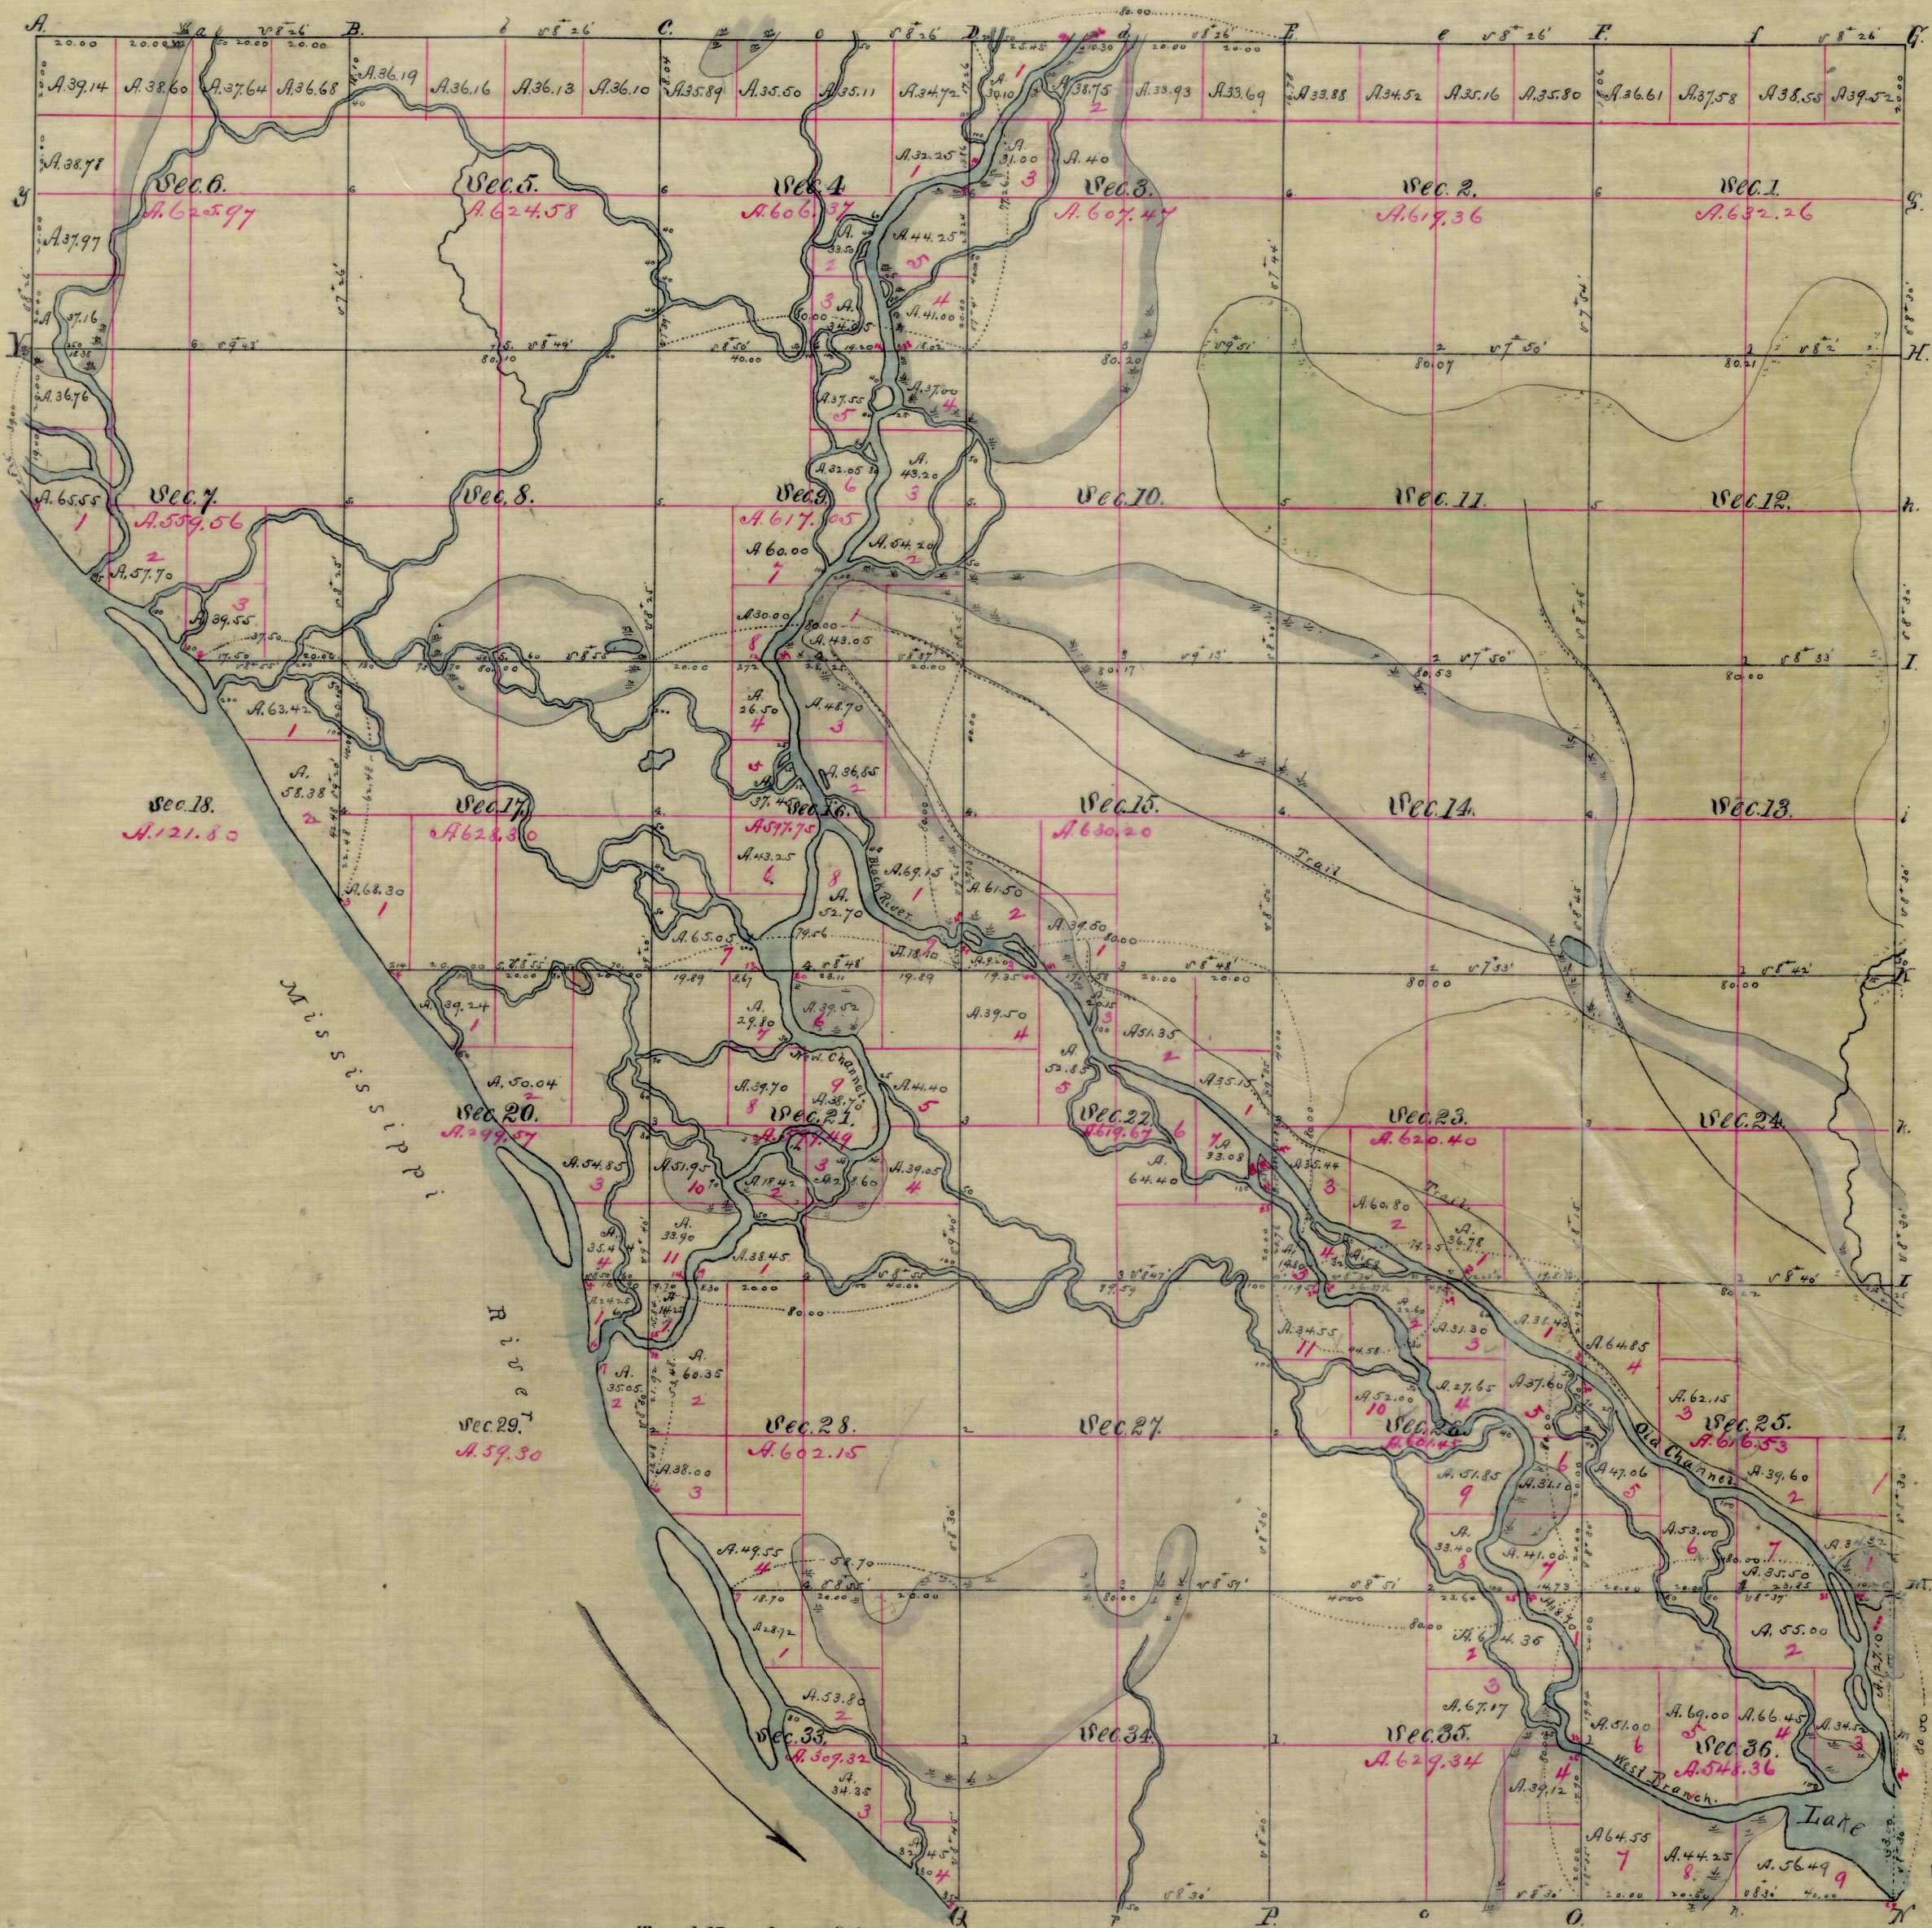

Total Number of Acres - 18,136.25

Surveys Designated.	By Whom Surveyed.	Date of Contract.	Amount of Survey M. Chs. Lks.	When Surveyed.	When Charged in the Sur. Gen. Acct.
Township lines.	W. A. Biggs.	Aug. 16 th 1845	16 " 42 " 50	Nov. & Dec. 1845	
Subdivisions.	A. L. Brown	Oct. 9 th 1846	85 " 50 " 28	Nov. & Dec. 1846	

Trigalove Map of Township No. 17, North of Range No. 8 West, 4th Principal Meridian, Wisconsin Territory, is strictly conformable to the field notes of the survey thereof on file in this office which have been examined and approved.
Surveyor General's Office.
Dubuque, April 8th 1847 Geo. H. Jones. Sur. Genl.

Meanders of Mississippi & Black Rivers.

Runs	Courses	Ch ² 1/4	Runs	Courses	Ch ² 1/4	Runs	Courses	Ch ² 1/4	Runs	Courses	Ch ² 1/4	Runs	Courses	Ch ² 1/4
Mississippi down stream.			New Channel 1 st d. d. down stream.			Old Channel 1 st d. d. down stream.			Old Channel 2 nd d. d. down stream.			Old Channel 3 rd d. d. down stream.		

The State of Wisconsin
Department of Public Lands
To All to Whom These Presents Shall Come Greeting
I, John H. Cowing, Chief Clerk of the Land Department of the State of Wisconsin do hereby certify that this copy of plat of Township No. 17 North of Range No. 8 West of 4th Meridian has been duly compared by me with the original plat in this Department and that the same is a true copy thereof and of the whole of such original.
In Testimony whereof, I have hereunto set my hand and affixed the official seal of the Commissioners of the Public Lands at the Capitol in the City of Madison, this 30th day of June A.D. 1880.
John H. Cowing, Chief Clerk.