


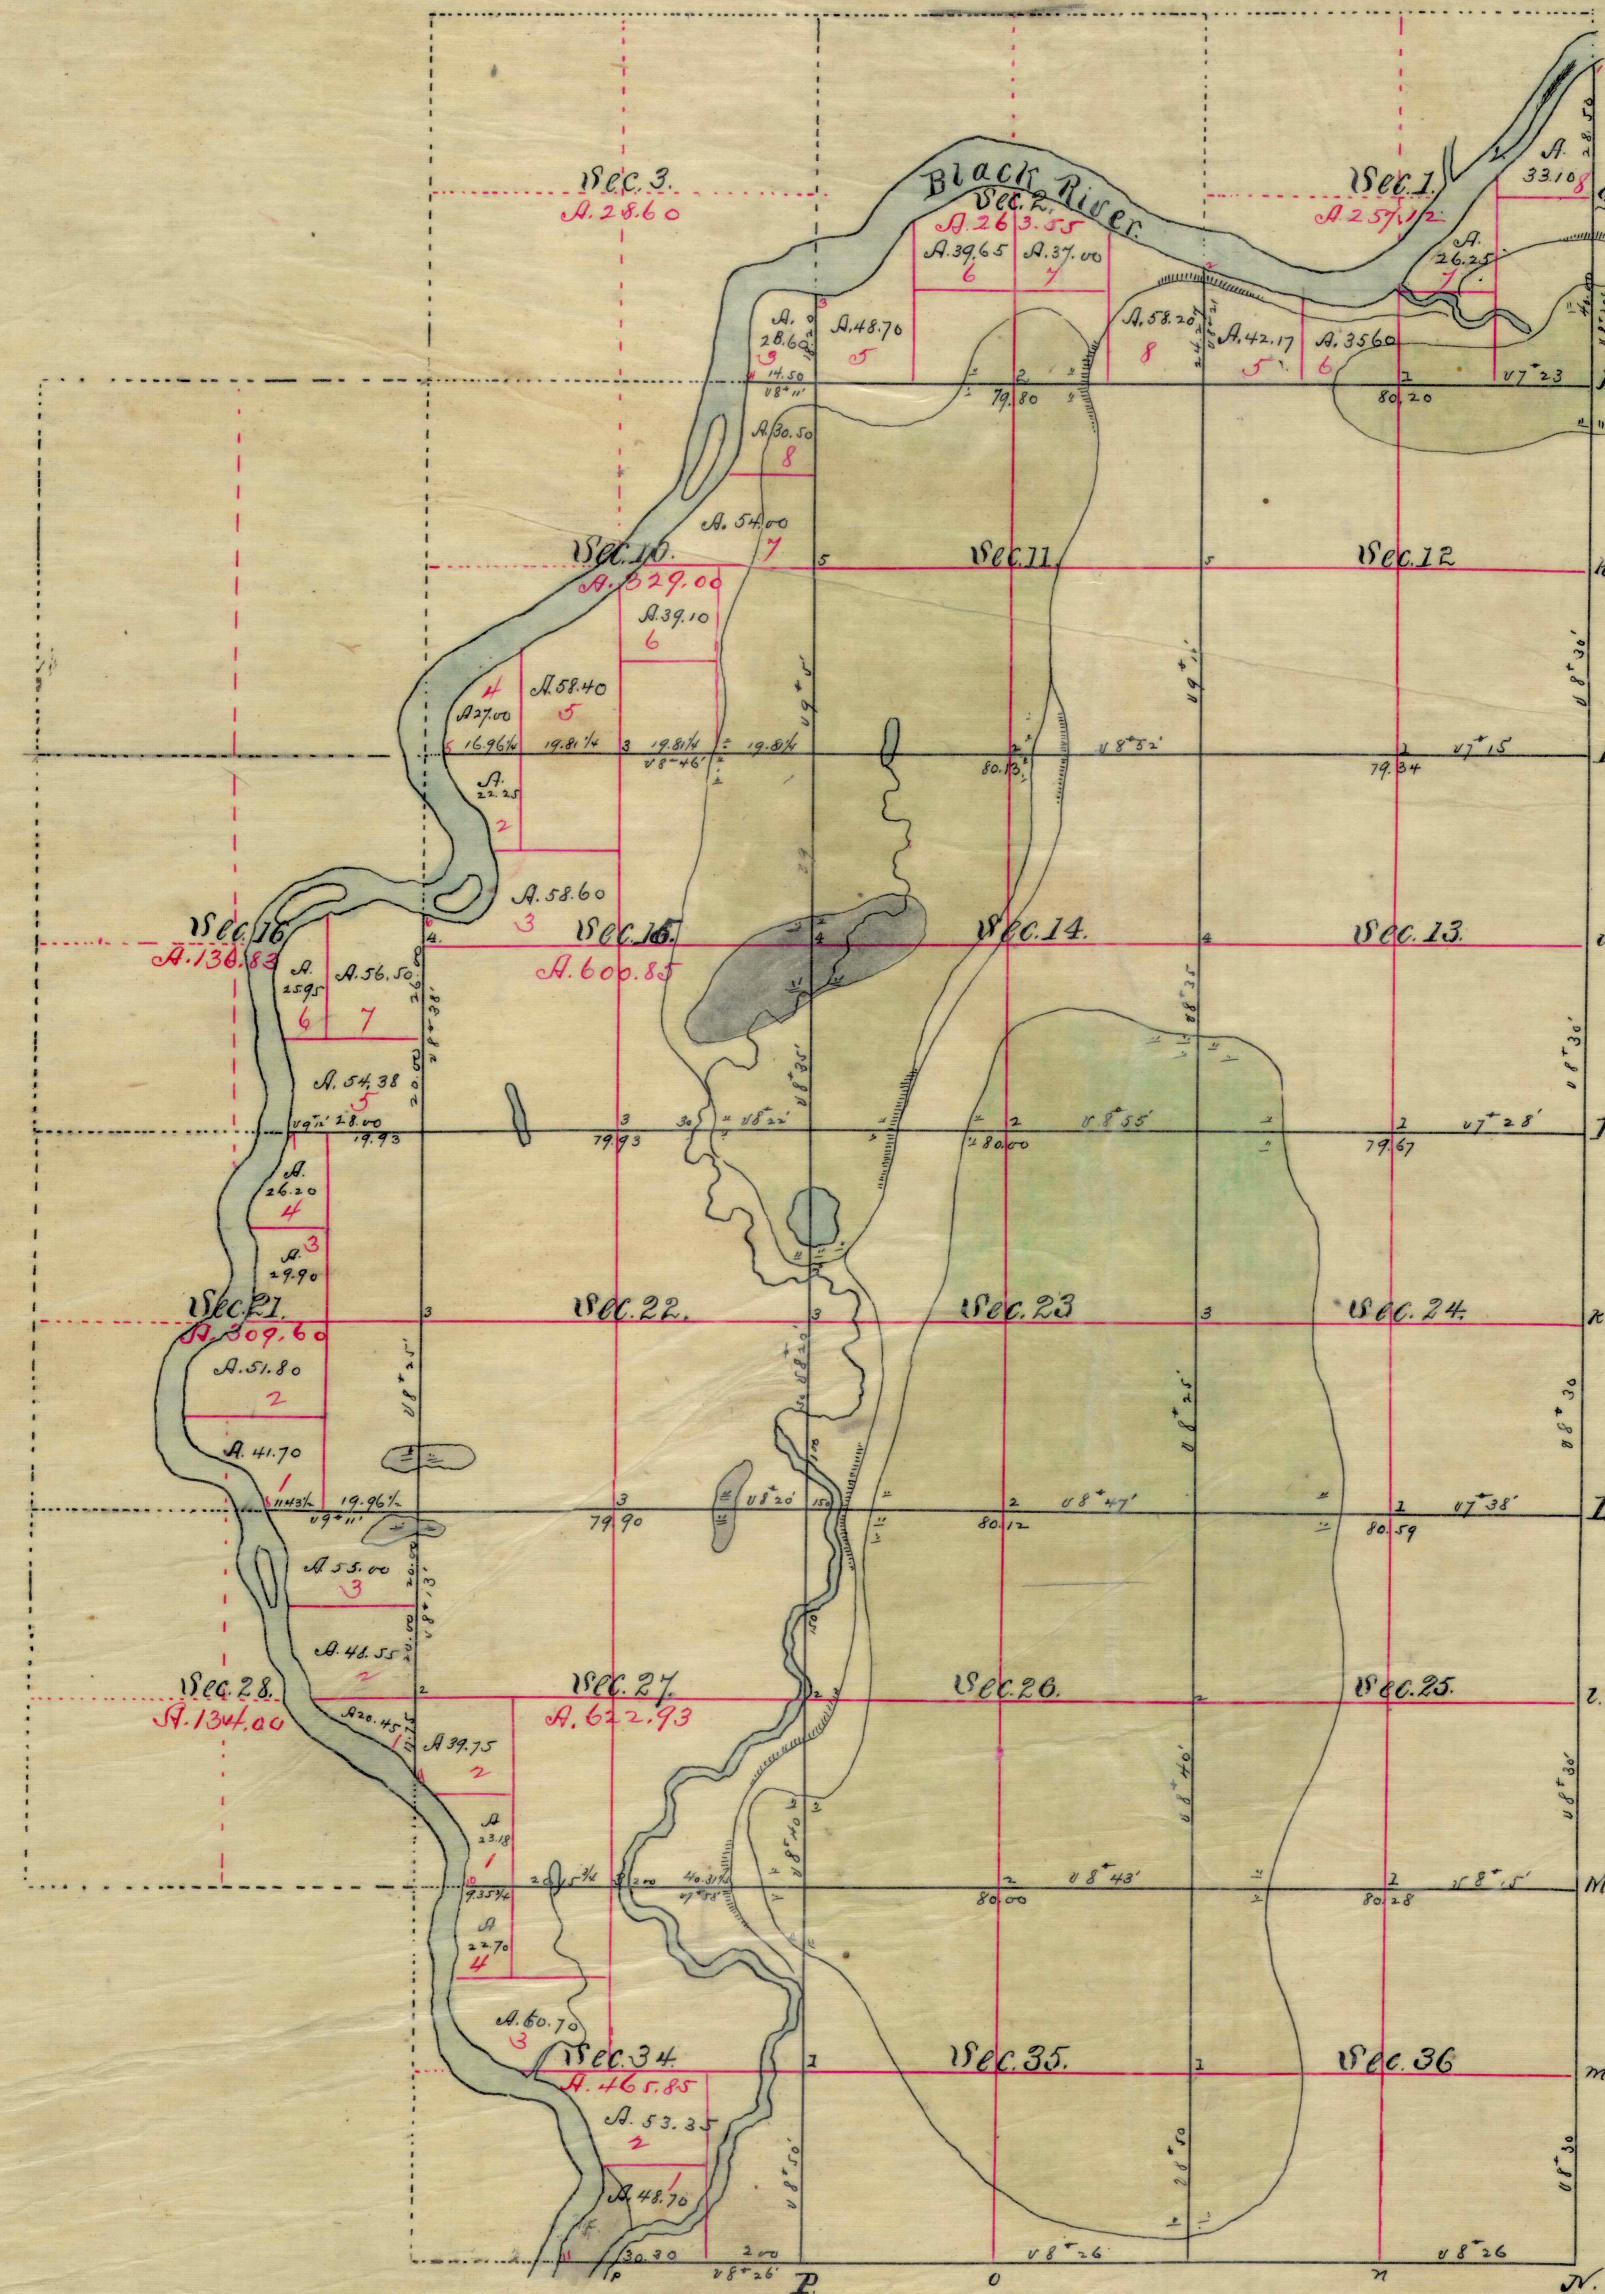

Revs	Courses	Ch ² Lat	Revs	Courses	Ch ² Lat
Left bank downstream					
1	S 42° W	12.08	8	S 56 1/2° E	9.30
	S 33 1/2° W	9.90		S 70° E	3.23
	S 47 1/2° W	12.40		S 48° E	6.75
	S 33 1/2° W	13.30		S 18 1/2° E	4.20
	S 32 1/2° W	8.86		S 30° E	3.78
	S 37 1/2° W	8.30		S 39° E	2.67
	S 4° W	8.15		S 36 1/2° E	3.24
	West	5.05		S 12° E	4.30
	S 75 1/2° W	6.60		S 11° W	3.73
	S 50° W	10.55		S 12 1/2° E	5.70
2	S 69 1/2° W	12.17		S 13° E	3.68
	S 65 1/2° W	19.20		S 41° E	5.50
	S 59° W	9.37		S 51 1/2° E	3.75
	S 71° W	9.93		S 41 1/2° E	2.92
	S 87 1/2° W	11.46		S 69 1/2° E	8.42
	S 65° W	16.76		S 54 1/2° E	2.33
	S 33 1/2° W	15.98		S 36 1/2° E	3.83
	S 62° W	5.97		S 45 1/2° E	1.14
3	S 85 1/2° W	14.54		S 44 1/2° E	13.80
	S 80° W	10.95		S 18 1/2° E	3.33
	S 72 1/2° W	2.84		S 27° E	4.06
	S 71° W	7.93		S 11° E	3.00
	South	4.61		S 13° W	2.20
	South	2.07			
4	S 114° E	7.00		S 22° W	5.00
	S 7 1/2° W	7.00		S 4 1/2° W	7.00
	S 22 1/2° W	5.37		S 10 1/2° W	4.08
	S 42 1/2° W	14.60		S 1° E	4.25
	S 40° W	8.56		S 3° W	3.40
	S 48 1/2° W	12.30		S 4 1/4° W	4.48
	S 57 1/2° W	29.71		S 4 1/2° E	3.58
	S 51 1/2° W	7.00		S 5 1/2° E	3.63
	S 35 1/2° W	5.14		S 16° E	2.96
	S 7 1/2° W	10.00		S 8° W	3.46
5	S 22 1/4° E	9.38		S 55° E	2.74
	S 42 1/2° E	7.27		S 86° E	6.66
	S 16° E	9.28		S 52° E	3.48
	S 5 1/2° W	5.10		S 77 1/4° E	3.82
	S 30 1/2° W	6.37		S 55 1/4° E	5.70
	S 69° W	3.53		S 20° E	5.47
	S 84° W	5.39		S 31° E	9.13
	S 57° W	3.38		S 3° E	5.50
6	S 58 1/2° W	7.20		S 8° W	4.37
	S 12° E	6.08		S 56° W	4.85
	S 57° W	4.48		S 63° W	3.18
	S 75° W	7.50		S 21° W	7.40
	S 64 1/2° W	3.43			
	S 63 1/2° W	2.77			
	S 17 1/2° W	6.13			
	S 1 1/2° E	6.26			
	S 3 1/4° E	7.80			
	S 10° E	4.44			
	S 25° E	7.80			
	S 1 1/2° W	6.85			
7	S 19 1/2° W	5.06			
	S 20 1/2° W	6.77			
	S 47 1/2° W	5.70			
	S 19° W	7.22			
	S 15 1/4° E	10.14			
	S 33 1/4° W	9.24			
	S 29° W	4.76			
	S 57° W	2.93			
	S 46 1/2° W	12.24			
	S 20 1/2° W	3.62			
	S 6 1/2° E	10.79			

Total Number of Acres 10,184.93

Surveys Designated.	By Whom Surveyed.	Date of Contract.	Amount of Survey M. Chs. Lks.	When Surveyed.	When Charged in the Sur. Gen. Sect.
Township lines.	James E. Freeman	4th Sept. 1845	17 " 74 " 43	November 1845	
" "	Oriskany Rogers	16th Aug. 1845	6 " 00 " 00	September 1845	
Subdivisions.	Green S. Woodward	June 22nd 1847	78 " 44 " 74	Sept & Oct 1847	

The above Map of Township No. 18 North of Range No. 8 West 4th Principal Meridian Wisconsin is strictly conformable to the field notes of the survey thereof on file in this Office which have been examined and approved.
Surveyor General's Office.
Dubuque June 7th 1848 Geo W. Jones.
Sur. Genl.

The State of Wisconsin
Department of Public Lands
To All to Whom These Presents shall Come, Greeting.
I, John M. Cowing, Chief Clerk of the Land Department of the State of Wisconsin do hereby certify that this copy of plat of Township No. 18 North of Range No. 8 West of 4th Meridian has been duly compared by me with the original plat in this Department and that the same is a true copy thereof and of the whole of such original.
In Testimony whereof, I have hereunto set my hand and affixed the official seal of the Commissioners of the Public Lands at the Capitol in the City of Madison, this 10th day of June A.D. 1848.
John M. Cowing.
Chief Clerk.