


## TOWNSHIP NO.17 NORTH, RANGE NO.9 WEST, OF THE FOURTH PRINCIPAL MERIDIAN, WISCONSIN.

PLAT OF ISLAND NO.88 IN THE MISSISSIPPI RIVER, SECTION 12.

849395

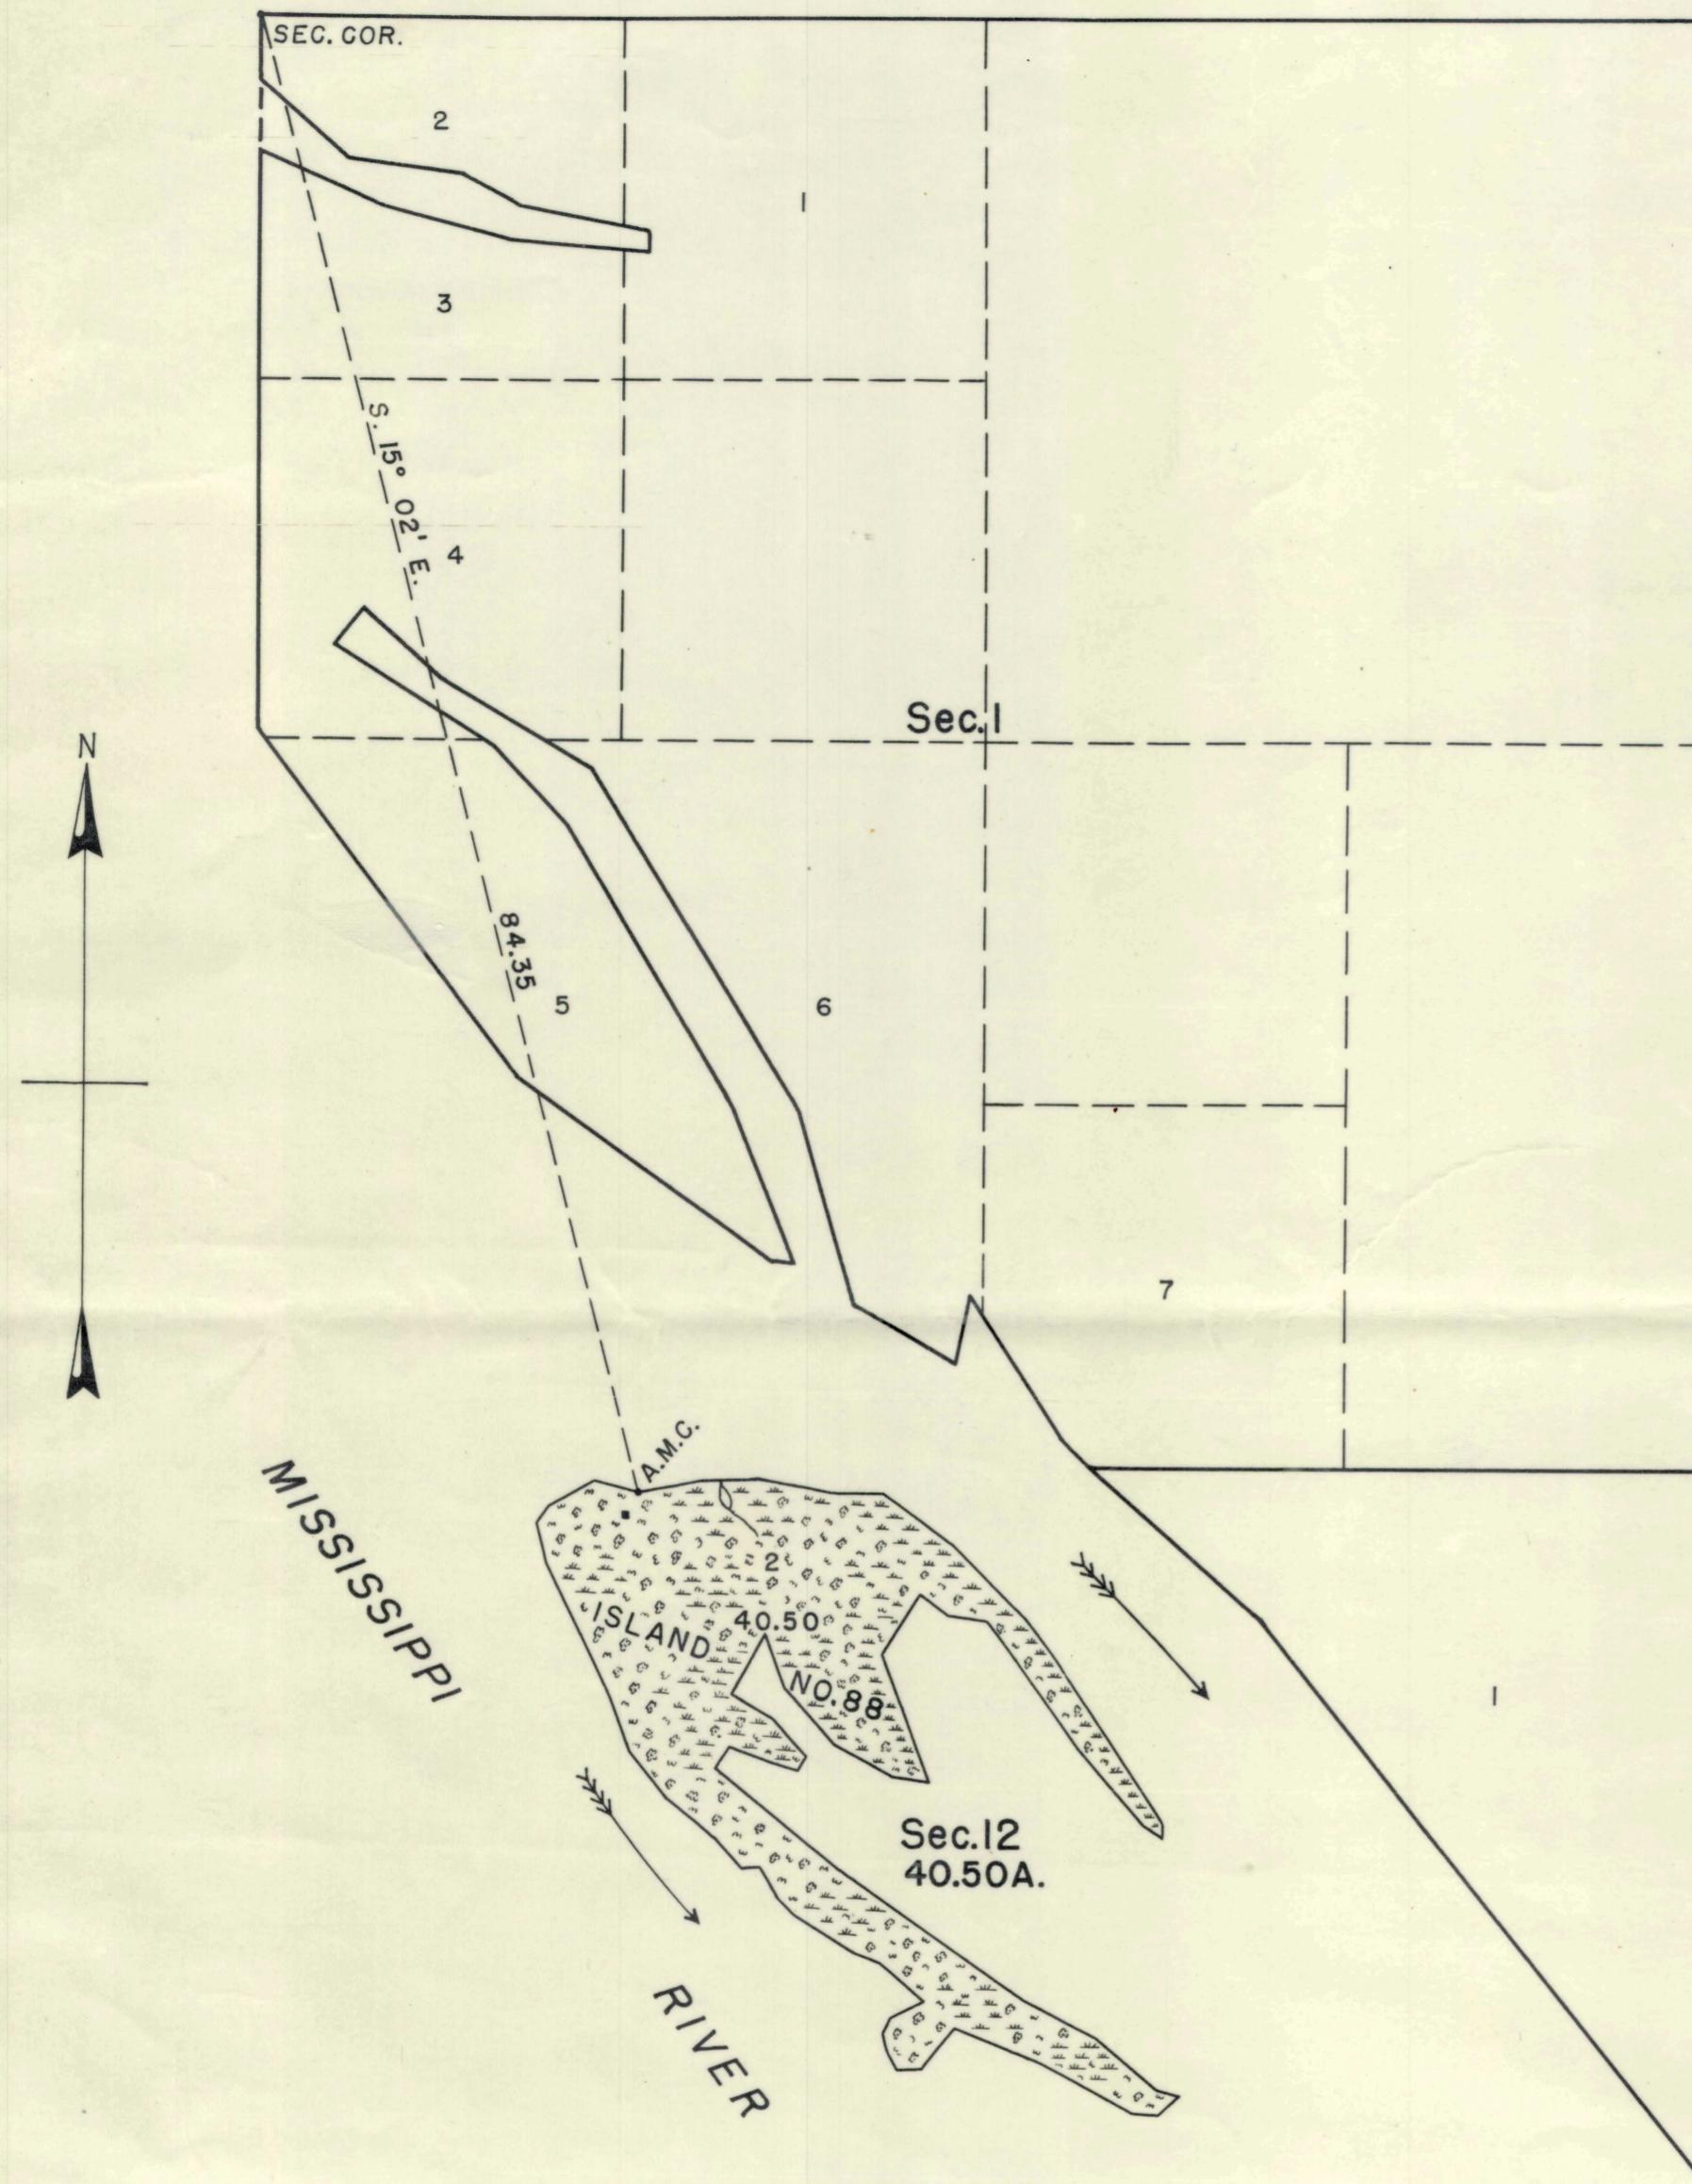

SCALE: 1 INCH EQUALS 10 CHAINS.

AREA SURVEYED, 40.50 ACRES.

LINES DESIGNATED	BY WHOM SURVEYED	GROUP NO.	DATE OF SPECIAL INSTRUCTIONS	WHEN SURVEYED	
				BEGUN	COMPLETED
MEANDER CONNECTION	HAL D. CRAIG HARLOW DAMMANN	52	JUNE 13, 1941.	AUGUST 5, 1941.	AUGUST 7, 1941.

W.N.R.

UNITED STATES DEPARTMENT OF THE INTERIOR  
GENERAL LAND OFFICE

DENVER, COLORADO, JUNE 4, 1942.  
 THIS PLAT OF ISLAND NO. 88 IN THE MISSISSIPPI RIVER IN SECTION 12, TOWNSHIP NO. 17 NORTH, RANGE NO. 9 WEST, FOURTH PRINCIPAL MERIDIAN, WISCONSIN, IS STRICTLY CONFORMABLE TO THE FIELD NOTES OF THE SURVEY THEREOF, WHICH HAVE BEEN EXAMINED AND APPROVED.

 W. D. Johnson  
SUPERVISOR OF SURVEYS.

WASHINGTON, D. C., DECEMBER 17, 1942.  
 THE SURVEY REPRESENTED BY THIS PLAT, HAVING BEEN CORRECTLY EXECUTED IN ACCORDANCE WITH THE REQUIREMENTS OF LAW AND THE REGULATIONS OF THIS OFFICE, IS HEREBY ACCEPTED.

 Joel David Wolfson  
ASSISTANT COMMISSIONER.

4-496 1714715  
ORIGINAL  
DUPLICATED PLAT

The following annotations are not a part of this plat

Received with letter dated June 4, 1942  
From Supervisor of Surveys  
Filed in Div. No. 1714715-PLA  
Vol 30 - pg 140  
Plat officially filed October 17, 1942  
Miscellaneous 1714715