

WEST 1/4 CORNER
SECTION 1 T15N-R5W
LUNDE MONUMENT

NORTH 1/4 CORNER
SECTION 1, T15N-R5W
BERNTSEN MONUMENT

EAST 1/4 CORNER
SECTION 1, T15N-R5W
HARRISON MONUMENT

SOUTH 1/4 CORNER
SECTION 1, T15N-R5W
LUNDE MONUMENT



COULEE REGION LAND SURVEYORS, INC.

917 SO. 4TH STREET - P.O. BOX 1957
LA CROSSE, WISCONSIN 54601
PHONE (608) 784-1614 FAX (608) 784-1408

LEGEND

- ⊕ = Found County marker
- = Found 3/4" Iron Bar
- = Found P.K. nail
- ⊗ = Set 3 1/2" Cut Nail & Lath
- = Boundary of this survey
- - - = Centerline
- () = Recorded dimensions
- x - x - x = Fence line

BEARING BASIS: THE EAST-WEST 1/4 LINE OF SECTION 1, T15N-R5W (N 88°12'38" E)

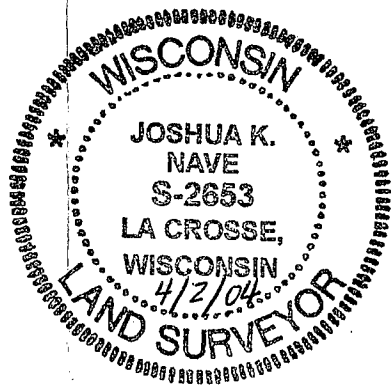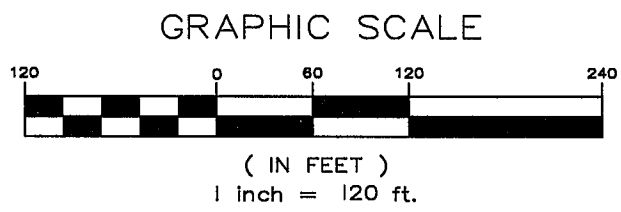

SURVEYOR'S CERTIFICATE

I, Joshua K. Nave, Registered Land Surveyor, hereby certify that the survey shown and represented hereon is accurate and true to the best of my knowledge and belief and that visible encroachments are shown.

Joshua K. Nave
Joshua K. Nave RLS 2653

**SURVEY FOR
JOE FRIET**

THE NORTH LINE OF THE NW 1/4 OF THE SW 1/4 SECTION 1, T15N-R5W TOWN OF WASHINGTON, LA CROSSE COUNTY, WI N2218 COUNTY ROAD "JB"	DRAWN BY: JKN	DATE: 03/17/2004	SCALE: 1" = 120 FEET
	REVISED BY: JKN	DATE: 03/25/04 04/02/04	
PROJECT NO.: S-4957		FIELD CREW: JN KK	
SHEET 1 OF 1			