


FRAC. SE 1/4 - SW 1/4
SEC. 2, T15N-R5W

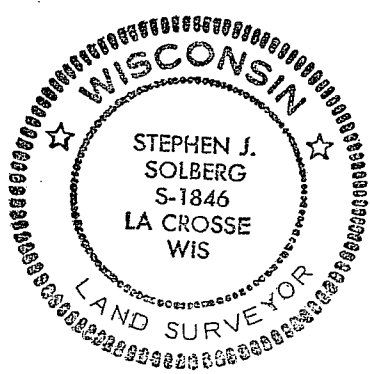

CURVE 1
 $\Delta = 02^{\circ}43'37''$
 $R = 993.00'$
 $L = 47.26'$
 $CB = S 79^{\circ}10'14'' E$
 $C = 47.26'$

CURVE 2
 $\Delta = 04^{\circ}48'25''$
 $R = 988.00'$
 $L = 82.89'$
 $CB = S 75^{\circ}24'13'' E$
 $C = 82.87'$

LEGAL DESCRIPTION

Part of the Fractional SE 1/4 of the SW 1/4 of Section 2, T15N-R5W, Town of Bangor, La Crosse County, Wisconsin described as follows:

Commencing at the South 1/4 corner of said Section 2; thence N $56^{\circ}14'37''$ W 1620.82 feet to the intersection of the easterly R.O.W. line of State Road 162 and the northerly R.O.W. line of State Road 33; thence, along said northerly R.O.W. line, on the arc of a 993.00 foot radius curve, concave to the South, the chord of which bears S $79^{\circ}10'14''$ E 47.26 feet; thence, continuing along said R.O.W. line, S $12^{\circ}11'35''$ W 5.00 feet; thence, continuing along said northerly R.O.W. line, on the arc of a 988.00 foot radius curve, concave to the South, the chord of which bears S $75^{\circ}24'13''$ E 82.87 feet; thence, continuing along said R.O.W. line S $73^{\circ}00'00''$ E 113.42 feet to the point of beginning; thence N $14^{\circ}36'53''$ E 128.25 feet; thence S $73^{\circ}00'00''$ E 115.00 feet; thence S $14^{\circ}36'53''$ W 120.00 feet to the said northerly R.O.W. line of State Road 33; thence, along said R.O.W. line, N $73^{\circ}00'00''$ W 57.12 feet; thence, continuing along said R.O.W. line, S $17^{\circ}00'00''$ W 8.25 feet; thence N $73^{\circ}00'00''$ W 57.88 feet to the point of beginning;


NOTE: In order for the above description to become legal, it will be necessary:

- A. for Meyer to execute a quit claim deed to Arentz for any part of that parcel described in Vol. 440, Page 149 as "Parcel 11" lying outside the description above and
- B. for adjoining property owners, Arentz and Lucey, to quit claim the above described parcel to Meyer.

LEGEND

- = Found iron pipe
- = Set 1/2" rebar (1.13 lb./lin. ft.)
- = Boundary of this survey
- - - = Centerline
- () = Recorded dimensions
- ⊗ = Chiselled x

GRAPHIC SCALE

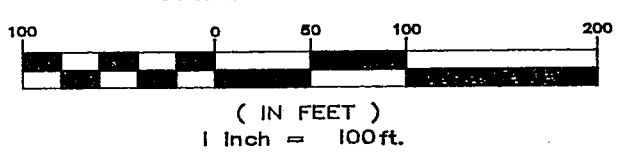

SURVEYOR'S CERTIFICATE

I, Stephen J. Solberg, Registered Land Surveyor, hereby certify that the survey shown and represented above is accurate and true to the best of my knowledge and belief and that there are no encroachments other than those shown.

[Signature]
Stephen J. Solberg, RLS 1846

**SURVEY FOR
HERBERT MEYER**

Part SE 1/4 - SW 1/4
T15N-R5W, TOWN OF WASHINGTON
LA CROSSE COUNTY, WISCONSIN
W792 STATE ROAD 33

DRAWN BY: SJS,DM DATE: 7-18-94
 REVISED BY: DATE:
 SCALE: 1" = 100'



**SOLBERGS & ASSOCIATES
SURVEYING & DRAFTING, INC.**

507 MAIN STREET
P.O. BOX 1235
LA CROSSE, WIS. 54602
PH.: (608)784-1614

SHEET 1 OF 1

PROJECT NO.: 2513 FB NO.: 165

In Blackburg Jan
 SE-SW 2-15-5
 10-89