


# CERTIFIED SURVEY MAP

PART OF  
SE 1/4 OF THE SW 1/4, SECTION 2, T15N-R5W  
TOWN OF WASHINGTON, LA CROSSE COUNTY, WISCONSIN

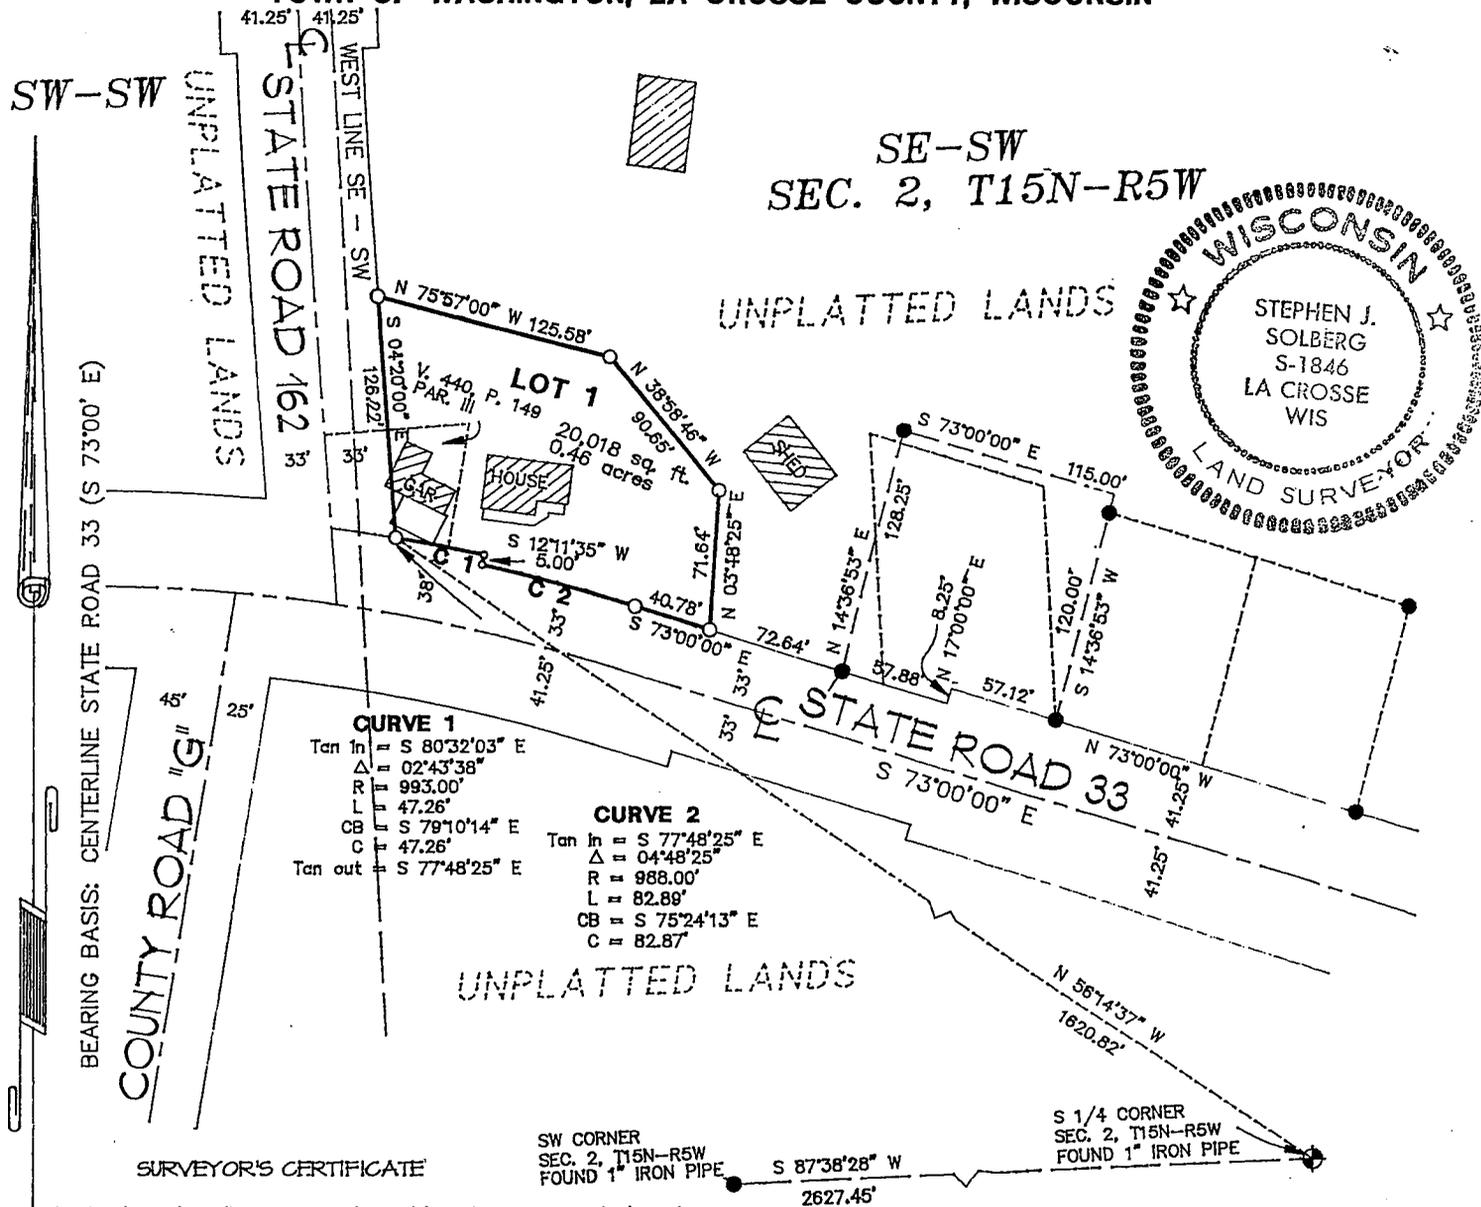

**CURVE 1**  
Tan in = S 80°32'03" E  
Δ = 02°43'38"  
R = 993.00'  
L = 47.26'  
CB = S 79°10'14" E  
C = 47.26'  
Tan out = S 77°48'25" E

**CURVE 2**  
Tan in = S 77°48'25" E  
Δ = 04°48'25"  
R = 988.00'  
L = 82.89'  
CB = S 75°24'13" E  
C = 82.87'

I, Stephen J. Solberg, Registered Land Surveyor, do hereby certify that I have surveyed and mapped this Certified Survey Map being a part of SE 1/4 of the SW 1/4 of Section 2, T15N-R5W, Town of Washington, La Crosse County, Wisconsin described as follows:  
Commencing at the South 1/4 corner of said Section 2; thence N 56°14'37" W 1620.82 feet to the intersection of the easterly R.O.W. line of State Road 162 and the northerly R.O.W. line of State Road 33 and the point of beginning;  
thence, along said northerly R.O.W. line, on the arc of a 993.00 foot radius curve, concave to the South, the chord of which bears S 79°10'14" E 47.26 feet; thence, continuing along said R.O.W. line, S 12°11'35" W 5.00 feet; thence, continuing along said northerly R.O.W. line, on the arc of a 988.00 foot radius curve, concave to the South, the chord of which bears S 75°24'13" E 82.87 feet; thence, continuing along said R.O.W. line S 73°00'00" E 40.78 feet; thence N 03°48'25" E 71.64 feet; thence N 38°58'46" W 90.65 feet; thence N 75°57'00" W 125.58 feet to the said easterly R.O.W. line of State Road 162; thence S 04°20'00" E 126.22 feet to the point of beginning.  
That I have made such survey, map and subdivision of land at the direction of Thomas J. Arentz, owner of said land.  
That such map is a correct representation of the exterior boundaries of the land surveyed and subdivision thereof made.  
That I have fully complied with the provision of s.236.34, Wisconsin Statutes and with the Subdivision Control Ordinances of the Town of Washington and of La Crosse County in surveying and mapping the same.

Stephen J. Solberg  
Jun. 9, 1995,  
Solberg Home Inspections, Inc.  
507 Main Street  
La Crosse, Wisconsin


OWNER:  
Thomas J. Arentz  
N2443 State Road 162  
Bangor, Wis. 54669

I hereby certify that this survey complies with the provisions of the La Crosse County Subdivision Control Ordinance  
William C. Jung  
County Surveyor  
Variance Granted On 10/2/95  
For 200' Depth

## LEGEND

- = Found iron pipe
- = Set 3/4"x30" iron bar (1.5 lb./lin. ft.)
- = Set drill hole
- = Boundary of this survey
- - - = Centerline
- ( ) = Recorded dimensions

## GRAPHIC SCALE

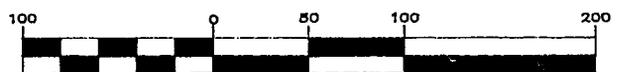

( IN FEET )  
1 Inch = 100ft.