

D.J. LaBlonde Survey
Dated 5/16/2024

SW - SW

SE - SW

Section 34

T16N-R5W

Berntsen Mon.
N 1/4 Corner
Section 3
T15N-R5W

Lunde Mon.
NW Corner
Section 3
T15N-R5W

C.W. Fechner Survey
Dated 4/24/2017

LEGEND

- = Found 3/4" Iron Bar (unless stated otherwise)
- = Set 3/4" x 20" Rebar (1.50 lb/lin. ft.)
- () = Recorded dimensions
- ⊕ = Found County marker
- = Boundary of this survey
- - - = Centerline
- x - x - = Fence line

Fractional
NE - NW
Section 3
T15N-R5W

RECEIVED

FEB 06 2025
County Surveyor

C.W. Fechner Survey
Dated 10/4/2017




SURVEYOR'S CERTIFICATE

I, Christopher W. Fechner, Professional Land Surveyor, hereby certify that the survey shown and represented above is accurate and true to the best of my knowledge and belief and that there are no visible encroachments other than those shown.

Christopher W. Fechner
Christopher W. Fechner PLS 2448

Graphic Scale

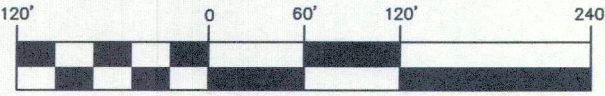

(IN FEET)
1 inch = 120 ft.

M.A. Lydon Survey
Dated 3/1/2024
SE-SW, Section 3

Coulee Region
Land Surveyors



917 SOUTH 4TH STREET - P.O. BOX 1954
LA CROSSE, WISCONSIN 54601
PHONE (608) 784-1614 FAX (608) 784-1408
www.couleeregionlandsurveyors.com

SURVEY FOR
Heidi Ellefson

Part of Fractional NE 1/4 - NW 1/4,
Section 3, T15N-R5W;
Town of Washington, La Crosse County, WI
N2425 Antony Road

PROJECT NO.: S-3701G
FIELD CREW: RC BW
SHEET 1 OF 1