


SEC. 1,
N-RSW
8 STONE

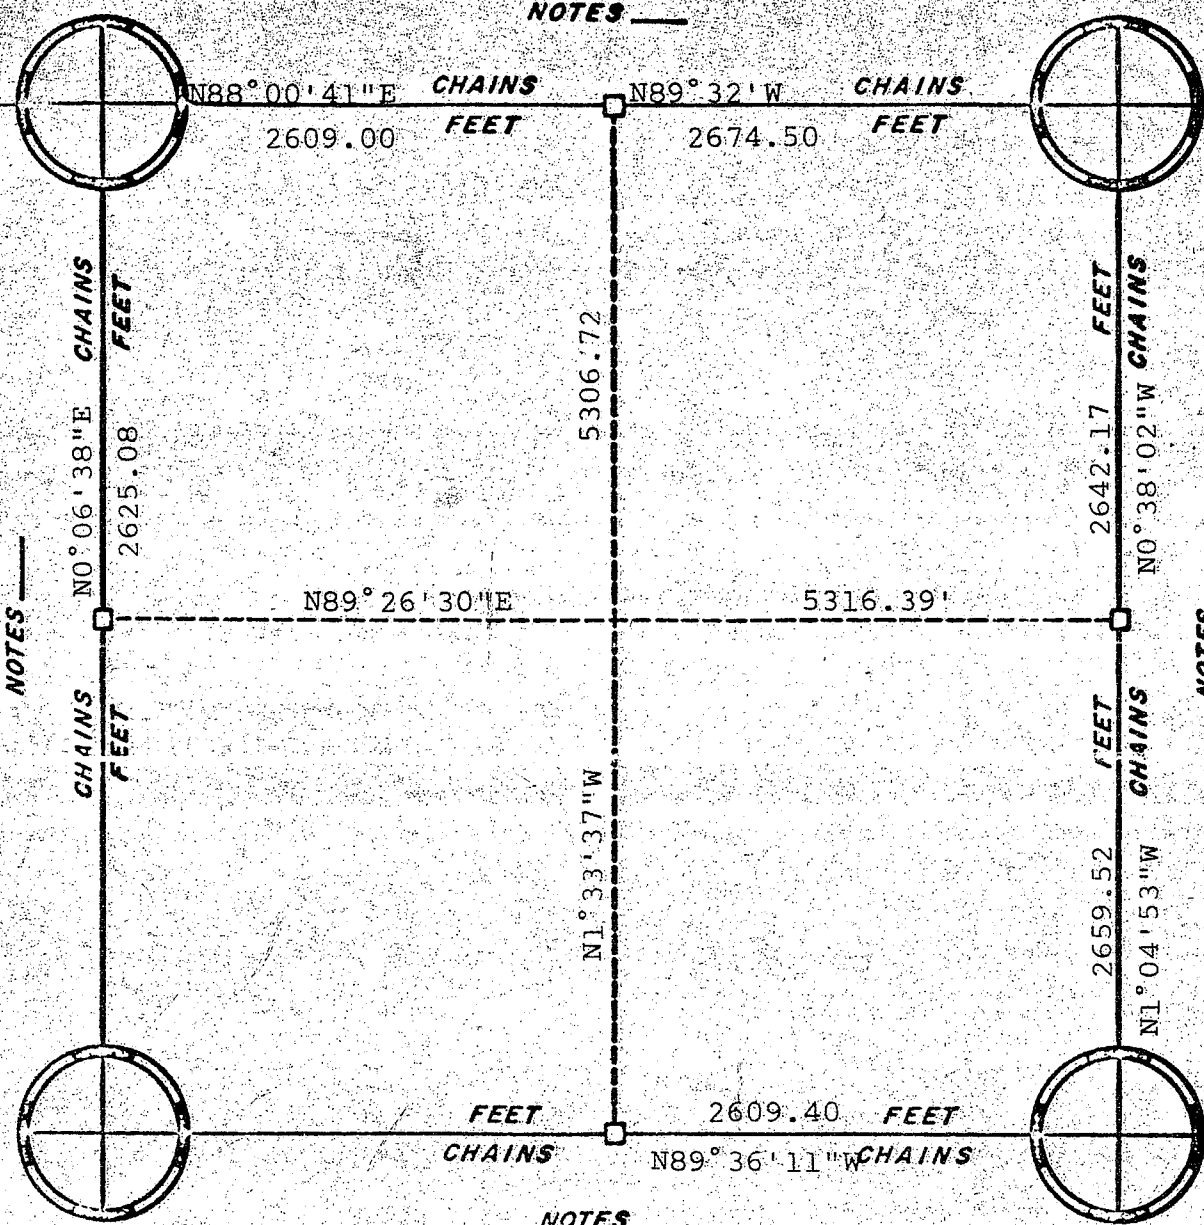


NOTES _____

NOTES _____

NOTES _____


NOTES _____

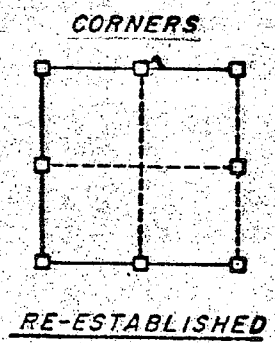

ORIGINAL SURVEY DATA

BY _____
DATE _____

SURVEYED BY	CONTRACT DATE	COUNTY MONROE	TOWN-VILLAGE-CITY	SECTION	TOWNSHIP	RANGE
G. L. Dechant	Dec. 17, 1986	██████████	Portland	7	15N	4W

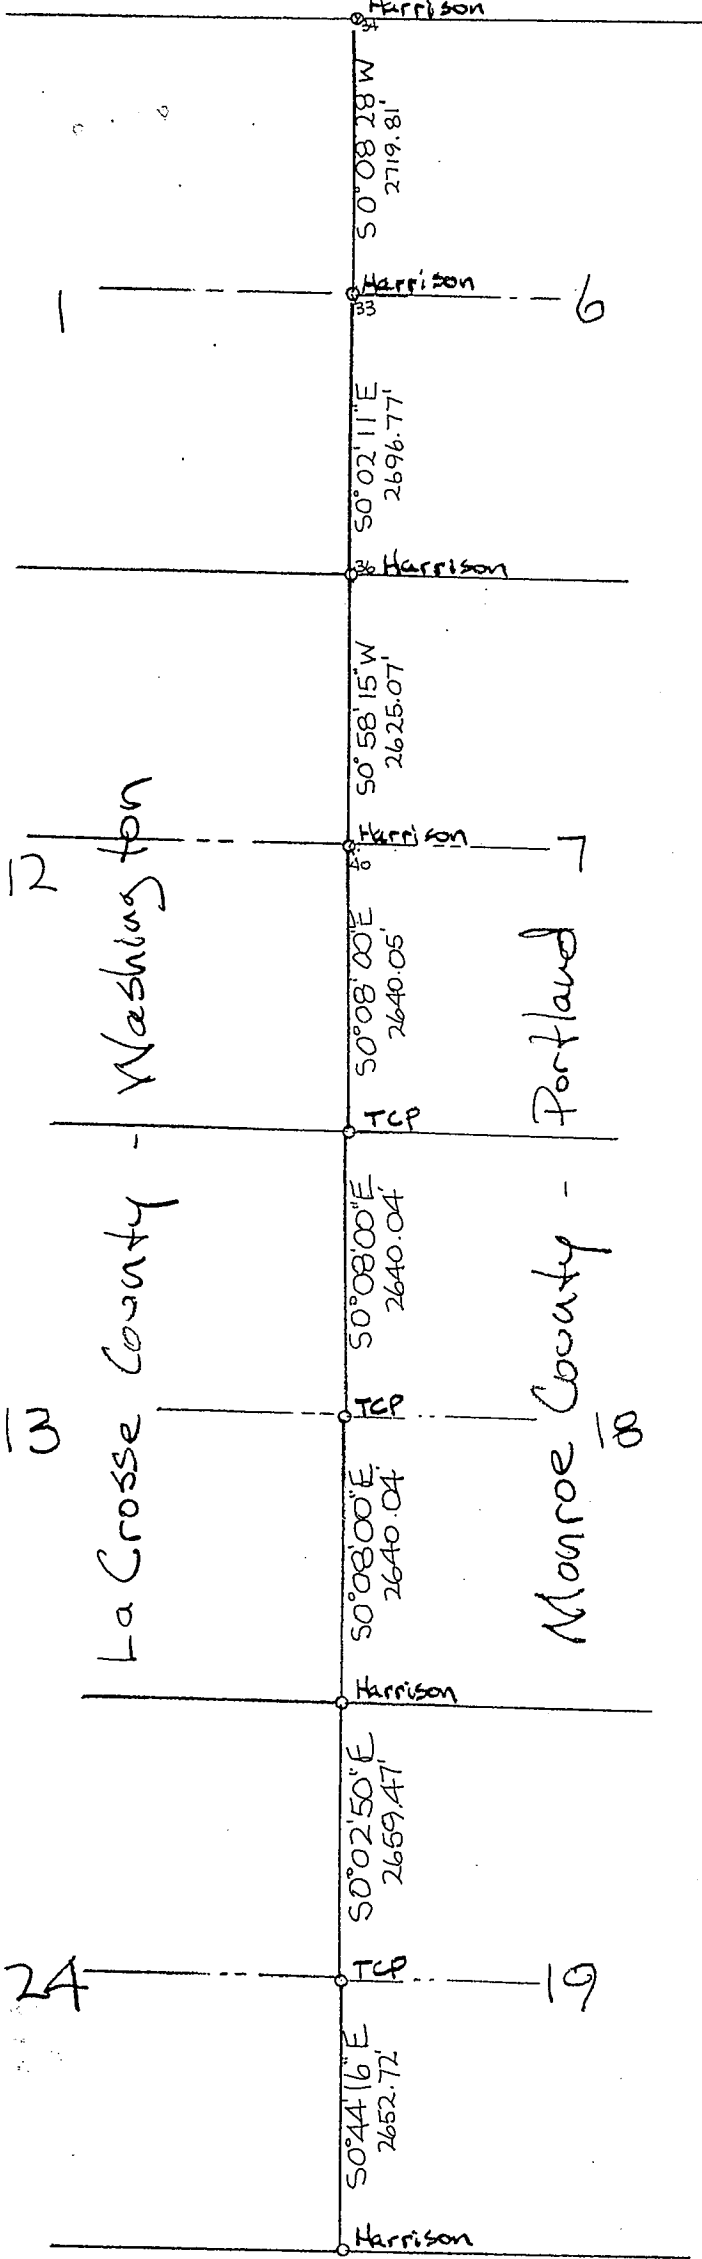

No Scale!
 Bearings are Assumed