

ya:17

Now SCHROEDER

DAVID FRIE SURVEY

Found Iron pipe

NE Corner Section 14 T15N, R5W La Crosse Co. Wis.

NW-NE 31.5

NE-NE

SW-NE 26.59


SE-NE

NW-SE

NE-SE



Clayton C. Solberg

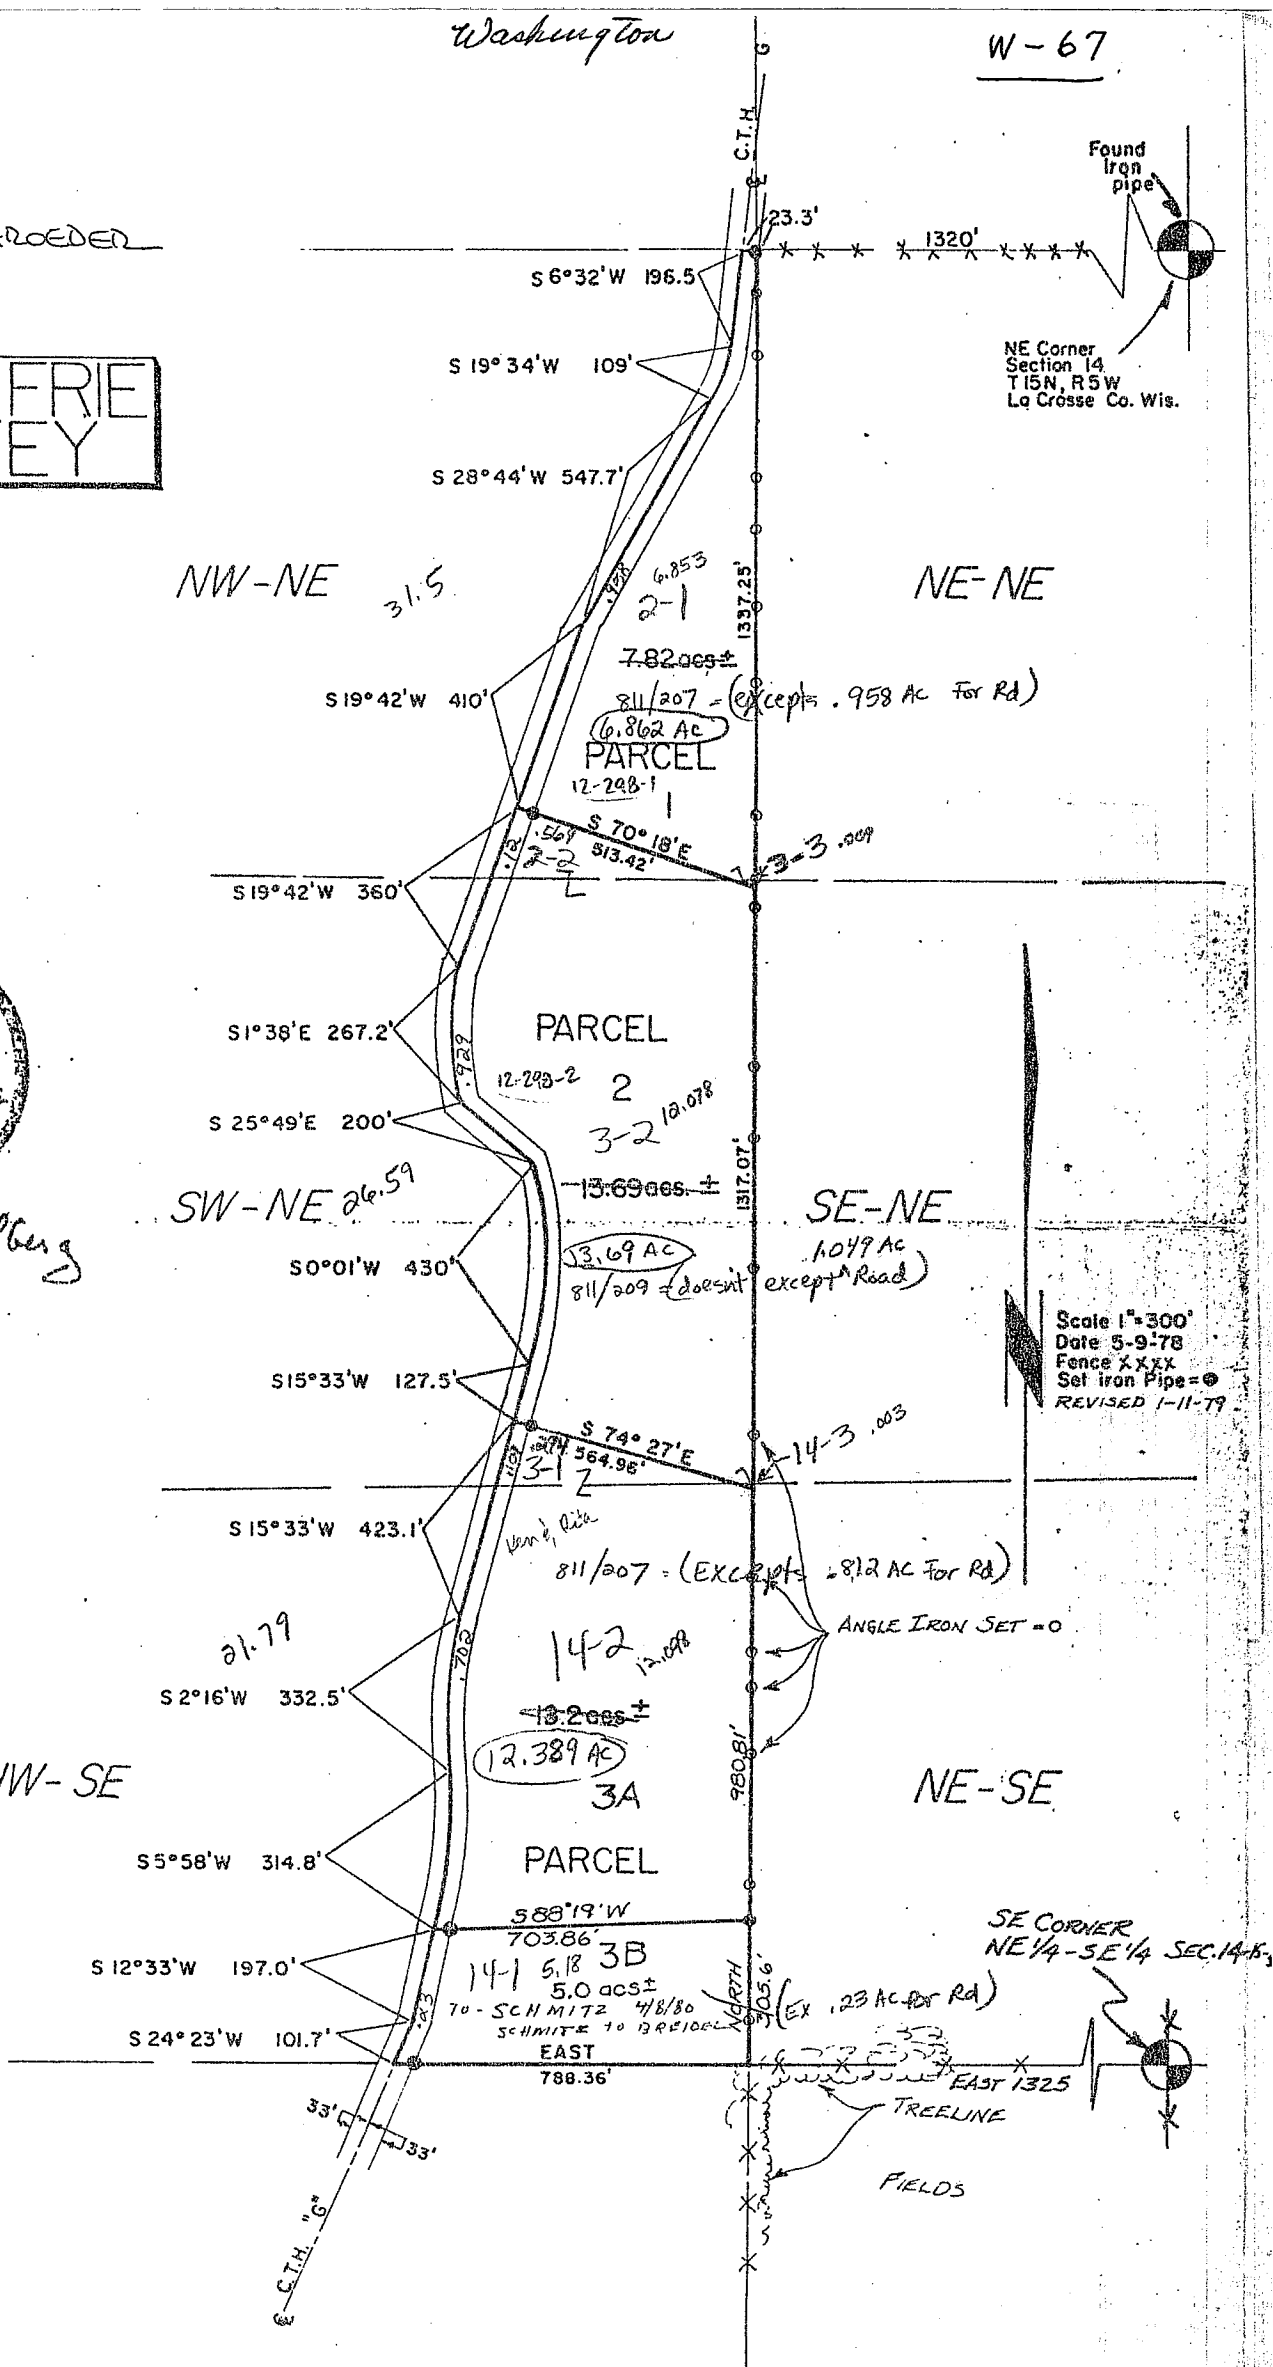


Scale 1"=300'
Date 5-9-78
Fence x x x x
Set Iron Pipe = ●
REVISED 1-11-79

SE CORNER NE 1/4 - SE 1/4 SEC. 14 - 67

from exclusive agriculture
to agriculture A
apply before Feb 7

DAVID FRIE
SURVEY

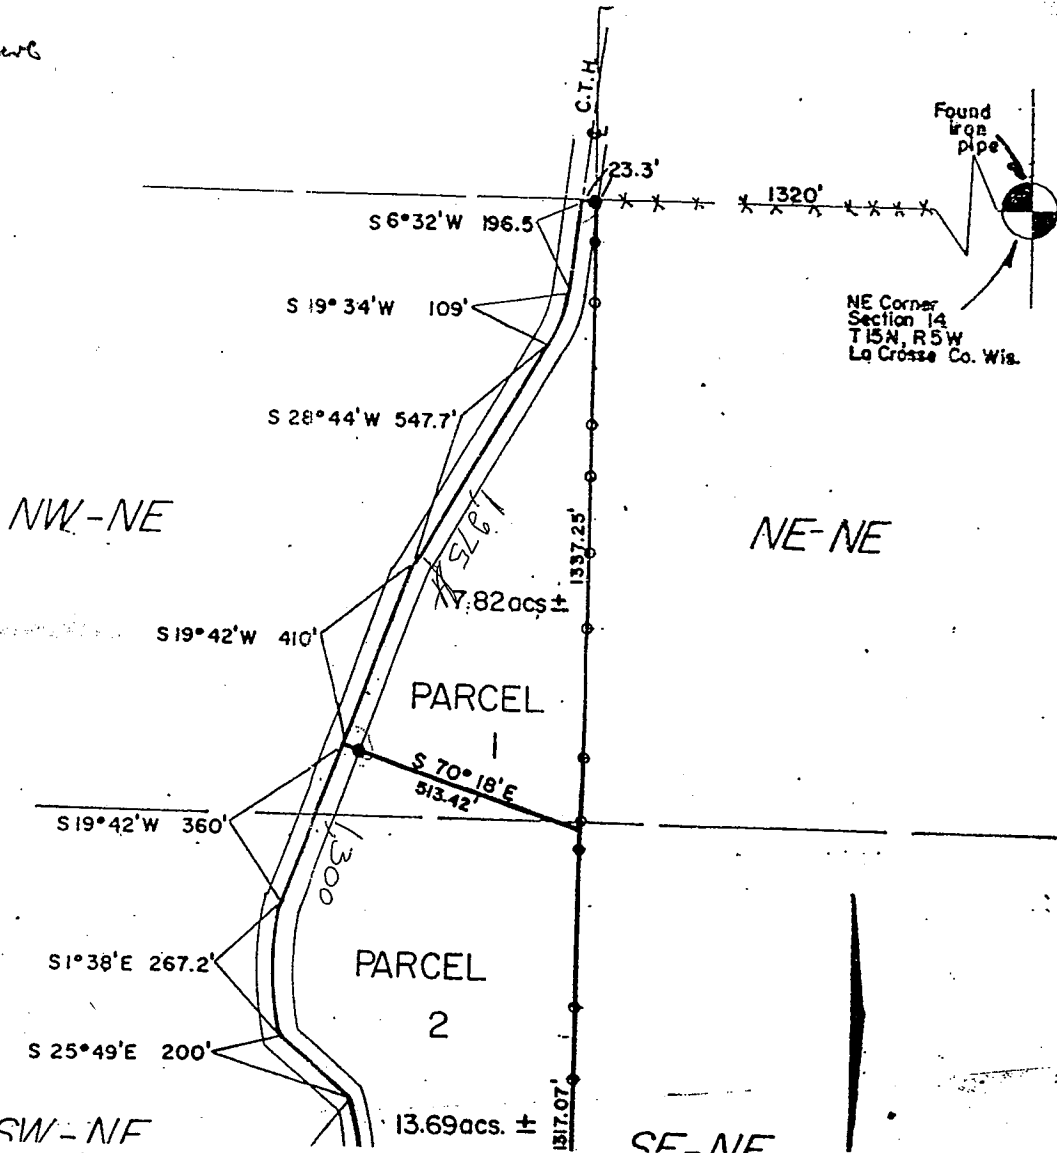

Scale 1"=300'
Date 5-9-78
Fence XXXX
Set Iron Pipe = ●
REVISED 1-11-79

