


Section Summary and Index

16	15N	5W
Section	Town	Range

Note: See tie sheet on the NW Corner for State Plane Coordinate data.

Town of Washington

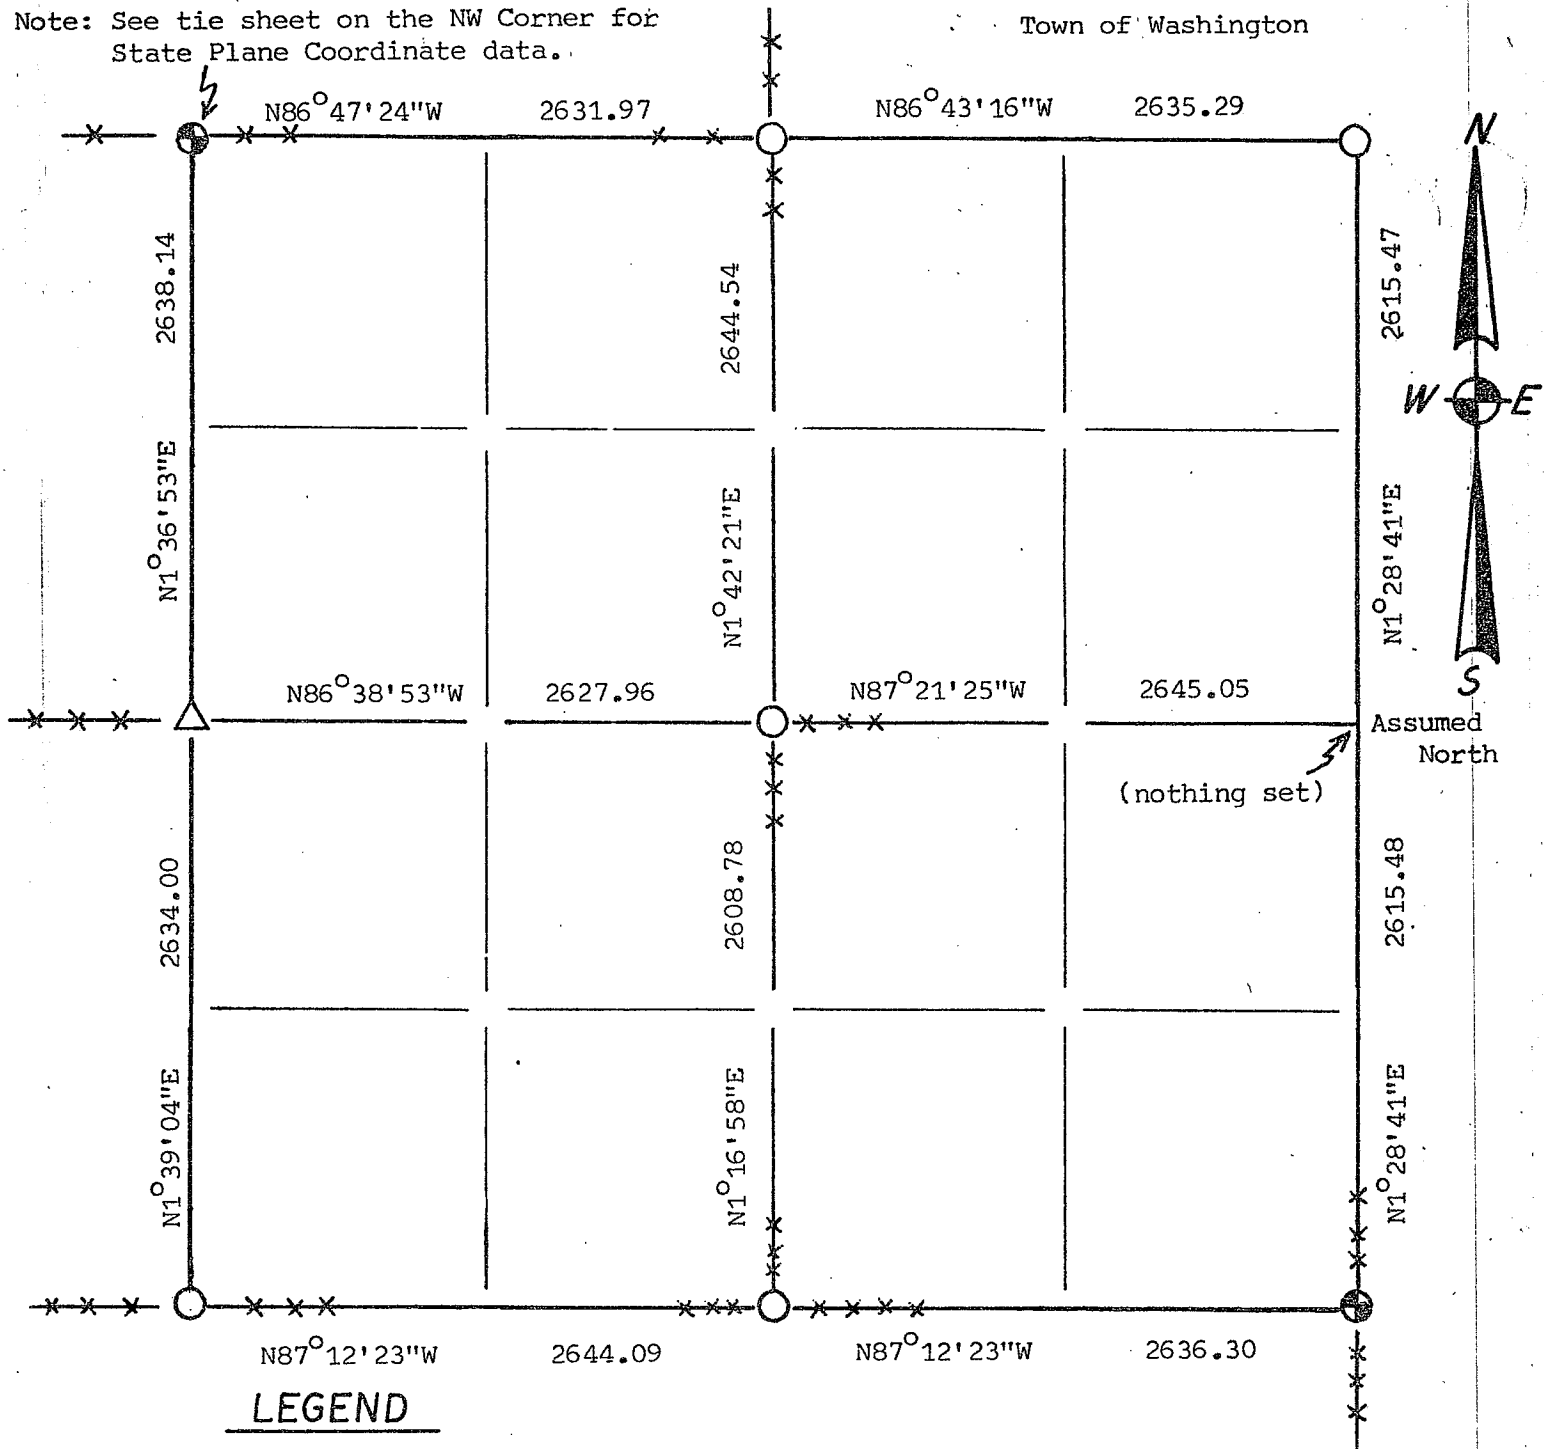

LEGEND

- - Brass capped Lunde monument.
- - Stone or concrete monument.
- - Other iron pipe
- △ - railroad spike
- *** - fence

December 18, 1989

