


Section Summary and Index


W-126  
 LaCrosse County  
 19 - 15 - 5  
 Section      Town      Range  
 Town of Washington

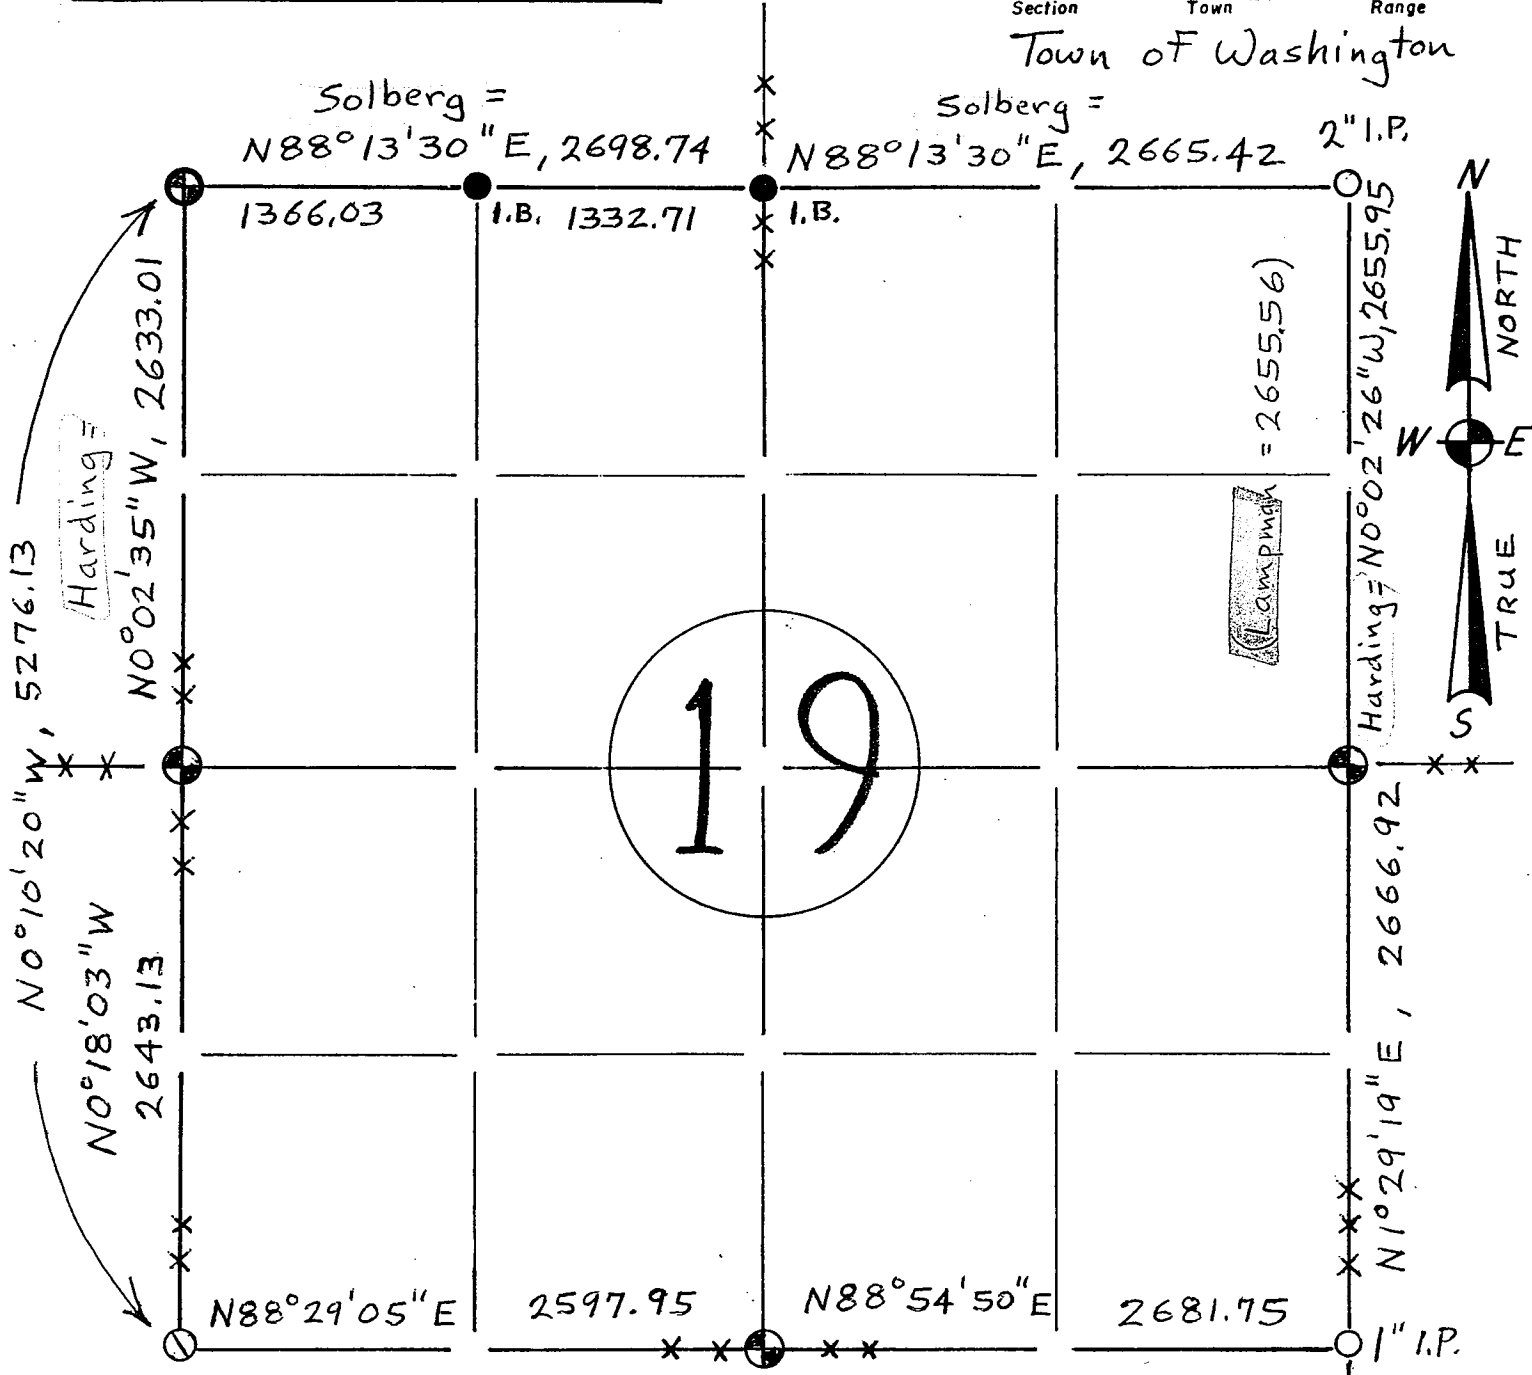

LEGEND

- ⊕ - Lunde monument.
- - Stone or concrete monument.
- - Other Pipe
- - 3/4" Iron bar set by Solberg
- ⊖ - computed location only in Field

(Not to scale!)

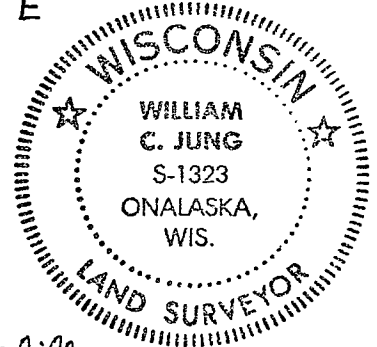

William C. Jung  
 County Surveyor  
 11/27/96

