

GRAPHIC SCALE



( IN FEET )  
1 inch = 100 ft.

NW - NE

NE CORNER  
SECTION 22  
T15N-R5W

BEARINGS REFERENCED TO THE EAST LINE OF THE NE 1/4,  
SECTION 22, T15N-R5W; LACROSSE CO. COORDINATE SYSTEM

SECTION 22

UNPLATTED LANDS  
BY CAVADINI

UNPLATTED LANDS  
BY ARENTZ  
V. 1583  
PG. 533

UNPLATTED LANDS  
BY DEFLORIAN

$\Delta = 02^{\circ}53'31''$   
 $R = 2831.90'$   
 $L = 142.94'$

E 1/4 CORNER  
CALCULATED

SW - NE

T15N-R5W

31,404 sq. ft.  
0.72 acres

UNPLATTED LANDS  
BY SILHA

LEGEND

- = Found 1" Iron Pipe (unless stated otherwise)
- = Set 3/4" X 30" Iron Bar (1.50 lb/lin. ft.)
- = Boundary of this survey
- - - = Centerline
- ( ) = Recorded dimensions
- U-U-U- = Utility lines
- x-x-x- = Fence line
- ⬢ = Found County marker

SURVEYORS DESCRIPTION


Part of the SW 1/4 of the NE 1/4, Section 22, T15N-R5W, Town of Washington, LaCrosse County, Wisconsin described as follows: Commencing at the northeast corner of Section 22, thence S 53°34'52" W 2662.12 feet to the northeast corner of that parcel described in Volume 1583, Page 533 of records; the northeasterly right-of-way line of County Road "H"; and the point of beginning: thence, along said right-of-way line on the arc of a 2831.90 foot radius curve, concave to the northeast, the chord of which bears, S 66°38'41.5" E 142.93 feet; thence S 28°43'14" W 324.94 feet; thence N 08°01'33" W 226.53 feet to the southeast corner of said Vol. 1583, Pg. 533; thence N 25°44'20" E 130.24 feet to the point of beginning.

Subject to any easements, covenants and restrictions of record.

SURVEYOR'S CERTIFICATE

I, Christopher W. Fechner, Registered Land Surveyor, hereby certify that the survey shown and represented above is accurate and true to the best of my knowledge and belief and that there are no visible encroachments other than those shown.

*Christopher W. Fechner*  
Christopher W. Fechner RLS 2448

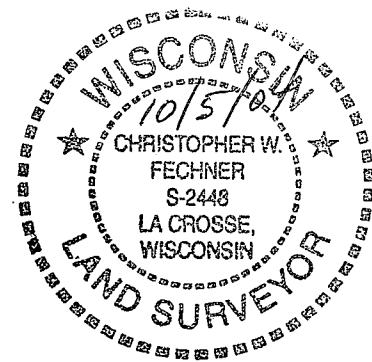

SURVEY FOR  
**SILHA TO ARENTZ**

PART OF THE SW - NE  
SECTION 22, T15N-R5W  
TOWN OF WASHINGTON, LACROSSE CO, WI  
COUNTY ROAD "H"

DRAWN BY: CF	DATE: 10/05/04
REVISED BY:	DATE:
SCALE: 1" = 100'	

SHEET 1 OF 1

PROJECT NO.:  
**S 5112**

FIELD CREW:  
**RC JS**

COULEE REGION LAND SURVEYORS, INC.

917 SO. 4TH STREET - P.O. BOX 1954

LA CROSSE, WISCONSIN 54601

PHONE (608) 784-1614 FAX (608) 784-1408