



Solberg Home Inspection Location Report

COMP# 13027 LAX13720 DATE 11/6/91 INV# 7410
Prepared for the exclusive use of

THE TITLE COMPANY

The above party and SHI, Inc. have a signed agreement on file to waive the requirements for a legal survey as set forth in Wisconsin Administrative Code AE 7.01 to AE 7.07. The information relating to lot dimensions and lot shape is based on public documents, not field measurements, the location of improvements is based on field inspection with respect to apparent property lines. It is not intended to be used for the construction of fences, driveways, garages, houses or other structures. It is, in no way, intended to be used as a basis for determining property lines. This report is not a part of any title commitment.


P.O. Box 1235
La Crosse, Wisconsin 54601
(608) 784-1614

Description

Part of the NW $\frac{1}{4}$ of the SE $\frac{1}{4}$ of Section 22, T15N, R5W

Address

Mark & Julie Newman
N1131 County Highway G
Middle Ridge, WI

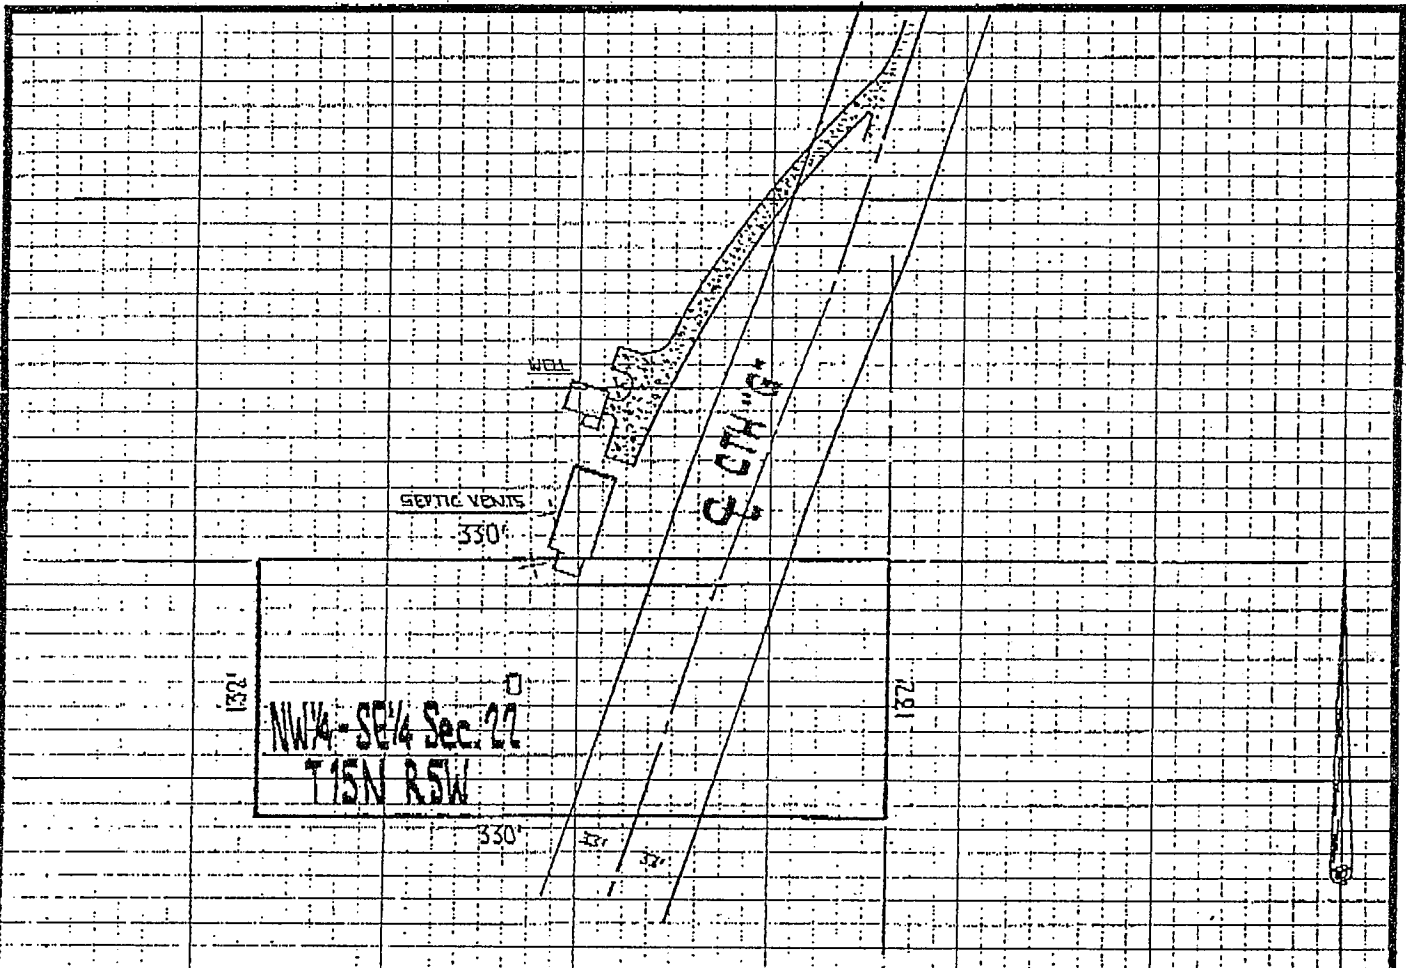

NOTE: Due to lack of monumentation, recorded evidence or apparent property lines, an accurate representation of property lines can not be portrayed. A legal survey is necessary to determine parcel size, location and relationship to existing improvements. Drawing developed from aerial photography and U.S.G.S. quadrangle

SCALE: 1" = 100'