


Township 15 Range 5 Section 30

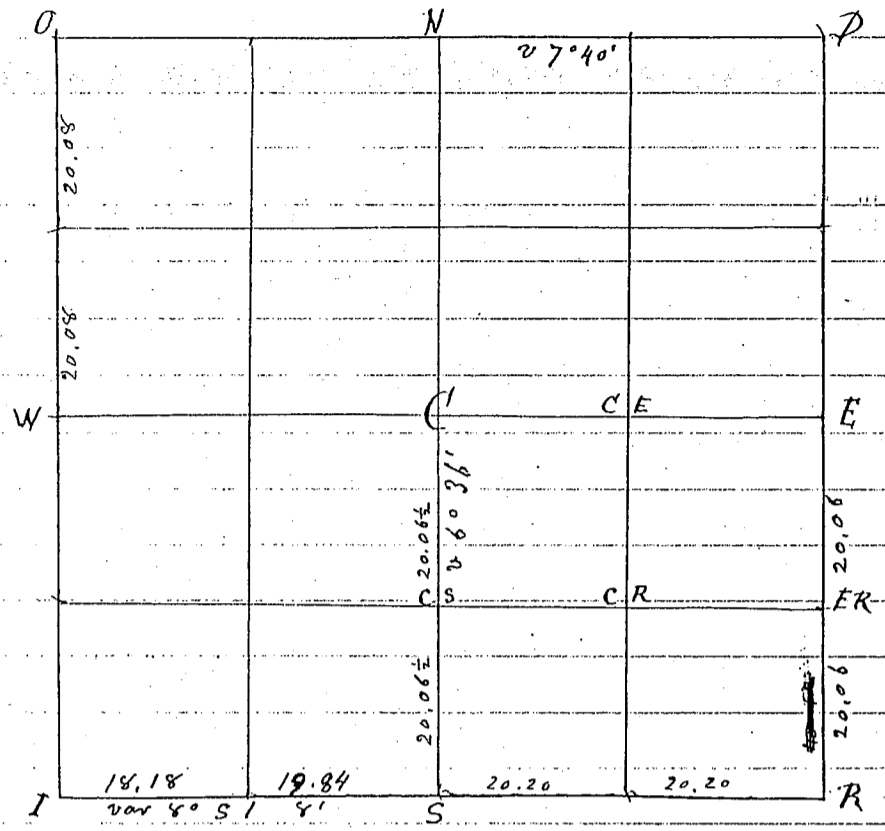

Surveyed May 23^d 1876

Corners

Run from S to I

S I

W Oak 16 S 13 1/2° W 84
W Oak 20 S 23 1/2° E 120

J Middlebrook County Surveyor

June 27th 1876 Run from O to N from

N to S and from W to E

C

planted Stone

J Middlebrook County Surveyor

September 30th 1877 Identified W and made new bearing

Measured from C to S from S to R from R to E and from E to C - Set stakes at C, S and at C, R and measured from W to O

J Middlebrook County Surveyor

W

B Oak 4 S 13° E 19 links